


239.


RECORD of NEW MONUMENTS IN Ogden City

SMITH STR. OR JEFFERSON AVENUE.

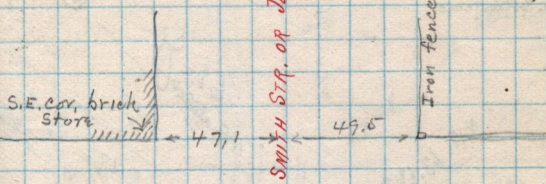

Center 24th Street

▲ CITY MONT NO 15

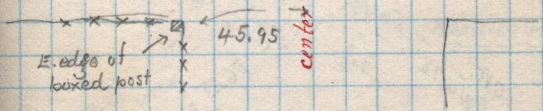

Tie Points -

S.E.	to top of Hydrant	56.05
SW,	" fence cor,	69.00 Ft.
N.W.	" brick building	67.35 "
N.E	" cor. Stevens fence	72.15 "
S. E.	" Cotton Lamp pole	6.5 2.50 "