


Set stakes and garr points on
West curb line (38 ft from Mounts) of
Washington Ave. - for Elec Light loc-
from 22^d to 25th St.

A. M. Oct 17-1890

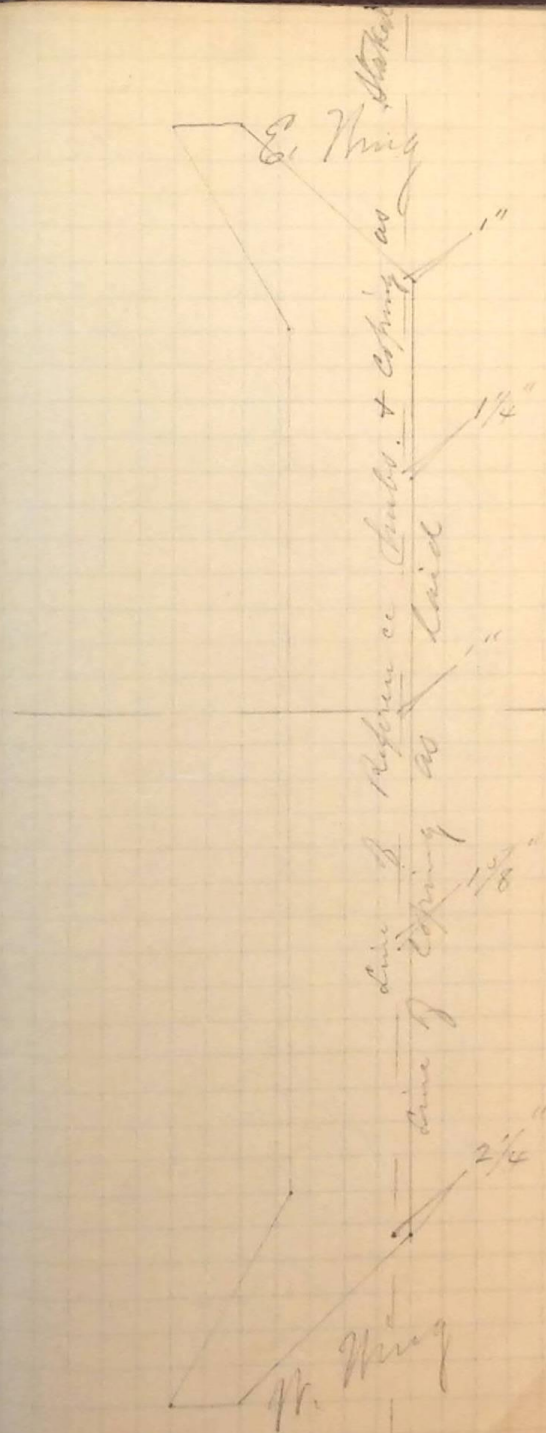

A. M.
Oct 18-90

Sketch showing
proper line for
Coping with ref-
erence to coping
as laid.