

# STATE OF UTAH STATE ROAD COMMISSION

## PLANS OF PROPOSED STATE ROAD FEDERAL AID PROJECT

**DD-53(1)**  
**I-15 TO DEFENSE DEPOT OGDEN**  
**WEBER COUNTY**  
**LENGTH 0.794 MILES**




FED. ROAD DIST. NO.	STATE	PROJECT NO.	SHEET NO.
UTAH	UTAH	DD-53(I)	3

DATE		RIGHT OF WAY INSTRUMENTS	
II-14-68		ORIGINAL SUBMISSION FOR R/W AUTH.	
REVISIONS			
R/W DES. REV. BY:	MAPS CORN. BY:	PARCELS AFFECTED	REQUEST BY:
			REMARKS:

NW $\frac{1}{4}$  SW $\frac{1}{4}$   
SEC. 12


OFFICE REVISION

$\Delta = 32^\circ 37' 44.3''$  LT.  
D = 7'00'  
R = 818.51'  
T = 239.57'  
L = 466.13'  
PI = 25+6118

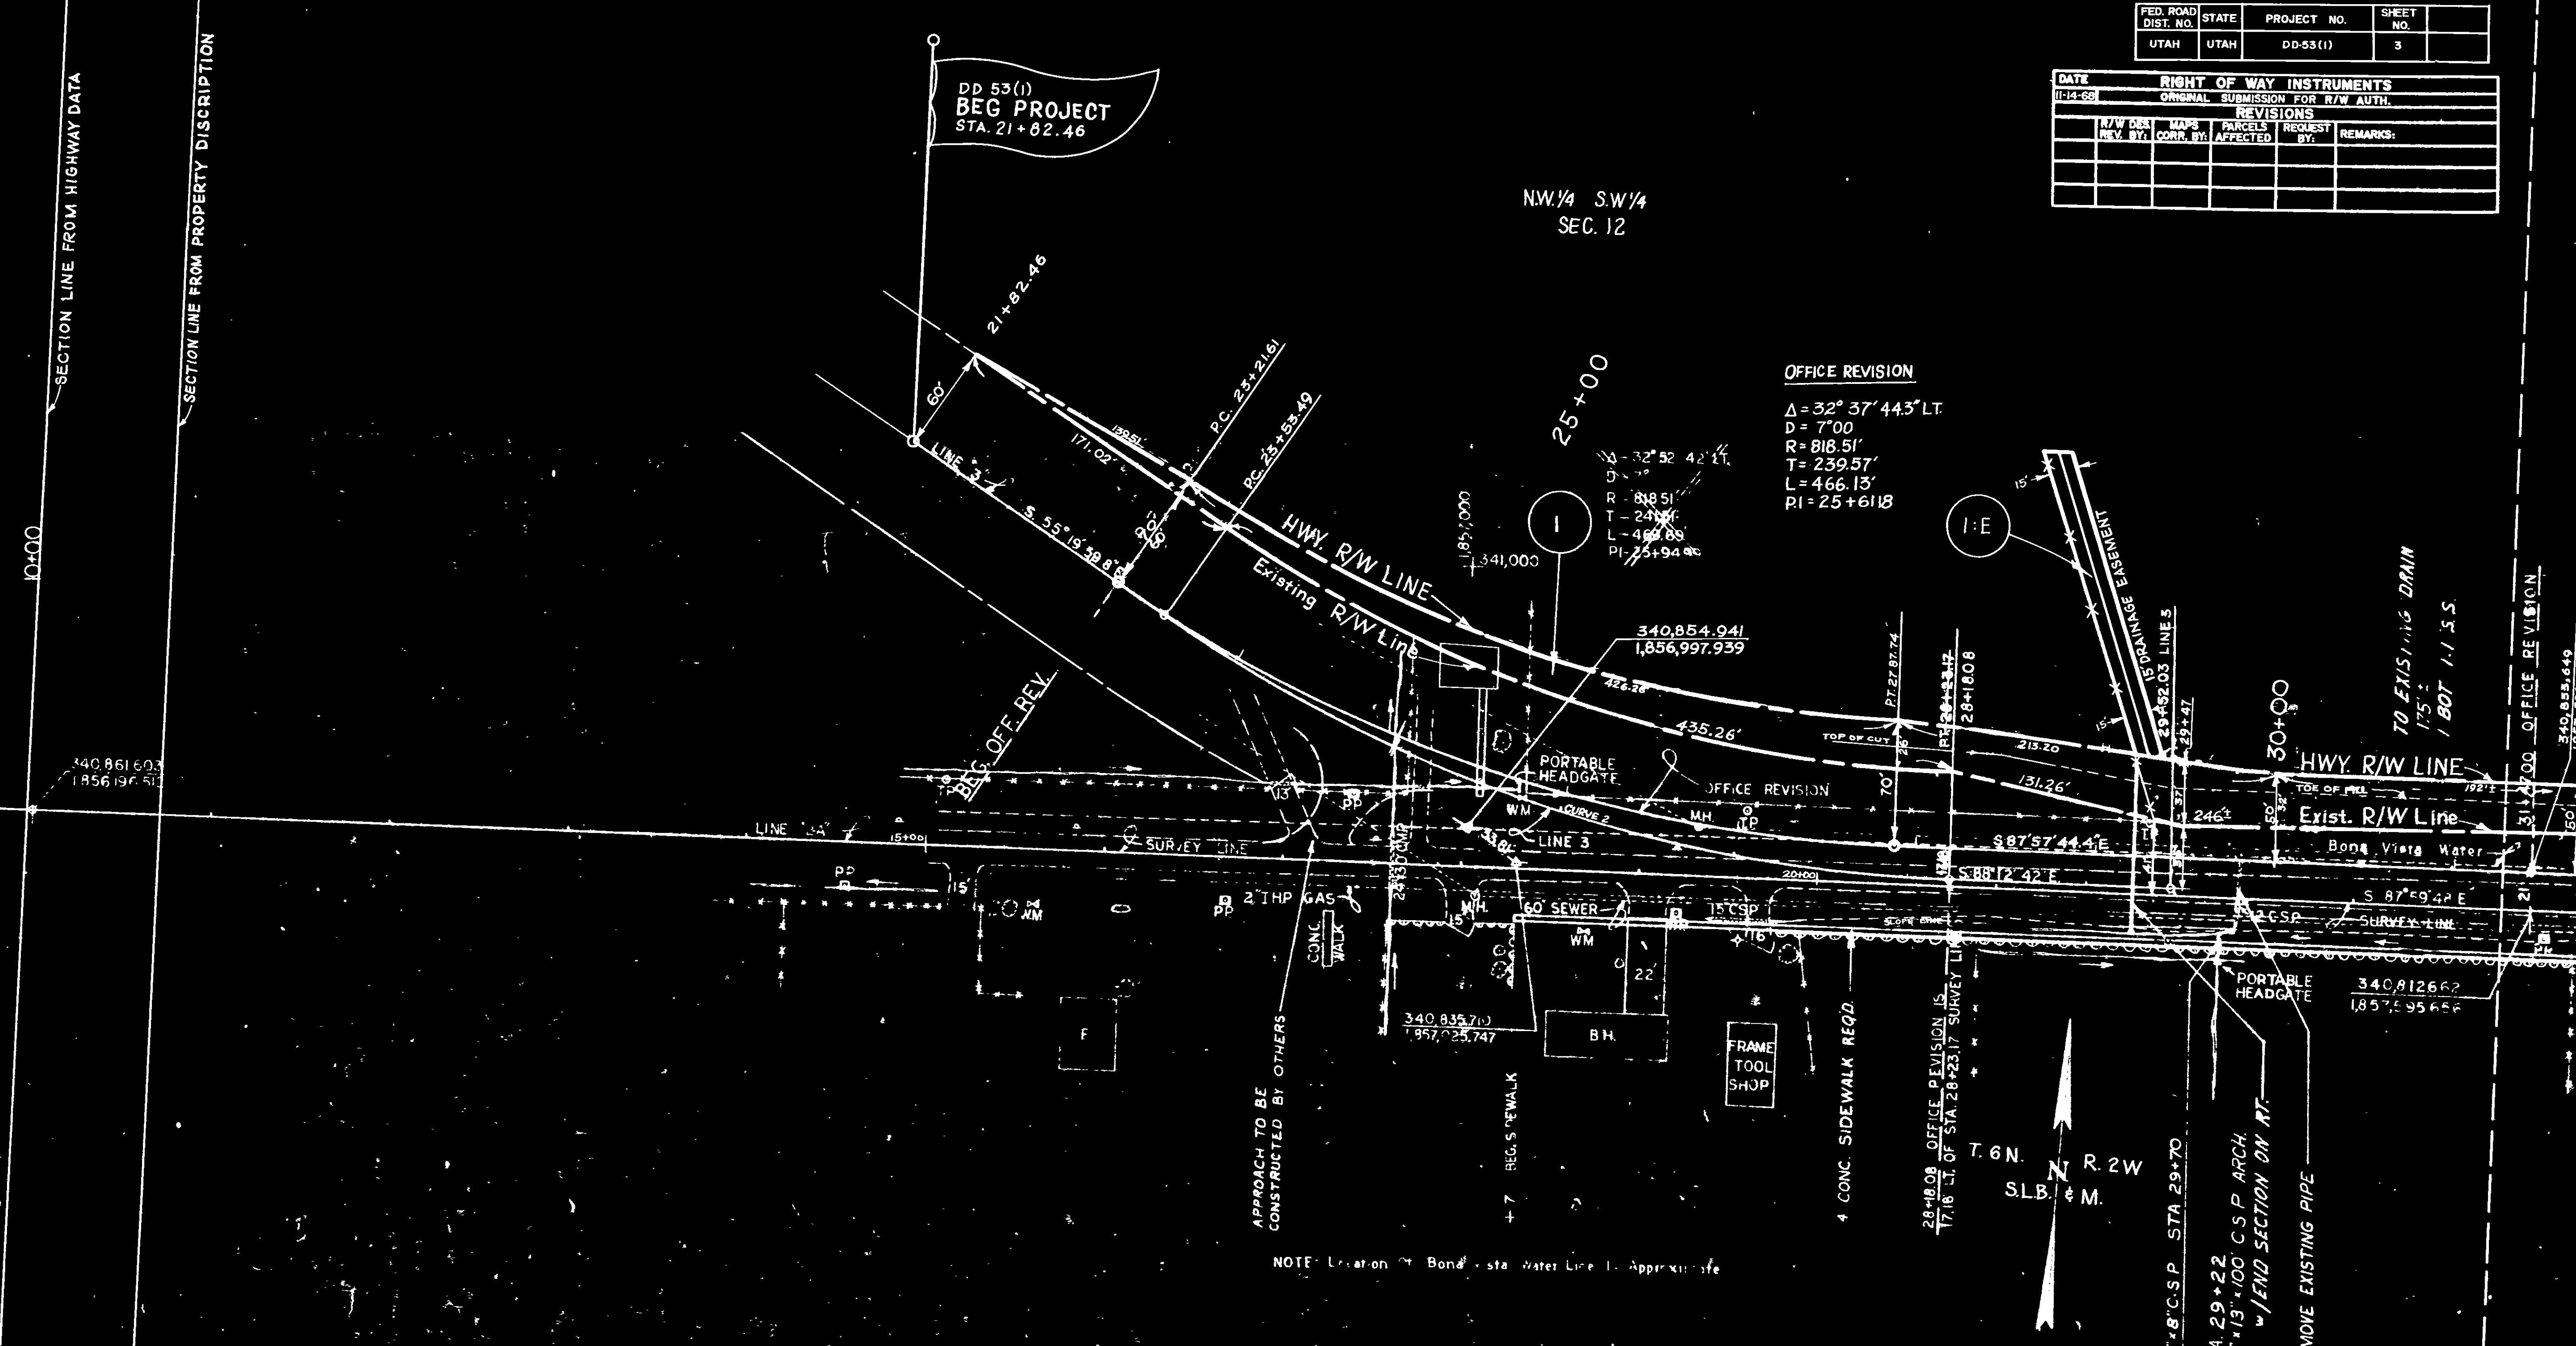


NOTE: Location of Bond - sta. Water Line is Approximate


PARCEL NO.	OWNER	NET AC.	SQ. FT.	OWNERSHIP AC.	REMAINING AC.	
					LEFT	RIGHT
53:1 I:E	JAMES CLIFFORD BLAIR	0.477± 0.062±	20,800	86.700	86.223	NONE

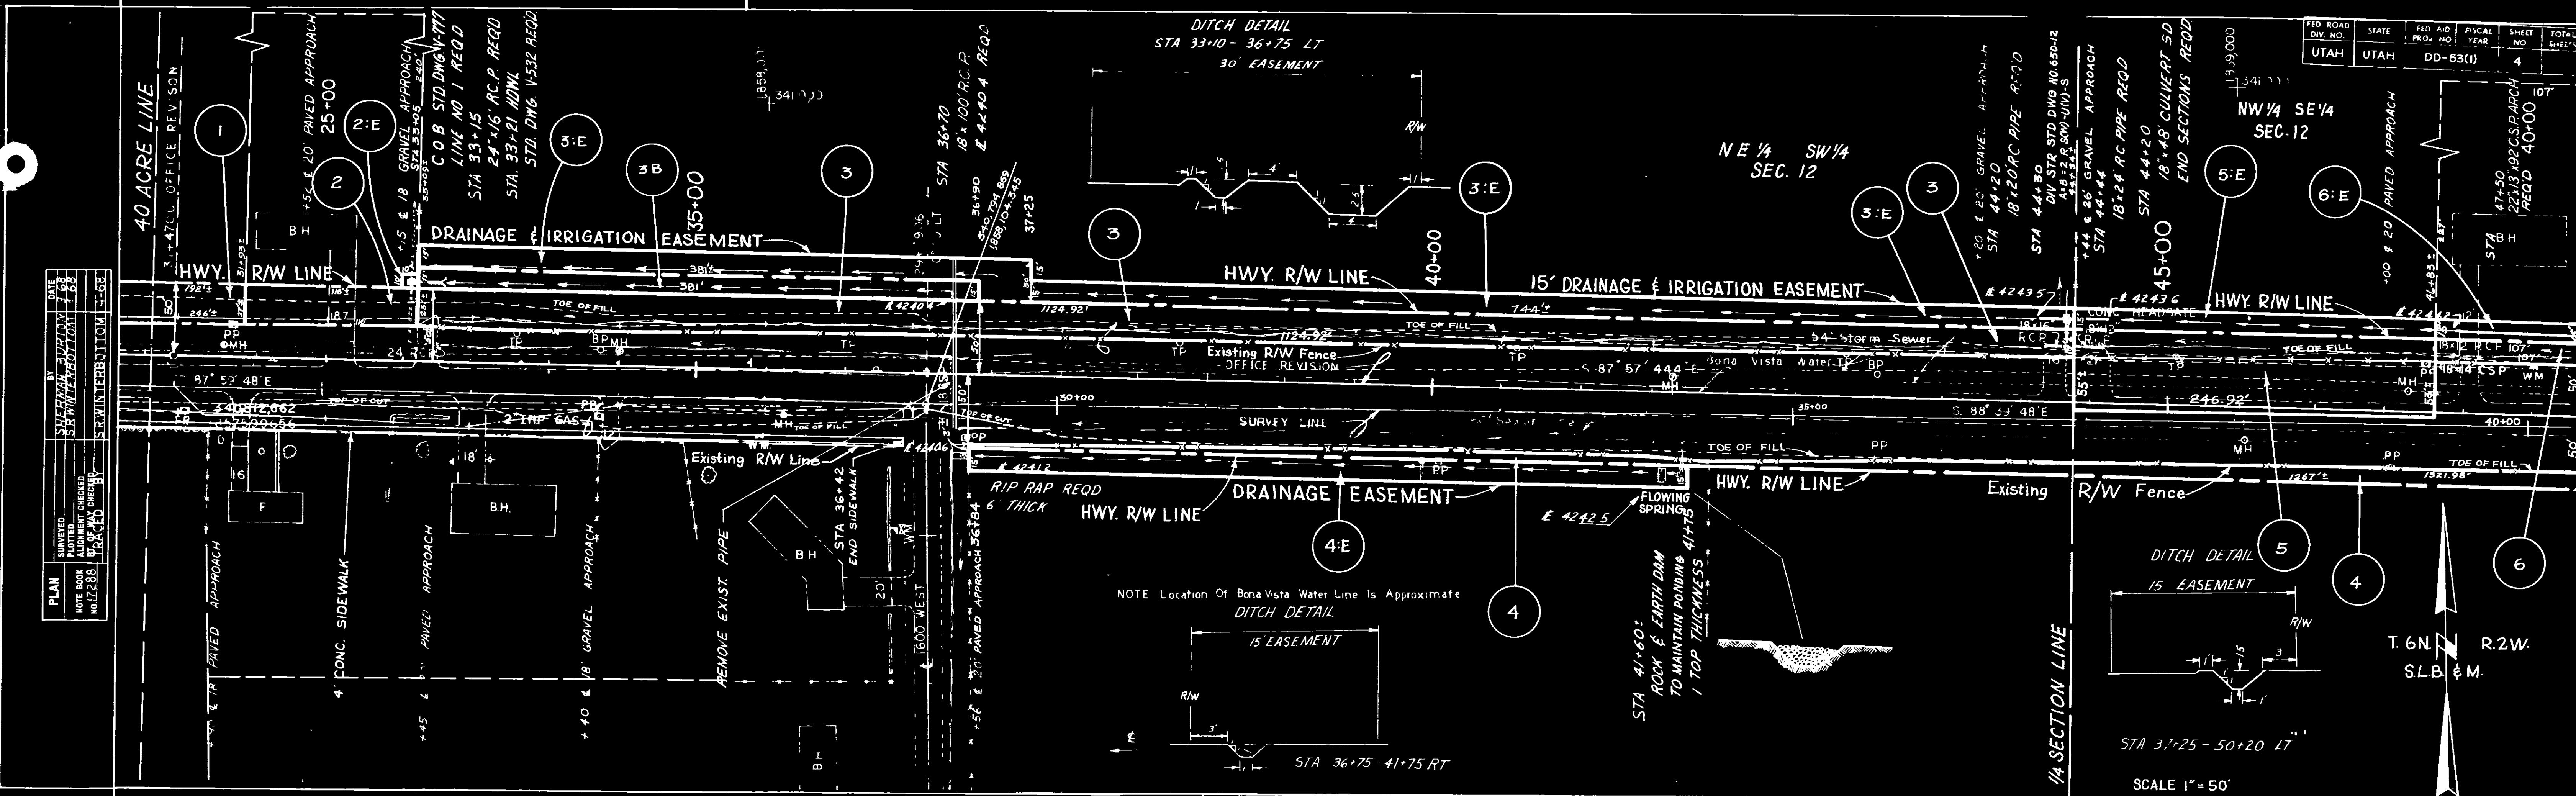

<u>PARCEL NO.</u>	<u>OWNER</u>	<u>NET AC.</u>	<u>SQ. FT.</u>	<u>OWNERSHIP AC.</u>	<u>REMAINING AC.</u>	
					<u>LEFT</u>	<u>RIGHT</u>
53:1	JAMES CLIFFORD BLAIR	0.477±	20,800	86.700	86.223	NONE
2	KEITH W. SLATER	0.069±	3,016	0.639	24,824 1/4	NONE
2:E	KEITH W. SLATER	0.002±				
3	BLANCHE P. SMOOT	0.568±	24,748	60.500	59.932	NONE
3:E	" " "	0.399				
4	AARON P. SPENCER	0.212±	9,254	25.410±	NONE	25.198
4:E	" " "	0.168±				
5	CLIFFORD J. SMOOT	0.167±	7,278	16.894	16.330	NONE
5:E	" " "	0.160±				
6	MYRNA PANTER	0.036±	1,552	0.557	22,738 1/4	NONE
6:E	" " "	0.036±				
3 B	BLANCHE P. SMOOT	0.131±	5,715	59.932	59,801	NONE

<b>RIGHT OF WAY INSTRUMENTS</b>				
ORIGINAL SUBMISSION FOR R/W AUTH.				
<b>REVISIONS</b>				
DES. BY:	MAPS CORR. BY:	PARCELS AFFECTION	REQUEST BY:	REMARKS:
C.B.	R.B.L.	3.E., 3B	H.H.R	REVISED AND NEW PARCEL

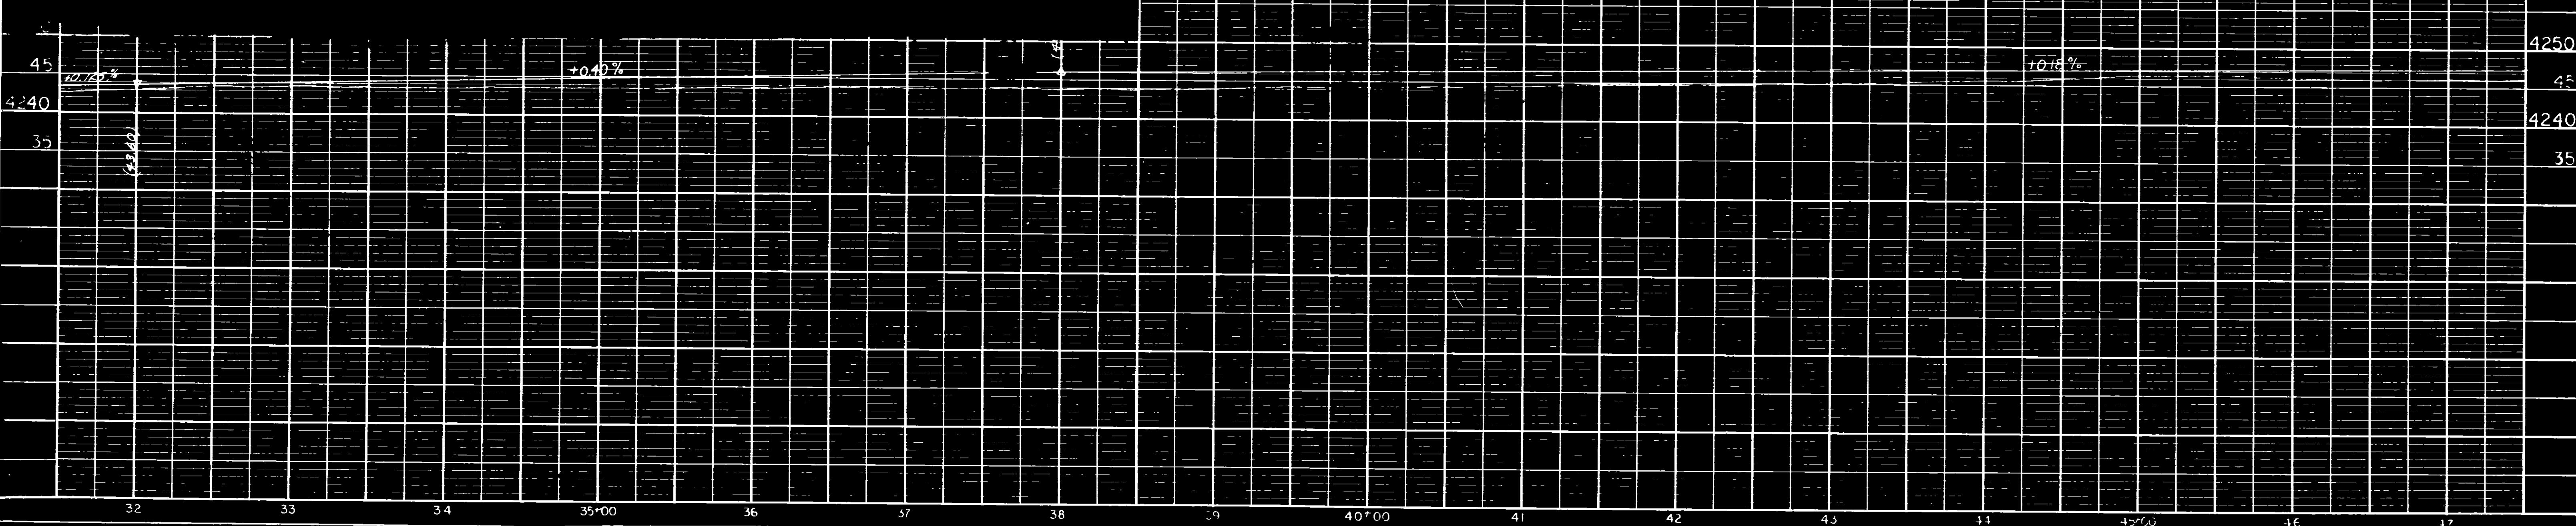

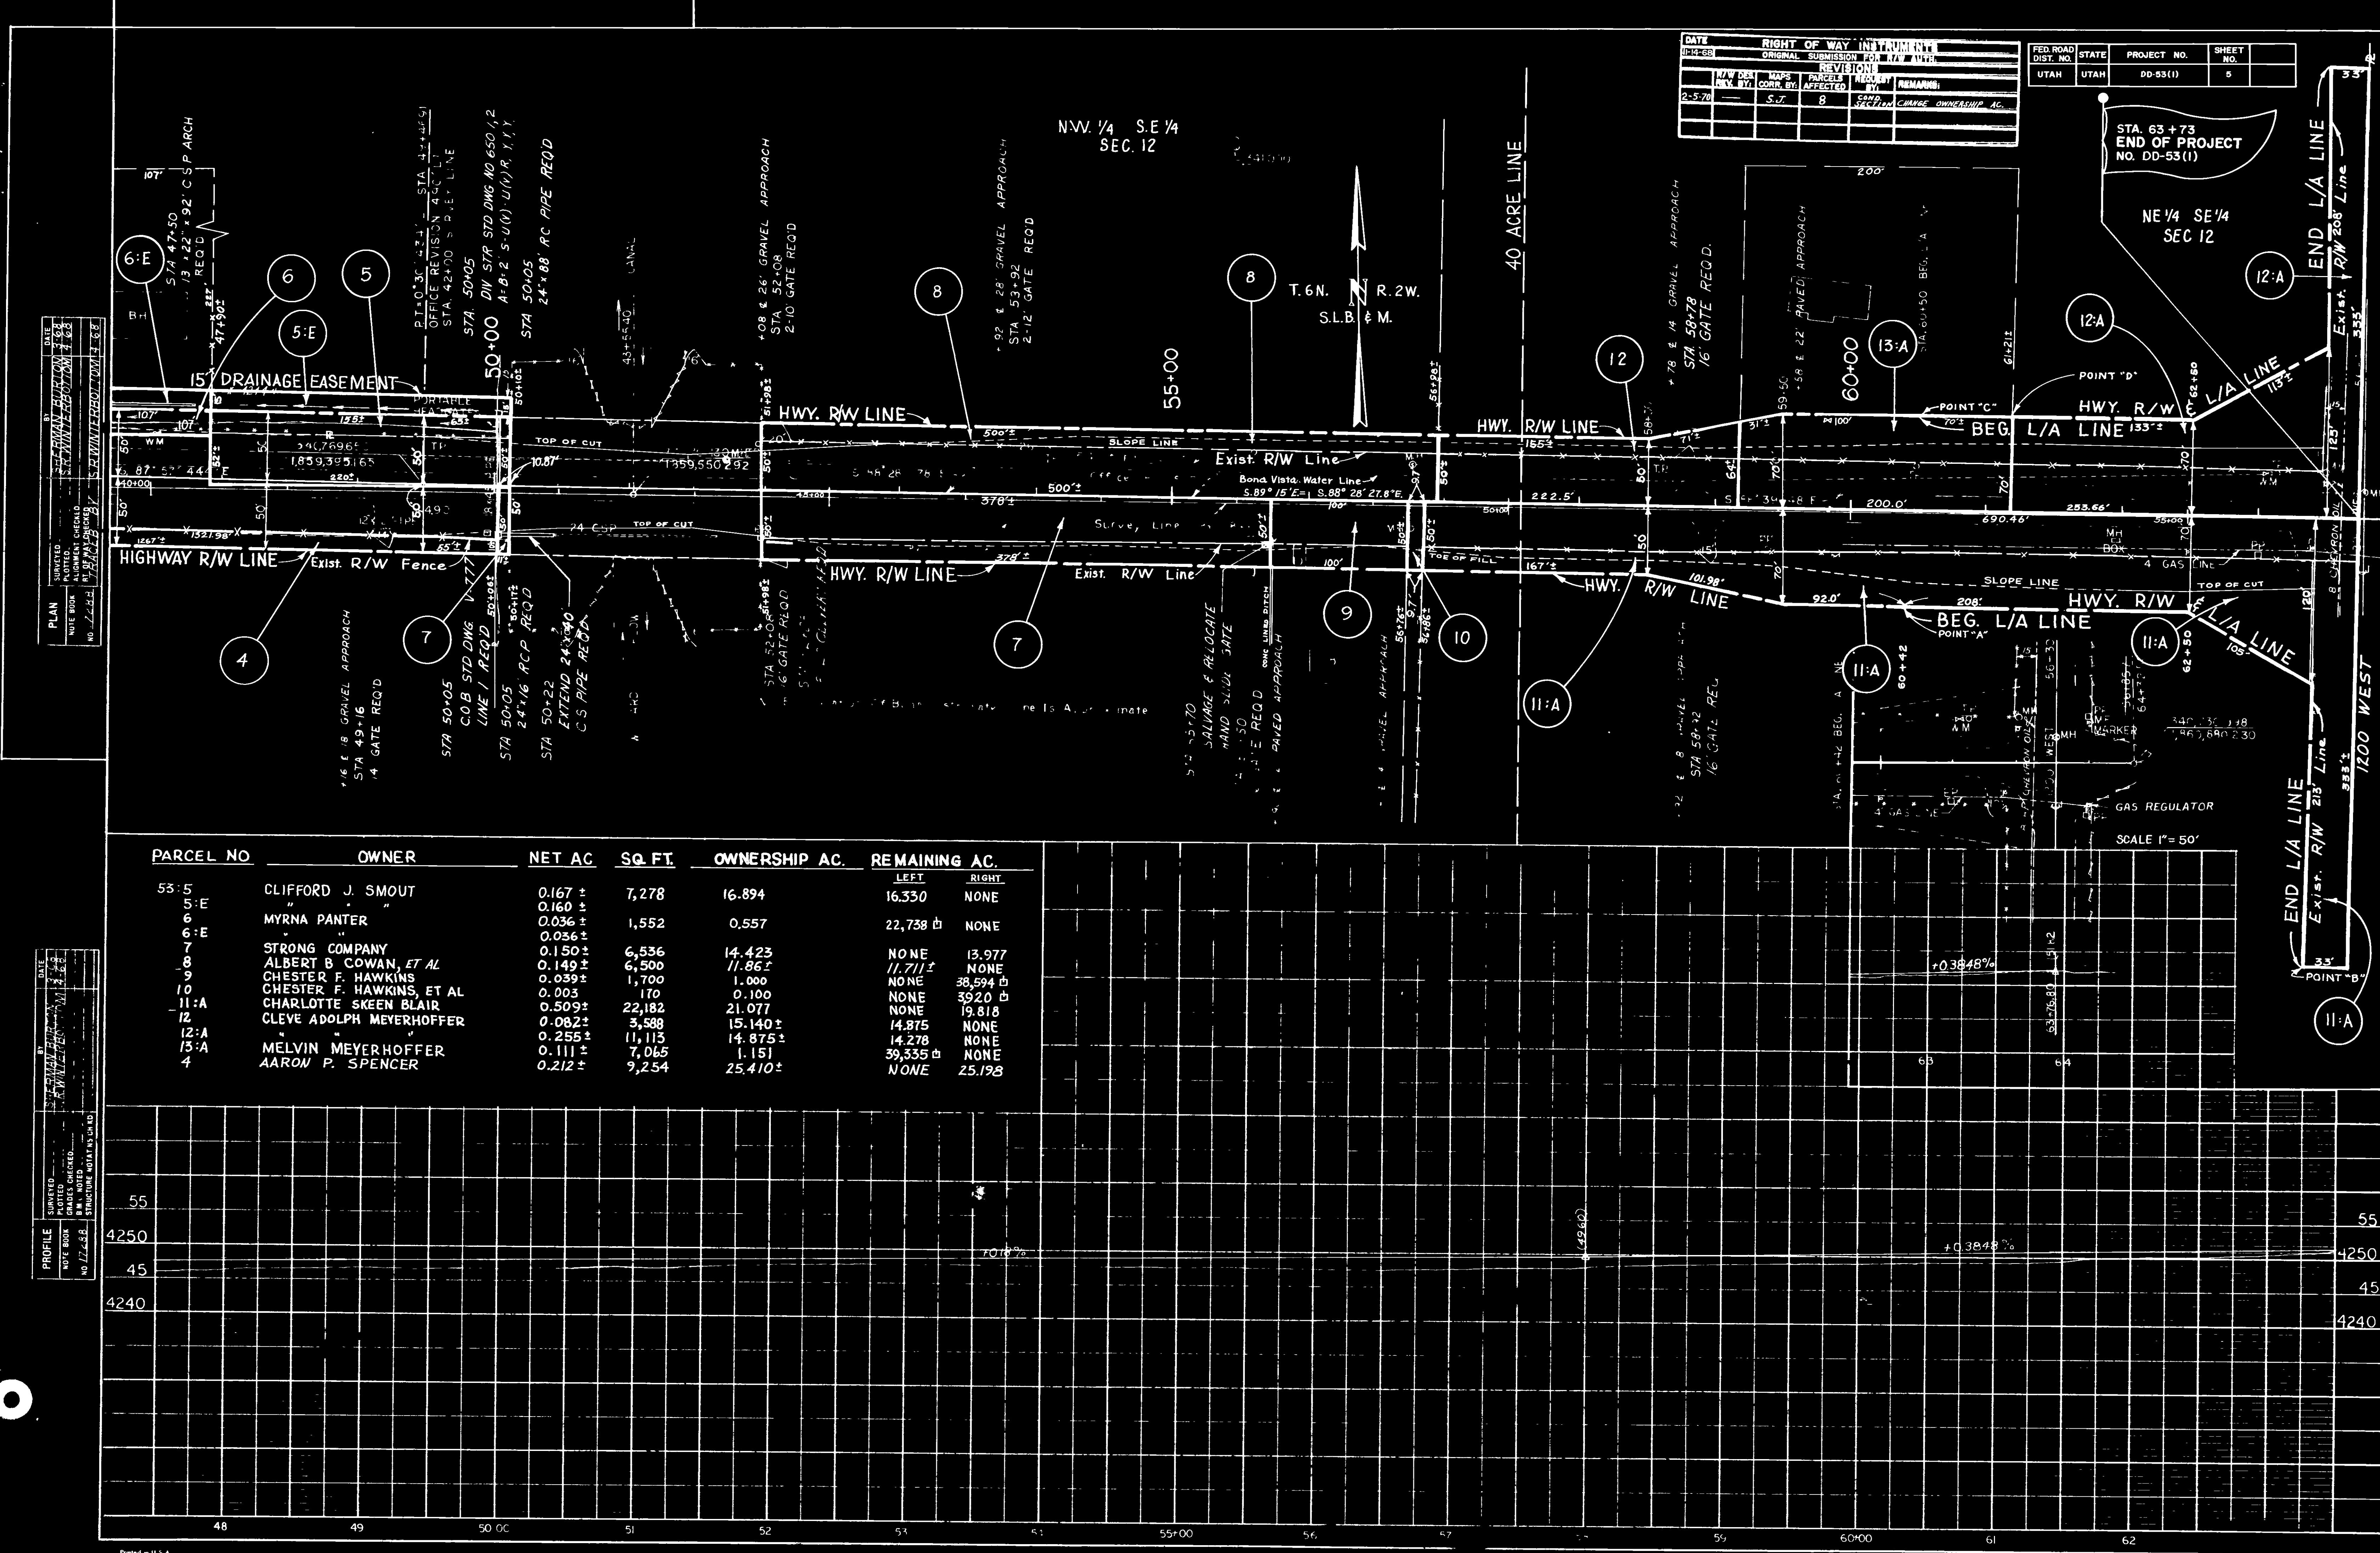

<b>PROFILE</b>	SURVEYED _____	PLOTTED _____	GRADES CHECKED _____	B.M. NOTED _____	STRUCTURE NOTATNS CHD
NOTE BOOK	10 17 68				


<b>PROFILE</b>	SURVEYED	3-7-5
	PLOTTED	4-6-0
<b>NOTE BOOK</b>	GRADES CHECKED	STRUCTURE NOTATIONS UN K'D
10 17 68	B.M. NOTED	

PLAN SURVEYED 3-6-88  
 PLOTTED 4-6-88  
 ALIGNMENT CHECKED AT OF WAY CHECKED BY  
 NOTE BOOK NO. 1288  
 DATE 4-6-88  
 BY S.R. WINTER BOTTOM

N. 345,000

UTAH STATE ROAD COMMISSION  
TOTAL TRACT MAP  
400 NORTH I-15 TO  
DEFENSE DEPOT OGDEN  
PROJECT NO DD-53(1) SCALE: 1" = 2  
WEBER COUNTY SEPT  
DRAWN BY: MCH

PARCEL NUMBER	GRANTOR	OWNERSHIP ACREAGE	NET ACREAGE
53: 1	JAMES CLIFFORD BLAIR	86.700	0.203
53: 1: E	" "	86.497	0.061
53: 2	KEITH W. SLATER	1.134	0.141
53: 2: E	" "	0.993	0.002
53: 3	BLANCHE P. SMOOT	60.500	0.568
53: 3: E	" "	59.932	0.387
53: 4	AARON P. SPENCER	25.410	0.212
53: 4: E	" "	25.198	0.168
53: 5	CLIFFORD J. SMOOT	16.894	0.167
53: 5: E	" "	16.330	0.085
53: 6	MYRA PANTER	0.557	0.034
53: 6: E	" "	0.638	0.046
53: 7	STRONG COMPANY	14.423	0.150
53: 8	ALBERT COWAN	7.281	0.149
53: 9	CHESTER HAWKINS	1.000	0.039
53: 10	CHAWKINS & STRONG CO.	0.100	0.003
53: 11A	CHARLOTTE S. BLAIR	21.077	0.509
53: 12	CLEVE MEYERHOFFER	15.140	0.082
53: 12A	" "	14.875	0.237
53: 13A	MELVIN MEYERHOFFER	1.151	0.111

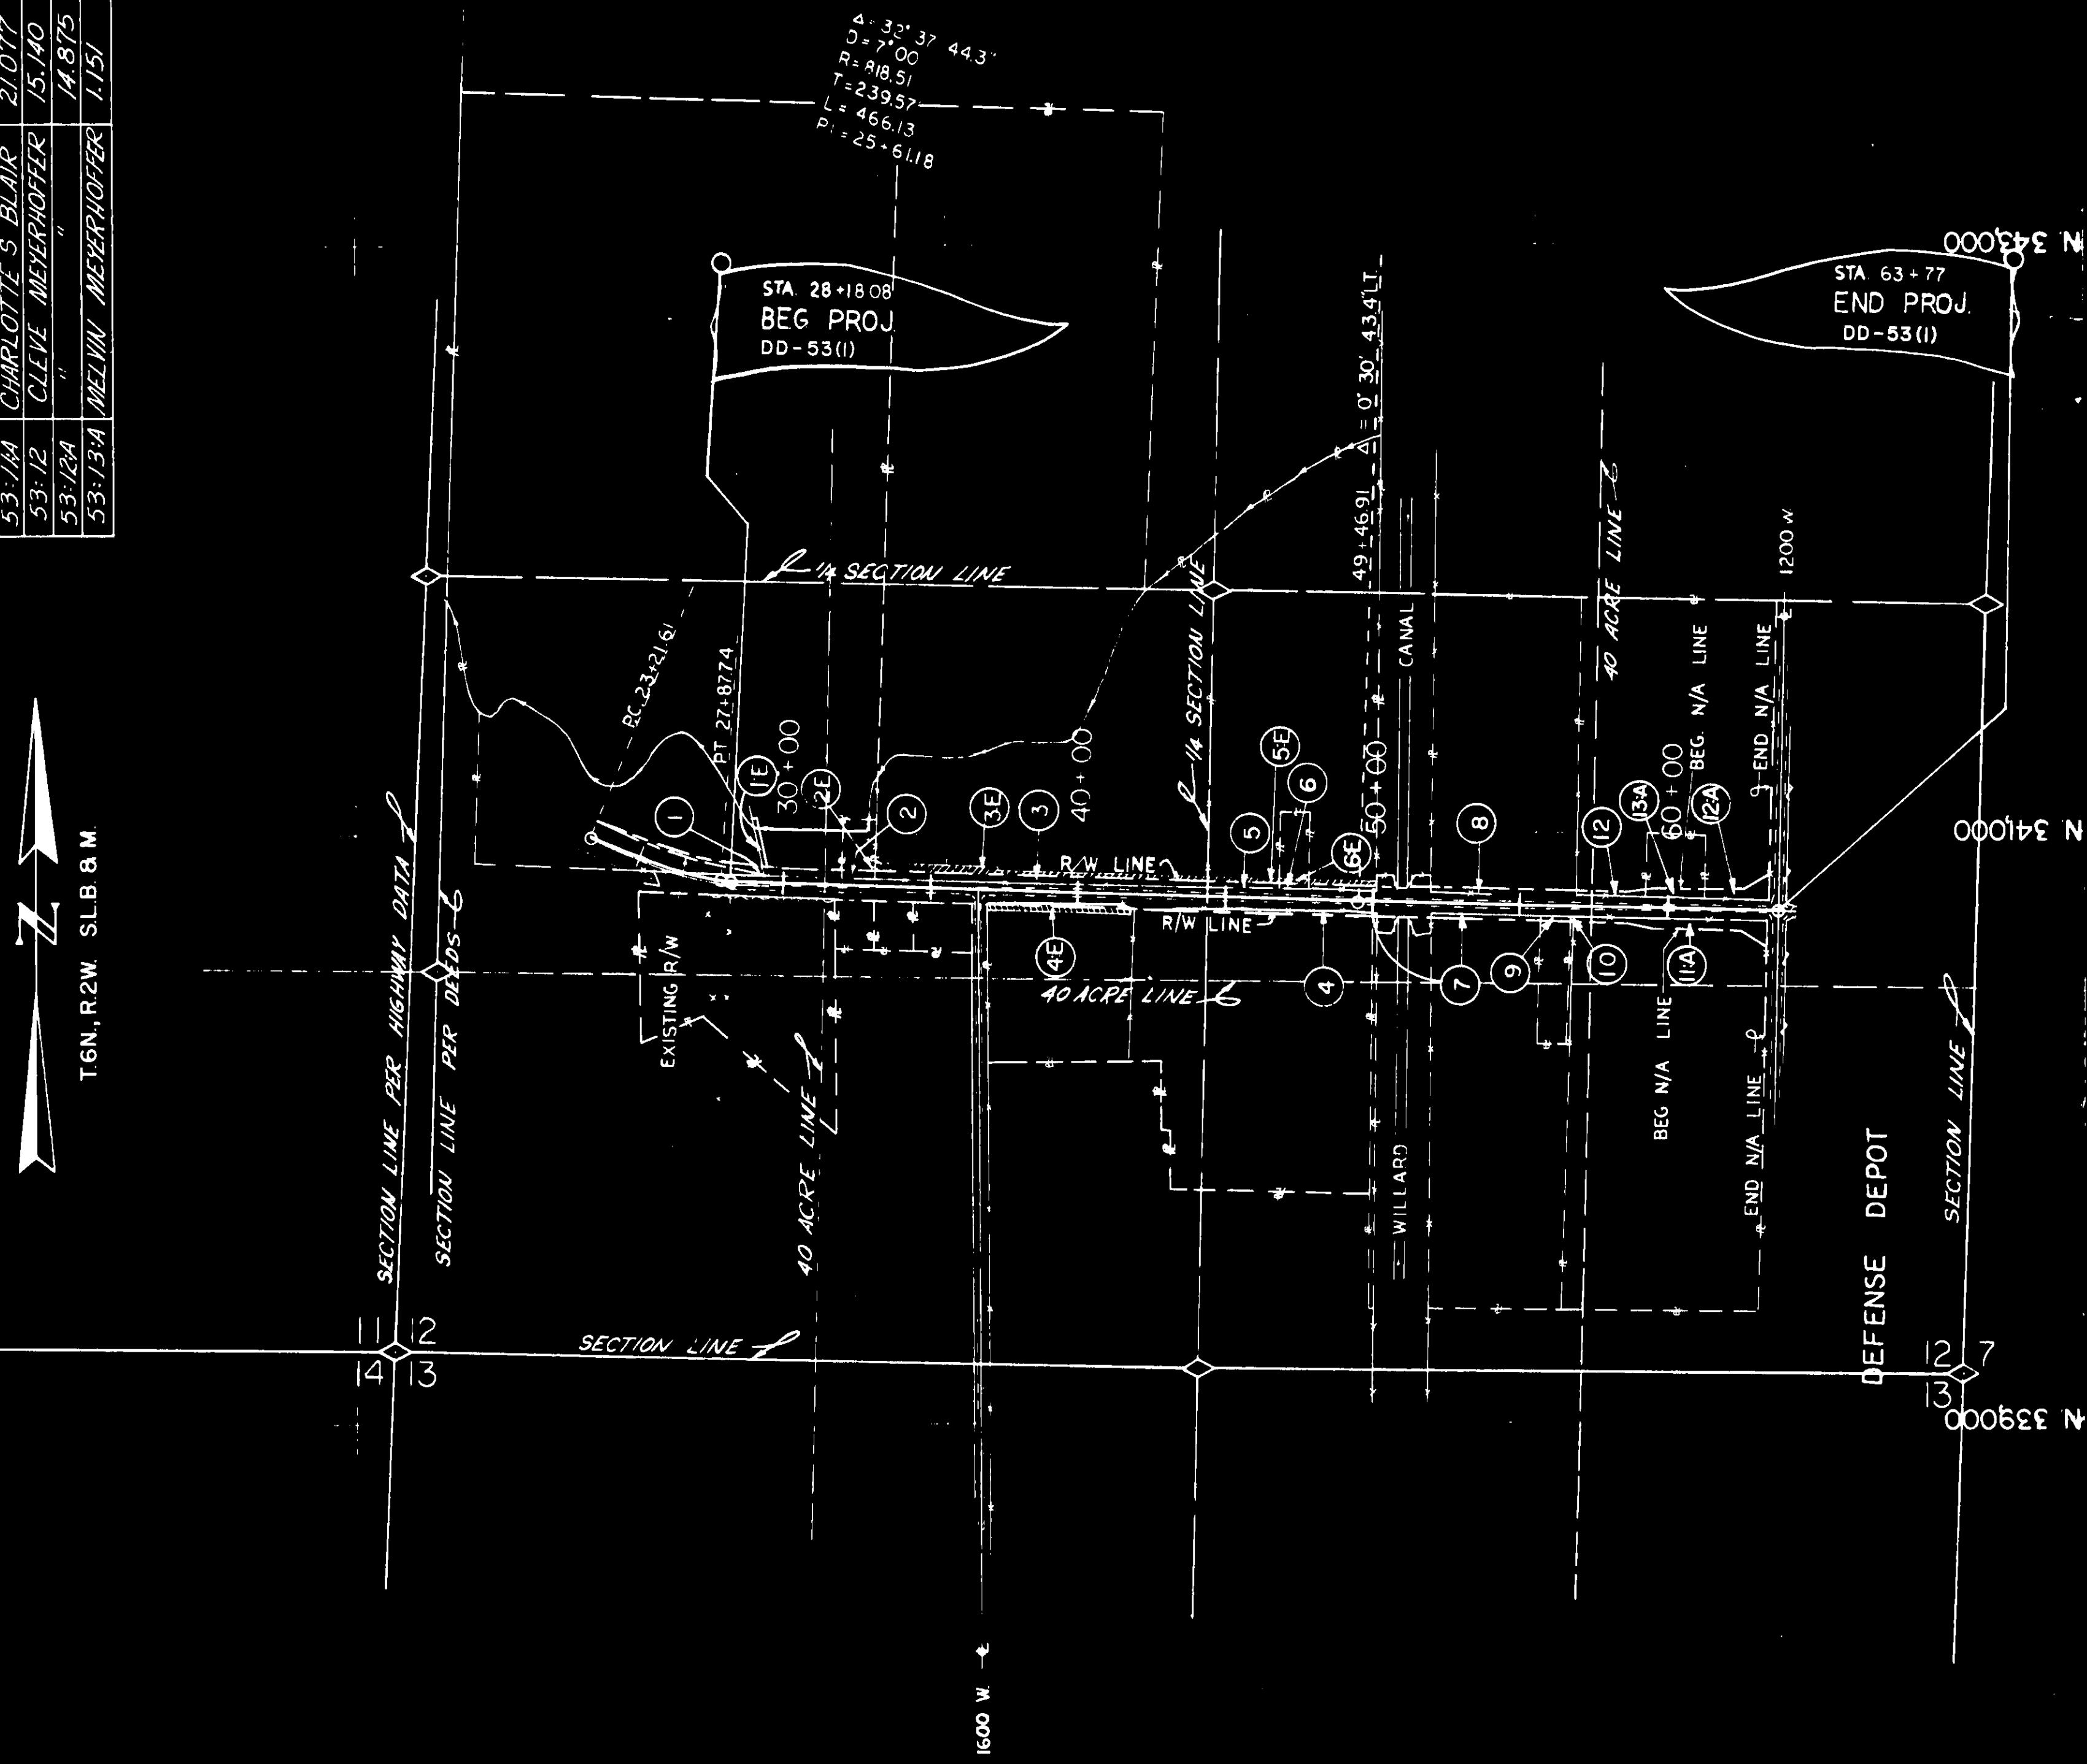


N 337,000

E. 1,854,000

# AS CONSTRUCTED PLANS

## STATE OF UTAH

### STATE ROAD COMMISSION

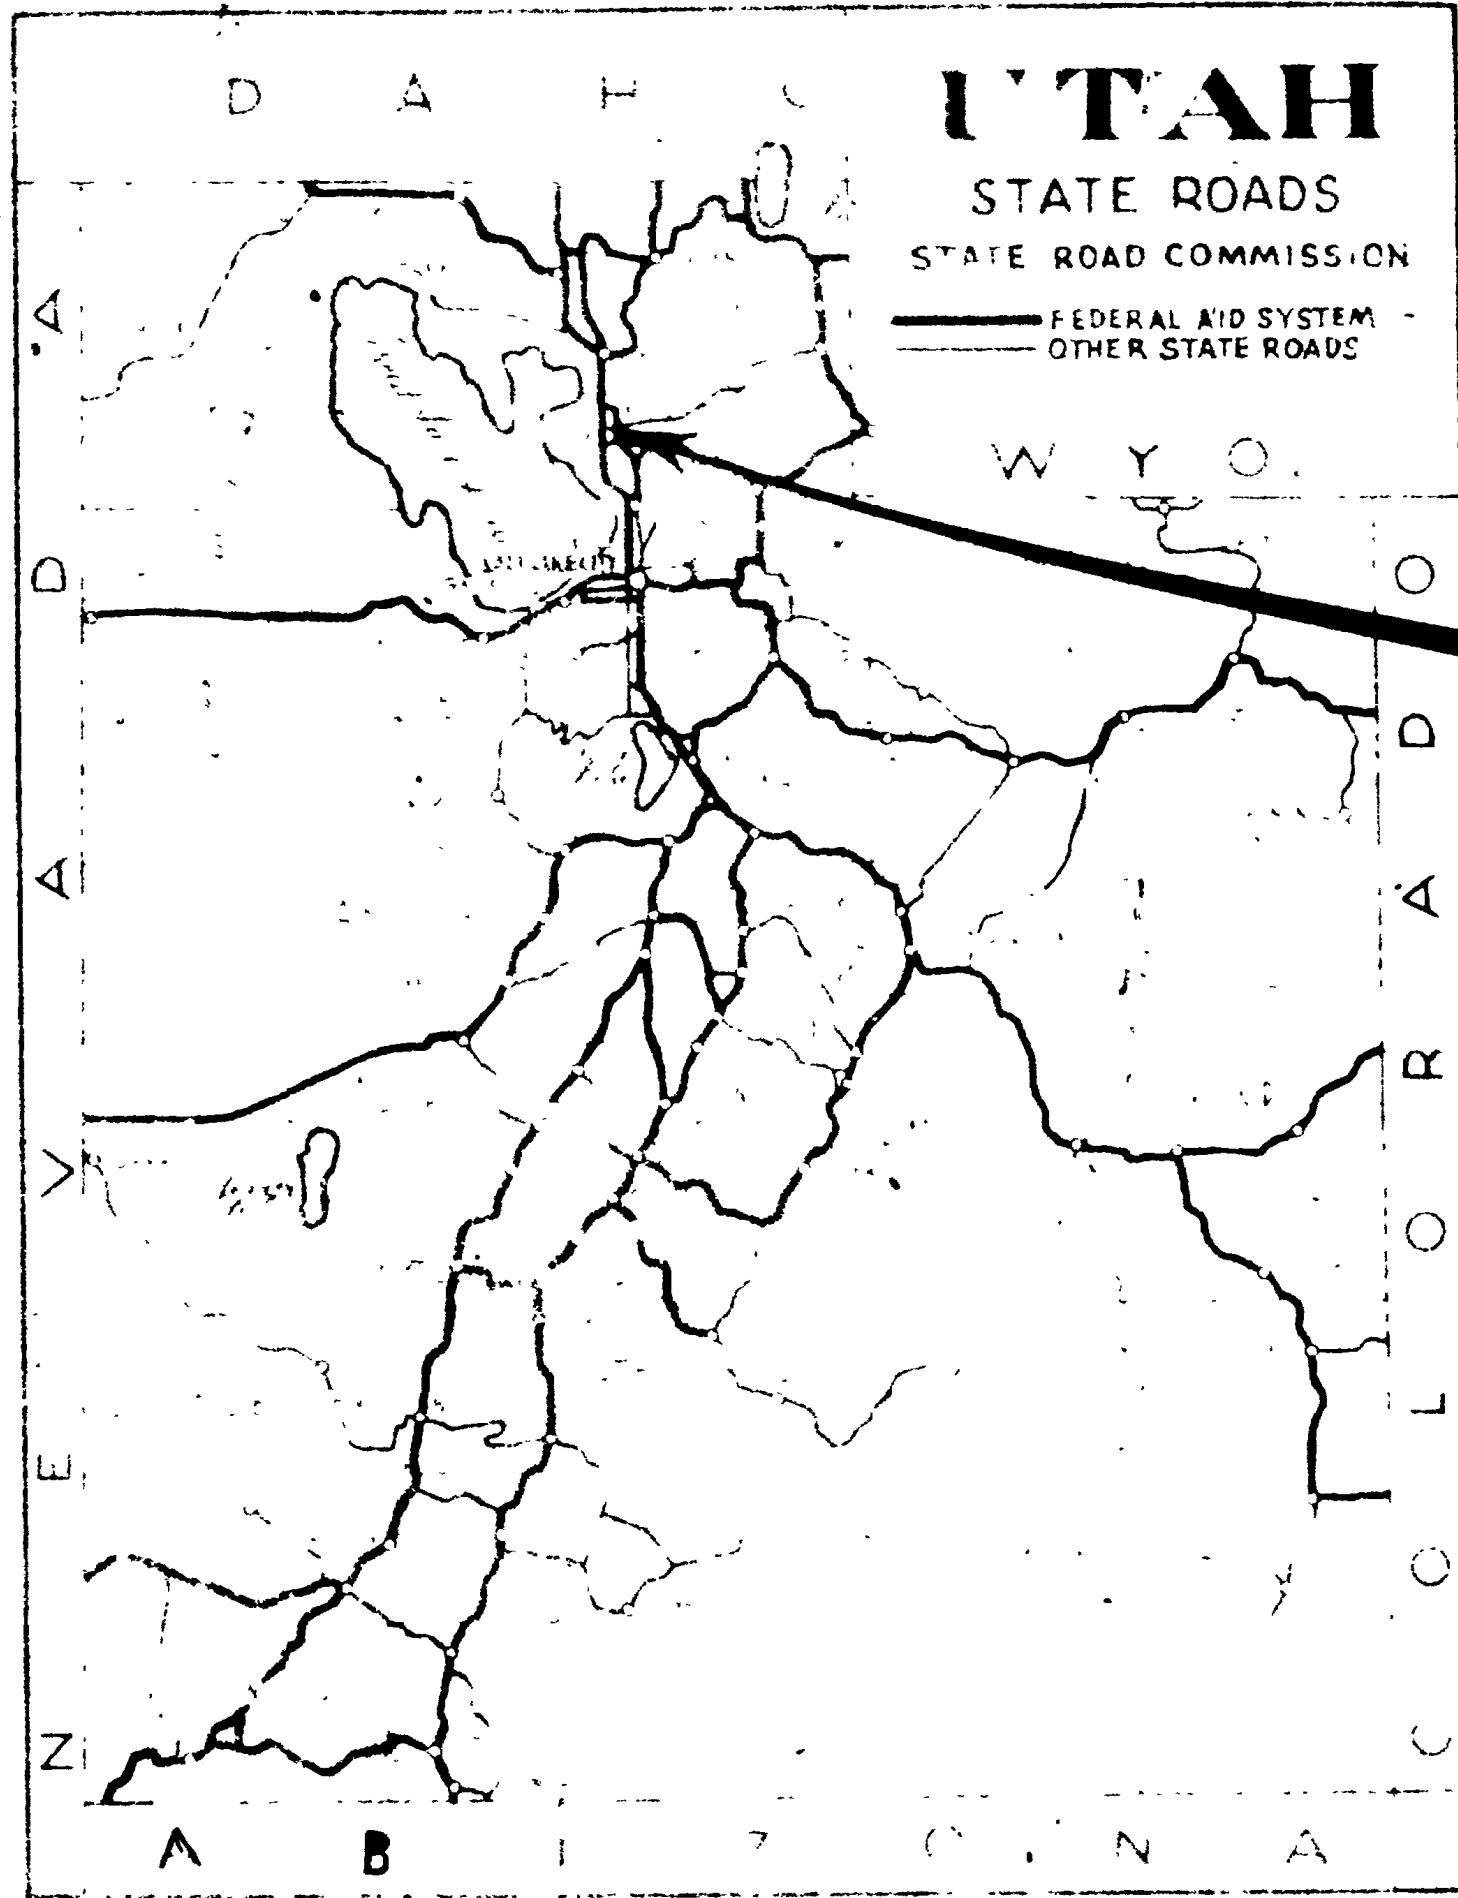


DD-53 (I)  
I-IG-15-8(23)338 9th CONTRACT

**PLANS OF PROPOSED STATE ROAD**  
**FEDERAL AID PROJECT**  
**DD - 53 (I)**  
**I-15 TO DEFENSE DEPOT OGDEN**

LENGTH . 0.678 MILES

**I-IG-15-8(23)338 9th CONTRACT**  
**1600 WEST ST.**  
**LENGTH . 0.263 MILES**  
**WEBER COUNTY**

SHERMAN L BURTON, RESIDENT ENGINEER  
FIFE CONSTRUCTION COMPANY, CONTRACTOR  
EFFECTIVE DATE 9-22-70

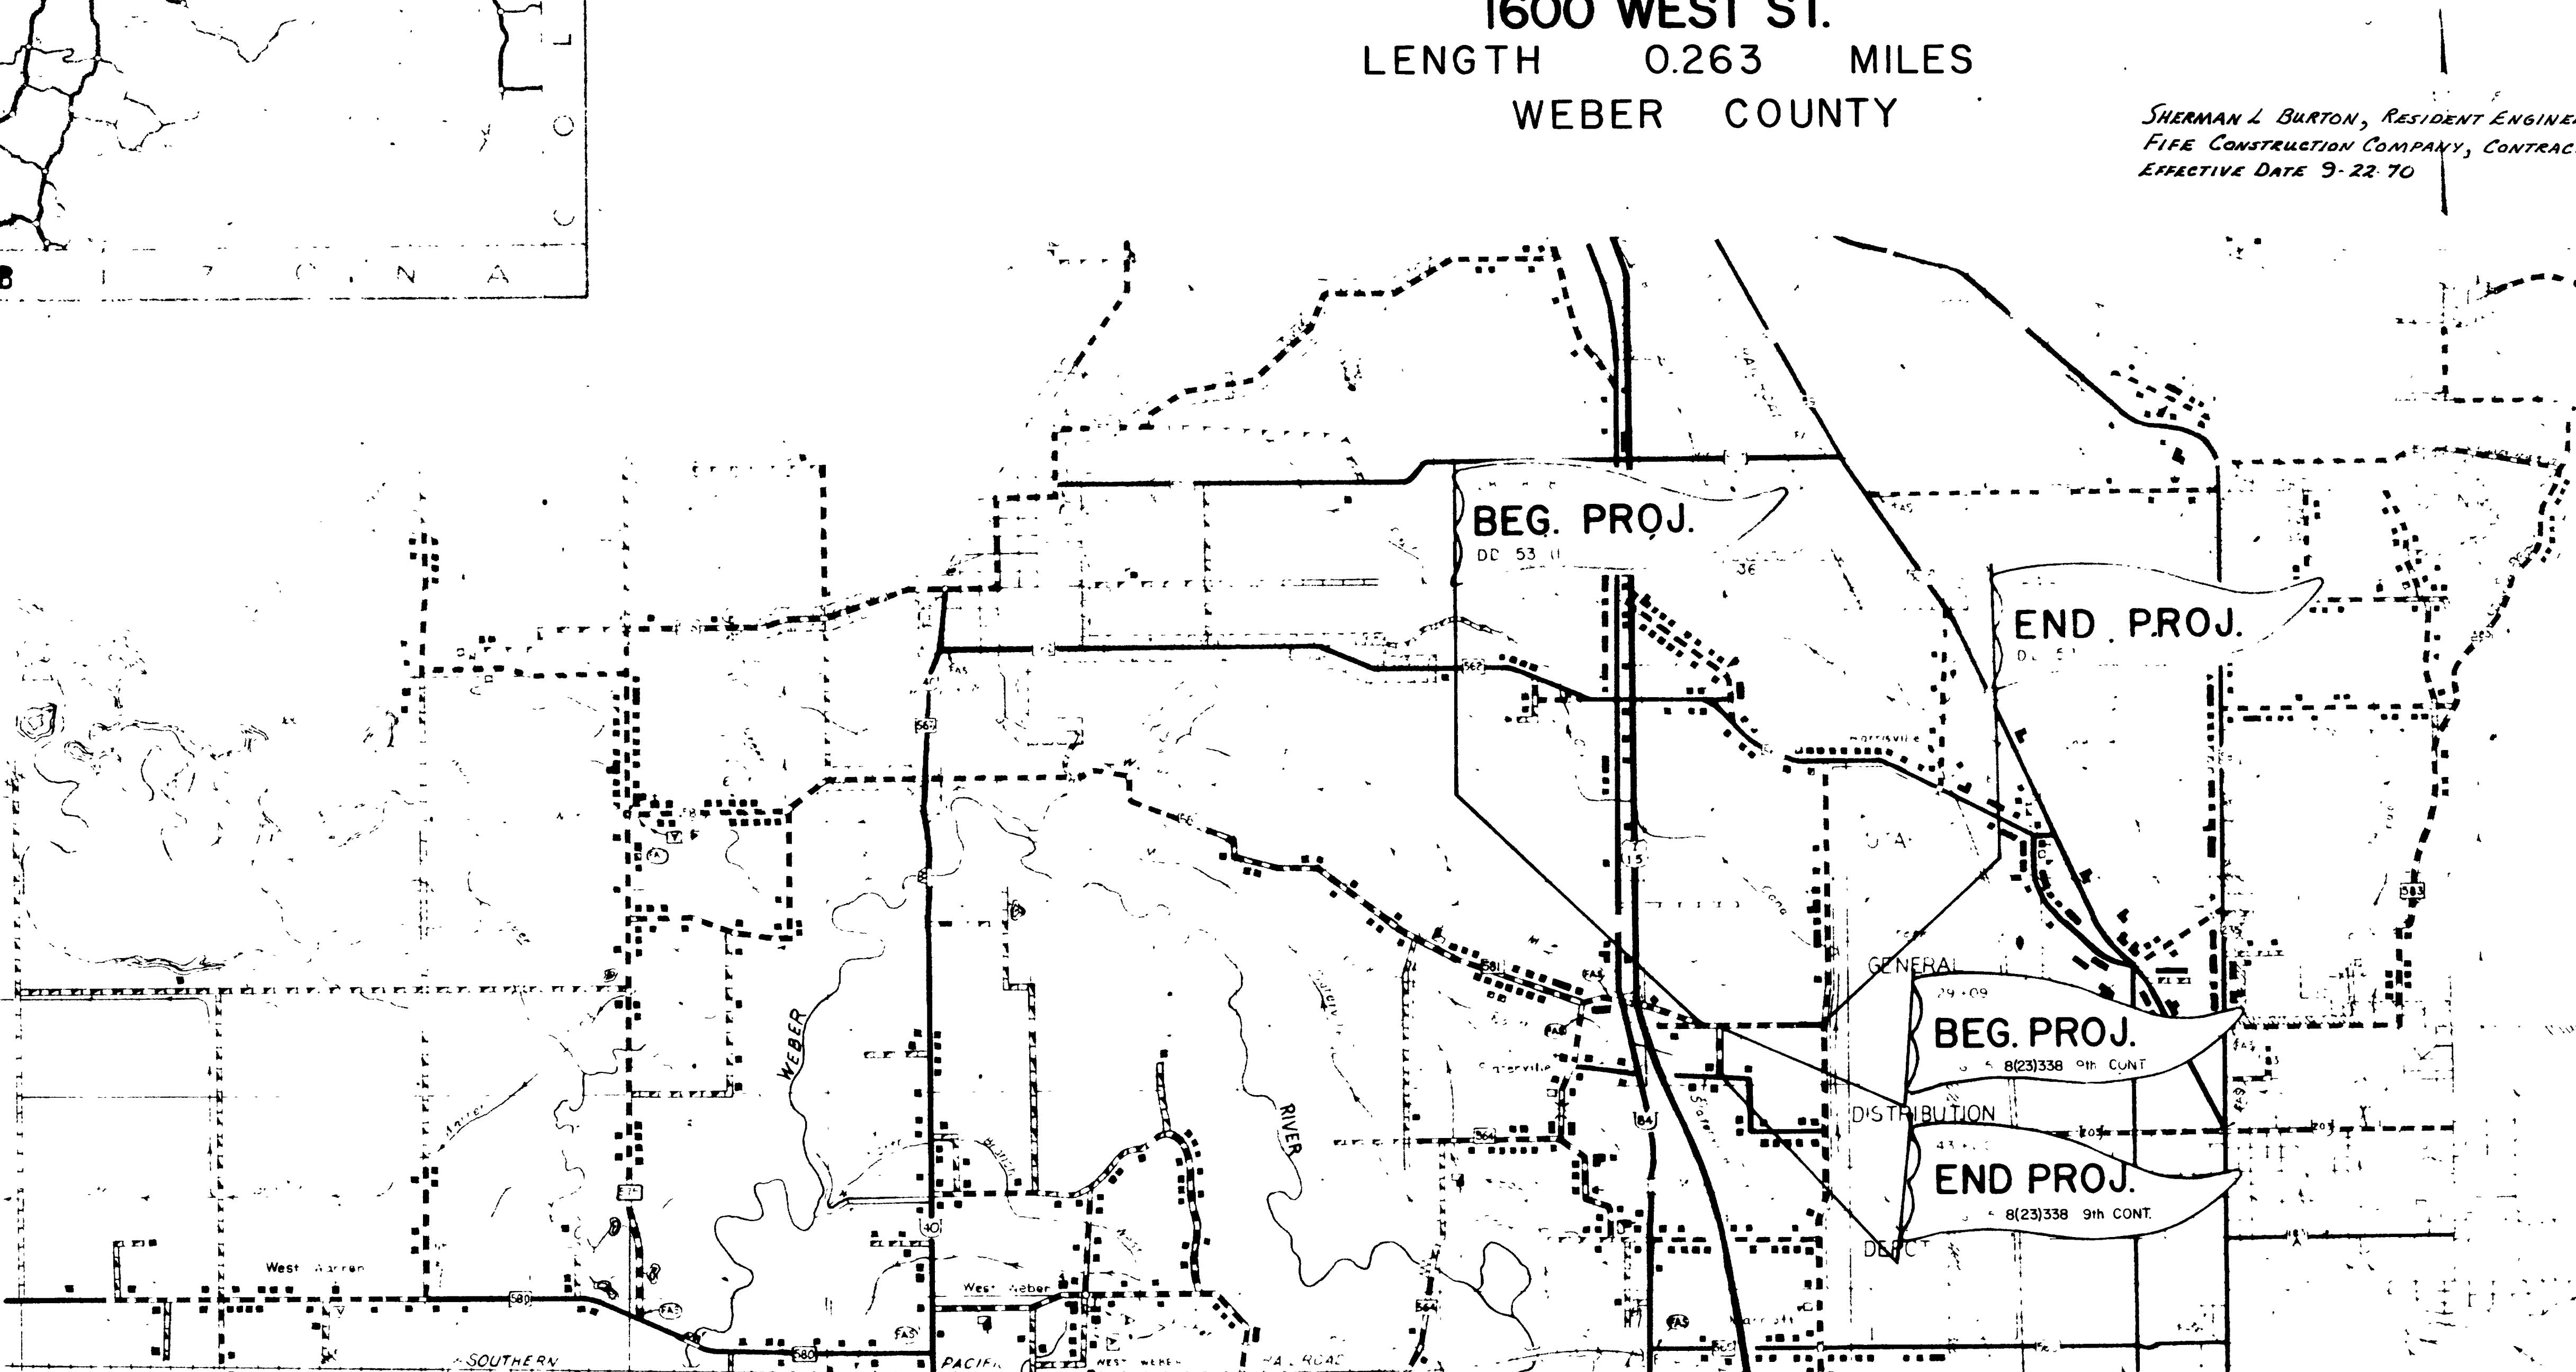

FED ROAD DIST NO	STATE	PROJECT NO	FISCAL YEAR	HEET NO	TOTAL SHEETS
UTAH	UTAH	DD-53(I)		I	
UTAH	UTAH	I-IG-15-8(23)338		I	

9th CONTRACT

INDEX TO SHEETS ON DD-53(I)

Sheet No	Description	Drawing No
1	TITLE SHEET	
2	TYPICAL CROSS SECTION	
3-5B	SUMMARY SHEETS	
4-6	PLAN PROFILE	
7	CHANNELIZATION	
8	SIGNING	
9	STANDARD CLEANOUT & JUNCTION BOXES	V-777
10	STANDARD HEADWALL	V-532

INDEX TO SHEETS ON I-IG-15-8(23)338 9th CONT.

Sheet No	Description	Drawing No
1	TITLE SHEET	
2	TYPICAL CROSS SECTION	
3	SUMMARY SHEETS	
4	PLAN PROFILE	

STANDARD DRAWINGS APPLICABLE THIS PROJ.

DESCRIPTION	DRAWING NO.
SUPERELEVATION AND WIDENING	1605-1A, II
RAISED MEDIAN	165-5
CONSTRUCTION SIGNING	745-1A
CONSTRUCTION SIGNING	745-1B, C, D
CONSTRUCTION SIGNING	745-6F
CONSTRUCTION IDENTIFICATION	745-6
PROJECT & R/W MARKERS, GUIDE, POST & MAIL BOXES	725-1
DIVERSION BOX	650-1
DIVERSION BOX	650-2
CONCRETE CURB AND GUTTER	615-1
METAL CULVERT END SECTIONS	605-2
REINFORCED CONCRETE CULVERTS	605-20
R/W FENCE & GATES	720-1
METAL CULVERTS	605-1
CHAIN LINK FENCE	720-3
EXIT & ENTRANCE RAMP DELINEATION	726-1
HIGHWAY SIGN STANDARDS INTERSTATE SYSTEM	745-20A
HIGHWAY SIGN STANDARDS INTERSTATE SYSTEM	745-20B
HIGHWAY SIGN STANDARDS INTERSTATE SYSTEM	745-20C
ROUTE MARKERS INTERSTATE SYSTEM	745-30
ROUTE MARKER AUXILIARIES INTERSTATE SYSTEM	745-31
GUIDE SIGN ARROWS (INTERSTATE)	745-40
TYPICAL PAVEMENT MARKINGS (FREEWAY SYSTEM)	745-41
GROUND MOUNTED SIGNS INSTALLATION DETAILS	745-50A
GROUND MOUNTED SIGNS INSTALLATION DETAILS	745-50B
GROUND MOUNTED SIGNS INSTALLATION DETAILS	745-50C
GROUND MOUNTED SIGNS INSTALLATION DETAILS	745-50D
GROUND MOUNTED SIGNS INSTALLATION DETAILS	745-50E

UTAH STATE DEPARTMENT OF HIGHWAYS  
RECOMMENDED FOR APPROVAL JANUARY 1970

CHIEF ROAD WAY DESIGN DIVISION  
RECOMMENDED FOR APPROVAL JANUARY 1970

ENGINEER FOR PRECONSTRUCTION  
APPROVED JANUARY 1970

STATE HIGHWAY ENGINEER

DEPARTMENT OF COMMERCE  
HIGHWAY & PUBLIC ROADS





APPROVED

DIVISION ENGINEER DATE


## TYPICAL CROSS SECTION

FED ROAD DIST.	STATE	PROJECT NO.	FISCAL YEAR	SHEET	TOTAL SHEETS
UTAH	UTAH	DD-53 (I)		2	

BITUMINOUS MATERIALS  
 BITUMINOUS MATERIAL GRADE AC-20 PEN. ASPHALT REQ'D IN MIX  
 BITUMINOUS MATERIAL GRADE MC-70 OR MC-250 REQ'D FOR PRIME COAT  
 BITUMINOUS MATERIAL GRADE RC-70 OR RC-250 REQ'D FOR FLUSH COAT & TACK COAT  
 BITUMINOUS MATERIAL GRADE AC-PM PEN. ASPHALT REQ'D IN SEAL  
 BITUMINOUS MATERIAL GRADE SS-1 EMULSION (S.A. #1)

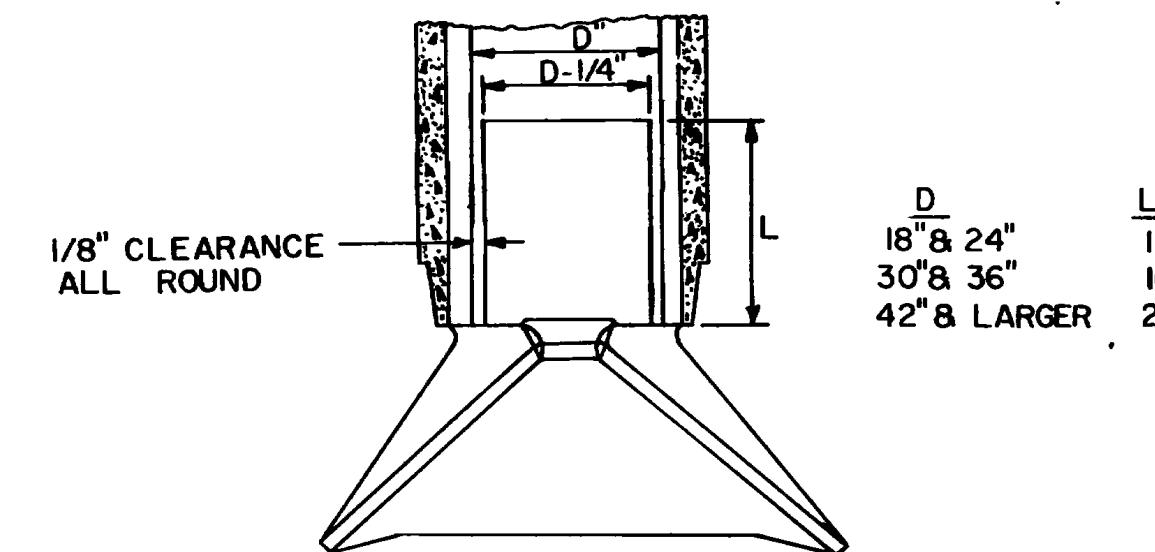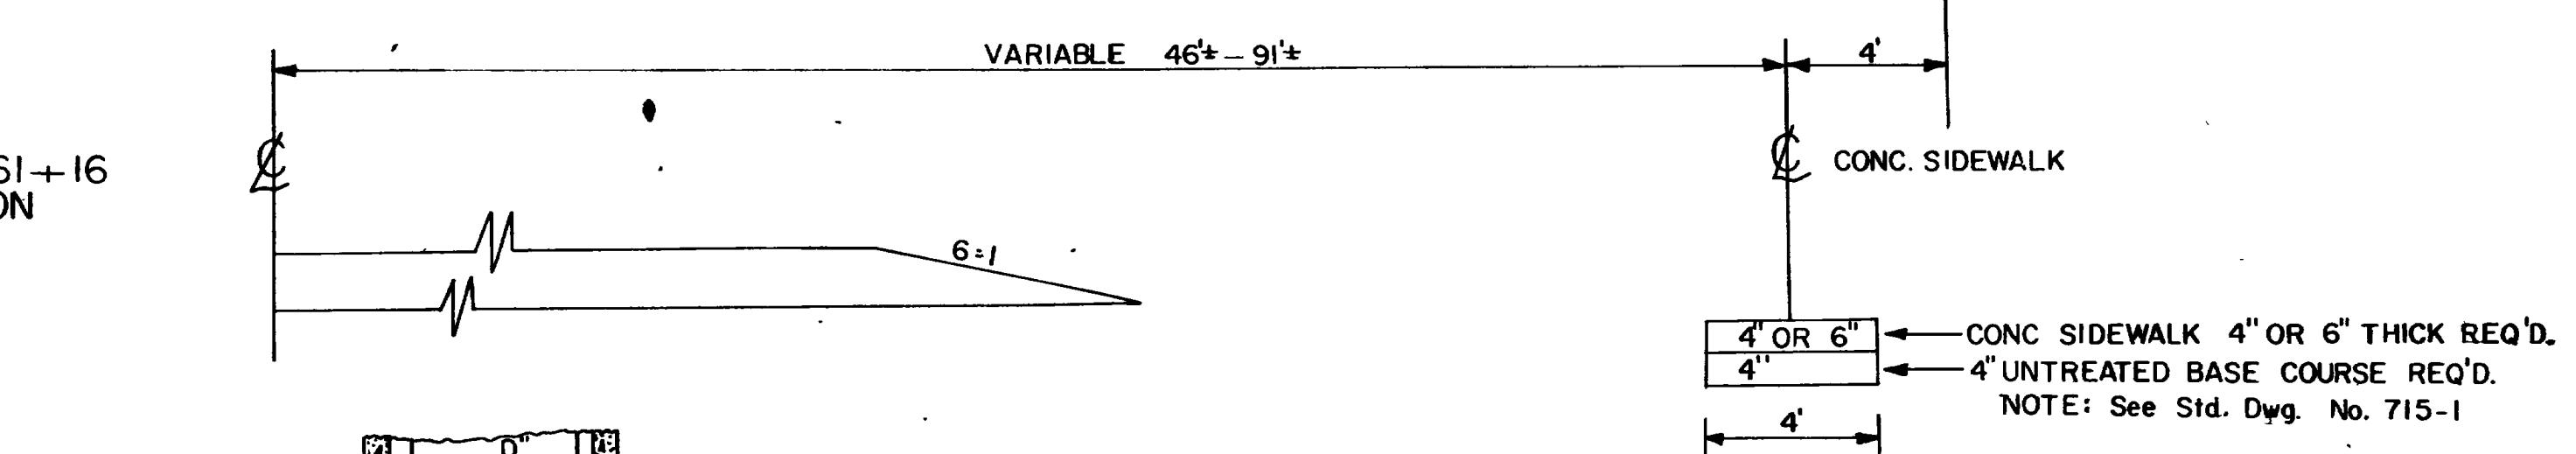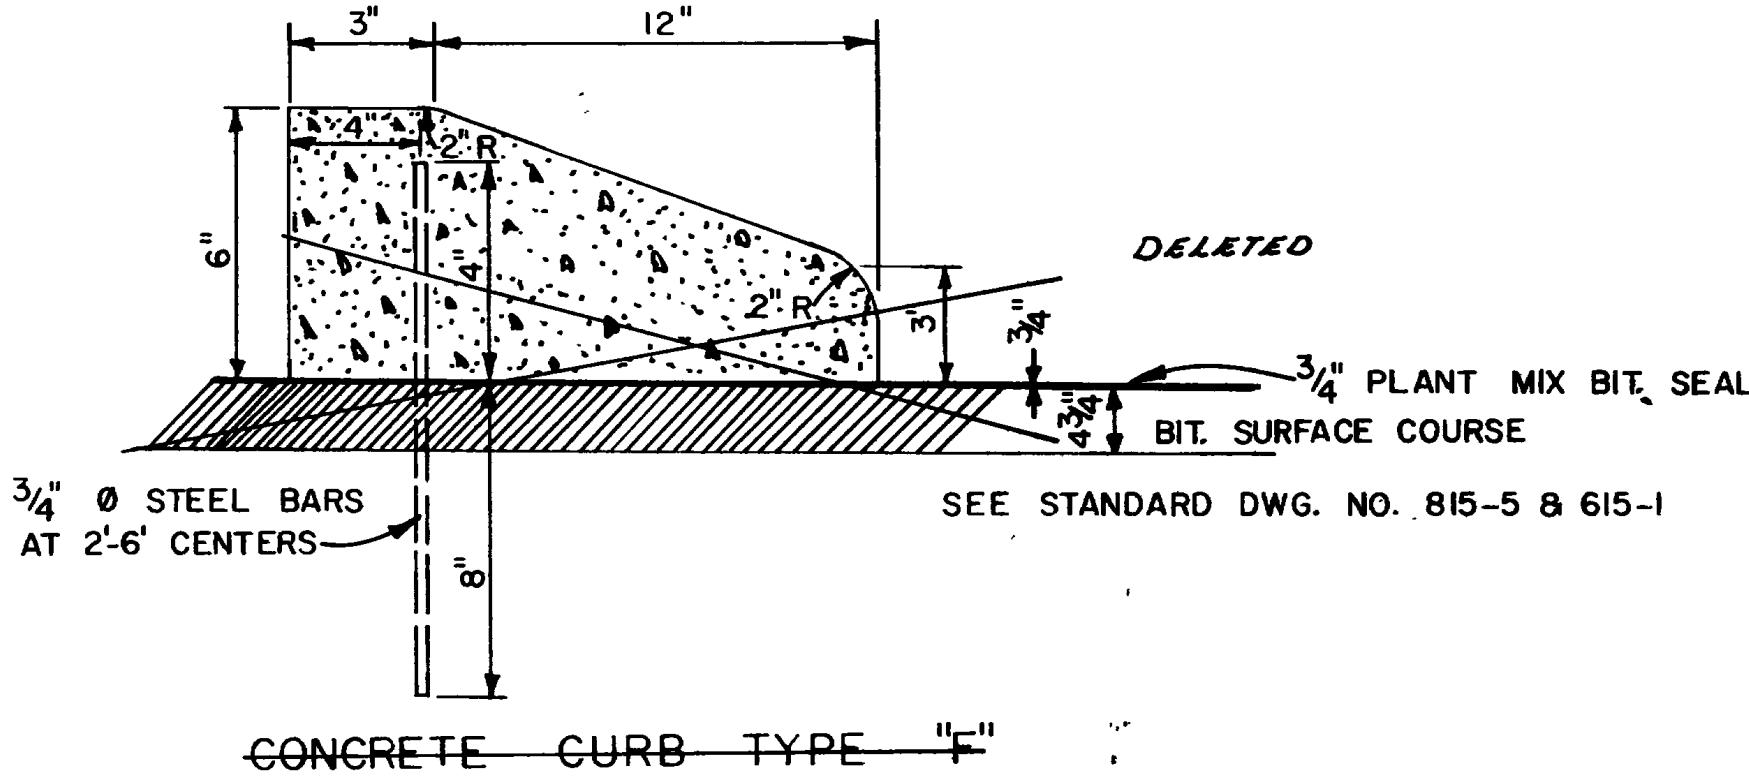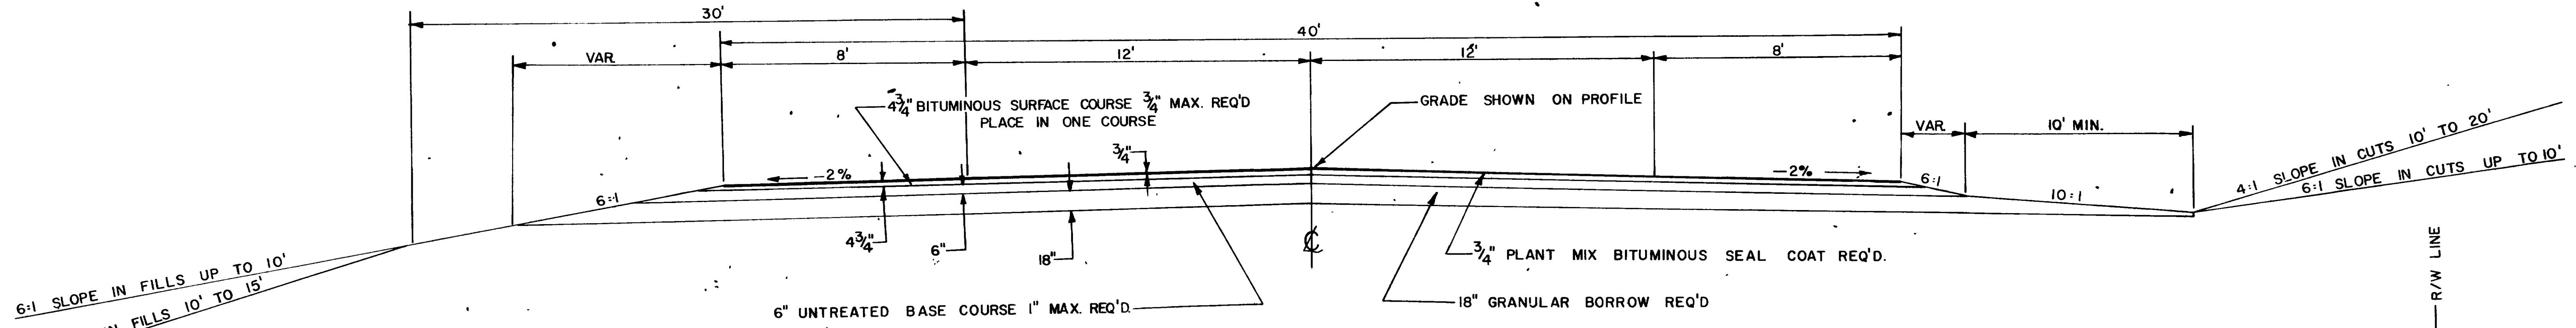

STEEL END SECTION FOR CONCRETE PIPE

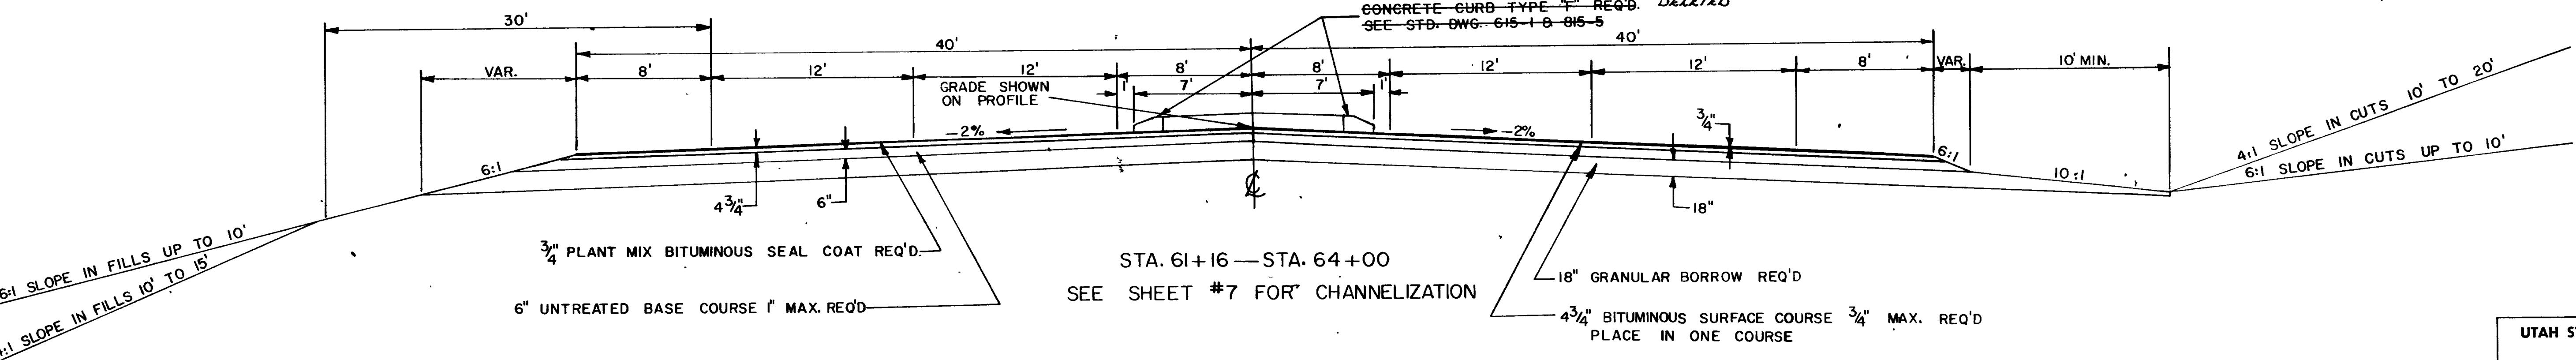

# SUMMARY SHEET NO.

1	1	1	1	1
UTAH	UTAH	DD-53(II)	3	1

## LIST OF STRUCTURES

STATIONS	IN PLACE	HEIGHT OF FILL NET →	C.S. PIPE	R.C. PIPE	CSP ARCH	PIPE CULVERT	END SECTIONS	DELIN. CULV.	RIP	SMALL EXC.	BACK- FILL	CLASS "A"	REINF. STR.	LINE DWG	CONSTRUCTION	REMARKS		
			12"	24"	18"	24" 22"x13" 18"	18"	CSP.A	22x13	RAP	DITCH FOR EXC. STR.	FILL	LONG. AE	STEEL STEEL	NO NO	FFL	BOOK	
29+32			250					1 + 4	48	68 99		3	7	LT.				
29+73		2	8						0.2	11		3	4	RT. END SECTION\$ REQD.				
33+06									45	22 105 131 134 139		3	12	LT. CATCH BASIN				
33+24-33+96												3	16	LT.				
33+40-50+00												3	21	S.D. LT.				
33+15												3	24	LT. HEADWALL				
33+21												3	29	LT.				
33+26-36+70												3	31	EXTEND LT.				
36+70		3										3	34	RT.				
36+84-41+70												3	33	RT.				
37+03												3	33	RT.				
37+70												3	75					
41+71												3	71					
41+69												3	37	S.D. LT.				
31+81-32+05												DELETED		SD. END SECTION\$ REQD.				
33+36-33+60												3	43	DIVERSION STRUCTURE LT. R-S(W)-UV-V,S DIBBZ				
44+20												22	21 0745 83 67	650+12				
44+20												29	12 06 54 217					
44+30												52	73	3	47	S.D. LT.		
44+44												04	22	3	78			
34+34-34+50												22	4 176	3	50	SD. LT. IRRIG.		
46+81												106.0	99					
47+50-47+87																		
49+96													6.4					
50+05													21	53	IRRIG.			
49+96													36.2	372	3	53		
50+05													56.7	269	3	56		
49+96													3.2	2.7 1030 90 70				
50+05													49	0.6 0.3 26 229	650+12	3	59	DIVERSION STRUCTURE LT. S-U(W)-UV-R YYY
49+96													3.3	2.8 1260 134 474	3	62	RT CATCH BASIN	
50+05													4.5	2.4 1260 134 474	3	77	V-777	
49+99													38.0	117	3	66	EXTEND S.D. RT.	
50+22													49					
52+08	DELETED													20-				
TOTAL																		
USE																		

## SUMMARY OF ITEMS

ITEM	UNIT	QUANTITY	ITEM	UNIT	QUANTITY
MOBILIZATION	LUMP	•100%	PLANT MIX BIT SEAL COAT	TON	801.0
FLAGGING	MN.HR.	305.0	BIT MATERIAL GRADE AC-PM	CU.YD.	50.82
ROADWAY EXCAVATION	CU.YD.	7600	36" STOP TYPE C-2 SIGN	EACH	3.0
EXCAVATION FOR STRUCTURES	CU.YD.	172.2	30" x 30" TYPE C-2 SIGN	EACH	2.0
BACKFILL	CU.YD.	158.0	24" x 30" TYPE C-2 SIGN	EACH	2.0
COMPACTION	CU.YD.	8458	96" x 32" TYPE C-2 SIGN	EACH	4.000
WATERING	M.GAL.	550	AUXILIARY TYPE C-2 SIGN	SQ.FT.	0.00
RIGHT OF WAY FENCE TYPE "B" (METAL POSTS)	LIN.FT.	5273	S.A. NO.1 BITUMINOUS MATERIAL TYPE SS-1 EMULSION	TON	6.25
10' GATES	EACH	5344			
12' GATES	EACH	4			
16' GATES	EACH	2			
12" C.S. PIPE	LIN.FT.	72.0			
24" C.S. PIPE	LIN.FT.	38.0			
18" R.C. PIPE	LIN.FT.	40			
24" R.C. PIPE	LIN.FT.	104.0			
18" PIPE CULVERT	LIN.FT.	120			
18" PIPE CULVERT END SECTIONS	EACH	0.0			
22" x 13" C.S.P. ARCH END SECTIONS	EACH	2			
UNTREATED BASE COURSE 1" MAX	TON	8044.3			
BIT. SURFACE COURSE 3/4" MAX.	TON	5300.9			
BIT. MATERIAL, GRADE MC-70 OR MC-250	TON	33.27			
S.A. #1	25				
BIT. MATERIAL, GRADE RC-70, OR RC-250	TON	0.0			
BIT. MATERIAL, GRADE AC-20 PEN ASPHALT	TON	278.97			
SMALL DITCH EXCAVATION	CU.YD.	337.0			
CONC. CURB TYPE "F"	LIN.FT.	538			
MOVING & RESETTING FENCE	LIN.FT.	770			
R/W MARKERS	EACH	16.00			
DELINERATORS	EACH	0.0			
MOVING MAIL BOXES	EACH	3.00			
MOVING STREET SIGNS	EACH	1.00			
CONC. MEDIAN FILLER (4" THICK)	SQ.YD.	0.0			
REINFORCING STEEL	LB	99			
STRUCTURAL STEEL	LB	619			
PC CONCRETE, CLASS "A" (AE) (SMALL STRUCTURES)	CU.YD.	5470			
RECONST. CLEAN-OUT, MANHOLE, MON. BOX	EACH	8.000			
LOOSE RIPRAP	CU.YD.	14			
GRANULAR BORROW	TON	4.18			
HIGHWAY TRAFFIC PAINT	GAL.	6			
CONCRETE SIDEWALK 4" THICK	SQ.YD.	27284.0			
REMOVAL OF CONCRETE PAVEMENT	SQ.YD.	25,600			
22" x 13" C.S.P. ARCH	LIN.FT.	181.0			
CONCRETE PAVEMENT OR CONCRETE SIDEWALK 6" THICK	SQ.YD.	192			
		16.7			
NOTE QUANTITIES SHOWN ON THESE PLANS ARE FOR ESTIMATING PURPOSES ONLY					
I HEREBY CERTIFY THAT THE QUANTITIES SHOWN HERE ARE TRUE AND CORRECT.					
<i>Sherman L. Burton</i> SHERMAN L. BURTON RESIDENT ENGINEER					

# SUMMARY SHEET NO

		DD-53 (1)		3A	

## **SURFACING**

## **FENCE & GATES**

STA TO STA.	TYPE "B" METAL POST		GATES			CONSTRUCTION SOURCE REFERENCE	
	LEFT	RIGHT	10'	12'	16'	FIELD BOOK	PAGE
	LIN. FT	LIN FT	EACH	EACH	EACH		
23+51 - 29+20 21+02.46 29+52.03	558 770		SALVAGE & RESET			5	3
33+08 - 46+82 33+10 47+10	1320 1100					"	4
33+15					I-LT	"	4
36+97 - 50+12 36+90 49+08		1,299 1,218				"	5
44+20					I-LT	"	4
44+44			2-LT.			"	4
44+69 46+95	235		Included in page #4				
47+89 - 50+12 47+95 50+10	224 215					"	7
49+16					I RT	"	5
49+20 50+12		84	Included in page #5				
52+06 51+44.03				1 RT.	"	9	
51+84 - 55+46 52+16 55+44		336 344		1 RT.	"	10	
51+93 - 53+88 52+20 53+86	178 160				"	9	
54+00					"	10	
54+97				2 RT.	"	11	
53+88 - 58+77 54+05 58+70	461 465				"	11	
55+54 55+29					1 RT.	"	9
56+83 - 58+92 56+85 58+90		210 205				"	12
58+77 - 59+50 58+85 59+50	59 63					"	13
58+48					I-LT	"	13
59+00 58+92						"	12
60+37 63+42 60+50 63+46	322 304					"	14
59+00 63+40		455					
59+08 63+39 63+39 LT. 63+42 LT.		448 209				"	15
TOTAL	3,042	2,302	4	?	7	"	16
USE	2,771	2,502	4	2	7		16
	5,344						

## MISCELLANEOUS SUMMARY

## **EARTHWORK SUMMARY**

## **WATERING, ROLLING & COMPACTION**

		CONSTRUCTION SOURCE REFERENCE
WATERING	FIELD BOOK	PAGE
2.980 + (31.206 x 0.54) 40	496 M.GAL	
USE	550 M.GAL	
"AS CONSTRUCTED QUANTITY" 903.0 M.GAL	5	54

## HIGHWAY TRAFFIC PAINT

HIGHWAY TRAFFIC PAINT		STL DRAW	
APPLICATION	FOR ESTIMATING PURPOSES ONLY	4" WHH	4" WHH
TYPE OF STRIPING	GAL PER MILE	MILE	GAL
<b>AS CONSTRUCTED QUANTITY</b>			
4" WHH WHH LINE	16.	68	117
SOLID & SKIP - WHITE SEE BOOK #5, PAGE 62			
4" SKH WHH LINE	6.	68	44
SOLID - YELLOW	"	"	"
4" WHH YELLOW LINE	16.		
<b>SUB TOTAL</b>		217	25.1
<b>TOTAL</b>		218	30.1
<b>USE</b>		30.1 GALS	

**(a-c) SEE SPECIFICATIONS**

(d) MOUNTING HEIGHT IS MEASURED FROM BOTTOM OF SIGN TO LEVEL OF PAVEMENT EDGE.



(e) COLOR CODE:  
B. BLUE, G. GREEN, W. WHITE, Bk. BLACK, Y. YELLO

# SIGN SUMMARY SHEET.

ED ROAD DIST NO	STATE	PROJ NO	FISCAL YEAR	SHEET NO	TOTAL SHEETS
UTAH	UTAH	DD-53(I)		3-B	


PLAN SURVEYED BY SHERMAN BURTON DATE 3-5-8  
PLOTTED BY SR WINTERBOTTOM 4-6-8  
NOTE BOOK GRADED CHECKED NO. 17288  
N.M. NOTED NO. 17288  
STRUCTURE ROTATNS CHD

PROFILE SURVEYED— SHERMAN BURTON 3-5-8  
PLOTTED— SR WINTERBOTTOM 4-6-8  
NOTE BOOK GRADED CHECKED NO. 17288  
N.M. NOTED NO. 17288  
STRUCTURE ROTATNS CHD

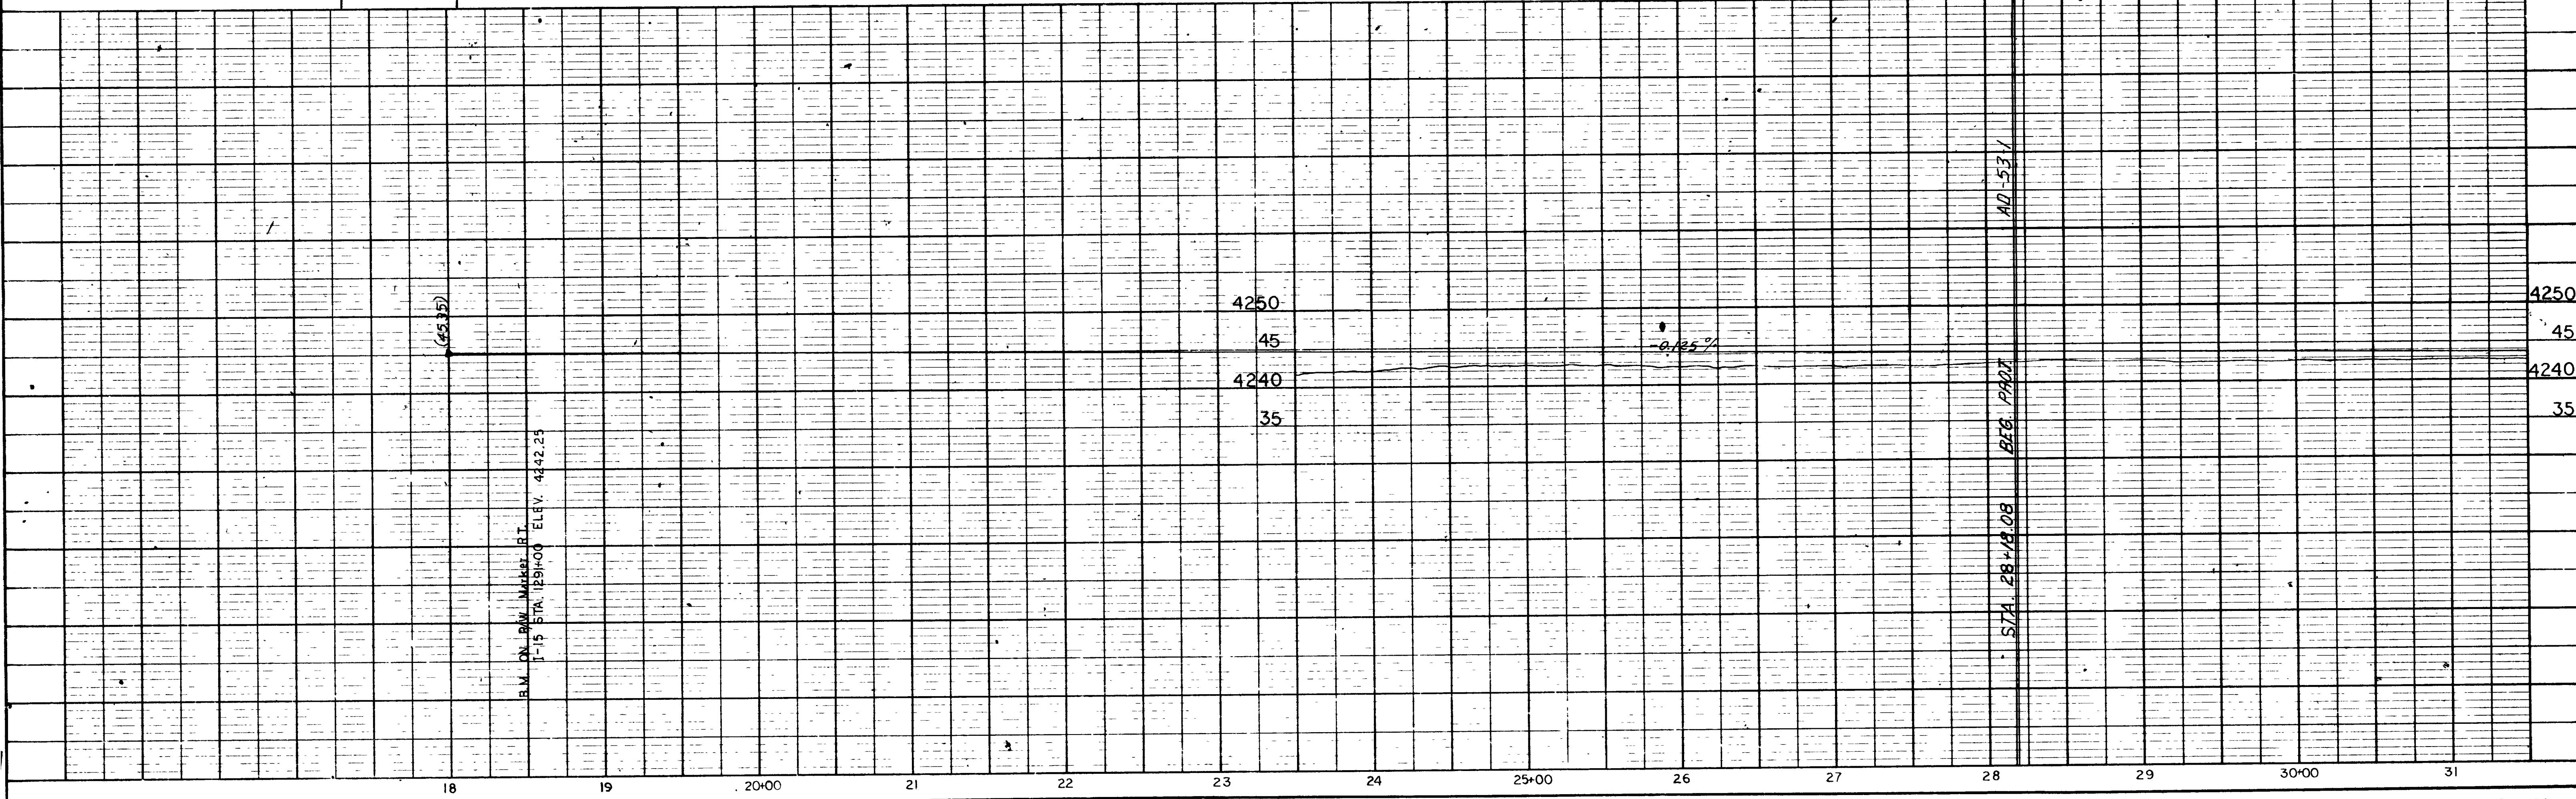
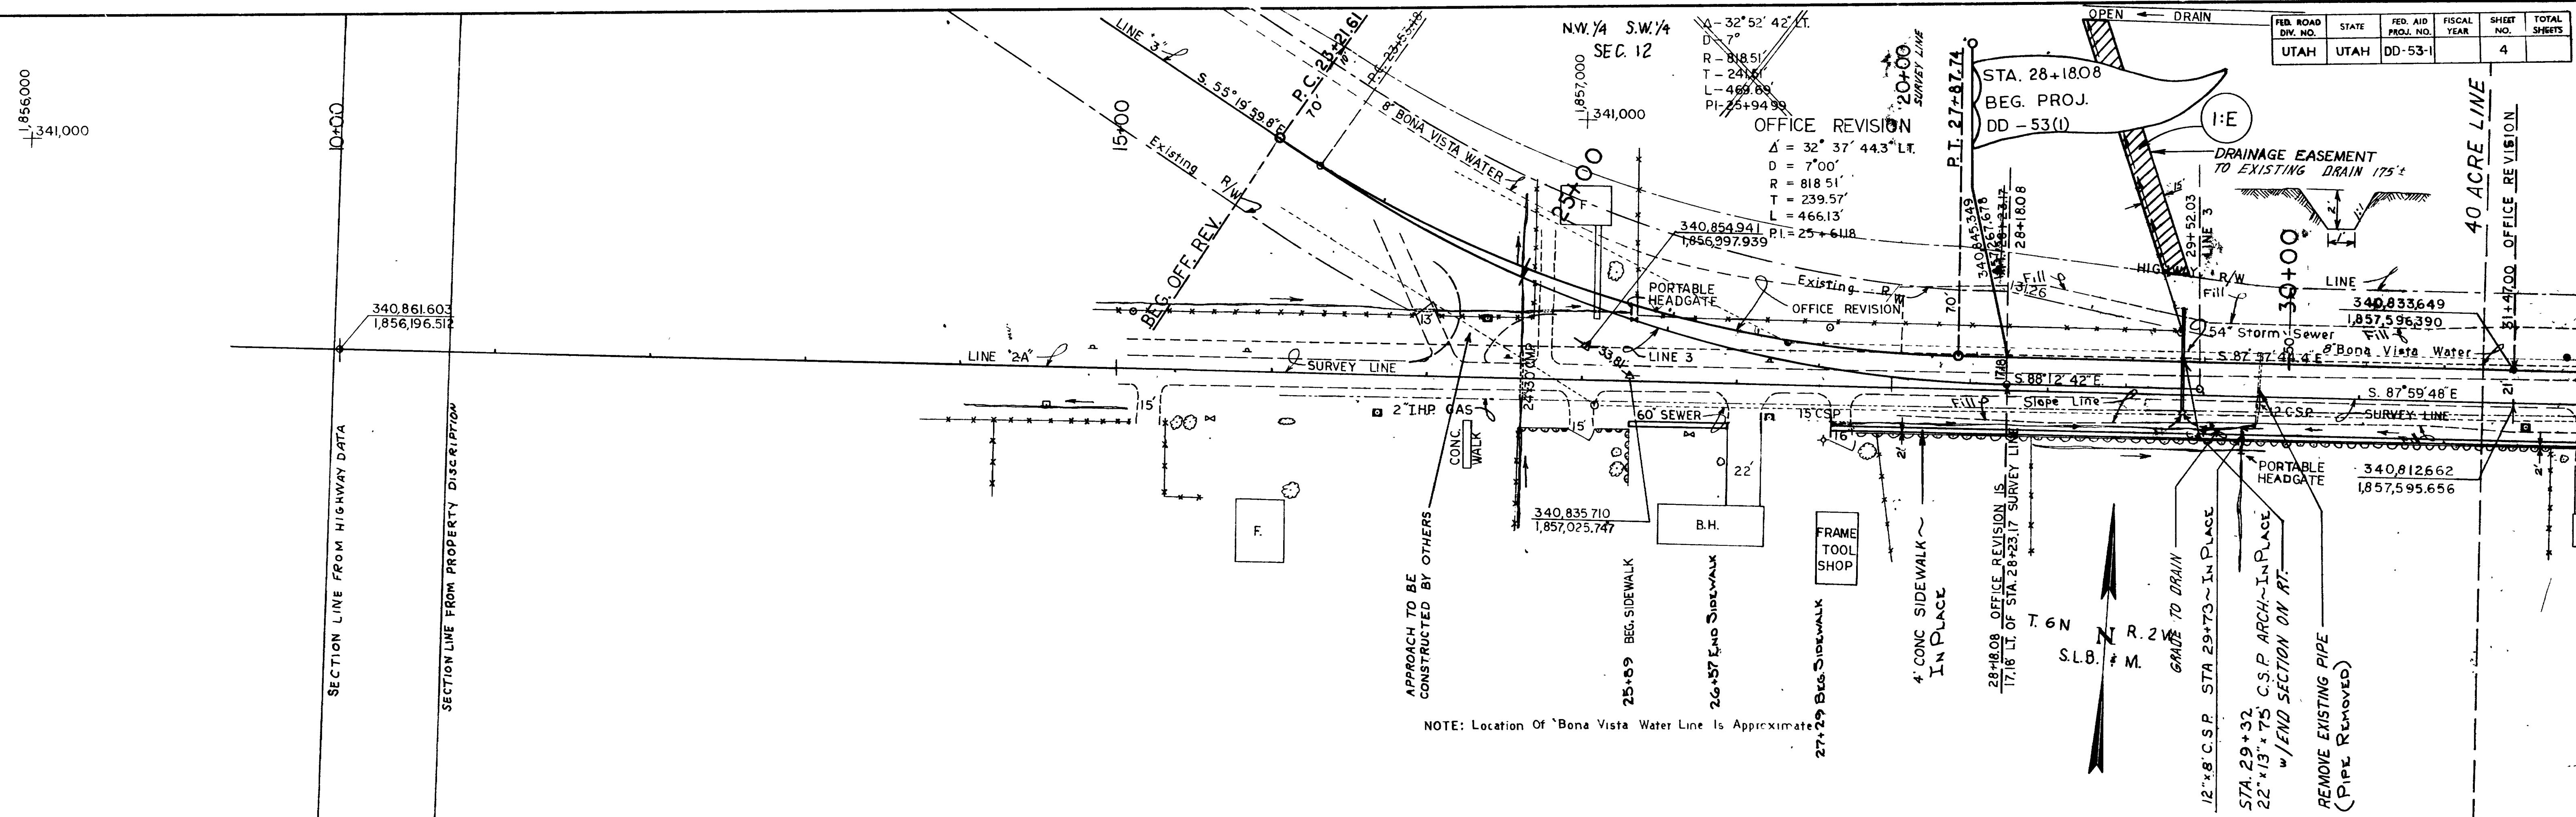



PLAN SURVEYED BY SHERMAN BURTON DATE 3-68  
PLOTTED BY SHERMAN BURTON 3-68  
NOTE BOOK NO. 17288 GRADES CHECKED  
STRUCTURE NOTATED CWD

PROFILE SURVEYED BY SHERMAN BURTON DATE 3-68  
PLOTTED BY SHERMAN BURTON 3-68  
NOTE BOOK NO. 17288 GRADES CHECKED  
STRUCTURE NOTATED CWD

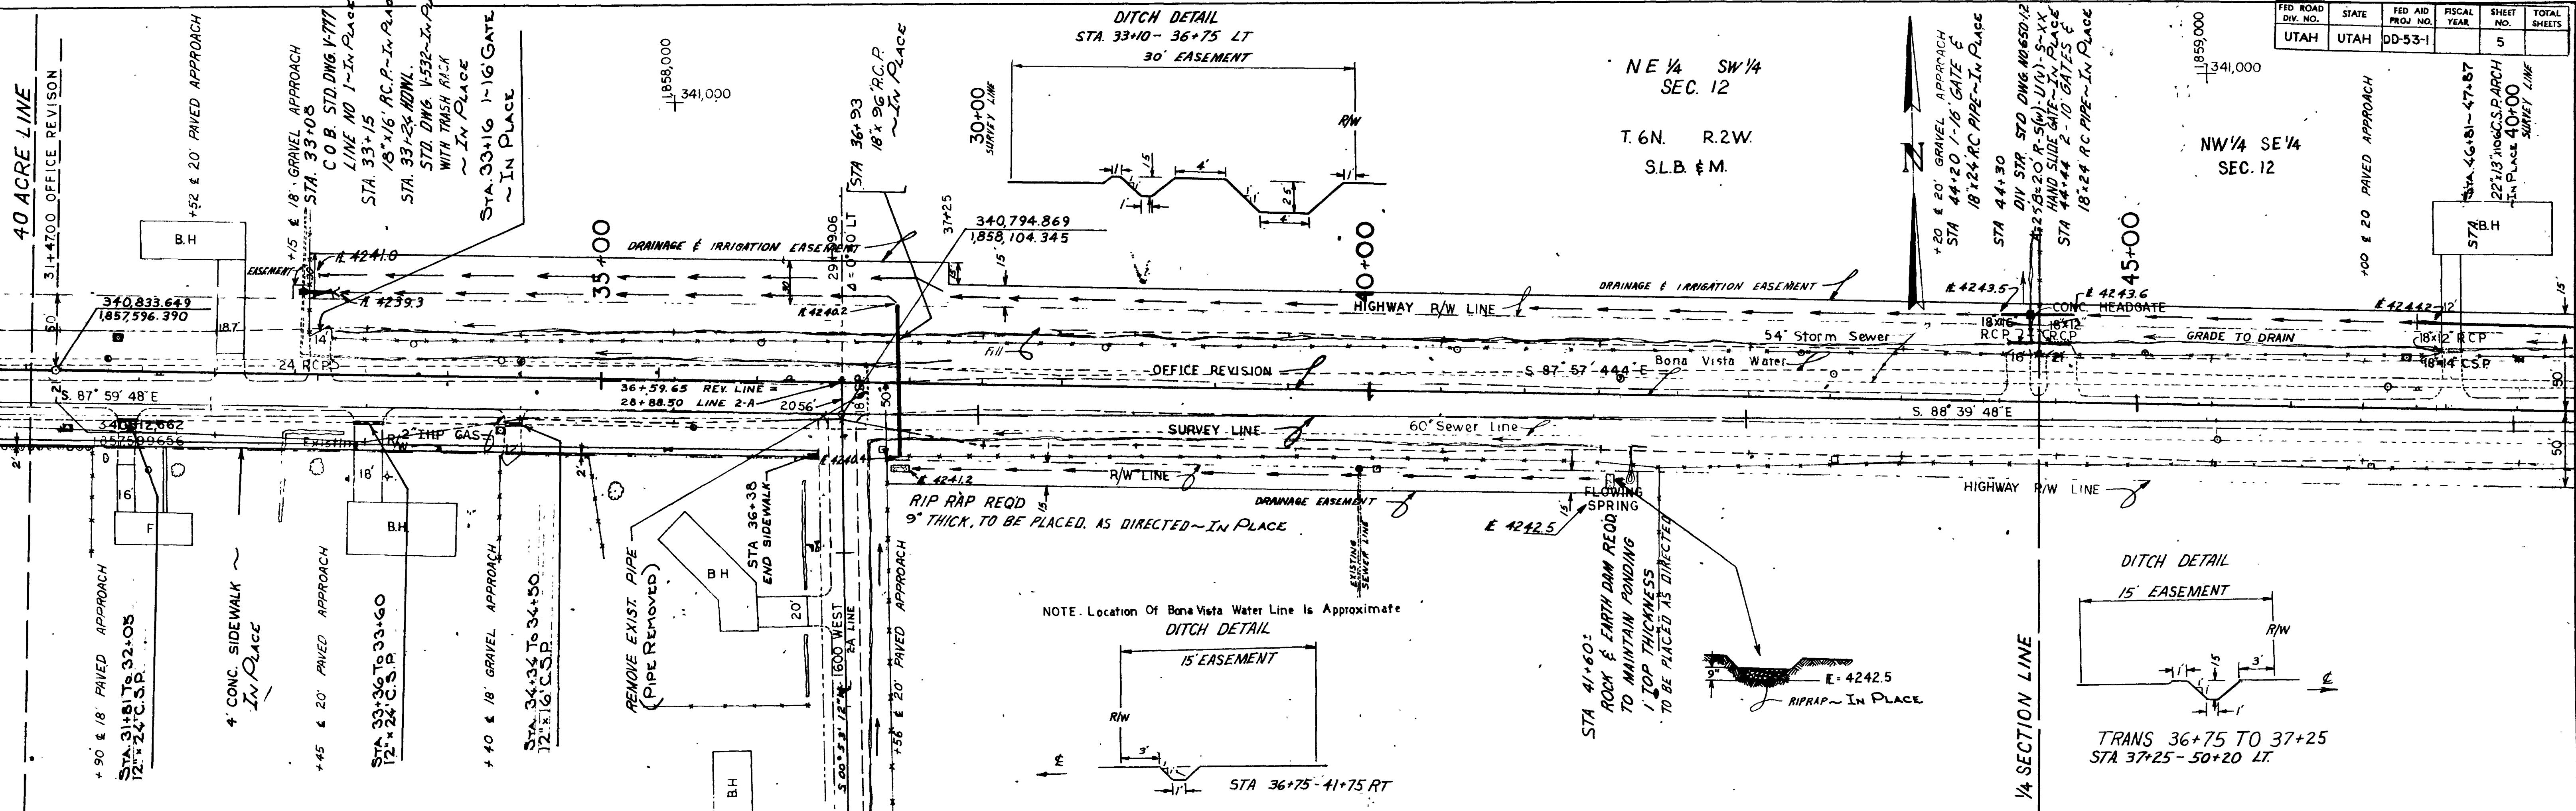


ED ROAD DIV NO	STATE	FED AID PROJ NO	FISCAL YEAR	SHEET NO	TOTAL SHEETS
UTAH	UTAH	DD-53(1)		6	

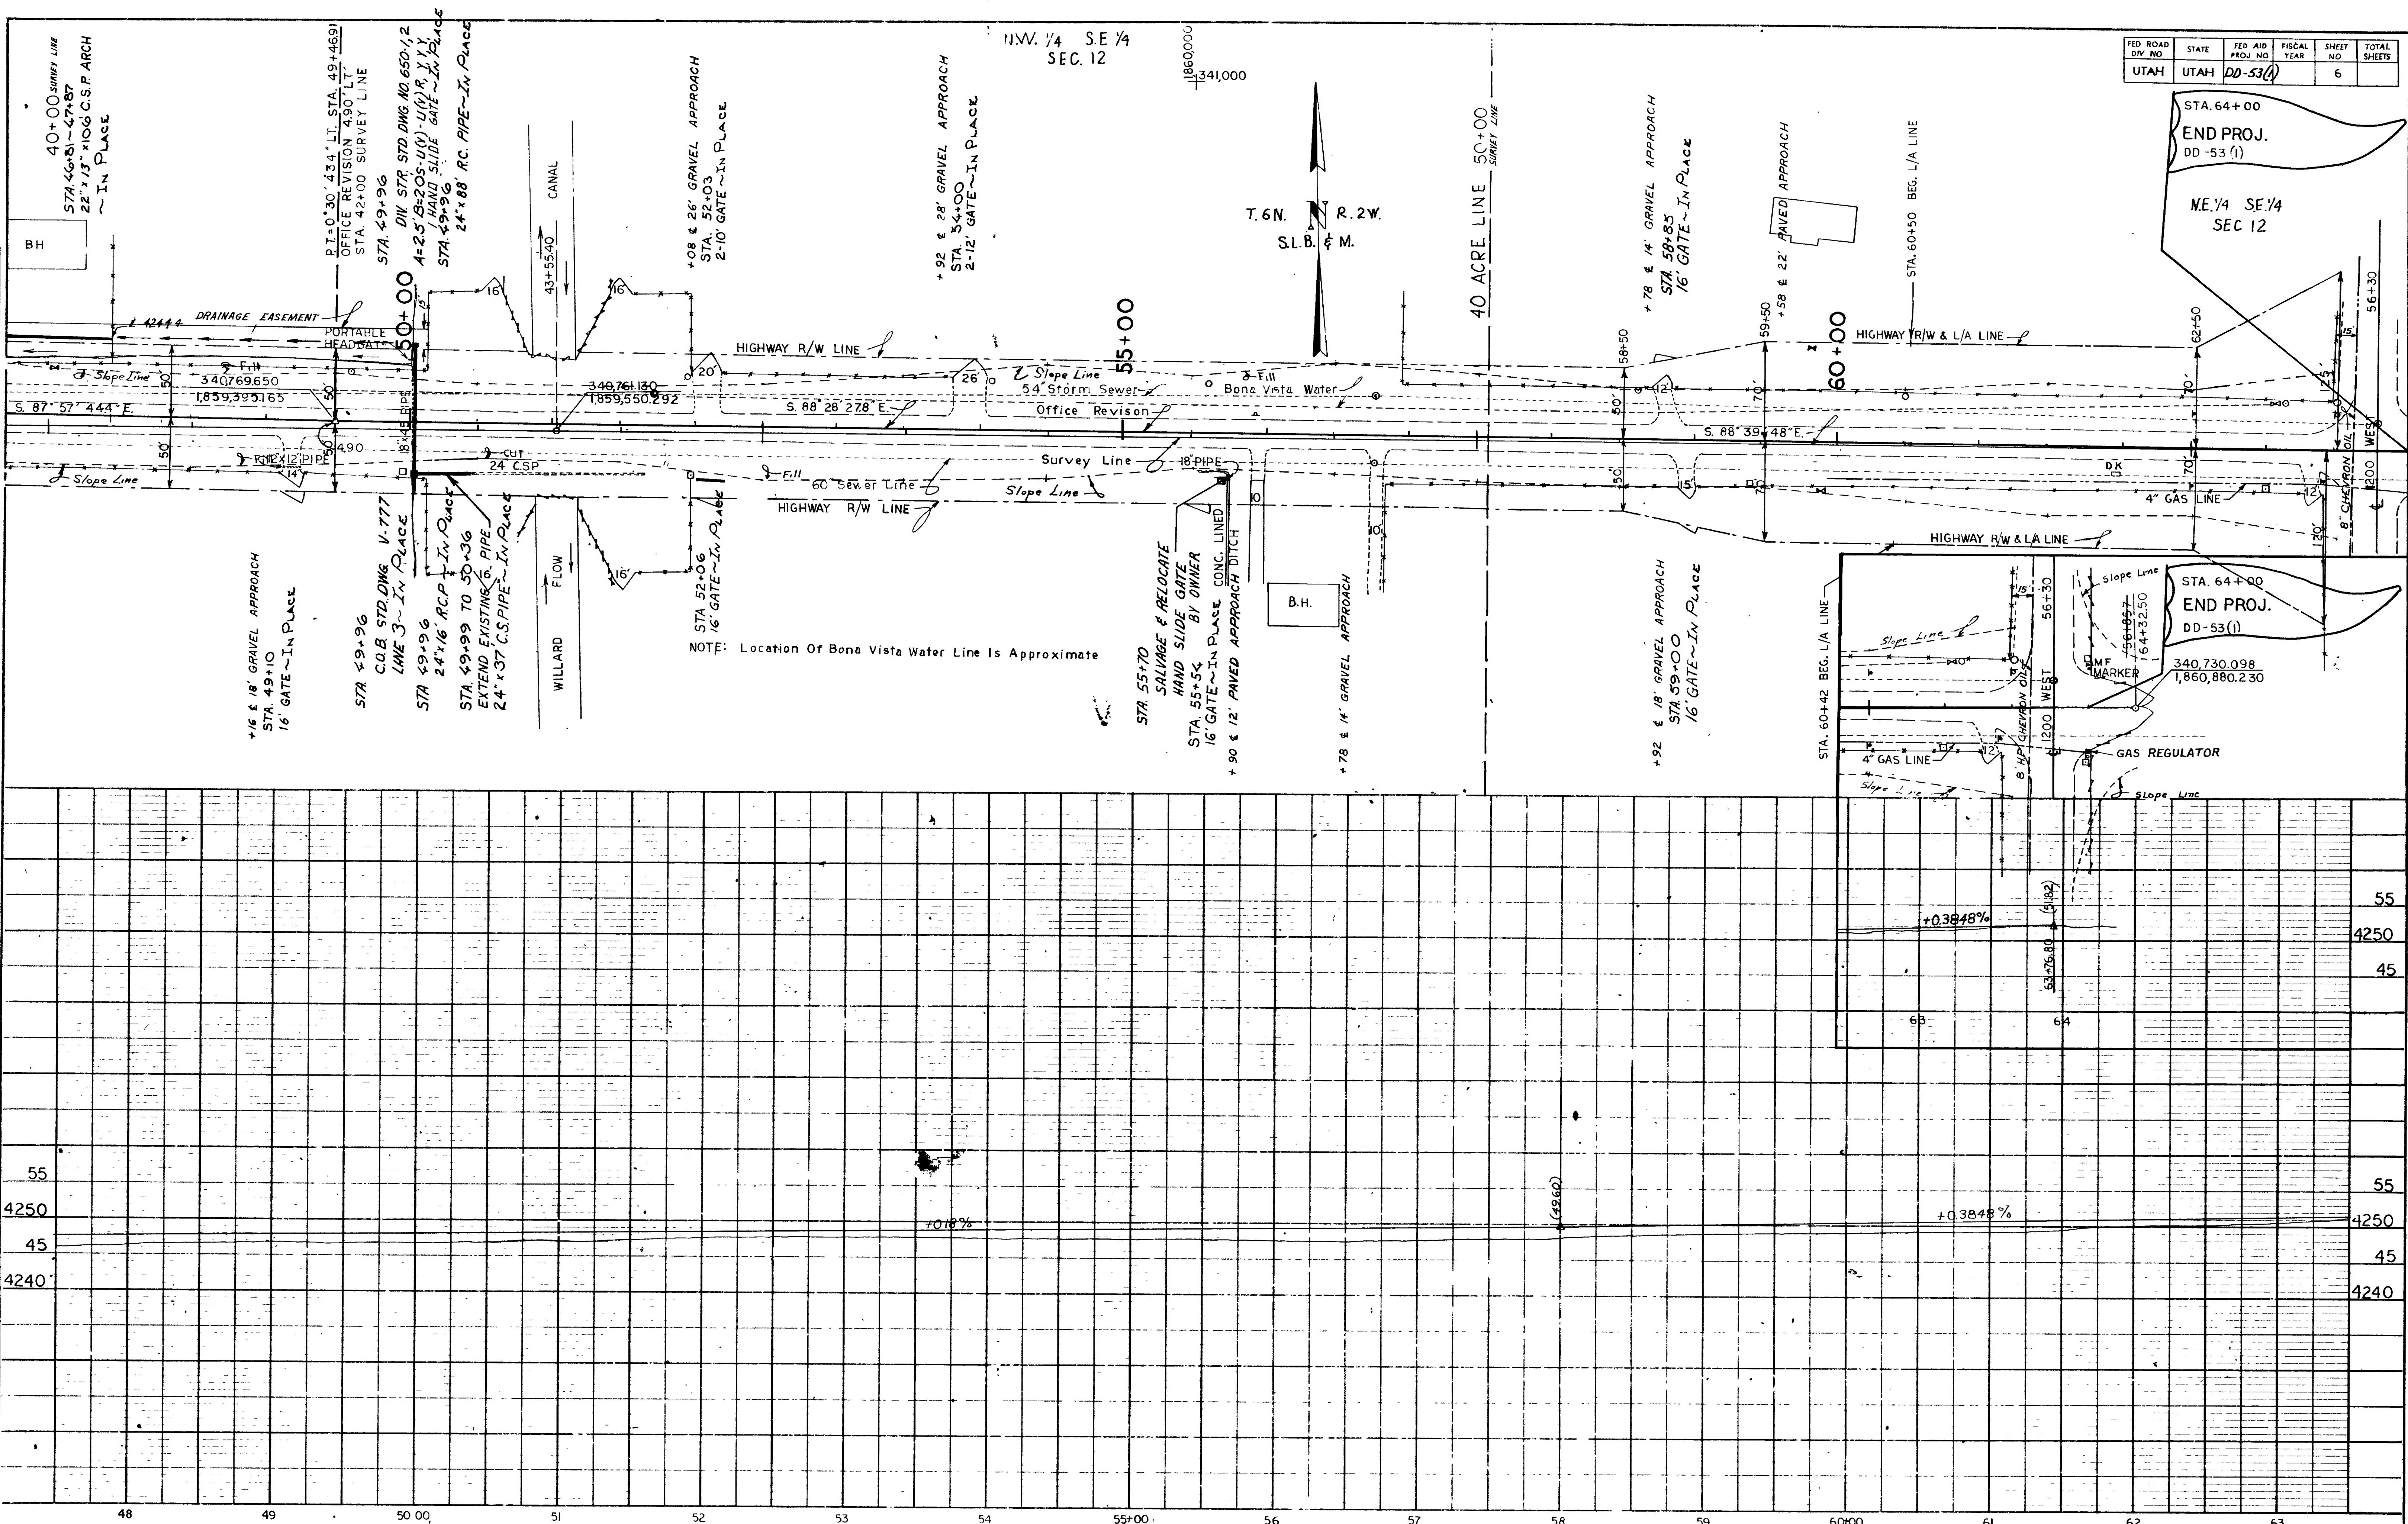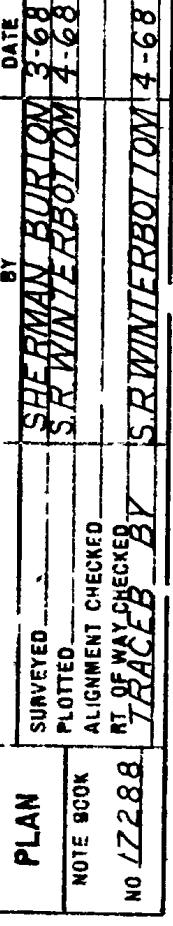

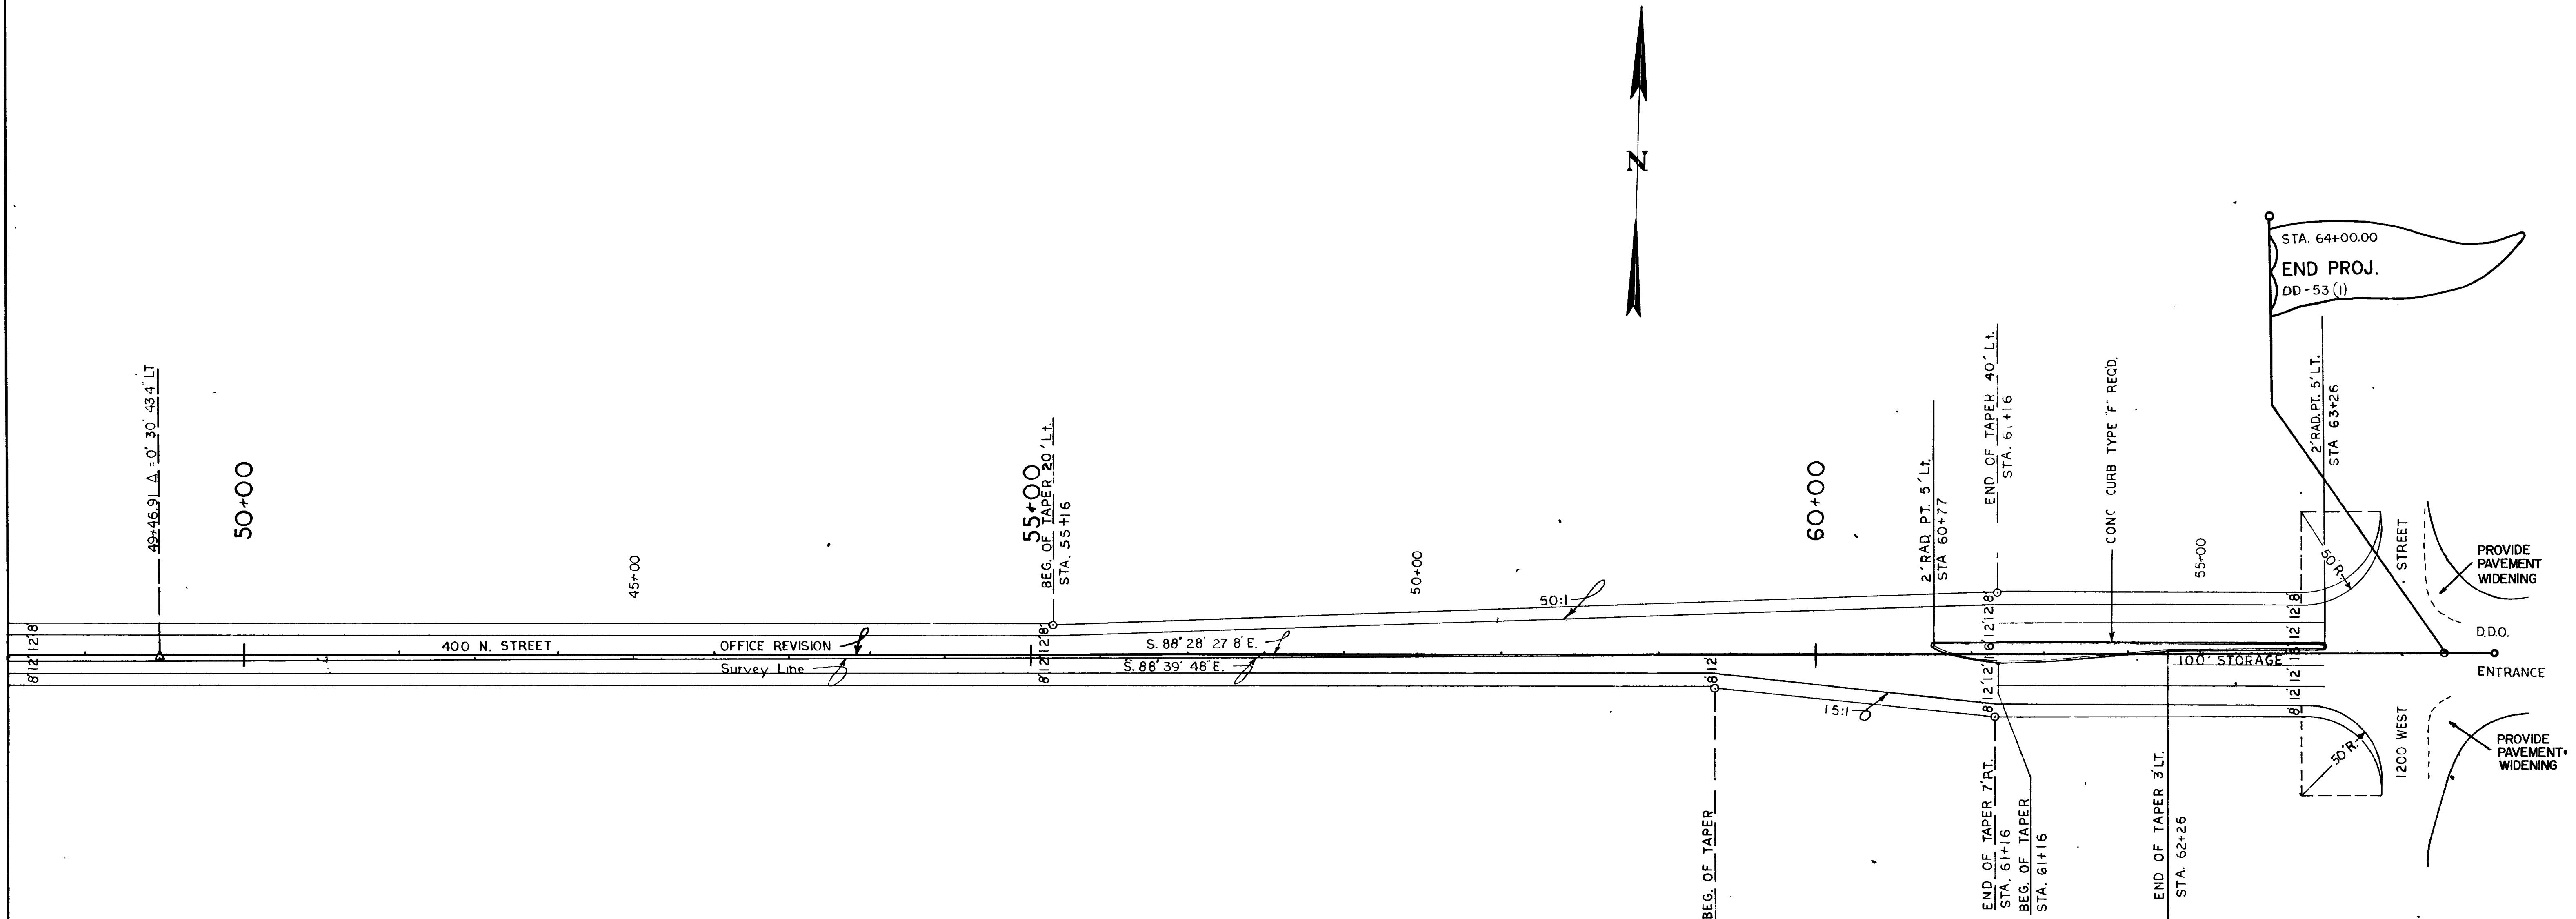

FED ROAD DIST NO	STATE	PROJ NO.	FISCAL YEAR	SHEET NO	TOTAL SHEETS
UTAH	UTAH	DD-53 (I)		8	

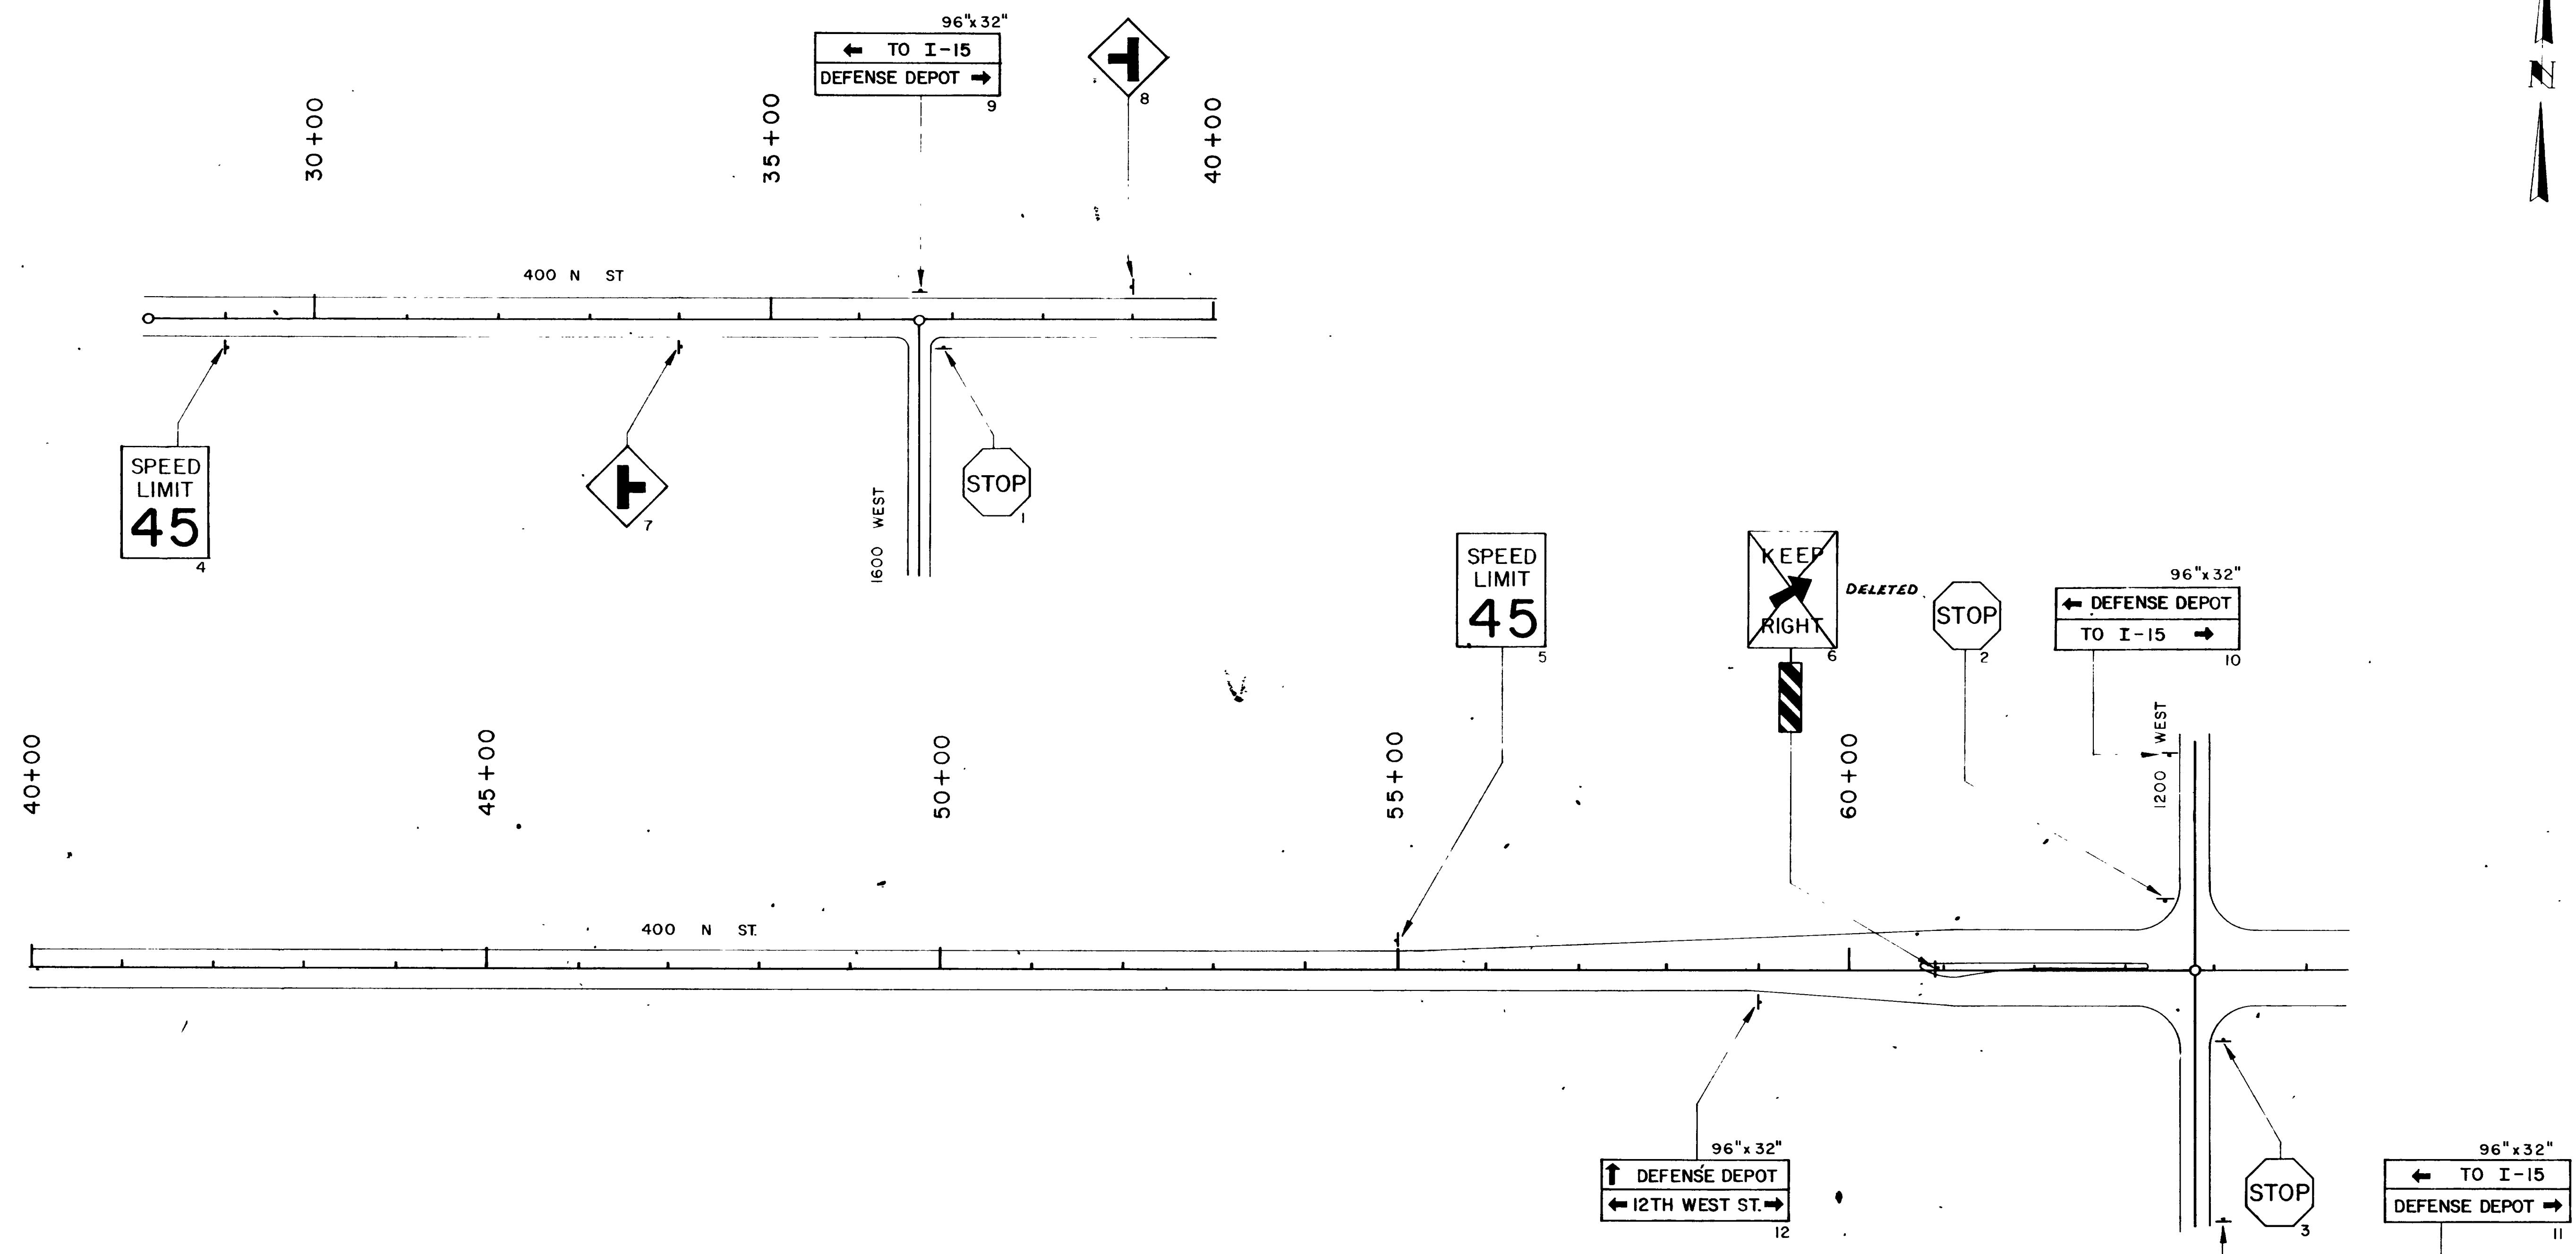

# TYPICAL CROSS SECTION



FED. ROAD L-# NO.	STATE	PROJECT NO.	FISCAL YEAR	SHEET NO.	TOTAL SHEETS
UTAH	UTAH	I-IG-15-8(23)338		2	

9TH CONTRACT

## BITUMINOUS MATERIALS

BITUMINOUS MATERIAL GRADE AC-20 PEN ASPHALT REQ'D. IN MIX  
 BITUMINOUS MATERIAL GRADE MC-70 OR MC-250 REQ'D FOR PRIME COAT  
 BITUMINOUS MATERIAL GRADE RC-70 OR RC-250 REQ'D FOR FLUSH COAT & TACK COAT  
 BITUMINOUS MATERIAL GRADE AC-PM PEN. ASPHALT REQ'D IN SEAL

BITUMINOUS MATERIAL GRADE SS-1 EMULSION (S.A. #1)

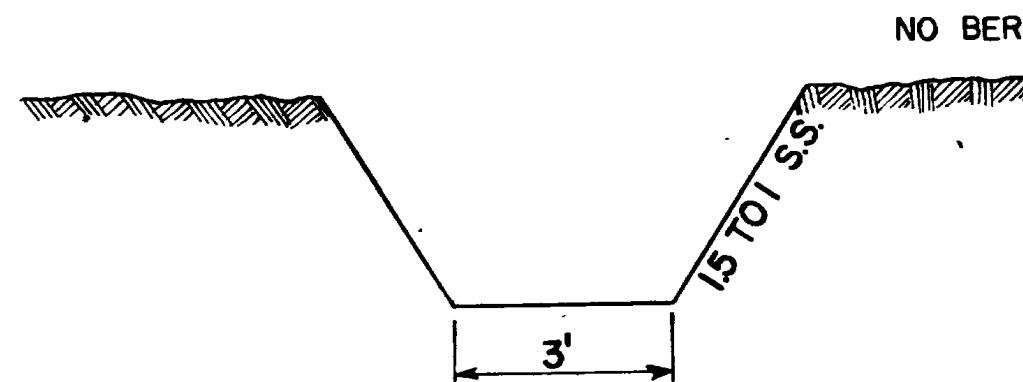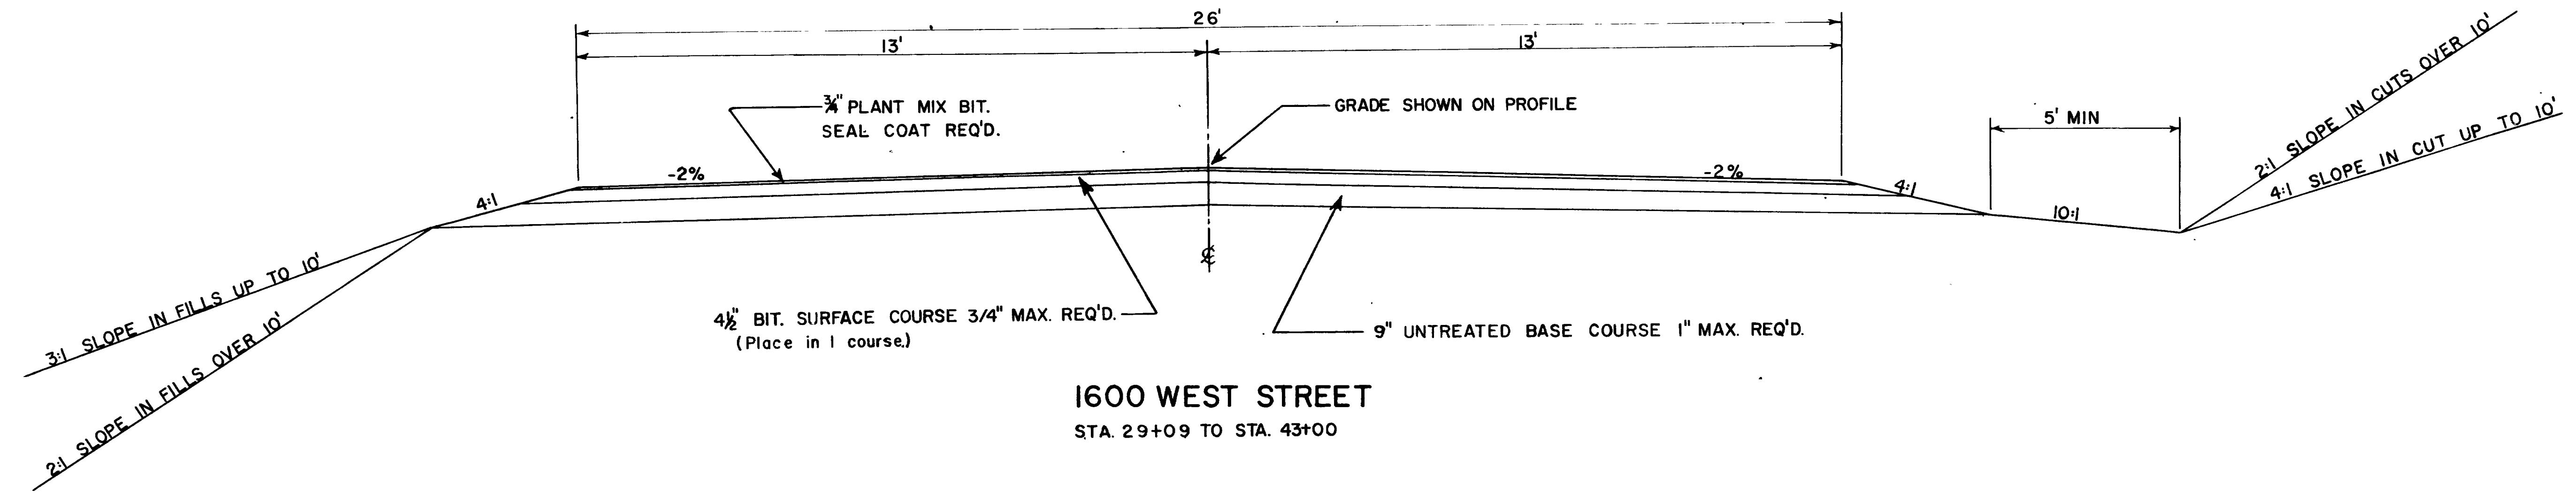

IRRIG. DITCH LT.  
 1600 WEST ST.

DESIGN SPEED 25 M.P.H.

UTAH STATE ROAD COMMISSION  
 SALT LAKE CITY UTAH

BITUMINOUS  
 SURFACED  
 ROADWAY

## **SUMMARY SHEET**

REVISED- 1-14-70

I-IG-15-8(23)338  
9TH CONTRACT

EARTHWORK QUANTITIES				CONSTRUCTION SOURCE REFERENCE
STATION TO STATION	EMBANK- MENT	EXCA- VATION	BORROW	
"AS CONSTRUCTED"	CU. YD.	CU. YD.	CU. YD.	FIELD BOOK
29+09 TO 43+00		677 776		6
				8
TOTAL		677 776		
LISE		677 850		

MISCELLANEOUS				
<u>"AS CONSTRUCTED"</u>		NAME	UNIT	QUANTITY
MOBILIZATION	6	6	LUMP	.10
FLAGGING	6	7	HOUR	480 8
6' CHAIN LINK 10' GATES	6	4	EACH	2.0
DELINEATORS	6	22	EACH	* 0
MOVING MAILBOXES	6	24	EACH	* 1.
RECONST. C.O.B. MANHOLE & MON. BOX	6	26.2	EACH	2.1
MODIFICATION OF EXISTING WELL	6	29	LUMP	.10
S.A. #1 BITUMINOUS MATERIAL GRADE SS-1 EMULSION		INVOICE # 1201800	TON	2.0

WATERING		
CONSTRUCTION SOURCE REFERENCE		
FIELD BOOK	PAGE	
2,373.39 TONS = 1,255.8 CU YD.		
<u>1,255.8</u> 40 = 31.4		
USE 35-M GAL AS CONSTRUCTED 49.0' M.GALS.	6	12
COMPACTION		
CONSTRUCTION SOURCE REFERENCE		
FIELD BOOK	PAGE	
<u>1391' x 35' x 0.6667</u> = 1,202.2		
AS CONSTRUCTED 1,323' CU.YD. USE 1,300 CU.YD	6	9





STATION	STATION	R/W MARKERS	CONSTRUCTION SOURCE REFERENCE
		LT.      RT.	FIELD BOOK      PAGE
29+40			
36+00			
42+72			
TOTAL		3      3	
USE		50'	


STATION	STATION	R/W FENCE TYPE "B"	CONSTRUCTION SOURCE REFERENCE
		HT	FIELD BOOK
29+34	34+75	520	
29+40	34+60	504	
			PAGE
			6
			3
TOTAL		520 504	
USE		520 504	

HIGHWAY TRAFFIC PAINT		STD. DRWG.
NO. 745 41		
APPLICATION	FOR ESTIMATING PURPOSES ONLY	4" SKIP WHITE
TYPE OF STRIPING	GAL PER MILE	MILE      GAL.
4" SKIP WHITE LINE	6	.26      1.64
TOTAL		.26,      1.64
USE	E.B #6- D. 31	1.6 2

STATION	STATION	R/W GATES				CONSTRUCTION SOURCE REFERENCE	
		LT.		RT.		FIELD BOOK	PAGE
		14'	16'	14'	16'		
34+58				1		6	3
34+54							
TOTAL				1			
USE				1			

STATION	STATION	6' CHAIN LINK FENCE TYPE II	FIELD BOOK	CONSTRUCTION SOURCE REFERENCE
		LT.	RT.	PAGE
37+08	42+38.6 42+68	520.6 540'		6 4
TOTAL		520.6 540'		
USE		520.6 540'		

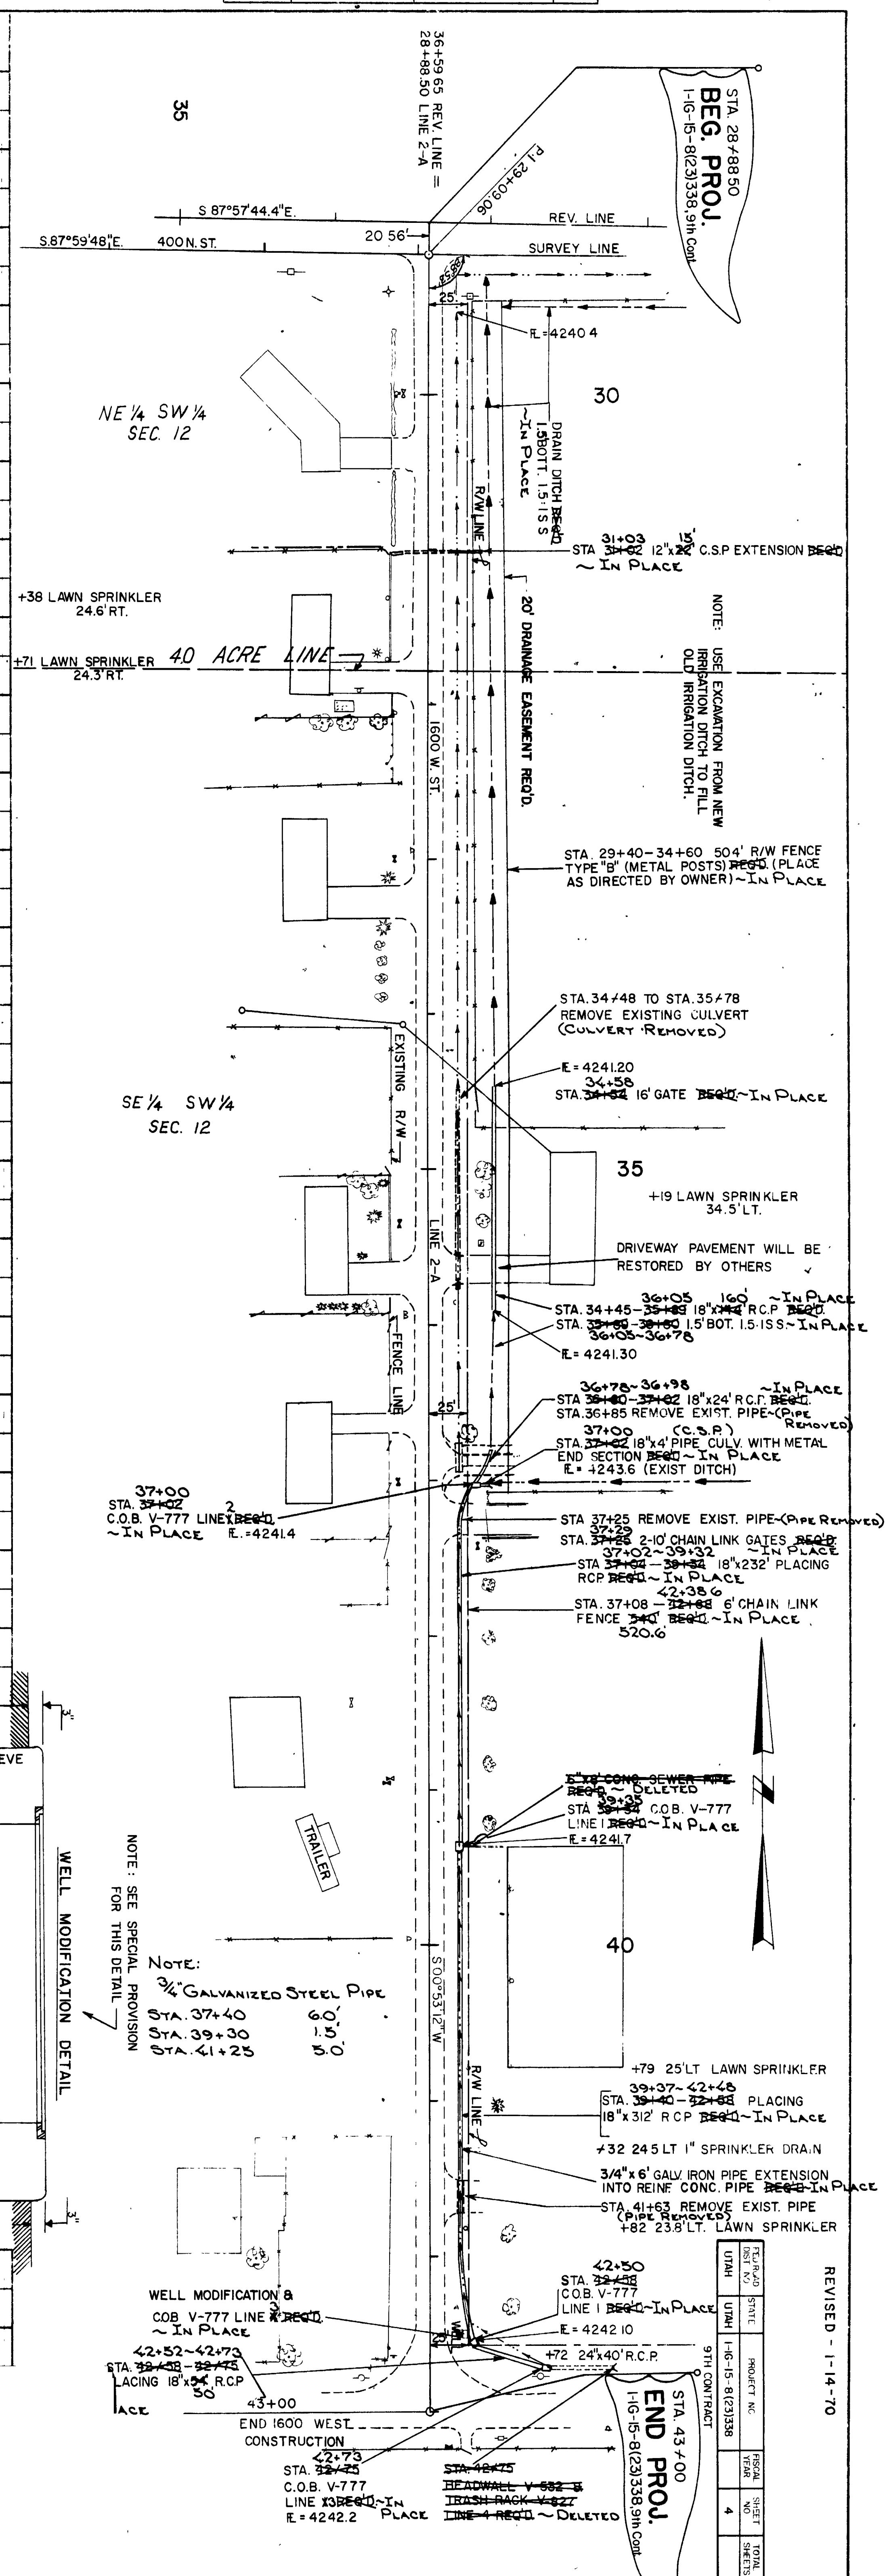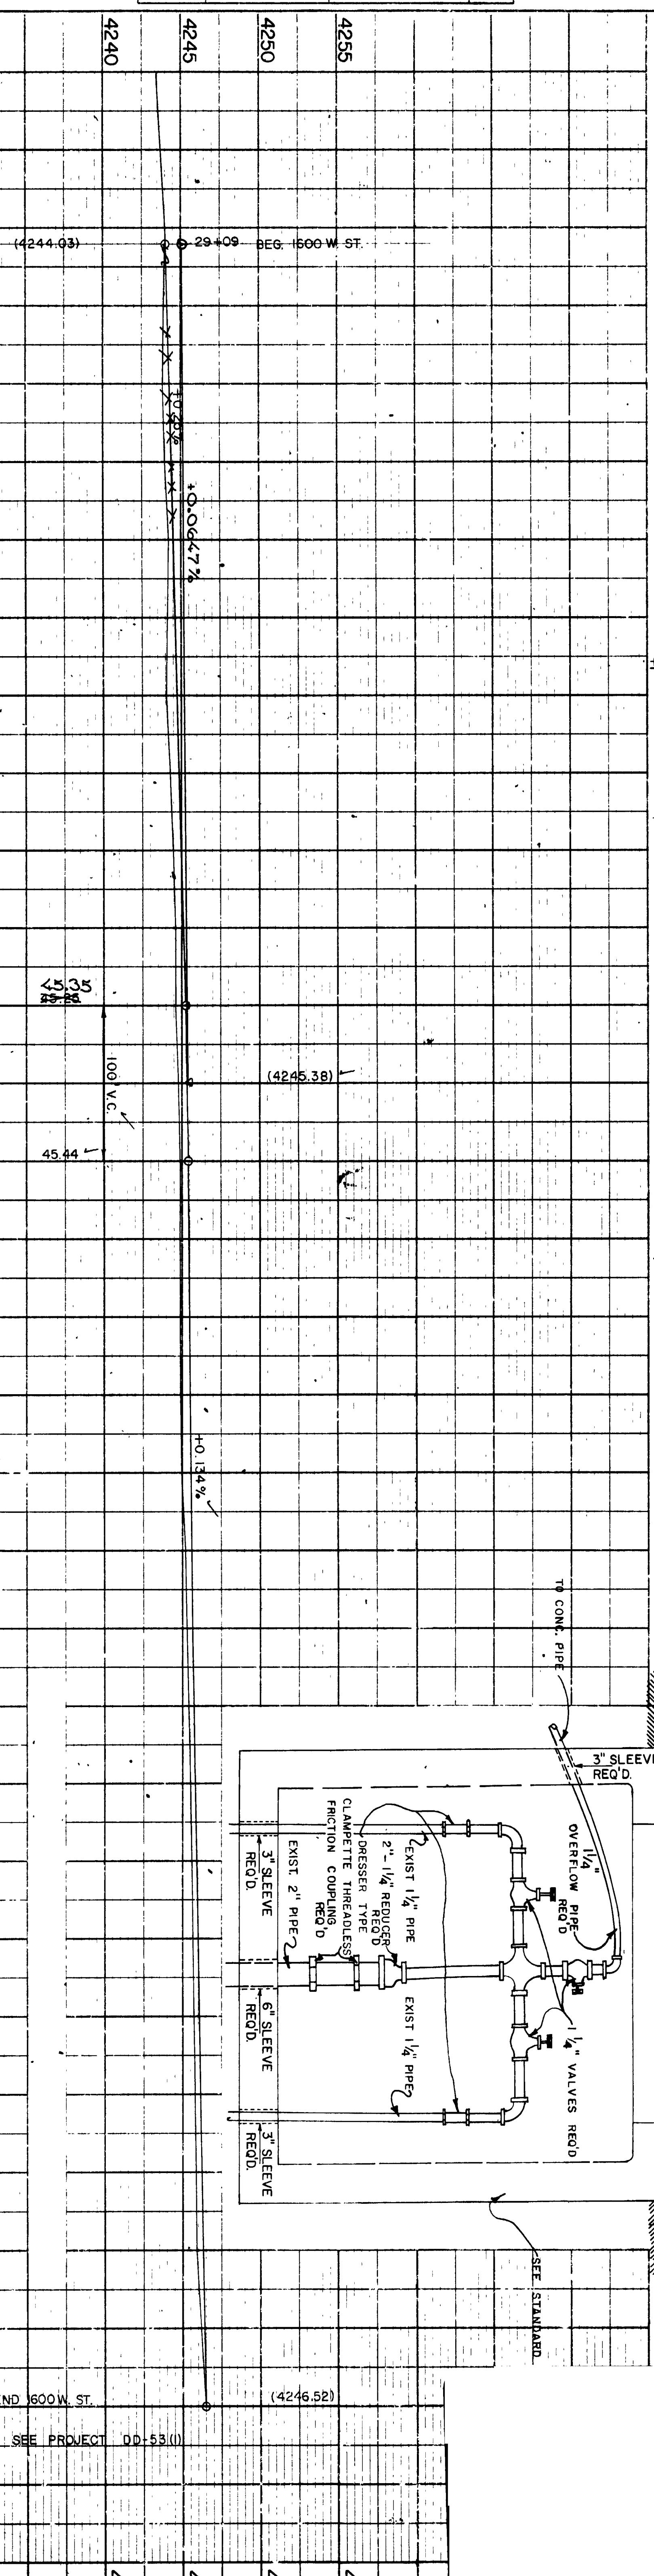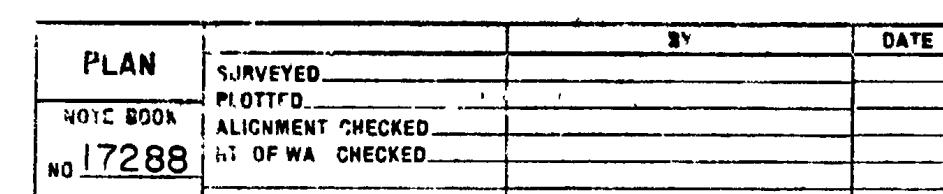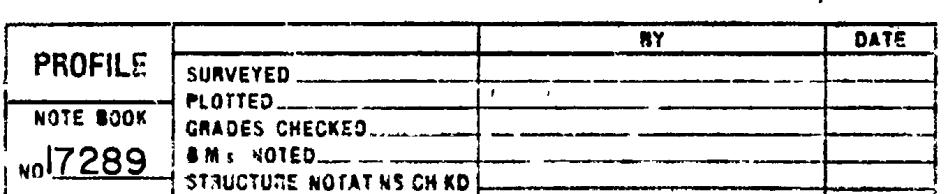

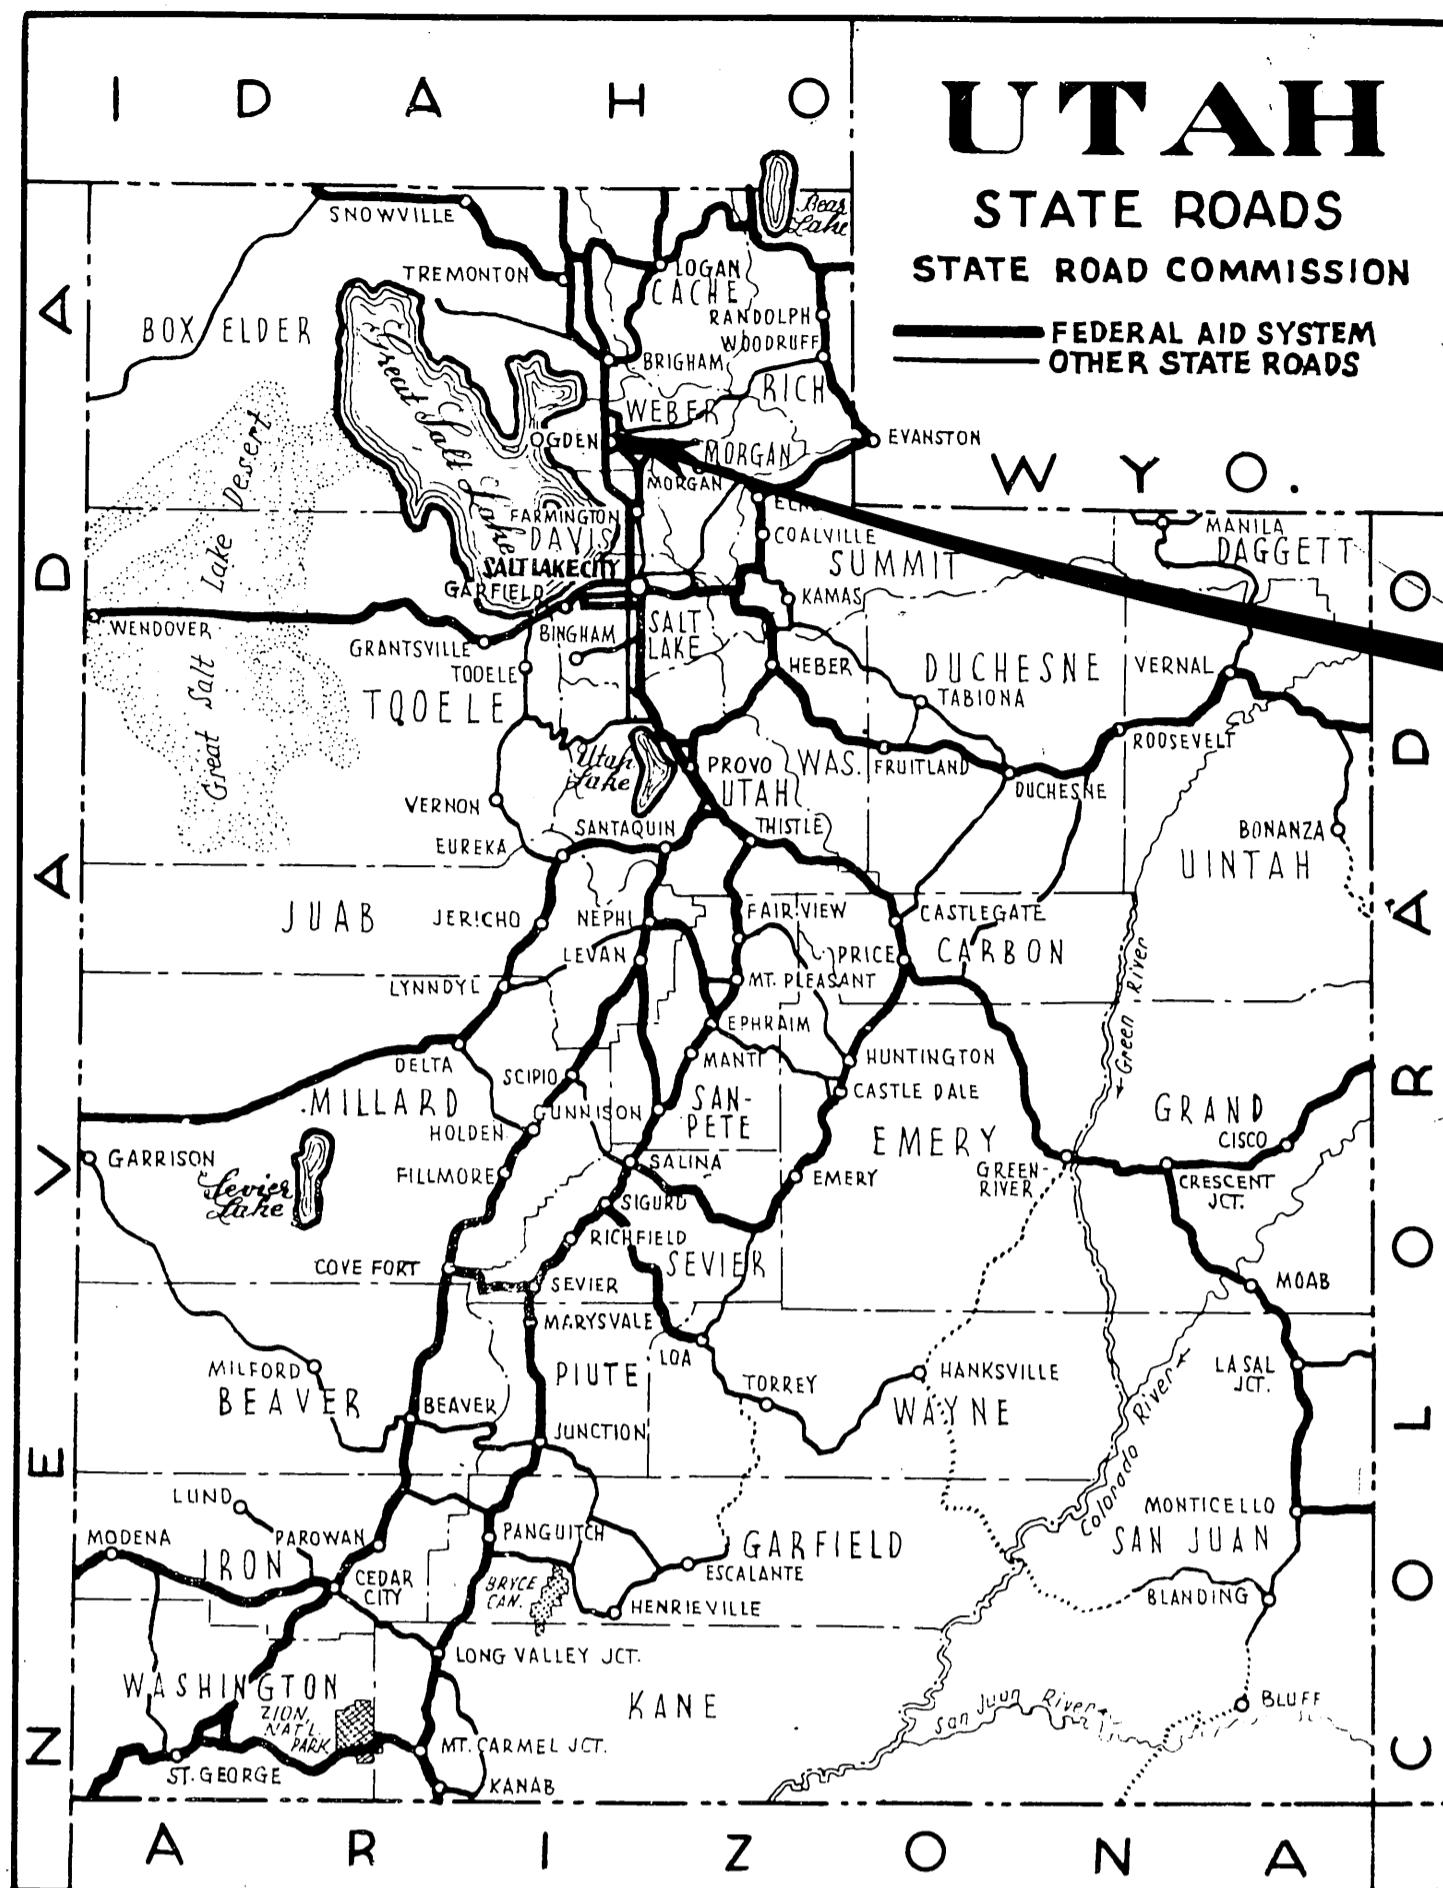

# STATE OF UTAH STATE ROAD COMMISSION


DD-53 (I)  
I-IG-15-8(23)338 9th CONTRACT

## PLANS OF PROPOSED STATE ROAD FEDERAL AID PROJECT

**DD - 53 (I)**  
**I-15 TO DEFENSE DEPOT OGDEN**

LENGTH 0.678 MILES




**I-IG-15-8(23)338 9th CONTRACT**  
**1600 WEST ST.**  
LENGTH 0.263 MILES  
WEBER COUNTY

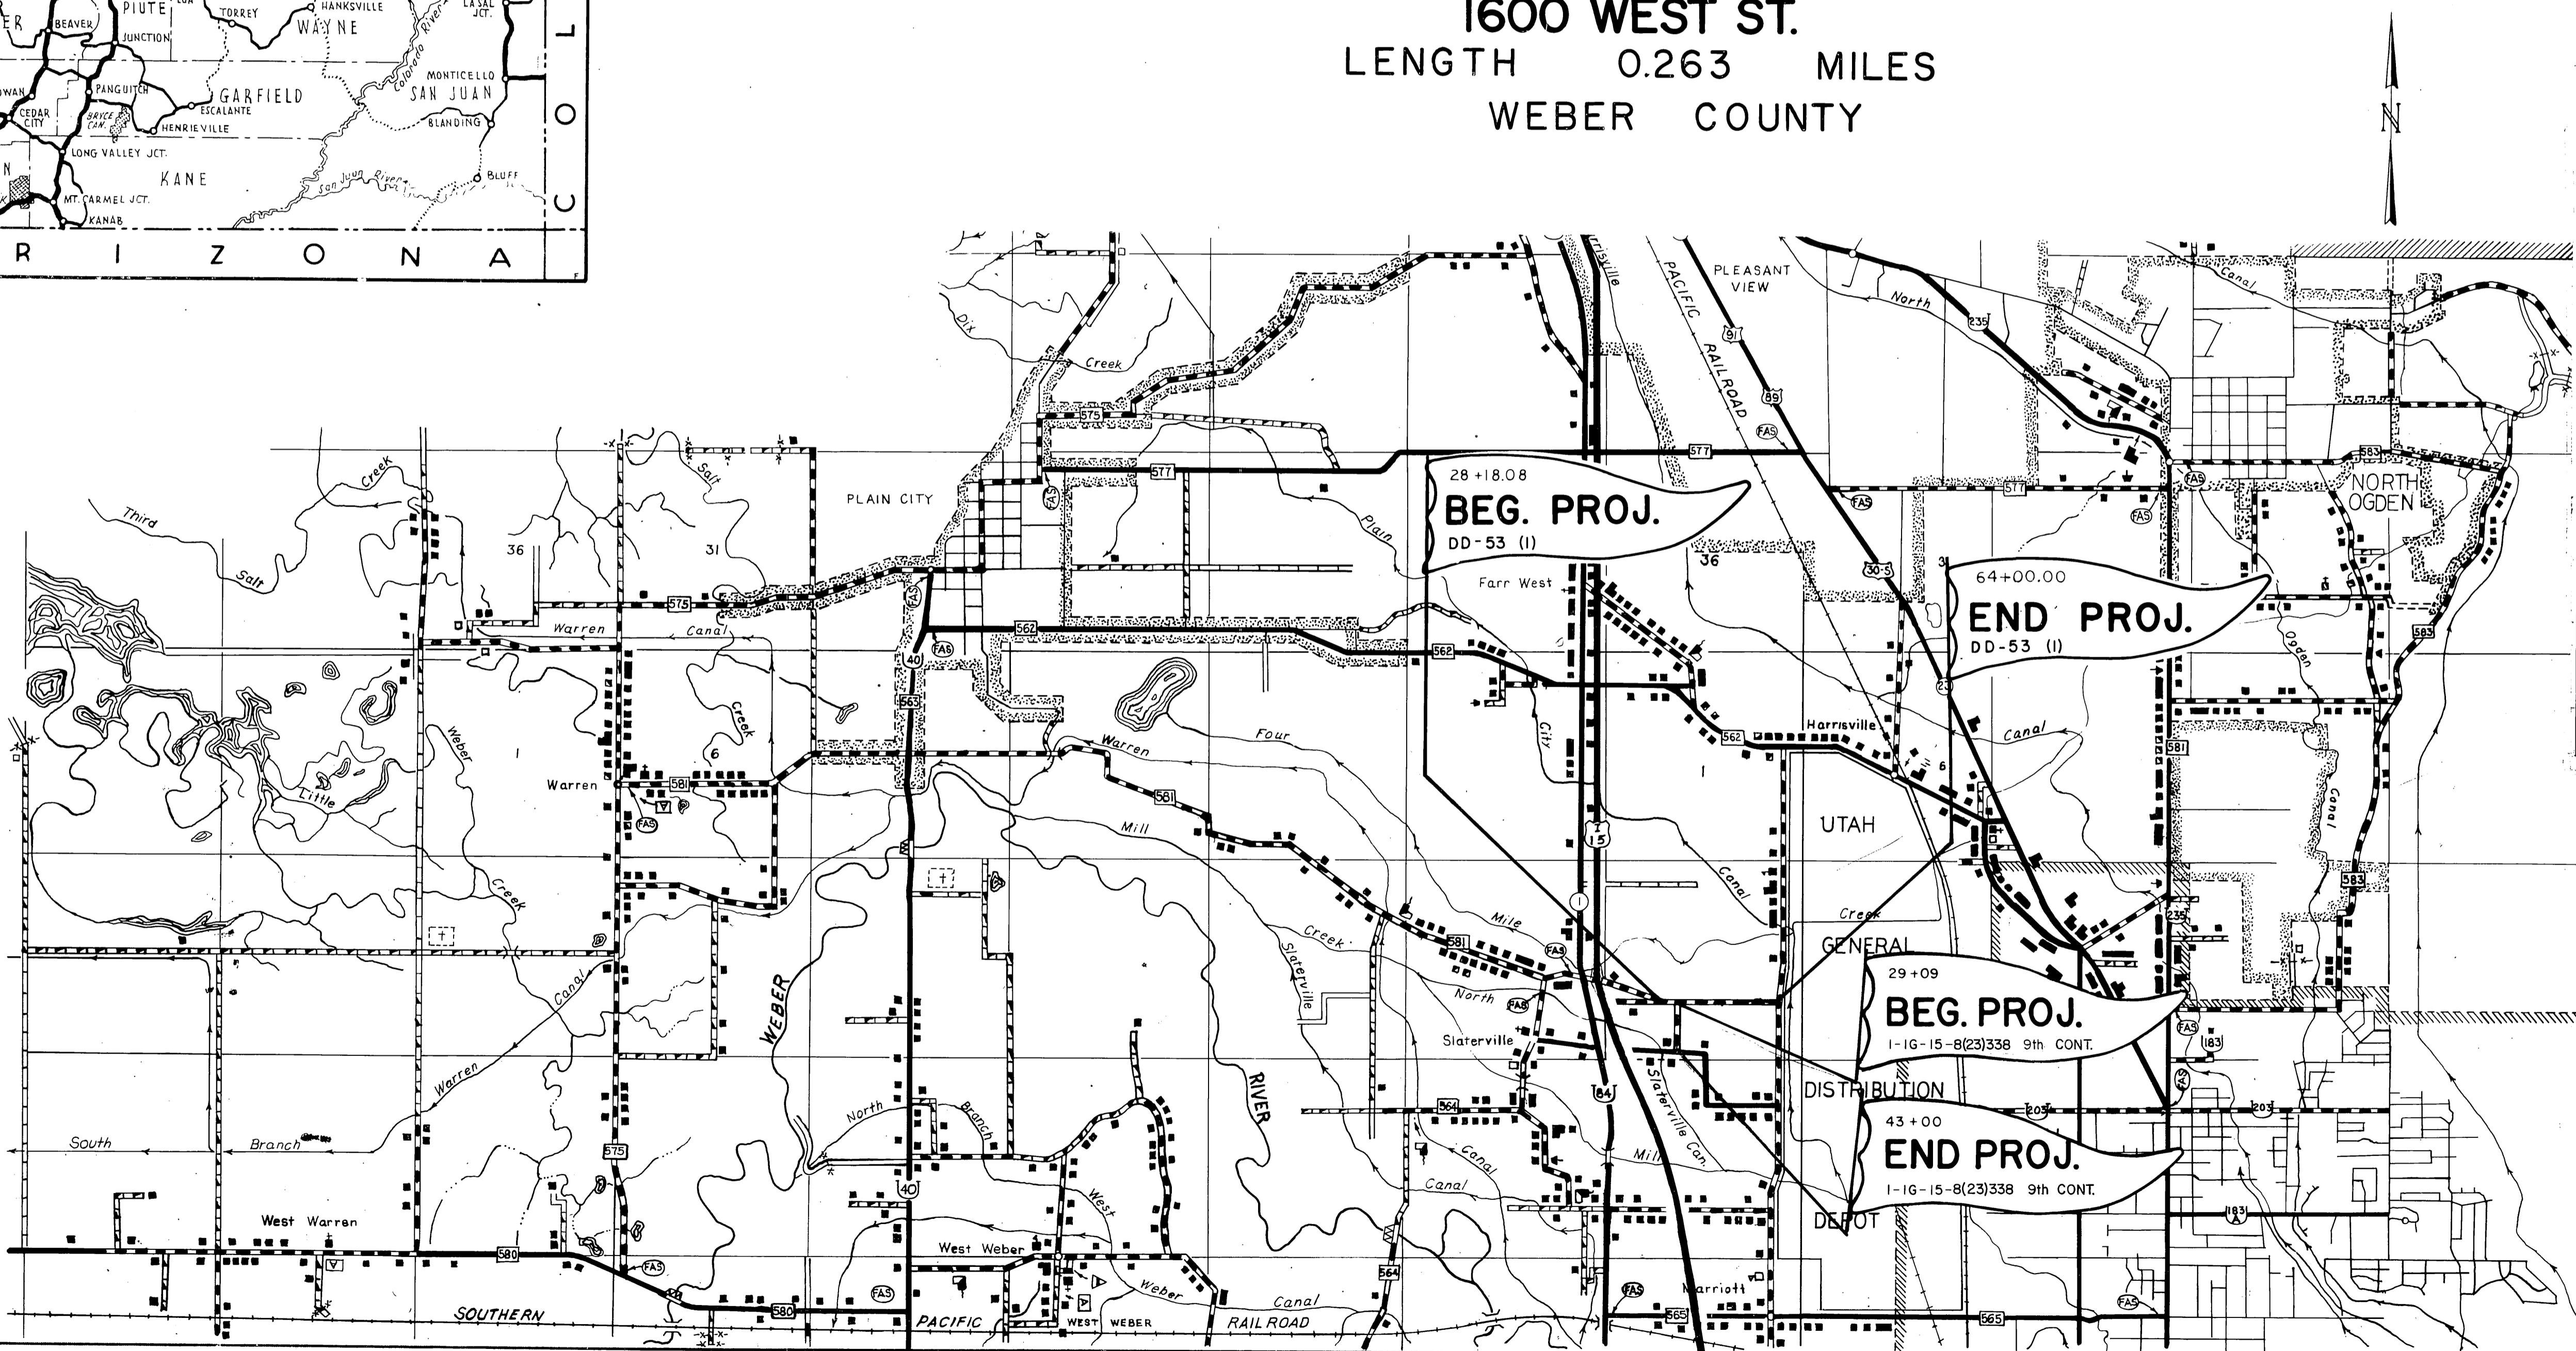



## TYPICAL CROSS SECTION

FED. ROAD DIST. NO.	STATE	PROJECT NO.	FISCAL YEAR	SHEET NO.	TOTAL SHEETS
UTAH	UTAH	DD-53 (I)		2	

BITUMINOUS MATERIALS  
 BITUMINOUS MATERIAL GRADE AC-20 PEN. ASPHALT REQ'D IN MIX  
 BITUMINOUS MATERIAL GRADE MC-70 OR MC-250 REQ'D FOR PRIME COAT  
 BITUMINOUS MATERIAL GRADE RC-70 OR RC-250 REQ'D FOR FLUSH COAT & TACK COAT  
 BITUMINOUS MATERIAL GRADE AC-PM PEN. ASPHALT REQ'D IN SEAL

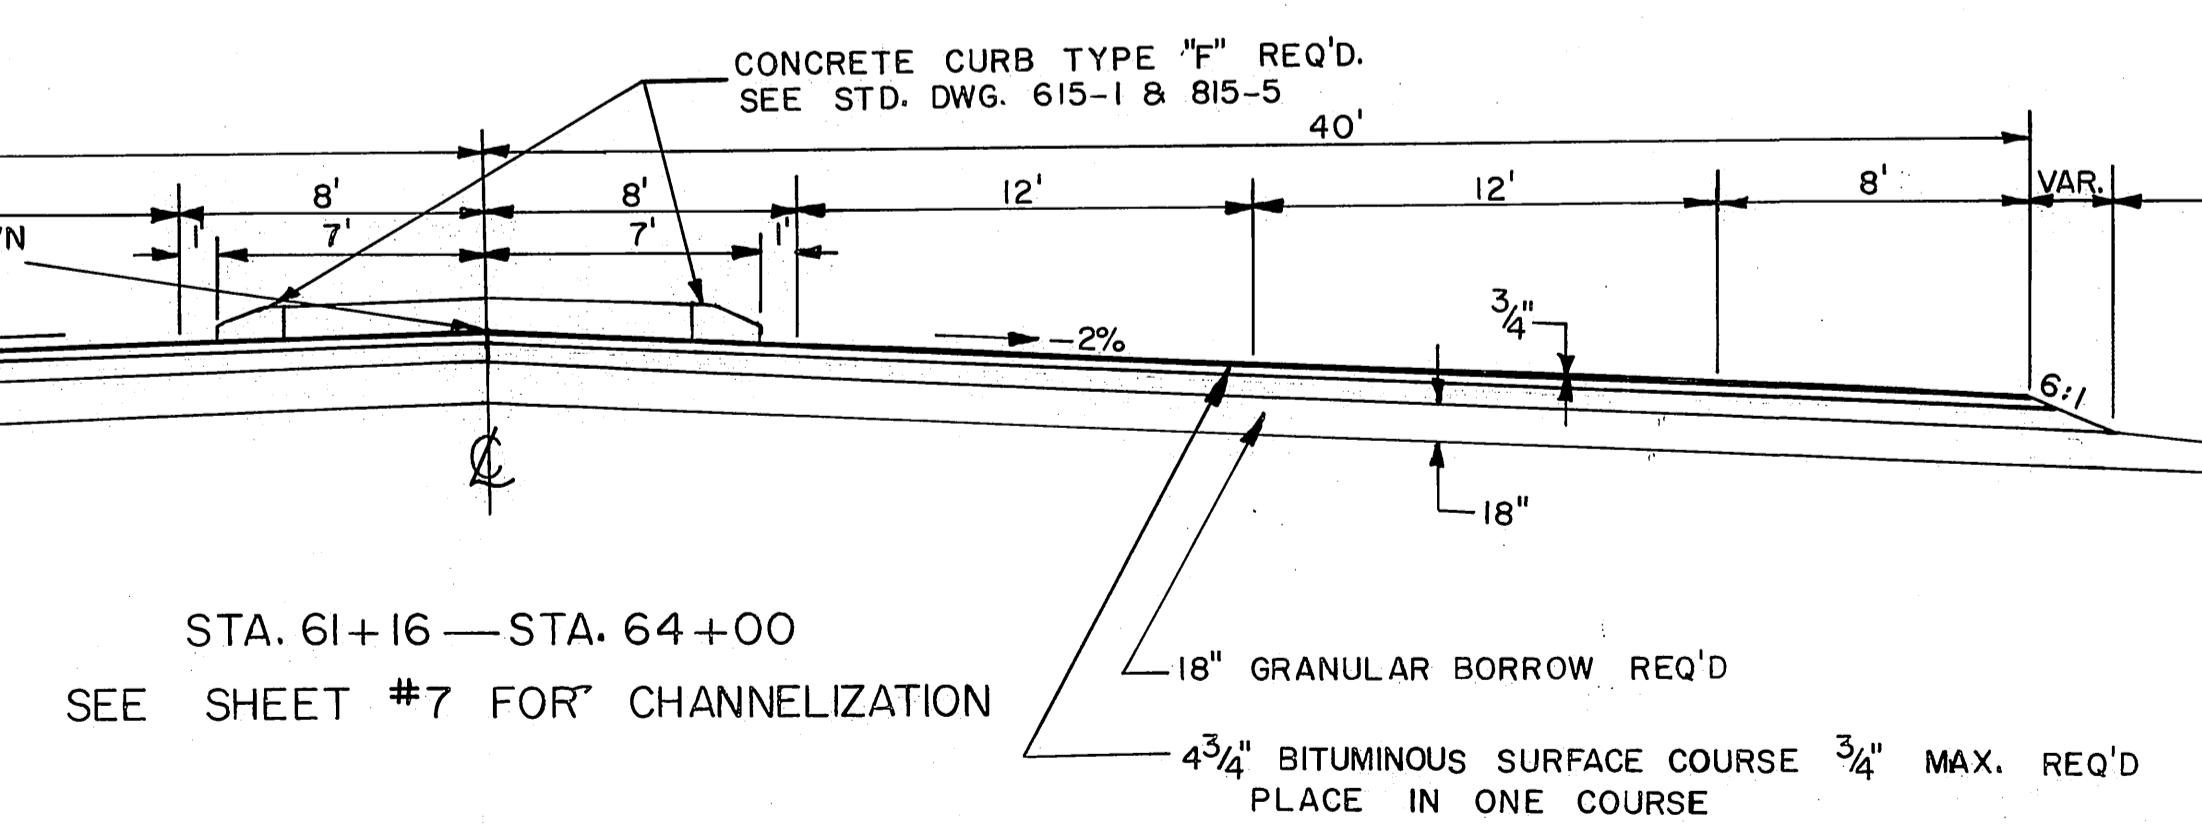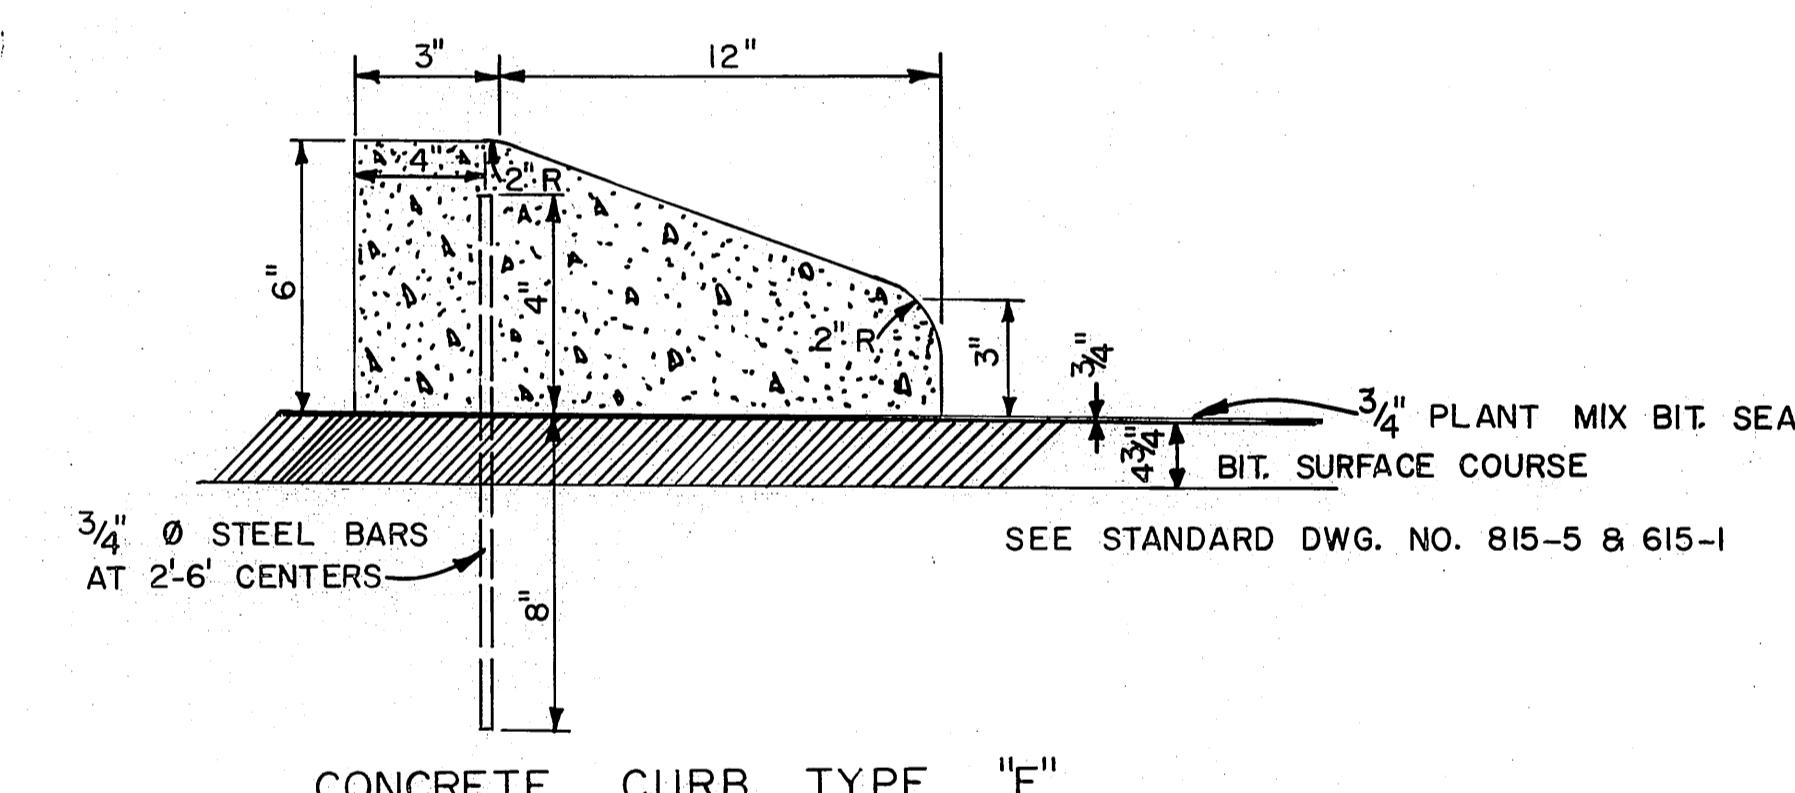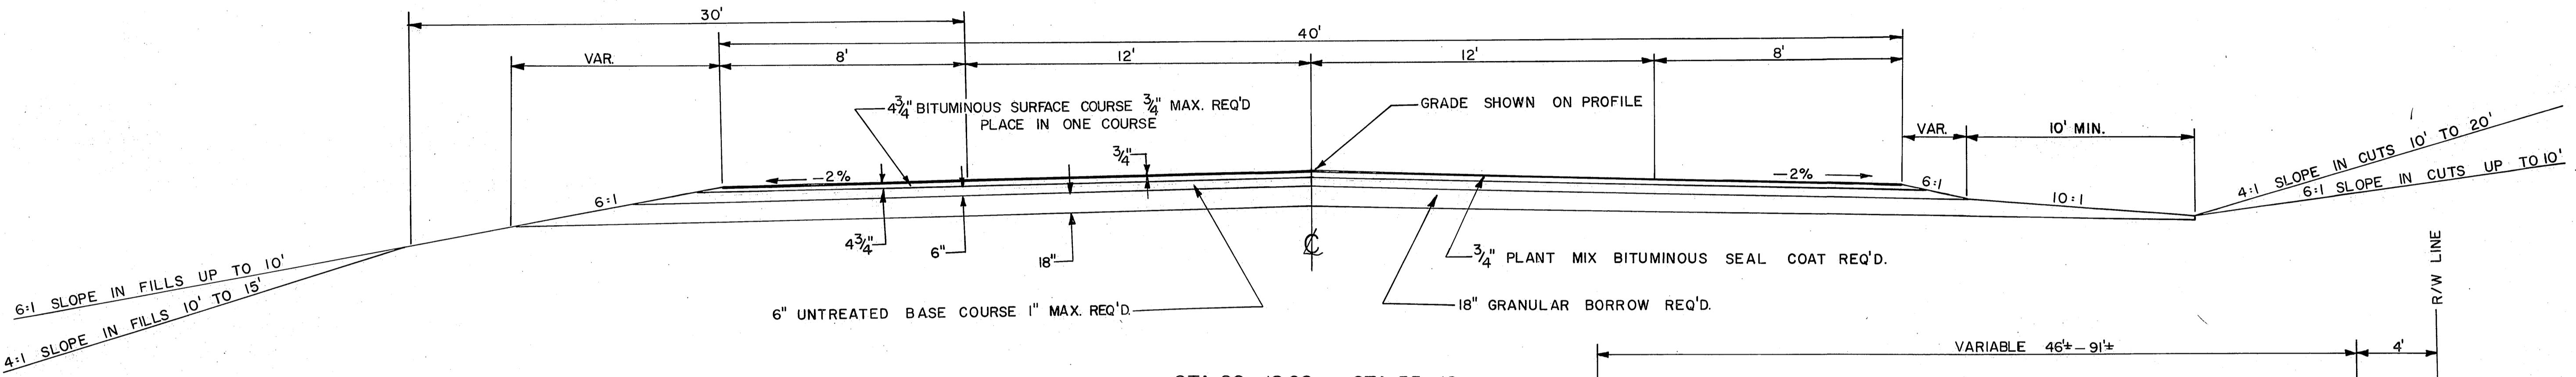

SUPERELEVATE CURVES IN ACCORDANCE WITH STD. DWG. NO. 805-IA & IB.  
 DESIGN SPEED 50 M.P.H.

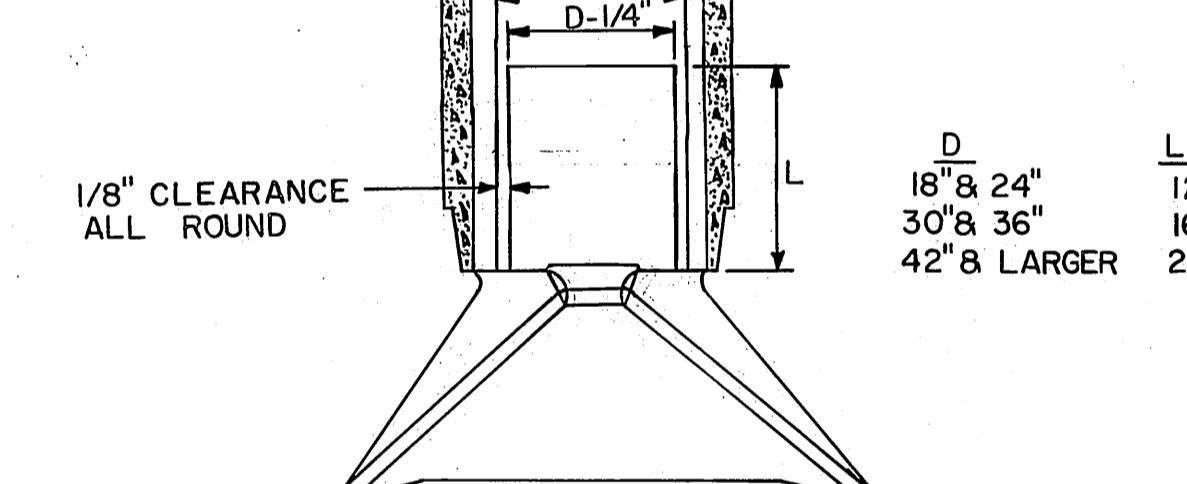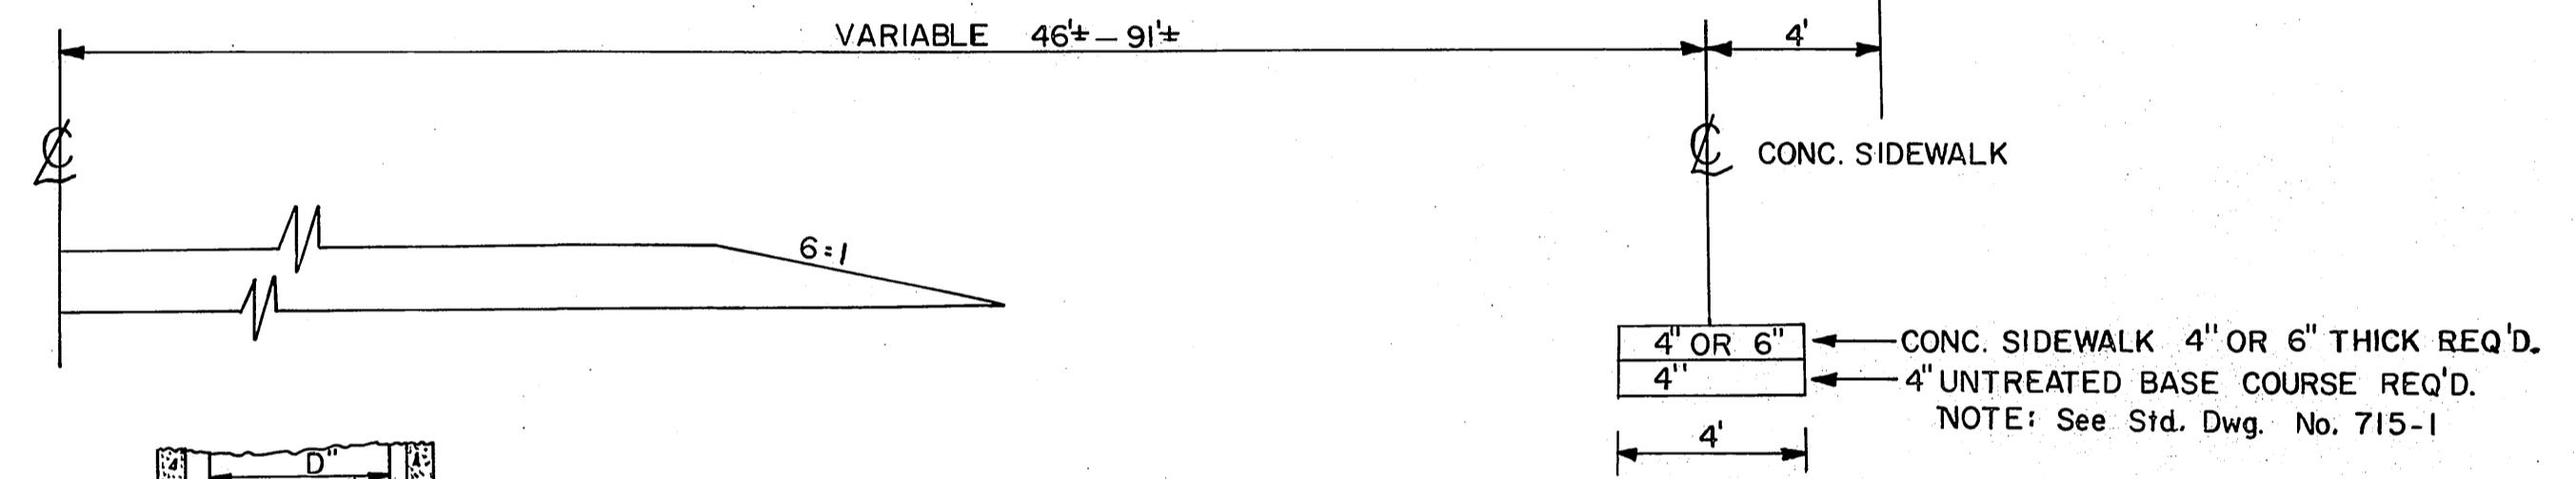

- NOTES:
1. SHOP FABRICATE STEEL END SECTION & SLEEVE.
  2. SLEEVE TO BE OF 12 GAGE SMOOTH GALVANIZED STEEL IN ACCORDANCE WITH A.A.S.H.O. M-36.
  3. WELD SLEEVE TO END SECTION.
  4. REPAIR OF DAMAGED SPelter COATING SHALL BE IN ACCORDANCE WITH A.A.S.H.O. M-36.
  5. PRIOR TO INSTALLATION, COAT SLEEVE WITH MINIMUM 1/8" THICKNESS OF ASPHALT COATING IN ACCORDANCE WITH SECTION 702 STANDARD SPECIFICATIONS, EXCEPT ASPHALT COATING TO BE OF BRUSH CONSISTENCY INSTEAD OF SPRAY CONSISTENCY.

STEEL END SECTION FOR CONCRETE PIPE

UTAH STATE ROAD COMMISSION

BITUMINOUS  
 SURFACED  
 ROADWAY



# SUMMARY

# CHART

DD-53 (1) 5A  
V.R.-70

STATION TO STATION	TYP SIC	LENGTH	BITUMENOUS SURFACE COURSE			PLANT MIX BIT. SEAL COAT			GRAVEL SURFACE COURSE			UNTREATED BASE COURSE			GRANULAR BORROW			HYDRATED LIME 1% BY WT			PIEN ASPHALT GRADE AC-20			GRADE AC-PM			PCTO/RG250		
			IN'	FT'	IN"	IN'	FT'	IN"	IN'	FT'	IN"	IN'	FT'	IN"	IN'	TON	TON	TON	TON	TON	TON	TON	TON	TON	TON	TON	TON	TON	TON
23+18 - 55+16		2698	42	.3958	3,319				42	.0625	942					47	.5	4,458.0	59	15	16,714.0	8%	166	42	38	40	4.8	44	15.9
55+16 - 61+16		600	62	.3958	1,082				62	.0625	172					67	.5	1,407.0	79	15	4,977.0	8%	54	62	12	60	1.6	64	5.1
61+16 - 63+16		245	82	.3958	588				62	.0625	93					67	.5	746	99	15	2,547.0	5%	29	62	7	60	0.8	84	2.8
RAISED MEDIAN																													
APPROACHES																													
36+75 - 40+70 DITCH ON RDT																													
INTERSECTION																													
TOTAL																													
USE																													

## FENCE & GATES

STA. TO STA.	TYPE "B" METAL POSTS LNGHT FT	GATES EACH	CONSTRUCTION SOURCE REFERENCE
23+5 - 29+20			
29+20 - 29+24.6	770	SALVAGE & RESET	
46+82 - 47+10	1100		
33+16		I-LT.	
36+97 - 49+08	1,218		
44+20		I-LT.	
44+45		2-LT.	
44+60 - 46+95	235		
47+89 - 50+12	215		
49+10		I-RT.	
49+28 - 50+12	84		
52+06		I RT	
52+03		2-LT.	
51+84 - 55+46	336		
52+16 - 55+44	220		
57+93			
57+90 - 53+88	178		
53+92		2-LT.	
53+90 - 58+70	467		
55+54		I-RT.	
56+83 - 58+92	210		
58+77 - 59+50	59		
58+85		I-LT.	
59+00		I-RT.	
60+F7 - 63+42	322		
59+08 - 63+39	443		
63+39 LT	209		
TOTAL	2,771	2,702	4 2 7
USE			

## MISCELLANEOUS SUMMARY

ITEM	UNIT	QUANTITY	CONSTRUCTION SOURCE REFERENCE	
			EMB. FACTOR	EXC.
MOBILIZATION	LUMP	•		
FLAGGING	MN.HRS.	800		
R/W MARKERS	EACH	16		
MOVING MAIL BOXES	EACH	3		
MOVING STREET SIGNS	EACH	210		
RECONSTRUCT/CLEANOUTS/MANHOLES MON. BOXES & WATER METERS	EACH	8		
CONC. PAVEMENT OR CONCRETE	SQ.YD.	414.2		
SIDEWALK 4" THICK	SQ.YD.	360		
CONC. PAVEMENT OR CONCRETE	SQ.YD.	16.7		
SIDEWALK 6" THICK	SQ.YD.	40		
MOVING & RESETTING FENCE	LIN.FT	558		

## EARTHWORK SUMMARY

STA. TO STA.	EMB. FACTOR	EMB.	EXC.	CHAN. CHG. EXC.	EXCESS MATERIAL	CONSTRUCTION SOURCE REFERENCE		
						CU YDS	CU YDS	CU YDS
28+18 - 64+33	1.20	1,379	6,923		5228			
USE					7,000			

## HIGHWAY TRAFFIC PAINT

APPLICATION	FOR ESTIMATING PURPOSES ONLY		4" SOLID WHITE	4" SKIP WHITE	4" SOLID YELLOW	STD. DRWG. NO. 745-41	
	TYPE OF STRIPING	GAL PER MILE	MILE	GAL	MILE	GAL	
4" SOLID WHITE LINE		16	.68	21.7			
4" SKIP WHITE LINE		6		.68	4.3		
4" SOLID YELLOW LINE		16			.12	1.8	
SUB-TOTAL							
TOTAL							
USE							

30 GALS.

## WATERING, ROLLING & COMPACTION

STA. - STA.	CONC. MEDIAN FILLER SQ.YD.	CONC. CURB TYPE LIN. FT.	REMOVAL OF CONCRETE DRIVeways SQ. YD.	CONSTRUCTION SOURCE REFERENCE	
				FIELD BOOK	PAGE
60+77	63+26			84.8	50961
32+60					686
47+00					104
55+95					DELETED
TOTAL				184.8	50961
USE				90	510
					120

**(a-c) SEE SPECIFICATIONS**


(d) MOUNTING HEIGHT IS MEASURED FROM  
BOTTOM OF SIGN TO LEVEL OF  
PAVEMENT EDGE

(e) COLOR CODE:  
B. BLUE, G. GREEN, W. WHITE, Bk. BLACK, Y. YELLOW


# **SIGN SUMMARY SHEET**

D. ROAD ST. NO.	STATE	PROJ. NO.	FISCAL YEAR	SHEET NO.	TOTAL SHEETS
UTAH	UTAH	DD-53(I)		3-B	




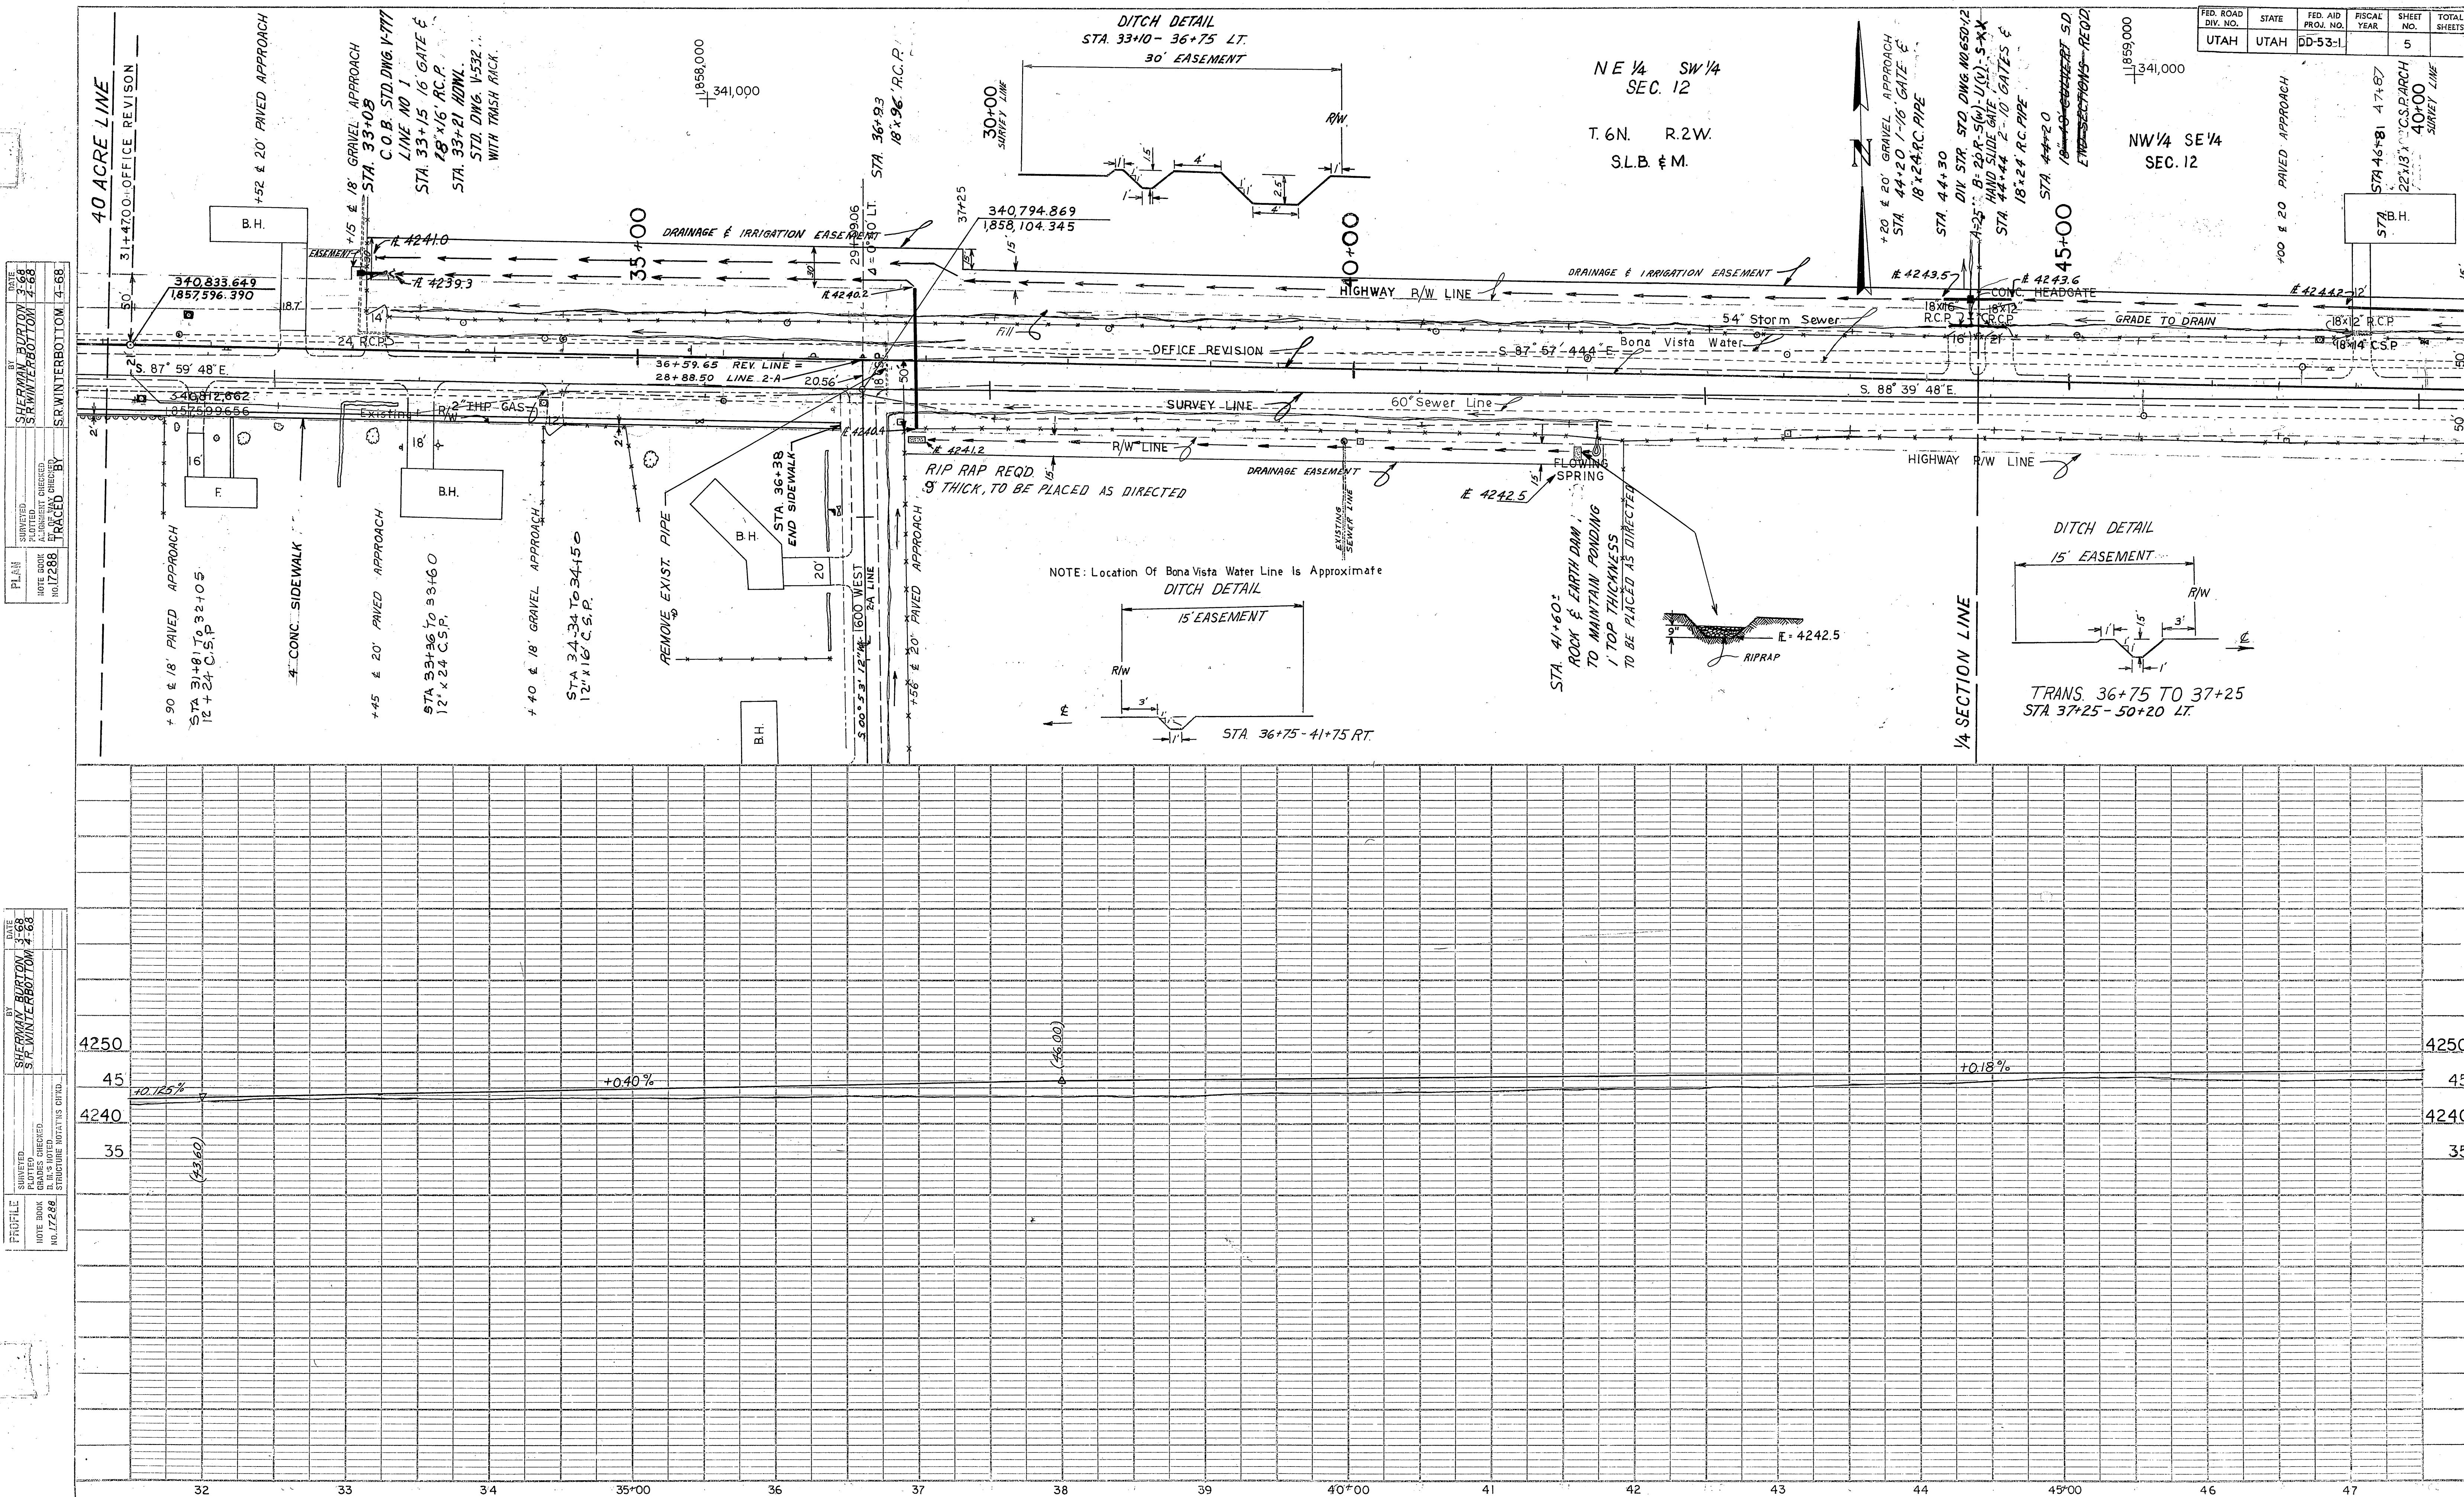


**PLATE 1--PLAN PROFILE B. P. R. STANDARD  
THE FREDERICK POST CO., Chicago**

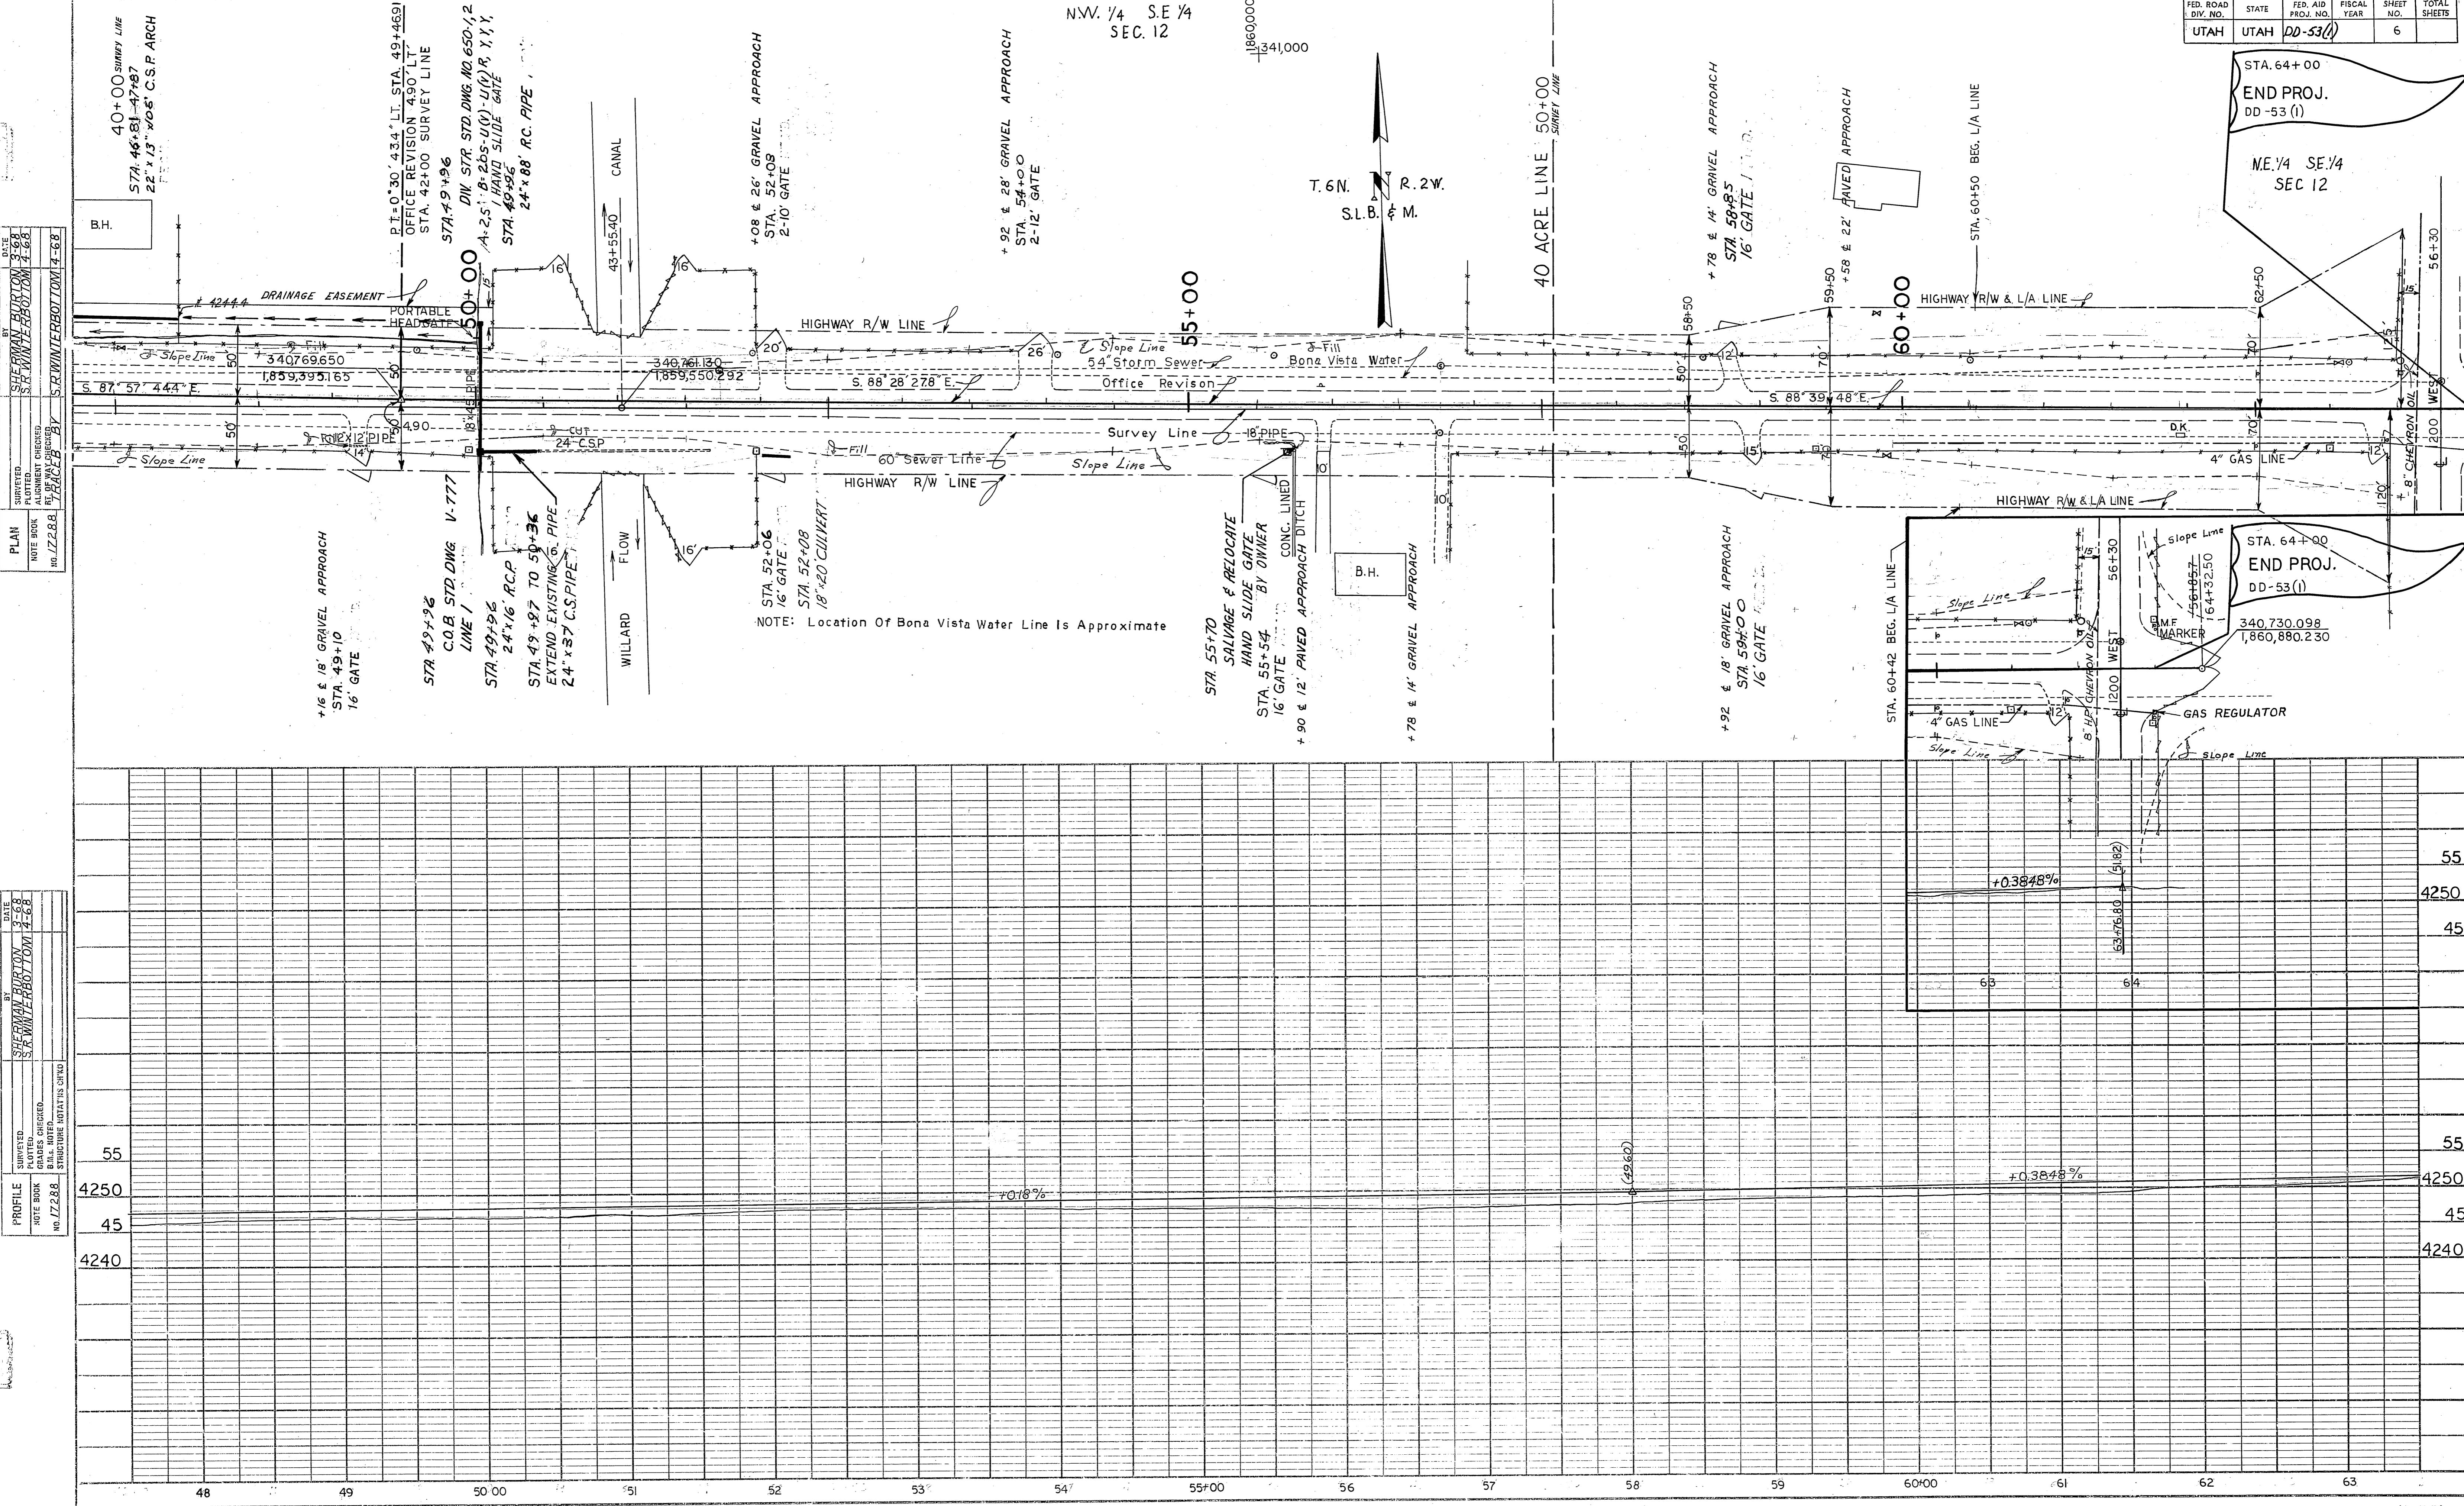


D. ROAD ST. NO.	STATE	PROJ. NO.	FISCAL YEAR	HEET NO.	TOTAL SHEETS
UTAH	UTAH	D.D - 53 (I)		7	

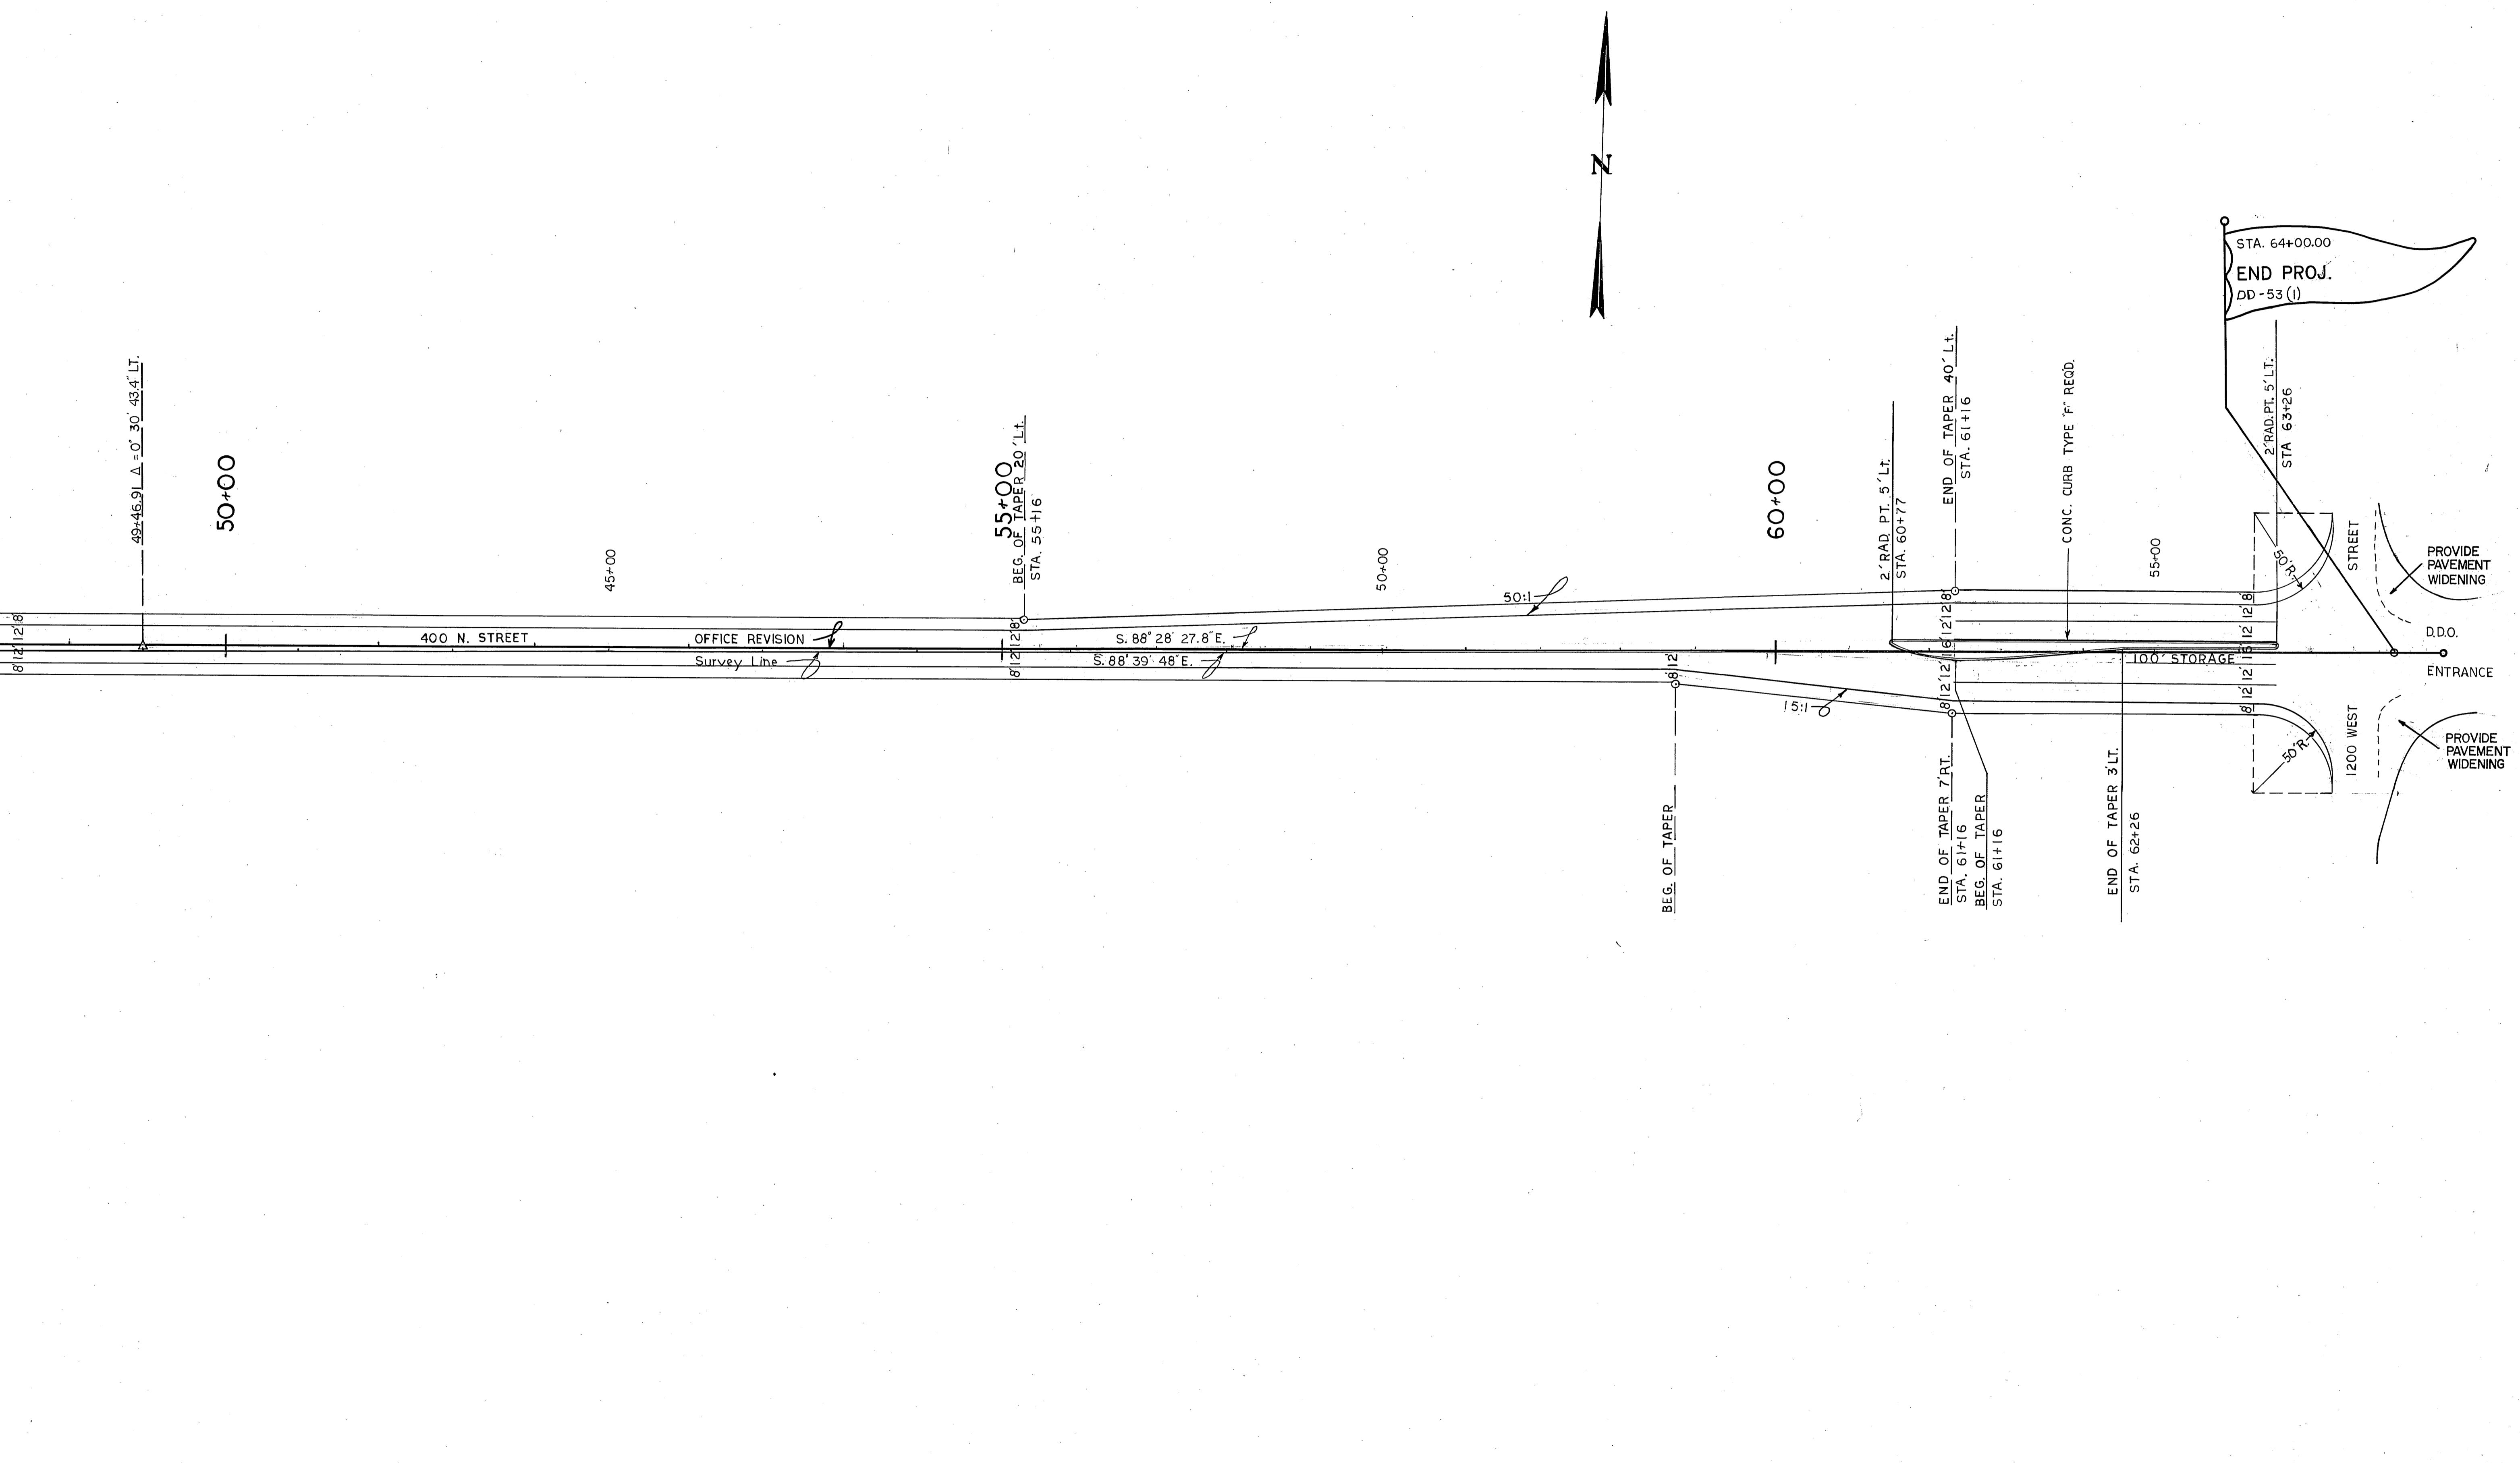

FED. ROAD DIST. NO.	STATE	PROJ. NO.	FISCAL YEAR	SHEET NO.	TOTAL SHEETS
UTAH	UTAH	DD-53 (I)		8	

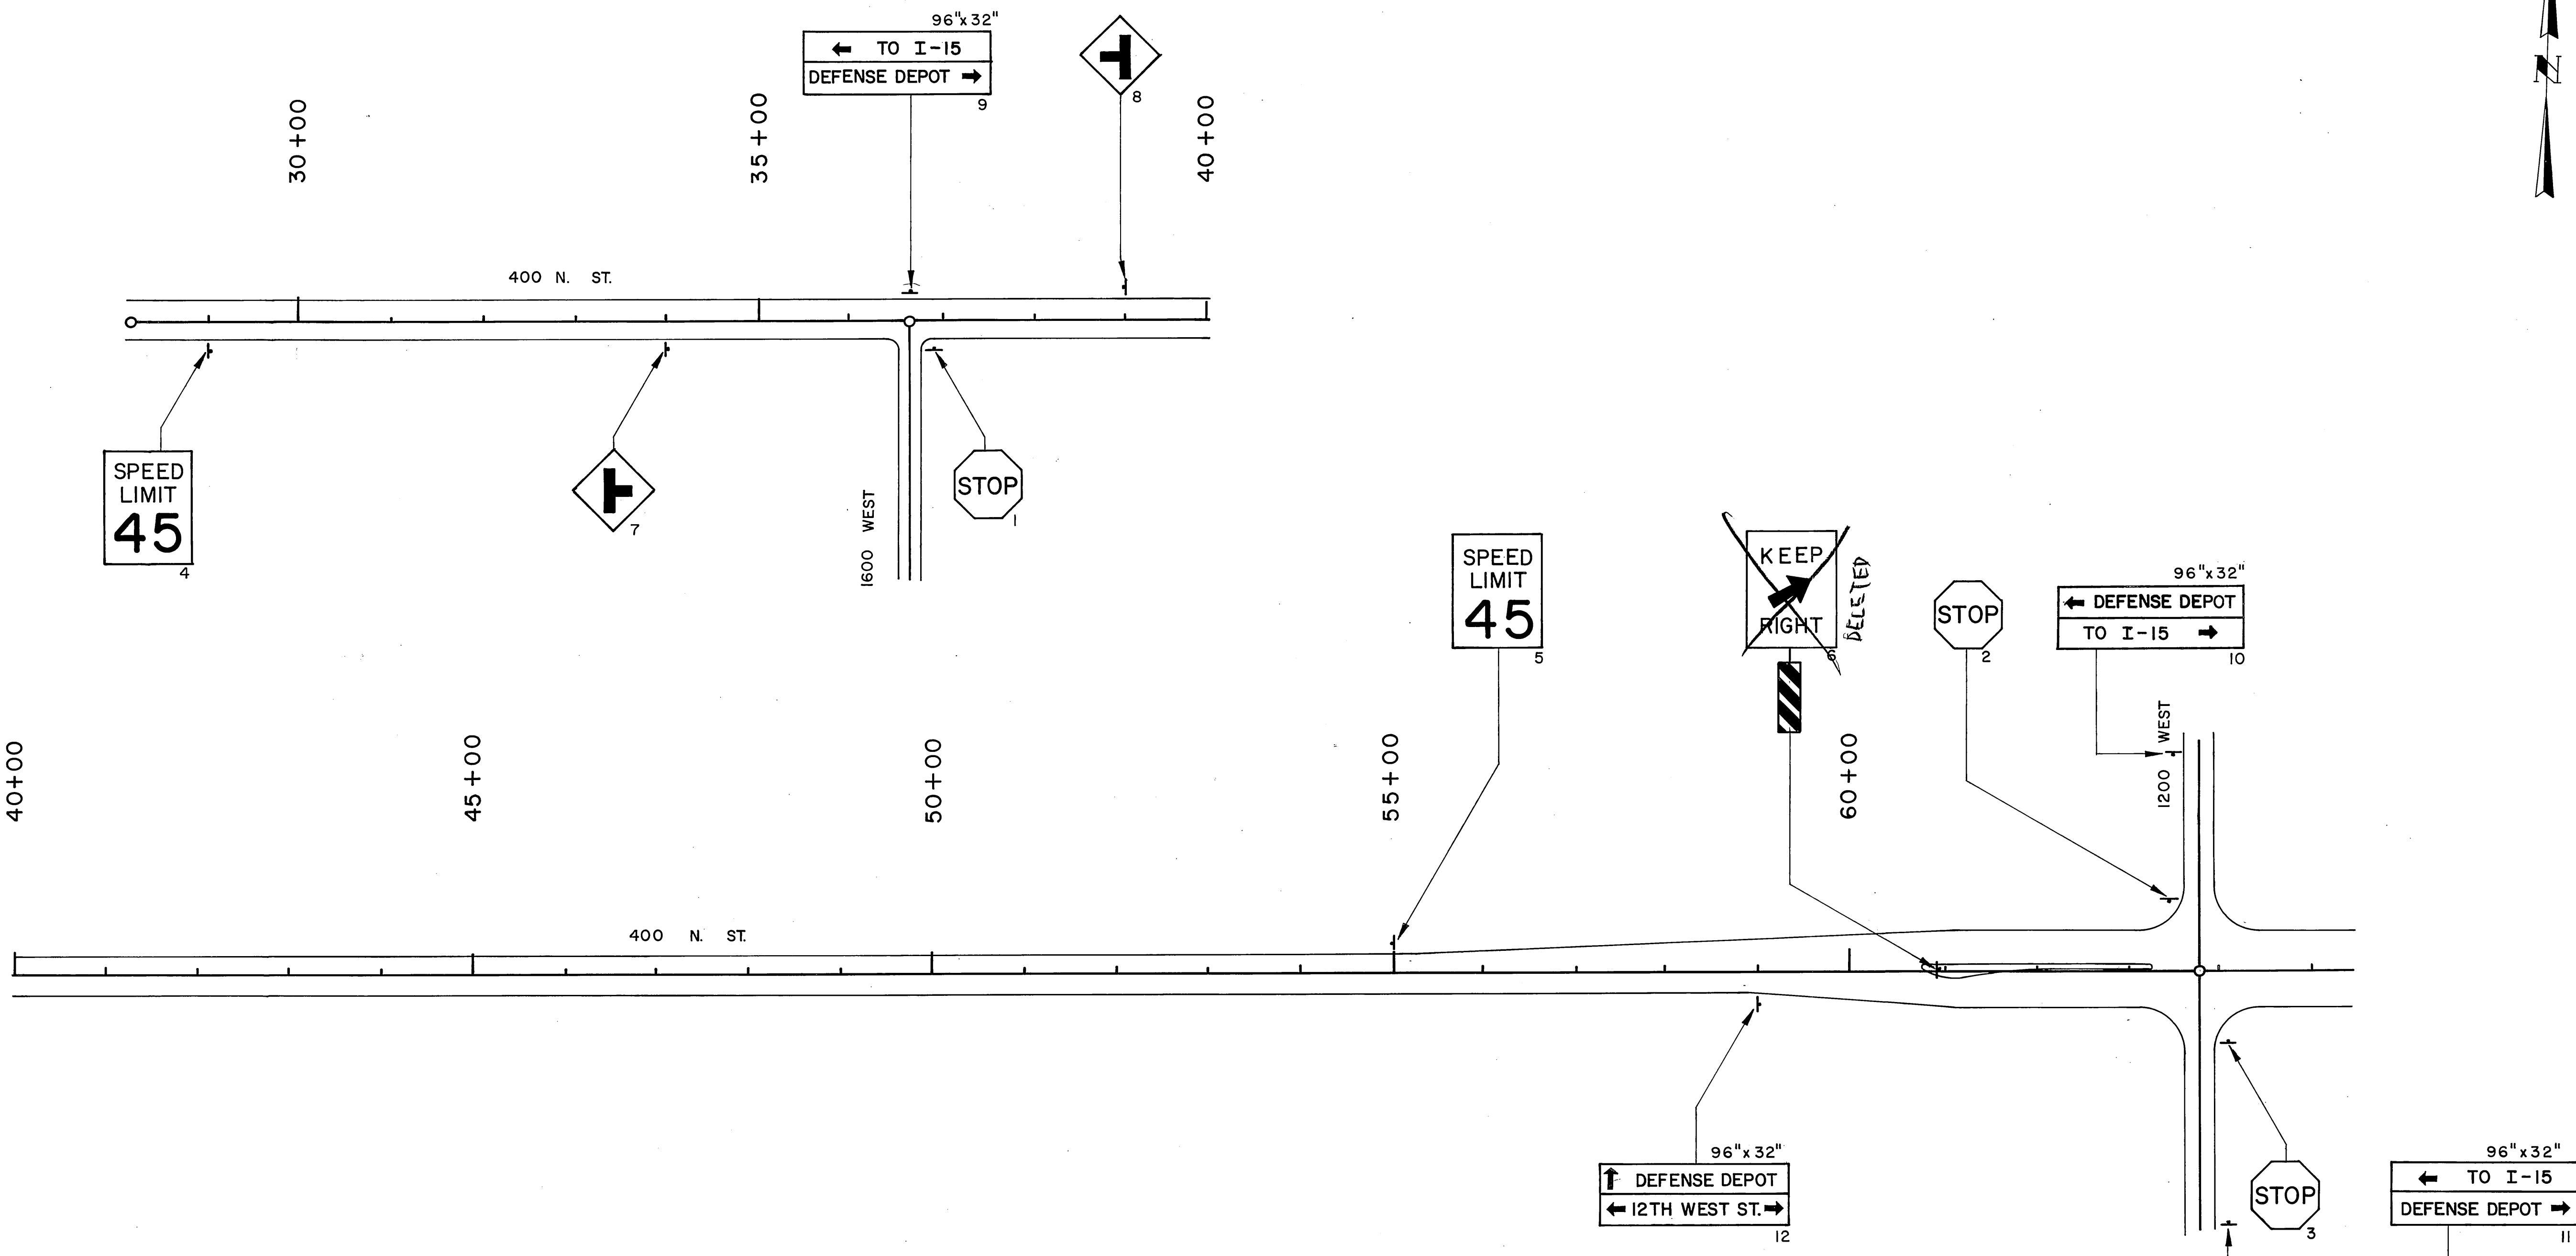

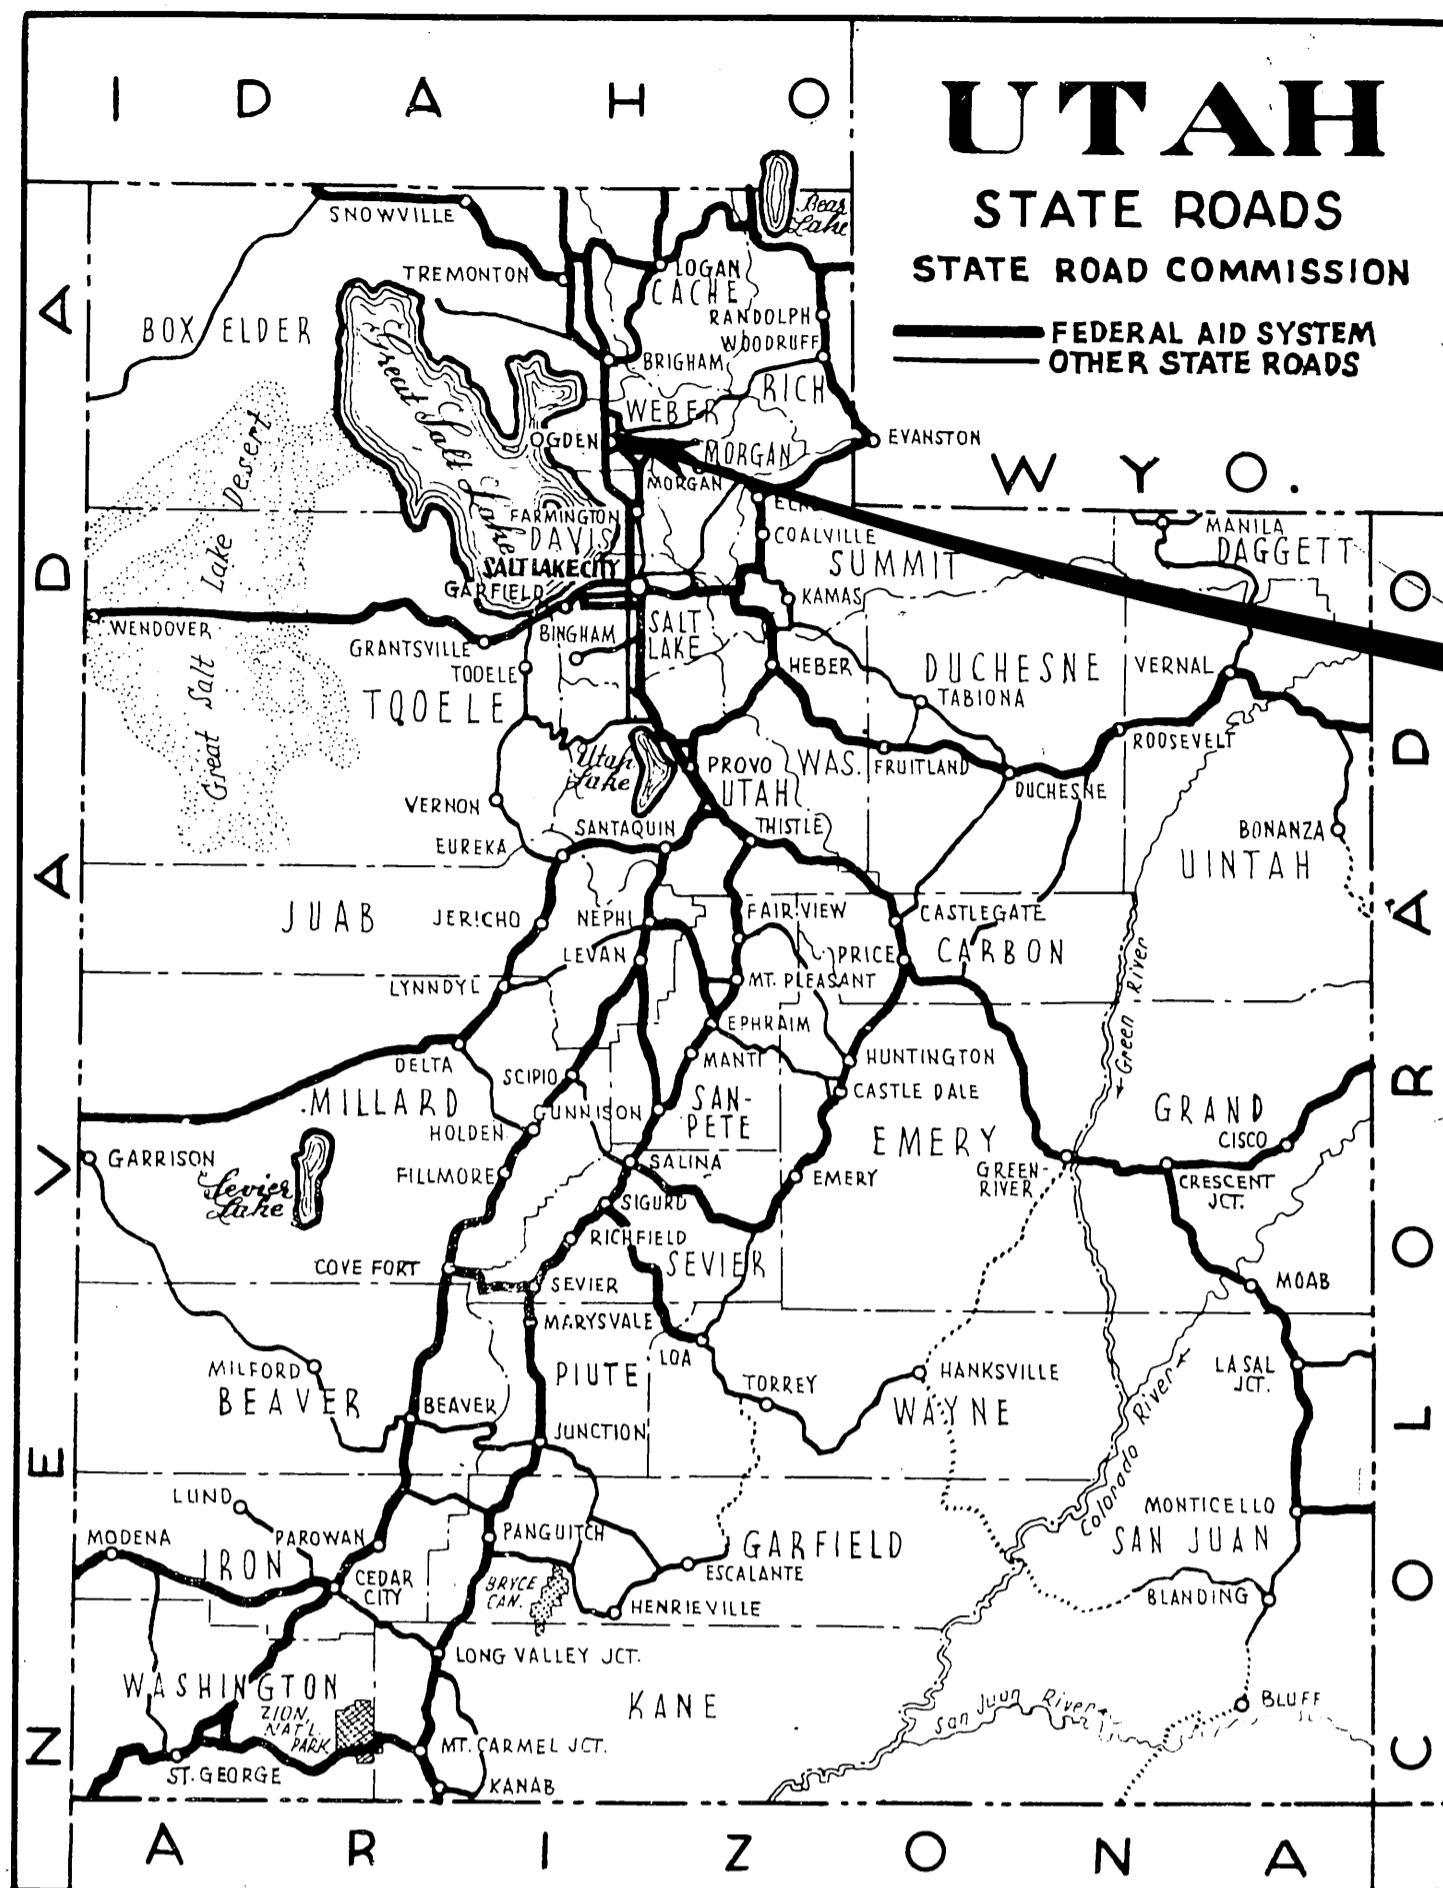

# STATE OF UTAH STATE ROAD COMMISSION


DD-53 (I)  
I-IG-15-8(23)338 9th CONTRACT

## PLANS OF PROPOSED STATE ROAD FEDERAL AID PROJECT

**DD - 53 (I)**  
**I-15 TO DEFENSE DEPOT OGDEN**

LENGTH 0.678 MILES

**I-IG-15-8(23)338 9th CONTRACT**  
**1600 WEST ST.**  
LENGTH 0.263 MILES  
WEBER COUNTY

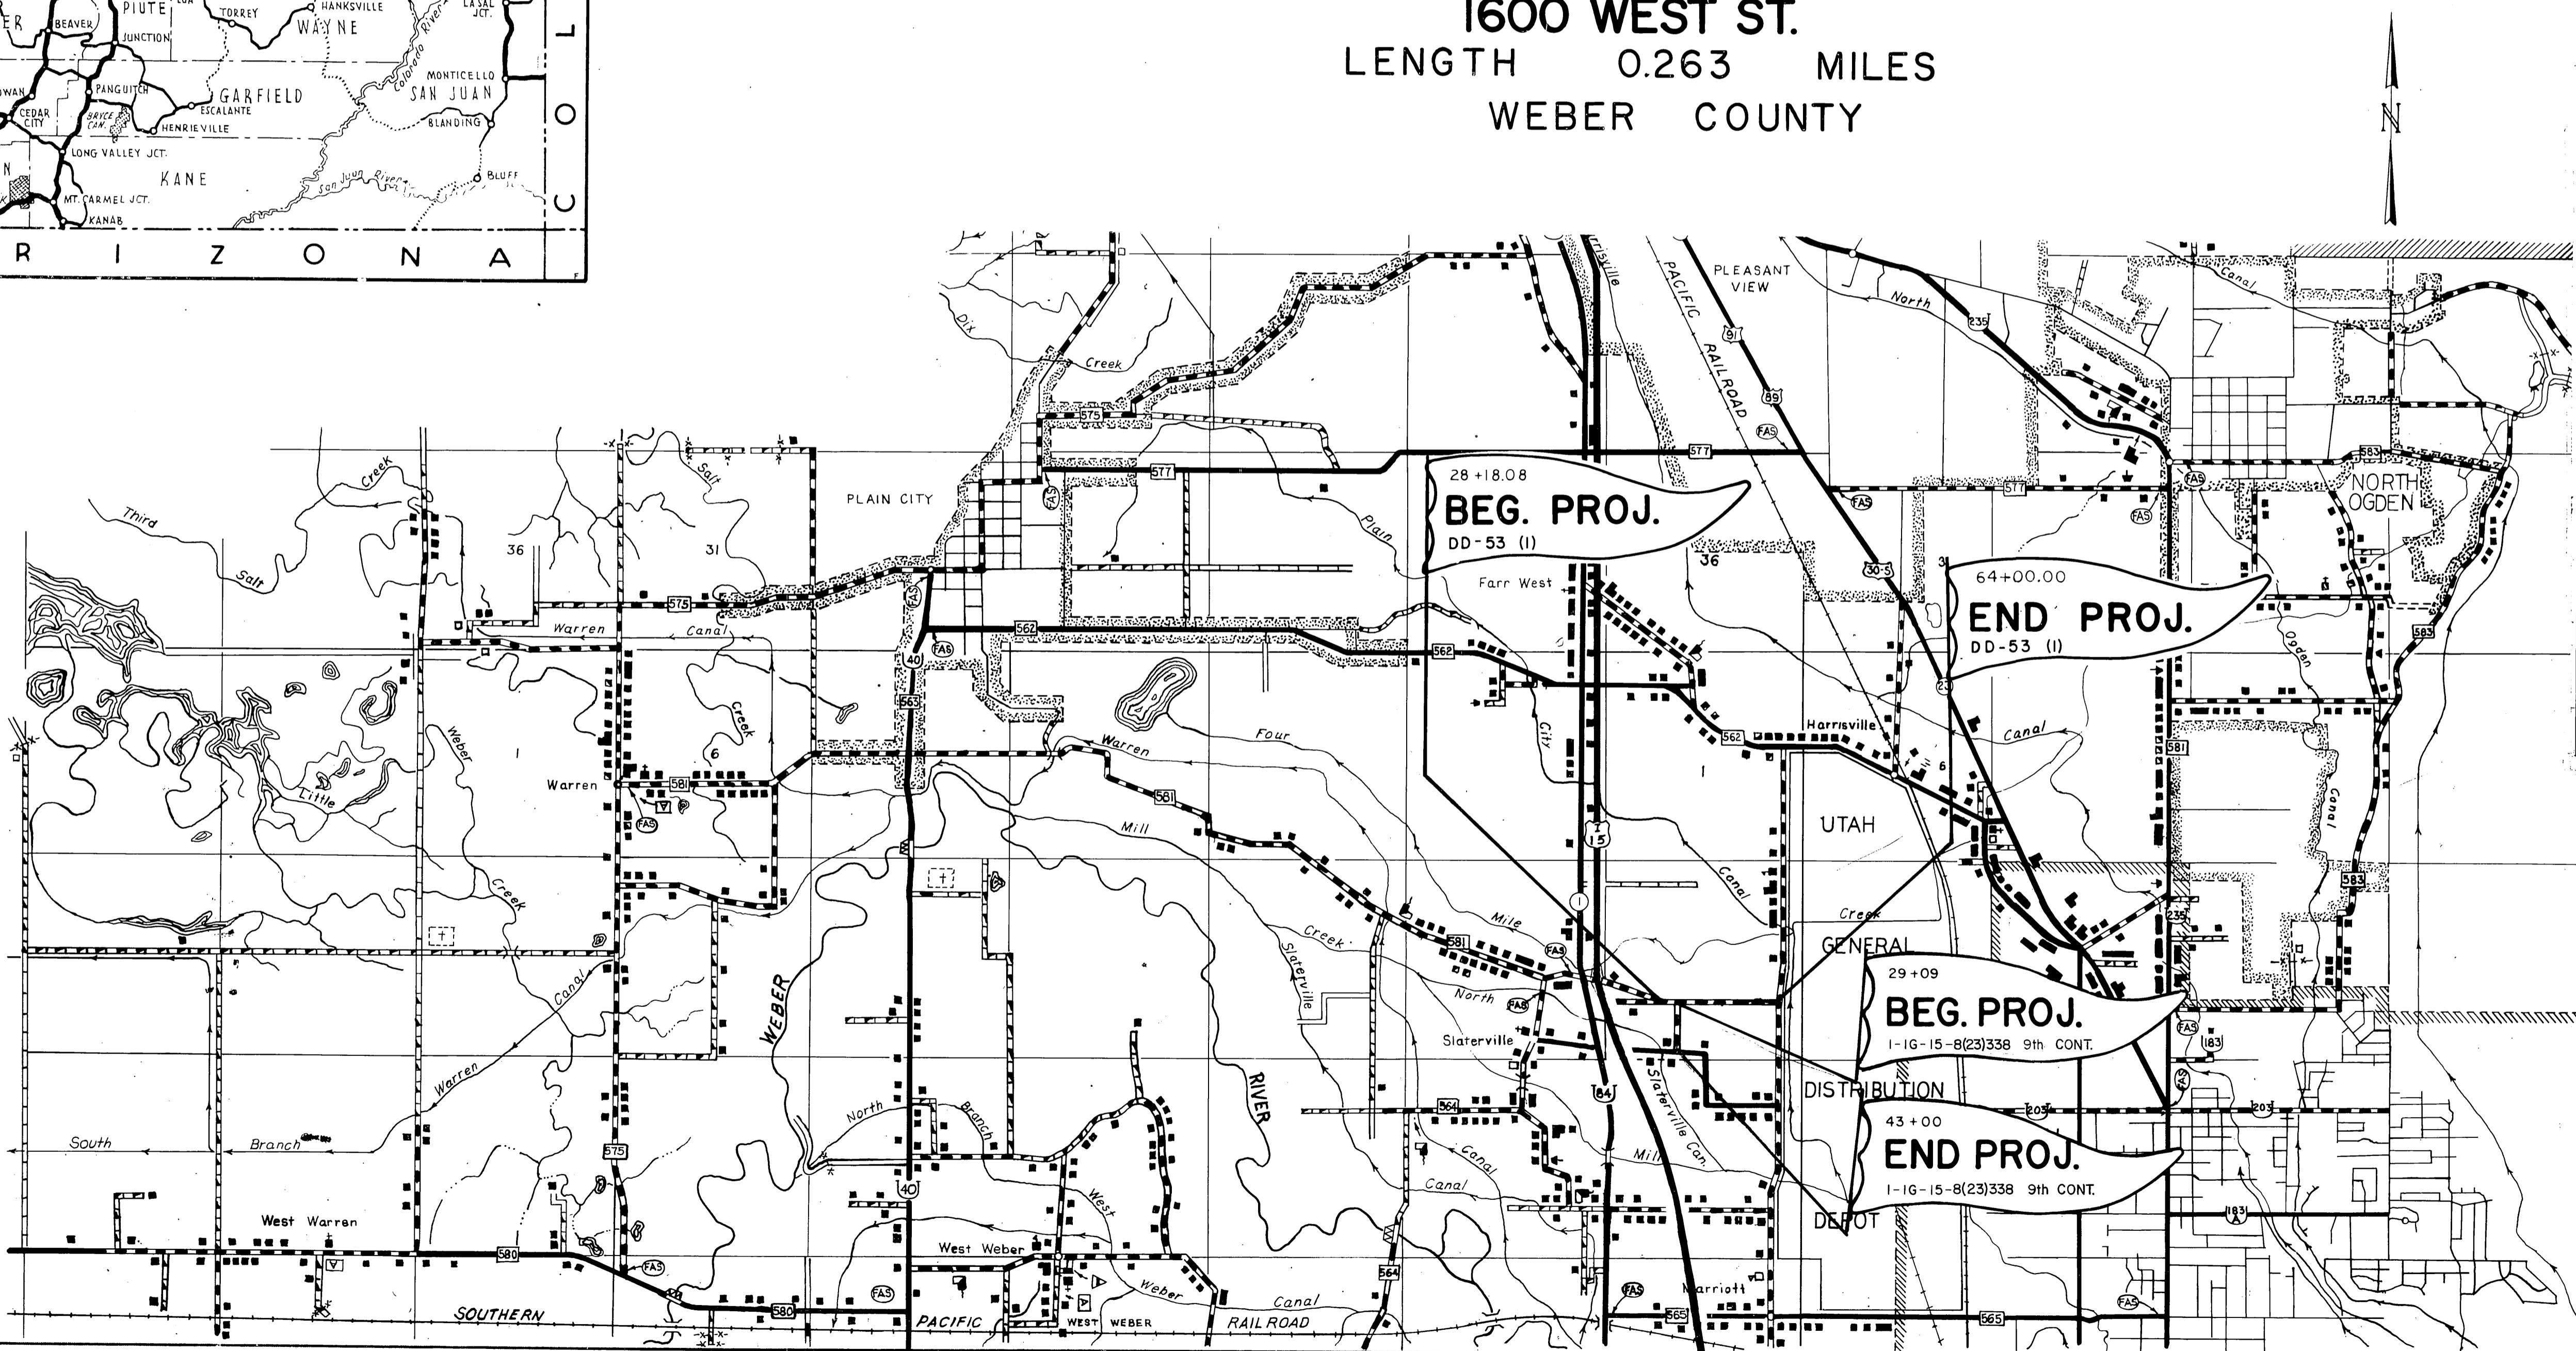

FEDROAD DIST. NO.	STATE	PROJECT NO.	FISCAL YEAR	SHEET NO.	TOTAL SHEETS
UTAH	UTAH	DD-53 (I)		I	
UTAH	UTAH	I-IG-15-8(23)338		I	

9th CONTRACT

INDEX TO SHEETS ON DD-53 (I)

SHEET NO.	DESCRIPTION	DRAWING NO.
1	TITLE SHEET	
2	TYPICAL CROSS SECTION	
3-3B	SUMMARY SHEETS	
4-6	PLAN PROFILE	
7	CHANNELIZATION	
8	SIGNING	
9	STANDARD CLEANOUT & JUNCTION BOXES	V-777
10	STANDARD HEADWALL	V-532

INDEX TO SHEETS ON I-IG-15-8(23)338 9th CONT.

Sheet No.	DESCRIPTION	Drawing No.
1	TITLE SHEET	
2	TYPICAL CROSS SECTION	
3	SUMMARY SHEETS	
4	PLAN PROFILE	

STANDARD DRAWINGS APPLICABLE THIS PROJ.

DESCRIPTION	DRAWING NO.
SUPERELEVATION AND WIDENING	805-1A, 1B
RAISED MEDIAN	815-5
CONSTRUCTION SIGNING	745-1A
CONSTRUCTION SIGNING	745-B, C, D
CONSTRUCTION SIGNING	745-1E
CONSTRUCTION IDENTIFICATION	745-6
PROJECT & R/W MARKERS, GUIDE POST & MAIL BOXES	725-1
DIVERSION BOX	650-1
DIVERSION BOX	650-2, 3
CONCRETE CURB AND GUTTER	615-1
METAL CULVERT END SECTIONS	605-2
REINFORCED CONCRETE CULVERTS	605-20
P/W FENCE & GATES	720-1
METAL CULVERTS	605-1
CHAIN LINK FENCE	720-3
EXIT & ENTRANCE RAMP DELINEATION	726-1
HIGHWAY SIGN STANDARDS INTERSTATE SYSTEM	745-20A
HIGHWAY SIGN STANDARDS INTERSTATE SYSTEM	745-20B
HIGHWAY SIGN STANDARDS INTERSTATE SYSTEM	745-20C
ROUTE MARKERS INTERSTATE SYSTEM	745-30
ROUTE MARKER AUXILIARIES INTERSTATE SYSTEM	745-31
GUIDE SIGN ARROWS (INTERSTATE)	745-40
TYPICAL PAVEMENT MARKINGS (FREEWAY SYSTEMS)	745-41
GROUND MOUNTED SIGNS INSTALLATION DETAILS	745-50A
GROUND MOUNTED SIGNS INSTALLATION DETAILS	745-50B
GROUND MOUNTED SIGNS INSTALLATION DETAILS	745-50C
GROUND MOUNTED SIGNS INSTALLATION DETAILS	745-50D
GROUND MOUNTED SIGNS INSTALLATION DETAILS	745-50E

UTAH STATE DEPARTMENT OF HIGHWAYS  
RECOMMENDED FOR APPROVAL JANUARY 1970

CHIEF ROADWAY DESIGN DIVISION  
RECOMMENDED FOR APPROVAL JANUARY 1970

ENGINEER FOR PRECONSTRUCTION

APPROVED JANUARY 1970

*Ron L. Lewis*  
STATE HIGHWAY ENGINEER

DEPARTMENT OF COMMERCE  
BUREAU OF PUBLIC ROADS

APPROVED

DIVISION ENGINEER DATE


# TYPICAL CROSS SECTION

FED. ROAD DIST. NO.	STATE	PROJECT NO.	FISCAL YEAR	SHEET NO.	TOTAL SHEETS
UTAH	UTAH	I-IG-15-8(23)338		2	


9TH CONTRACT

## BITUMINOUS MATERIALS

BITUMINOUS MATERIAL GRADE AC-20 PEN. ASPHALT REQ'D. IN MIX  
 BITUMINOUS MATERIAL GRADE MC-70 OR MC-250 REQ'D. FOR PRIME COAT  
 BITUMINOUS MATERIAL GRADE RC-70 OR RC-250 REQ'D. FOR FLUSH COAT & TACK COAT  
 BITUMINOUS MATERIAL GRADE AC-PM PEN. ASPHALT REQ'D. IN SEAL

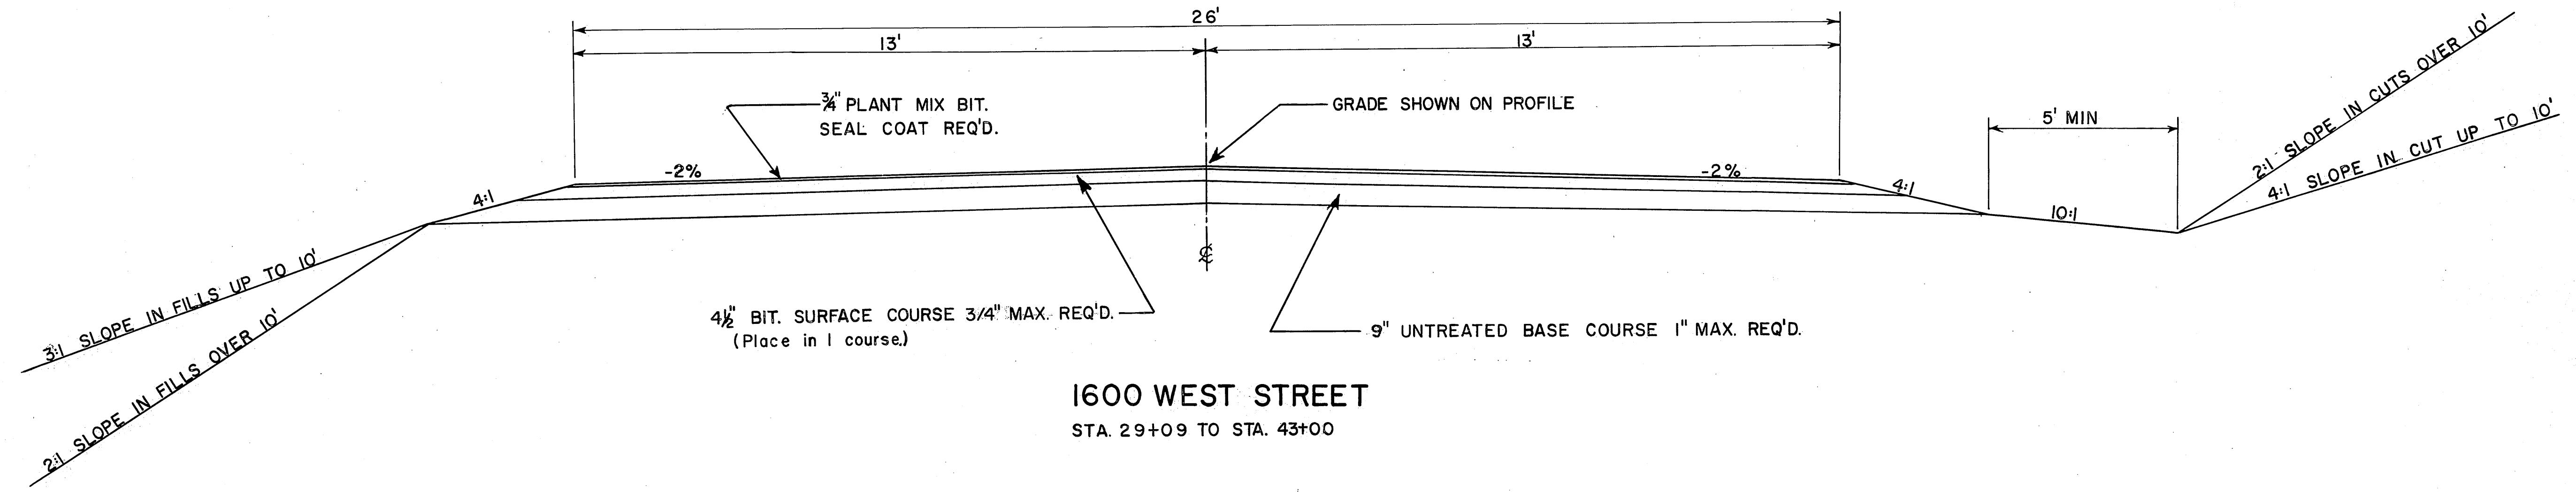

REVISIONS	BY	DATE

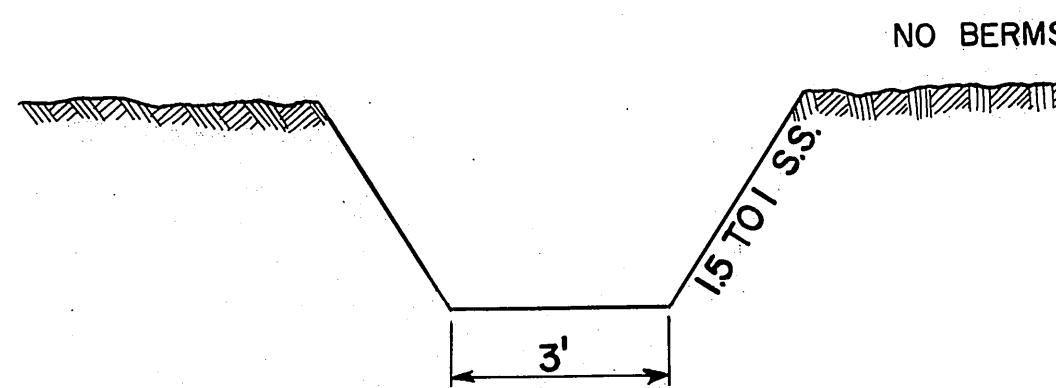

DESIGN SPEED 25 M.P.H.

UTAH STATE ROAD COMMISSION  
SALT LAKE CITY - UTAH

BITUMINOUS  
SURFACED  
ROADWAY

# **SUMMARY SHEET**

REVISED- 1-14-70

FED ROAD DIST NO	STATE	PROJ. NO	FISCAL YEAR	SHEET NO.	TOTAL SHEETS
UTAH	UTAH	I-IG-15-8(23)338		3	

OTH CONTRACT 12-70

MISCELLANEOUS			
NAME	UNIT	QUANTITY	
MOBILIZATION	LUMP	•	
FLAGGING	HOUR	480	
6' CHAIN LINK 10' GATES	EACH	2 0	
DELINEATORS	EACH	+ 0	
MOVING MAILBOXES	EACH	7 1.0	
RECONST. C.O.B., MANHOLE & MON. BOX	EACH	2 1.0	
MODIFICATION OF EXISTING WELL	LUMP	•	

<b>WATERING</b>	
CONSTRUCTION SOURCE REFERENCE	
FIELD BOOK	PAGE
2,373.39 TONS = 1, 255.8 CU. YD.	
$\frac{1,255.8}{40} = 31.4$	
USE 35 M GAL	
<b>COMPACTION</b>	
CONSTRUCTION SOURCE REFERENCE	
FIELD BOOK	PAGE
$\frac{1391' \times 35' \times 0.6667}{1,202.2}$	
USE 1,300 CU. YD.	

STATION TO STATION	LENGTH	GRAVEL MATERIAL				BITUMINOUS MATERIAL				PLANT MIX BIT. SEAL COAT				CONSTRUCTION SOURCE REFERENCE							
		BITUMINOUS SURFACE COURSE		UNTREATED BASE COURSE		PENASPH. AC-20		RC-70 / RC-250		MC-70/ MC-250		AVG. WIDTH	DEPTH	140 LBS. PER CU. FT.	PEN. ASPHALT AC-PM						
		148LBS. PER CU.FT.		140 LBS. PER CU. FT.		RATE OF APPL.	1" MAX.	SEAL COAT		PRIME COAT					RATE 7% BY WEIGHT						
		Avg.Width	Depth	Ton	Avg.Width	Depth	Ton	Percent	Ton	Width	Ton	Width	Ton	ft.	In.	Ton	Percent	Ton	Field Book	Page	
29+09 TO 43+00	1,391	28'	4.5'	1,058.90	32.5'	9"	2,373.39	.05	60.70	26.5'	1.67	29.5'	4.65	26.25	3/4	155.04	.07	10.85			
TOTAL				1,058.90			2,373.39		60.70		1.67		4.65				155.04		10.85		
USE				1,120			2,650		70		2		5				170		12		

STATION	STATION	R/W MARKERS		CONSTRUCTION SOURCE REFERENCE	
		LT.	RT.	FIELD BOOK	PAGE
29+40					
36700					
42+72					
TOTAL		3	3		
USE		6	0		

STATION	STATION	R/W FENCE TYPE "B"		CONSTRUCTION SOURCE REFERENCE	
		LT.	RT.	FIELD BOOK	PAGE
29+34	+75	520			
29+40	34+60	504 <sup>1</sup>			
TOTAL		504 <sup>1</sup>			
USF		520			
		504 <sup>1</sup>			

<b>HIGHWAY TRAFFIC PAINT</b>		<b>STD. DRWG.</b>	
		<b>NO. 745-41</b>	
<b>APPLICATION</b>	<b>FOR ESTIMATING PURPOSES ONLY</b>	<b>4" SKIP WHITE</b>	
<b>TYPE OF STRIPING</b>	<b>GAL. PER MILE</b>	<b>MILE</b>	<b>GAL.</b>
<b>4" SKIP WHITE LINE</b>	<b>6</b>	<b>.26</b>	<b>1.65</b>
<b>TOTAL</b>		<b>.26</b>	<b>1.65</b>
<b>USE</b>			<b>2</b>

STATION	STATION	R/W GATES				CONSTRUCTION SOURCE REFERENCE	
		LT.		RT.		FIELD BOOK	PAGE
		14'	16'	14'	16'		
34+54 58				1			
TOTAL				1			
USE				1			

STATION	STATION	6' CHAIN LINK FENCE TYPE II		CONSTRUCTION SOURCE REFERENCE	
		LT.	RT.	FIELD BOOK	PAGE
37+08	42+38.6 42+68	520.6 540			
TOTAL		540			
USE		520.6	540		

NOTE:  
QUANTITIES SHOWN ON THESE PLANS ARE APPROXIMATE.


REVISED - 1-14-70  
AC 12-7-70

FED. ROAD DIST. NO.	STATE	PROJECT NO.	FISCAL YEAR	HEET NO.	TOTAL SHEETS
UTAH	UTAH	I-1G-15-8(23)338	4		



9TH CONTRACT

### END PROJ.

I-1G-15-8(23)338, 9th Cont.

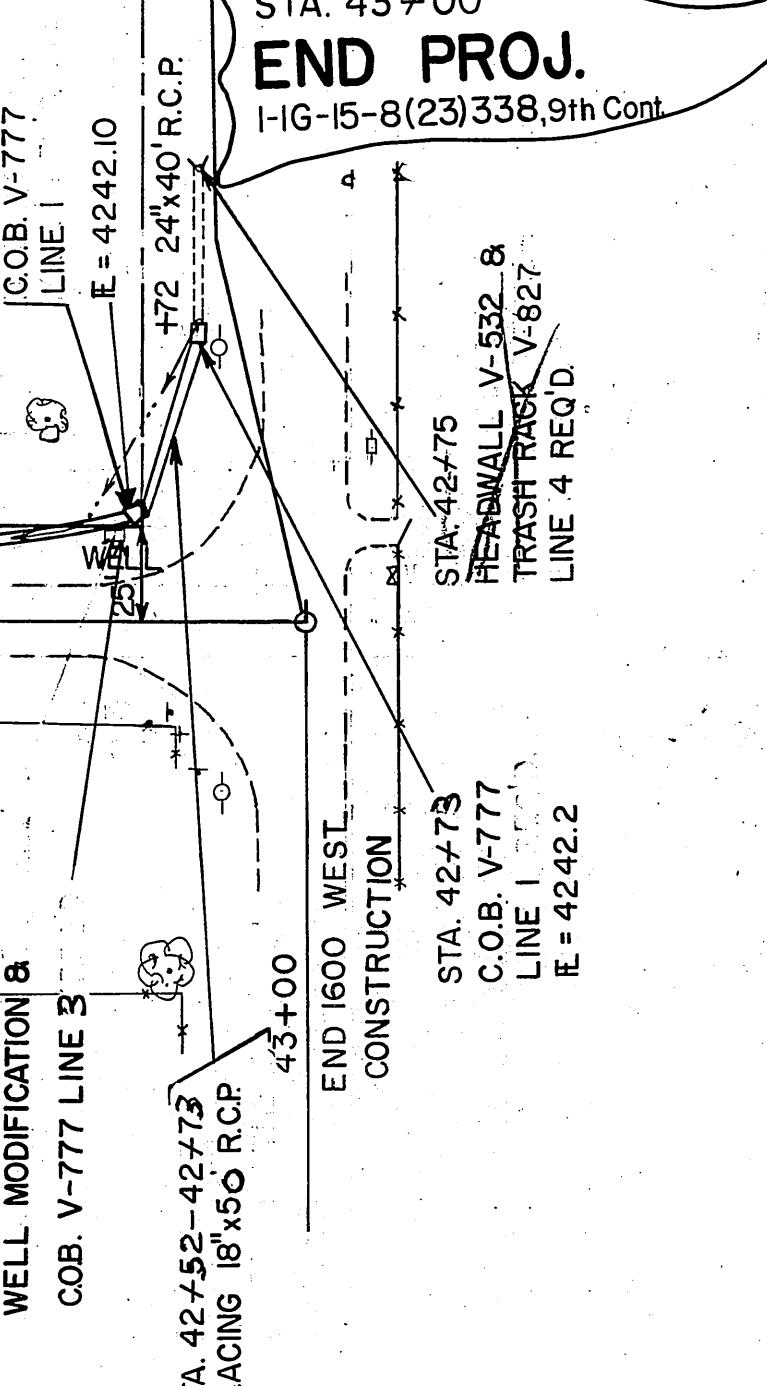

WELL MODIFICATION DETAIL

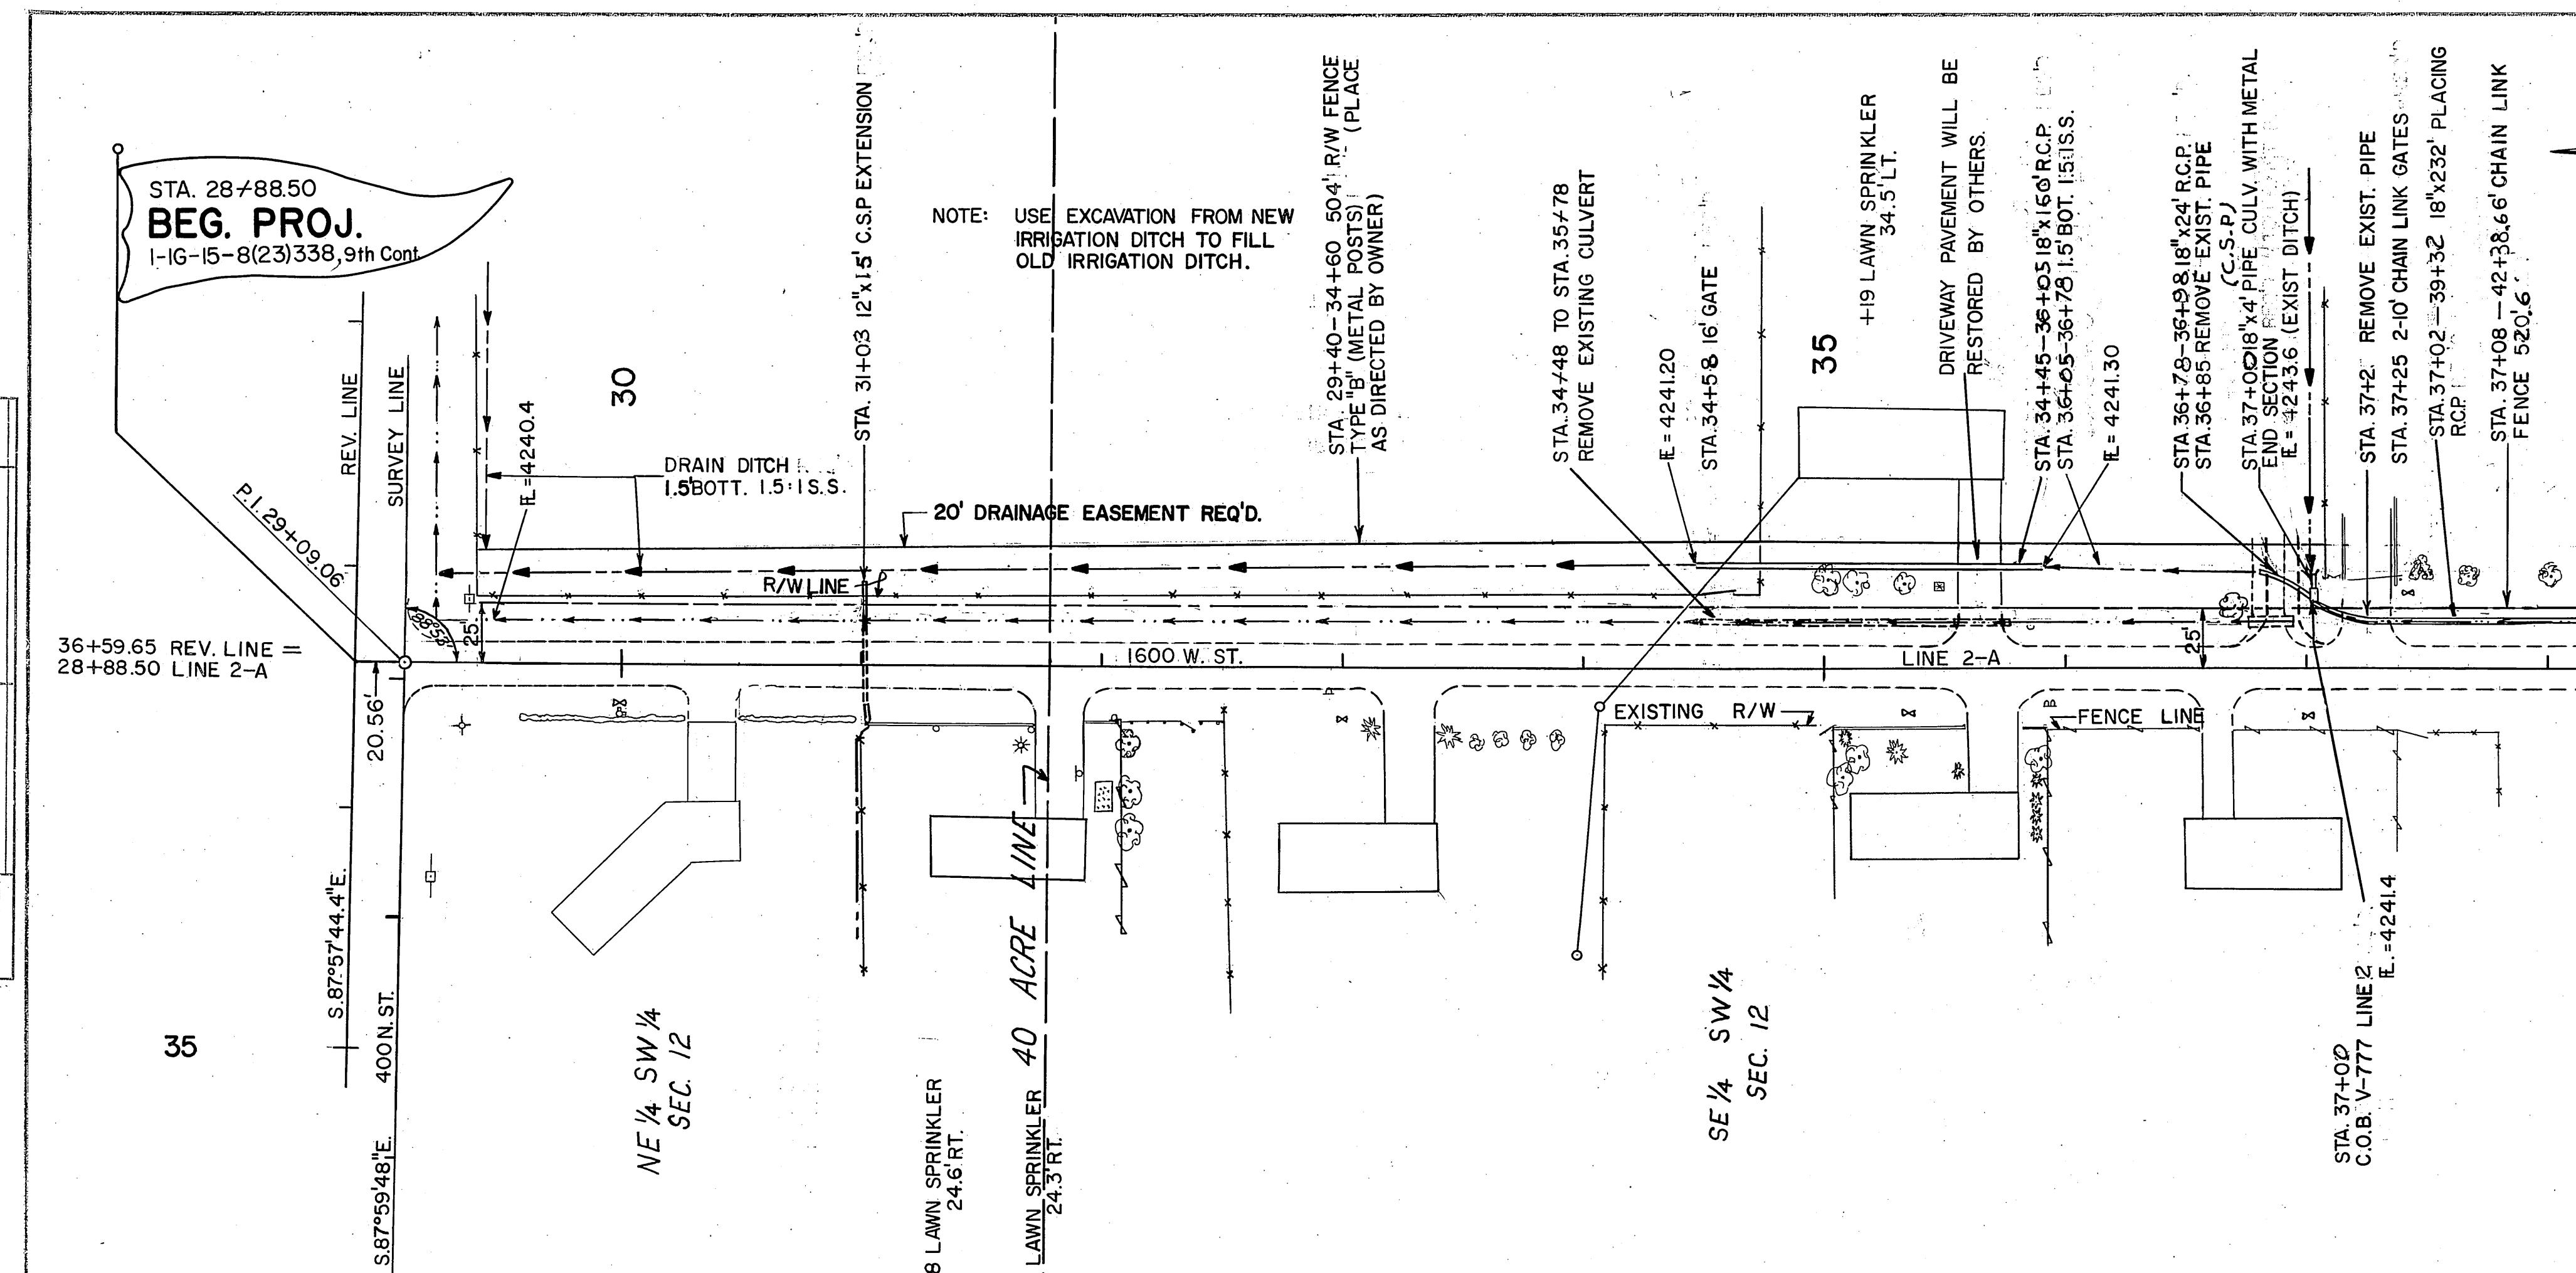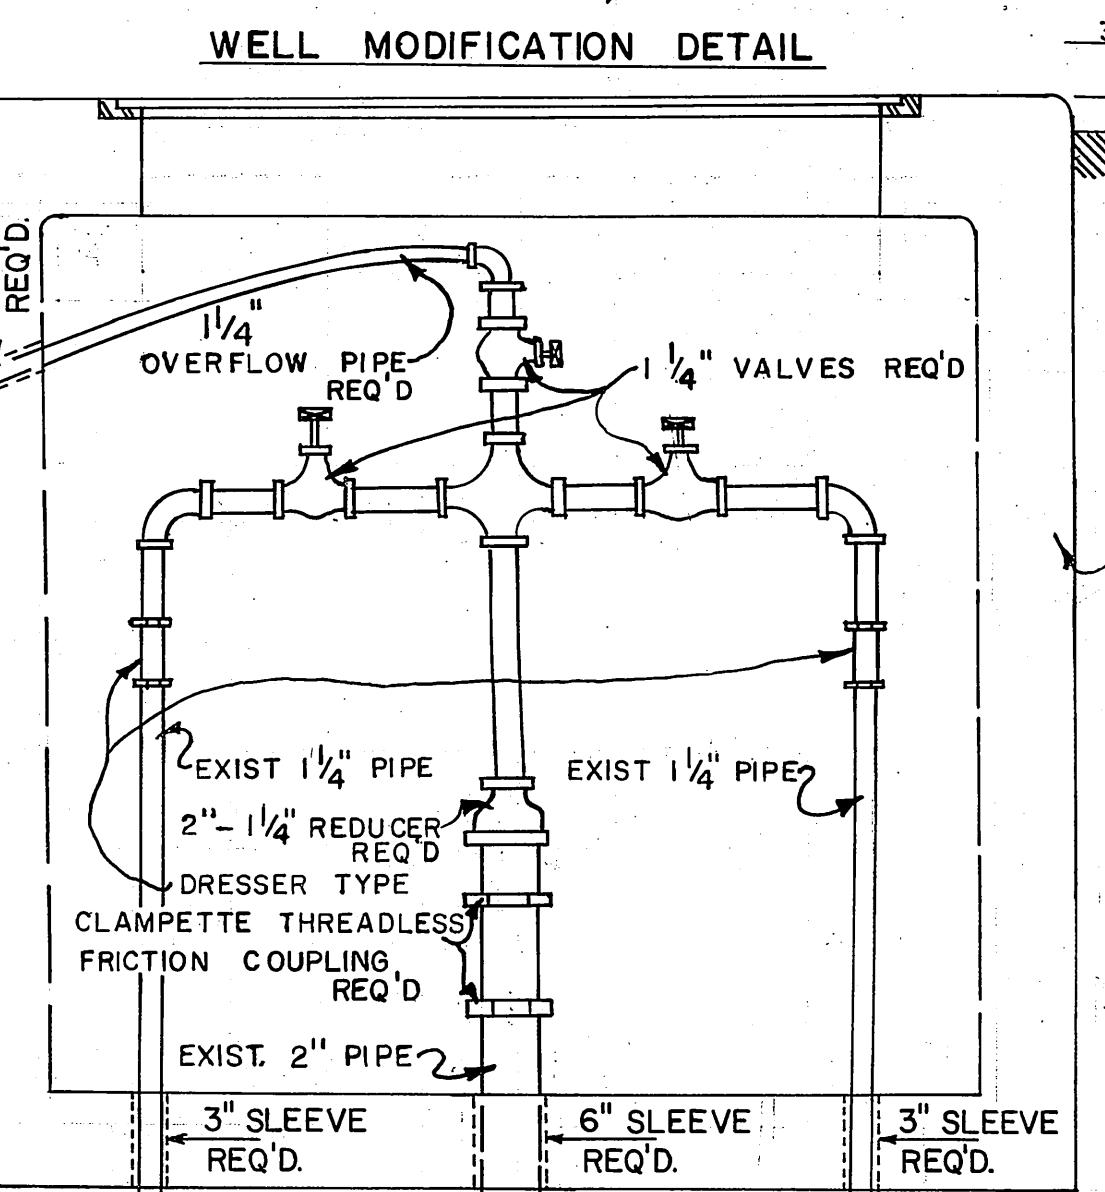

PROFILE SURVEYED ID	BY	DATE
NOTE: SURVEYED GRADES CHECKED STRUCTURE ROTATING CYLINDRICAL NO. 17289		
4255		
4250		

4245


3510

3505

3500

3495

3490

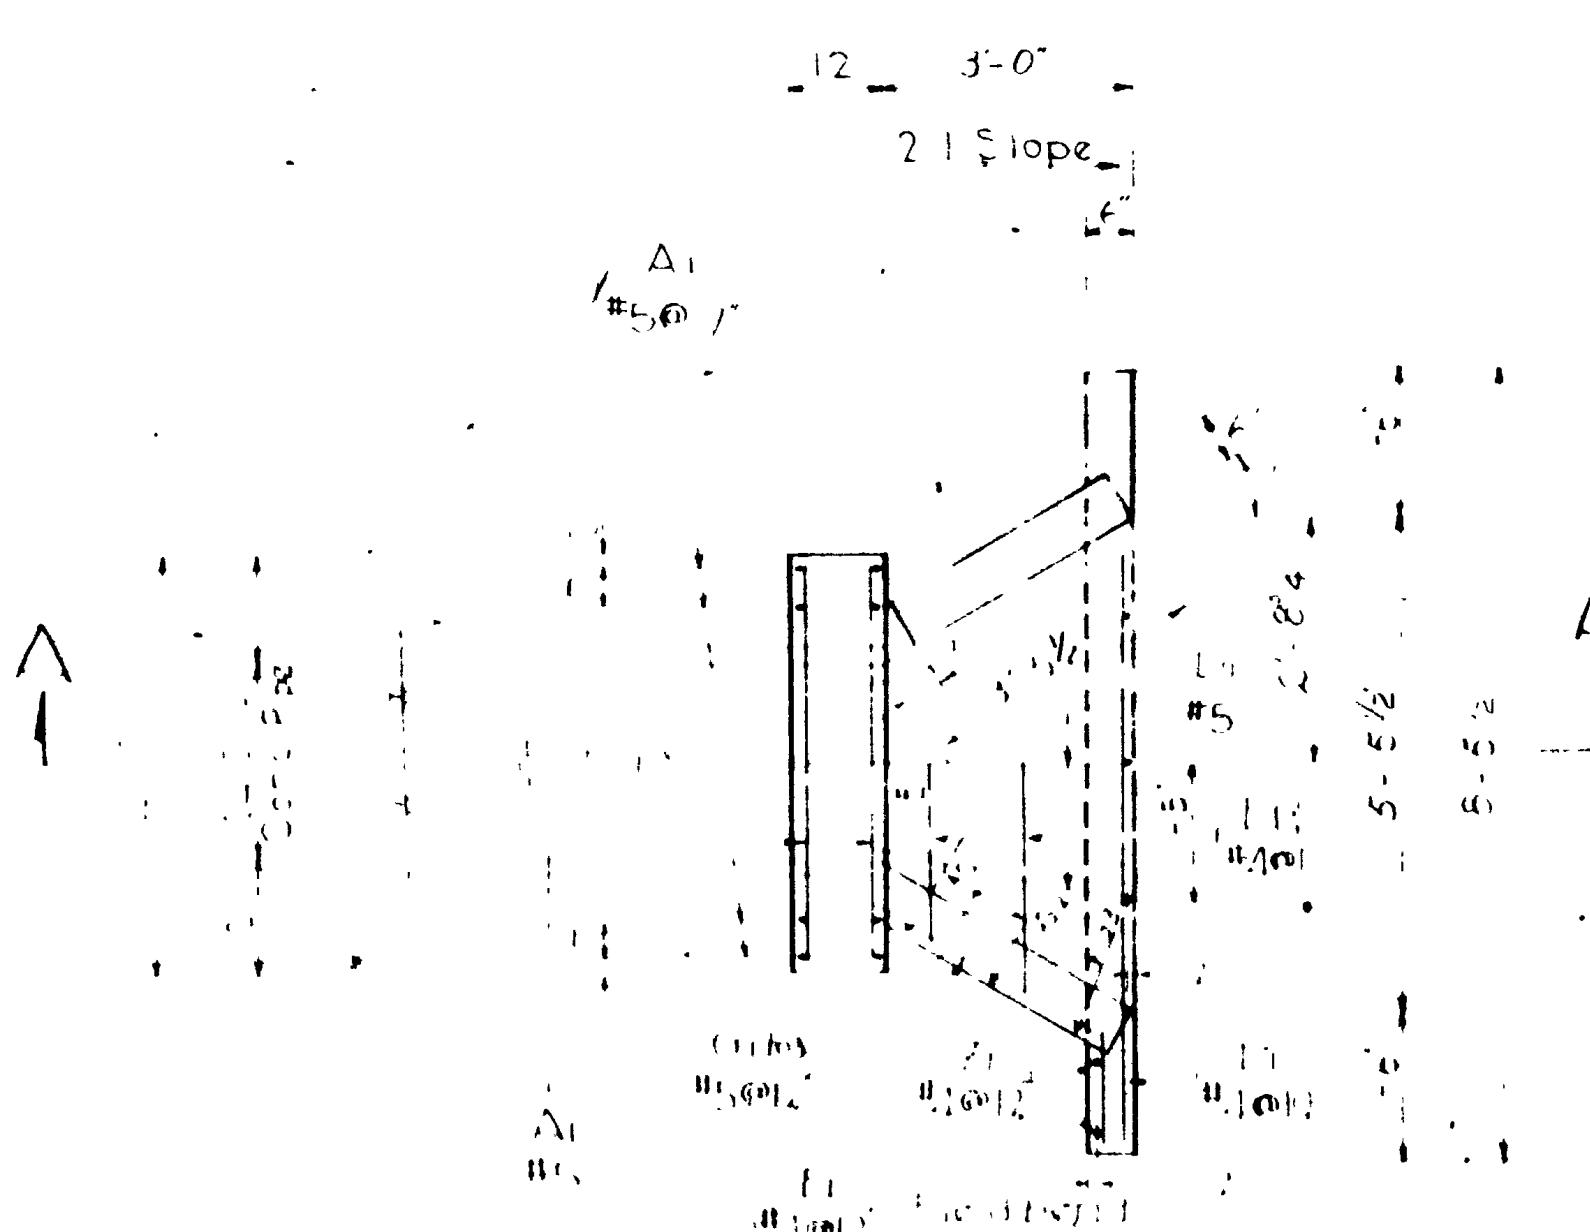

PLAN

Note: Field bend rods  
at 1/2 ft. on center - slope



Mark	LOCATION	SIZE SNO	LENGTH	No. BARS	TOTAL LENGTH	SKETCH
A1	Headwall	C	3'-8"	6	58'-8"	
C1	Apron	C	5'-7"	3	16'-9"	3 5 C
F1	"	A	3'-3"	1	3'-3"	
F2	"	A	4'-5"	1	4'-5"	
F3	"	A	4'-8"	4	18'-8"	
F4	"	A	2'-7"	1	2'-7"	
F5	"	A	3'-1"	1	3'-1"	
G1	Wings	C	5'-6"	1	5'-6"	
G2	"	C	5'-6"	2	10'-0"	a - F 4"
G3	"	C	2'-7"	2	5'-4"	a - F H
H1	End Edg. Wall	C	8'-0"	5	40'-0"	a - F G
I1	W.W. L. L.	C	5'-2"	4	20'-8"	
92' 1" #4 @ 0.668% = 62.0" 6.2" 0" 0" 16' 8" #1 @ 0.045% = 80.0" 8.0" 0" 0" Total 142' 0" 0" 0" 0"						

#### GENERAL NOTES

Materials, construction and workmanship shall be in accordance with the Utah Department of Highways Standard Specifications for Road and Bridge Construction, Interim Issue March 1968, and Supplements thereto which are in effect at the date of request for bids.

All reinforcing steel shall be deformed billet-steel bars conforming to ASTM Designation A615-68, grade 40. Concrete shall be class A (AD).

Place full ballast as practicable before building "berminder" curve concrete seven days before backfilling.

#### DESIGN DATA

The design is in accordance with the AASHTO Specifications of 1965, and Interim Specifications.  
 f<sub>c</sub> = 1200 psi  
 f<sub>s</sub> = 20,000 psi  
 n = 10

#### QUANTITIES

(for one headwall only)

Excavation for structures	4 Cu.yd
Concrete (class A (AD))	13 Cu.yd
Reinforcing steel	192 lb
Backfill	25 Cu.yd

STANDARD  
GENERAL  
NOTES

1	2	3	714

