


STATE OF UTAH STATE ROAD COMMISSION

FED. ROAD DIST. NO.	STATE	FED. AID PROJ. NO.	FISCAL YEAR	SHEET NO.	TOTAL SHEETS
12	UTAH	221-A(1)	1942	1	16
"	"	DA-WR 5(1)	1942	1	16
"	"	222-A(1)	1942	1	17
"	"	DA-WR 6(1)	1942	1	16
"	"	114-E(1)	1942	1	14
"	"	114-C(2)	1942	1	12
"	"	226-A(1)	1942	1	4
"	"	DA-WR 7(1)	1942	1	7
"	"	224-A(1)	1942	1	4
"	"	DA-WR 8(1)	1942	1	11
"	"	225-A(1)	1942	1	4
"	"	DA-WR 9(1)	1942	1	11

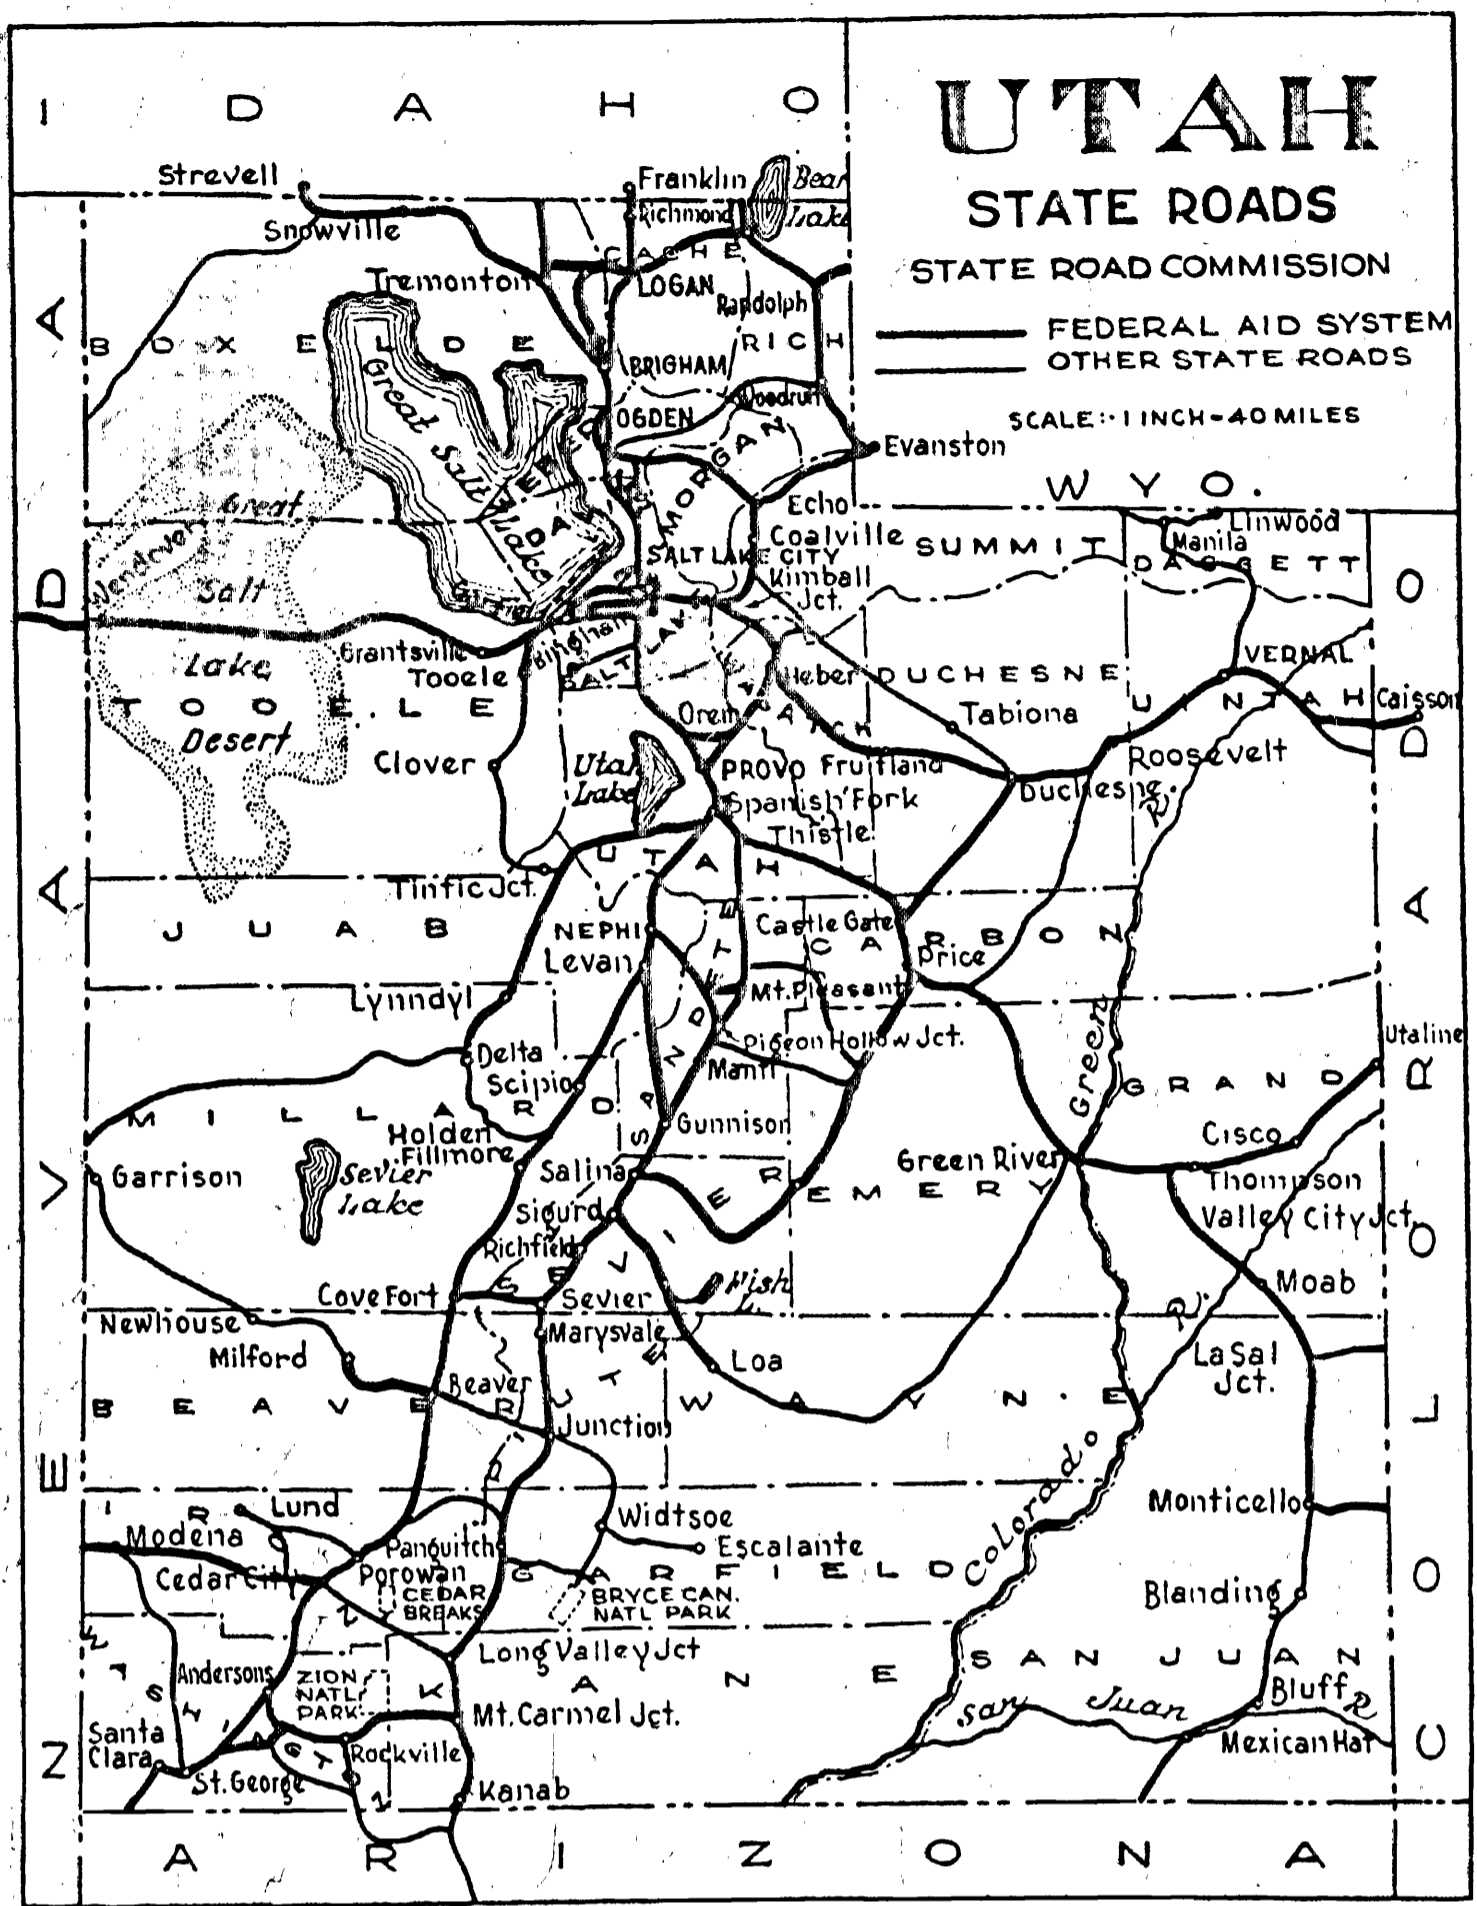

PLANS OF PROPOSED STATE ROAD FEDERAL AID PROJECT

- AW (PE) F.A.P. No 221-A(1) LENGTH 0.254 MILES
- DA-WR No 5(1) LENGTH 0.254 MILES
- AW (PE) F.A.P. No 224-A(1) LENGTH 0.506 MILES
- DA-WR No 6(1) LENGTH 0.083 MILES
- SN-F.A.P. No 114-E(1) LENGTH 0.939 MILES
- SN-F.A.P. No 114-C(2) LENGTH 2.971 MILES
- AW (PE) F.A.P. No 226-A(1) LENGTH 0.117 MILES
- DA-WR No 18(1) LENGTH 0.117 MILES
- AW-F.A.G.M. No 234-A(1) FL. LT. SIGNALS
- AW (PE) F.A.P. No 225-A(1) LENGTH 0.094 MILES
- DA-WR No 17(1) LENGTH 0.094 MILES

INDEX TO SHEETS AW-F.A.G.M. 234-A(1)

SHEET	DESCRIPTION	DRAWING	STATION
1	TITLE SHEET		
2	PLAN AND PROFILE		
3	R.R. ADV. WARNING SIGN (FIG-7)	GC-40	
4	F.L. SIGNALS (FIG-2A)	GC-40	
4	CIRCUIT PLAN & E.L. SIGNALS	GC-53	

INDEX TO SHEETS SN-F.A.P. 114-C(2)

SHEET	DESCRIPTION	DRAWING	STATION
1	TITLE SHEET		
2	TYPICAL SECTION		
3-8	PLAN AND PROFILE		
9	REINFORCING AND JOINT DETAILS	B-94	
10-11	STD. HIGHWAY SIGNS	B-95-1&2	
12	SUPERELEVATION OF CURVES	M-37	

INDEX TO SHEETS DA-WR No 6(1)

SHEET	DESCRIPTION	DRAWING	STATION
1	TITLE SHEET		
2, 2A	TYPICAL SECTIONS		
3-3A	PLAN AND PROFILE		
4	DETAILS OF C.C.G. & DRIVEWAY		
5-6	CHANNELIZATION		
7	SITUATION PLAN	V-277	
8-12	CONC. FLUME AND TRANSITION	D-474	1+9.6
13-15	27' O ₁₀ WOOD BRIDGES (300 FT. & RT.)	A-400	1+9.6
16-18	N.W. & S.W. WIND WALL TO HOME STRUCT.	V-309	1+9.6±
19-24	MISC. DRAINAGE STRUCTURES	V-311	3+00 TO 5+
25-27	CONC. WING WALL W/END UNDERPASS	V-307	4+
28-30	" " " " " " " " " " " "	V-306	4+93.6 TO 5+
31-35	47'-6" O ₁₀ RIGID FRAME UNDERPASS	D-475	4+70.6
36-40	45' O ₁₀ " " " " " " " " " " " "	D-476	4+71.1
41-44	CONC. RET. WALL BETW. TRACK STRUCT.	V-308	4+35.6 to 4+
45	F.A.P. AND R/W MARKERS	M-45	
46	REIN. & JOINT DETAILS	B-94	
47	CURB & GUTTER DETAILS	B-48-1	
47A	DETAILS OF TRACK LAYOUT AT UNDERPASS	F-22	
7-30' X SECTIONS			

INDEX TO SHEETS DA-WR No 18(1)

SHEET	DESCRIPTION	DRAWING	STATION
1	TITLE SHEET		
2	TYPICAL SECTION		
3	PLAN AND PROFILE		
4-A	F.A.P. AND R/W MARKERS	M-45	
5-6	STD. ROAD SIGNS	B-95-1&2	
7	STD. XING SIGN FOR RAILROADS	V-159	
4-B	R.R. ADVANCE WARNING SIGN	J-483	
1-3	X-SECTIONS		

INDEX TO SHEETS DA-WR No 5(1)

SHEET No.	DESCRIPTION	DRAWING No.	STATION
1	TITLE SHEET		
2	TYPICAL SECTION		
3	PLAN AND PROFILE		
4-10	41' O ₁₀ CONC. T-BEAM BRIDGE	D-477	12+70.7
11	STD. CONC. CATCH BASIN	V-175-1/64	9+46.6
12	CONC. HEADGATE & OUTLET	V-825	VARIOUS
13	F.A.P. & R/W MARKERS	M-45	VARIOUS
14-15	R.R. XING SIGNALS & CIRCUIT PLAN	GC-47	
16-A	STD. R/W FENCE AND GATES	M-46	
1-6	X-SECTIONS		

INDEX TO SHEETS DA-WR No 6(1)




SHEET	DESCRIPTION	DRAWING	STATION
1	TITLE SHEET		
2	TYPICAL SECTION		
3&3A	PLAN AND PROFILE & PROPERTY KEY MAP		
4-6	MISC. STRUCTURES	V-329	2+35 TO 3+
7-10	36'-1" O ₁₀ TIMBER BRIDGE	A-402	2+87
11	DAVIS-WEBER CO. CANAL RELOCATION	V-328	2+87
12-13	STD. HIGHWAY SIGNS	B-95-1&2	
14-A	F.A.P. MARKERS	M-45	
16	STD. CATCH BASIN	V-330-1/12	0+52
16	" " R.R. XING SIGNAL	GC-40 Fig 2A	3+87.7
17	" " ADVANCE WARNING SIGN	J-483	3+87.7
18	CHANNELIZATION		
1-3	X-SECTIONS		

INDEX TO SHEETS SN-F.A.P. No 114-E(1)

SHEET	DESCRIPTION	DRAWING	STATION
1	TITLE SHEET		
2, 2A	TYPICAL SECTION		
3-4	PLAN AND PROFILE		
5	CHANNELIZATION AT ROY		
6	2' X 1' X 96'-9 1/2" CONC. CULV.	E-747	407+05
7	2' X 1' X 96'-9 1/2" " "		473+32
8-A	HEADGATES AND OUTLETS	V-313-1/42	VARIOUS
8-B	STD. MAIL BOX POST	M-45	
9	GRATE INLET	V-330-1/12	395+56
10	STD. CURB AND GUTTER	B-48	
11	STD. DRIVEWAYS	B-52	
12	REINFORCING AND JOINT DETAILS	B-94	
13-14	STD. HIGHWAY SIGNS	B-95-1&2	
1-22	X-SECTIONS		

INDEX TO SHEETS DA-WR PROJ. No 17(1)

SHEET No.	DESCRIPTION	DRAWING No.	STATION
1	TITLE SHEET		
2	TYPICAL SECTION		
3	PLAN AND PROFILE		
4	GRADE SHEET		
5	GUTTER INLET AND CLEAN OUT BOX	V-331	5+72±
6	STD. CATCH BASIN	V-330-1/14	6+85±
7-9	STD. DRIVEWAYS	M-46	
8-9	STD. HIGHWAY SIGNS	B-95-1-2	
10	" " DRIVEWAYS	B-52	
11	" " STD. CURB & GUTTER	B-48-1	
1-2	X-SECTIONS		

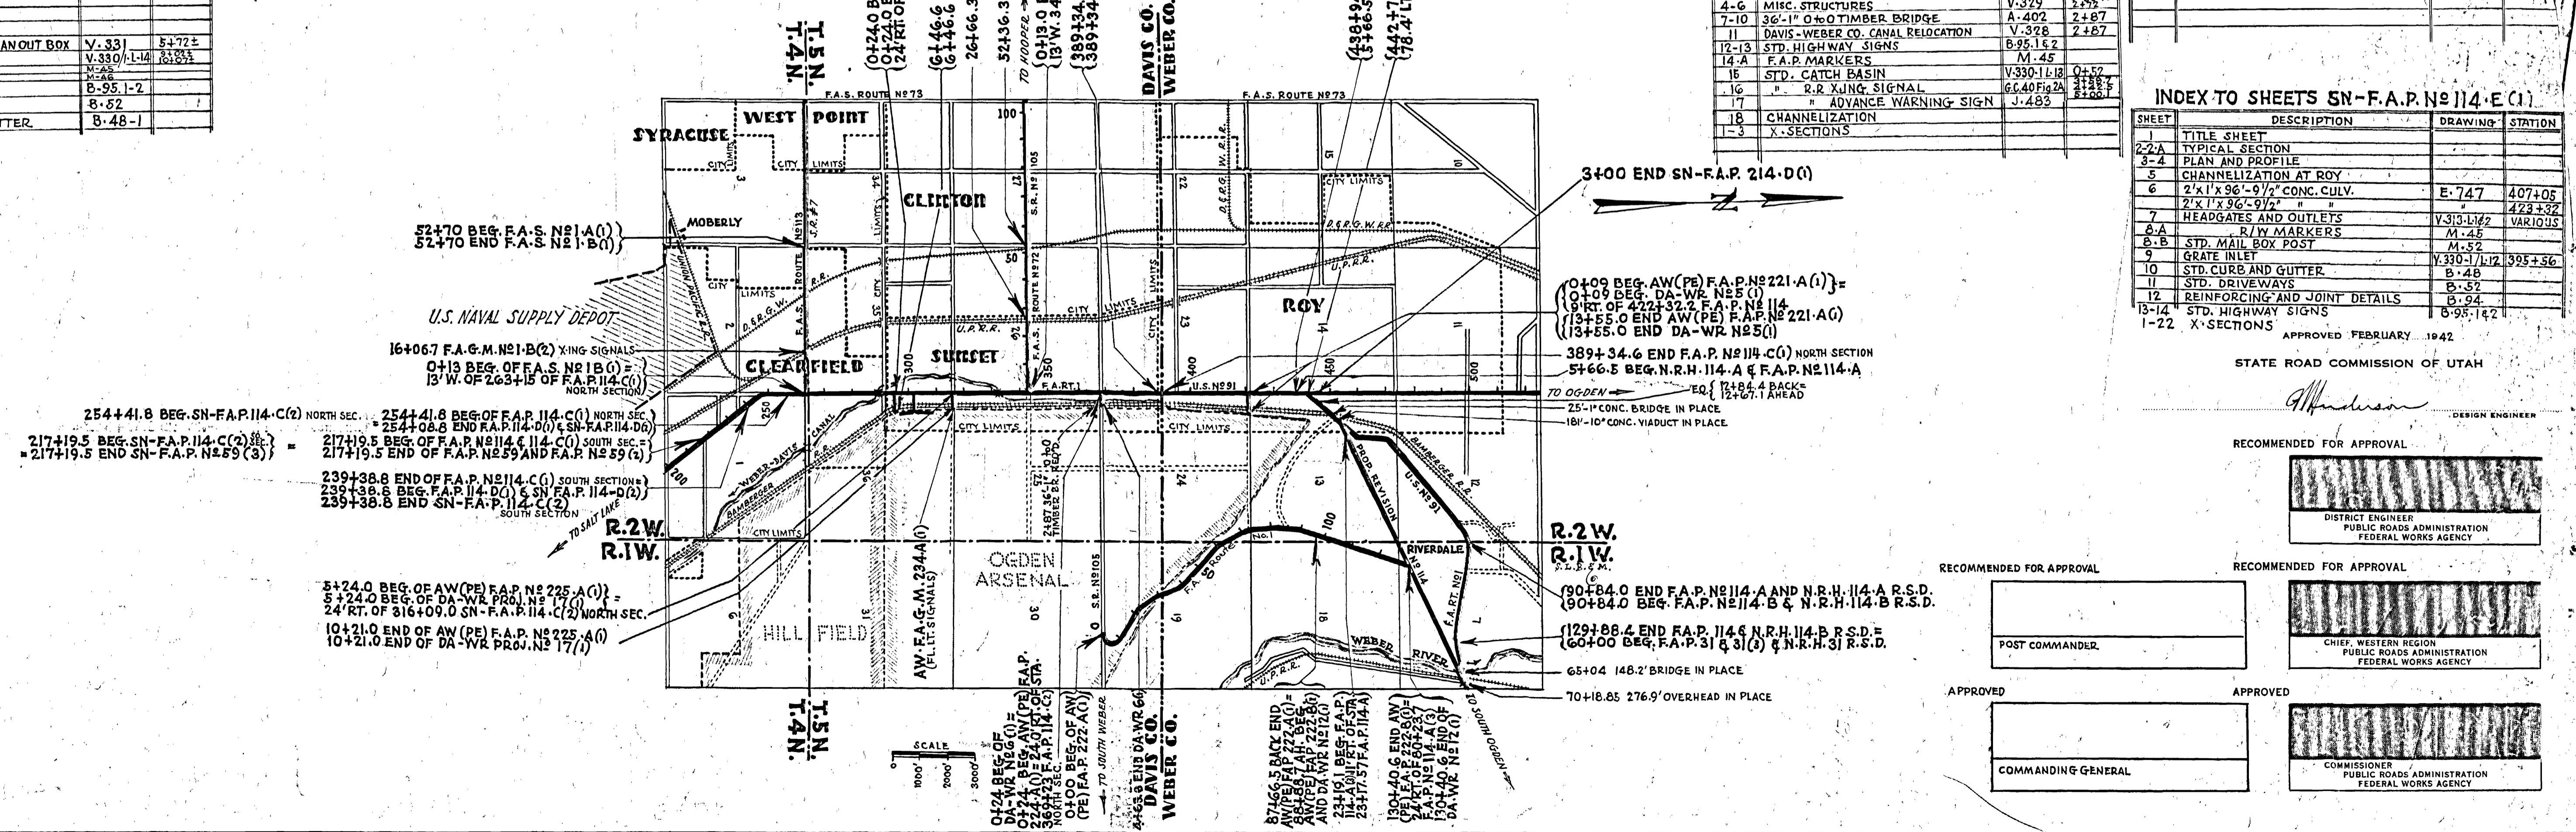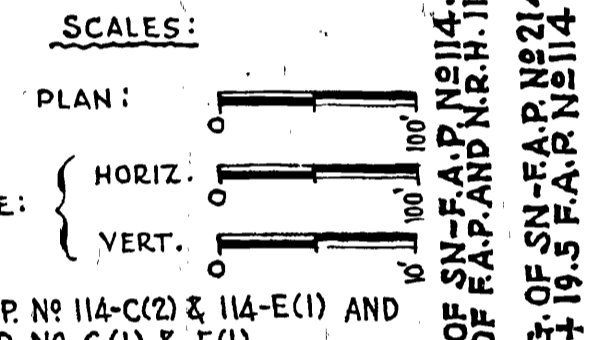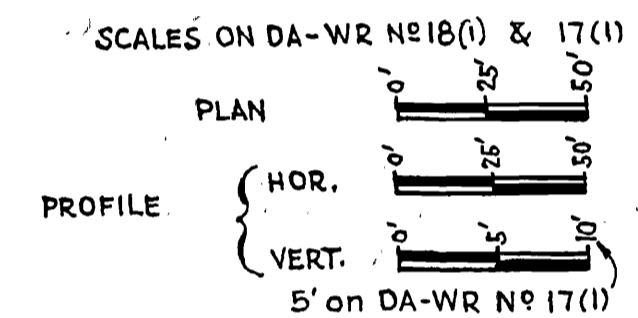

APPROVED FEBRUARY 1942
STATE ROAD COMMISSION OF UTAH

DESIGN ENGINEER
W. Anderson

RECOMMENDED FOR APPROVAL

DISTRICT ENGINEER
PUBLIC ROADS ADMINISTRATION
FEDERAL WORKS AGENCY

RECOMMENDED FOR APPROVAL

CHIEF, WESTERN REGION
PUBLIC ROADS ADMINISTRATION
FEDERAL WORKS AGENCY

POST COMMANDER

COMMANDING GENERAL

APPROVED

COMMISSIONER
PUBLIC ROADS ADMINISTRATION
FEDERAL WORKS AGENCY


FED. ROAD DIST. NO.	STATE	FISCAL YEAR	SHEET NO.	TOTAL SHEETS
12	UTAH	1922	2	

F.A.P.-221-A(1)
SHEET #2


TYPICAL CROSS SECTION

TYPE "F"


CEMENT CONCRETE SURFACE

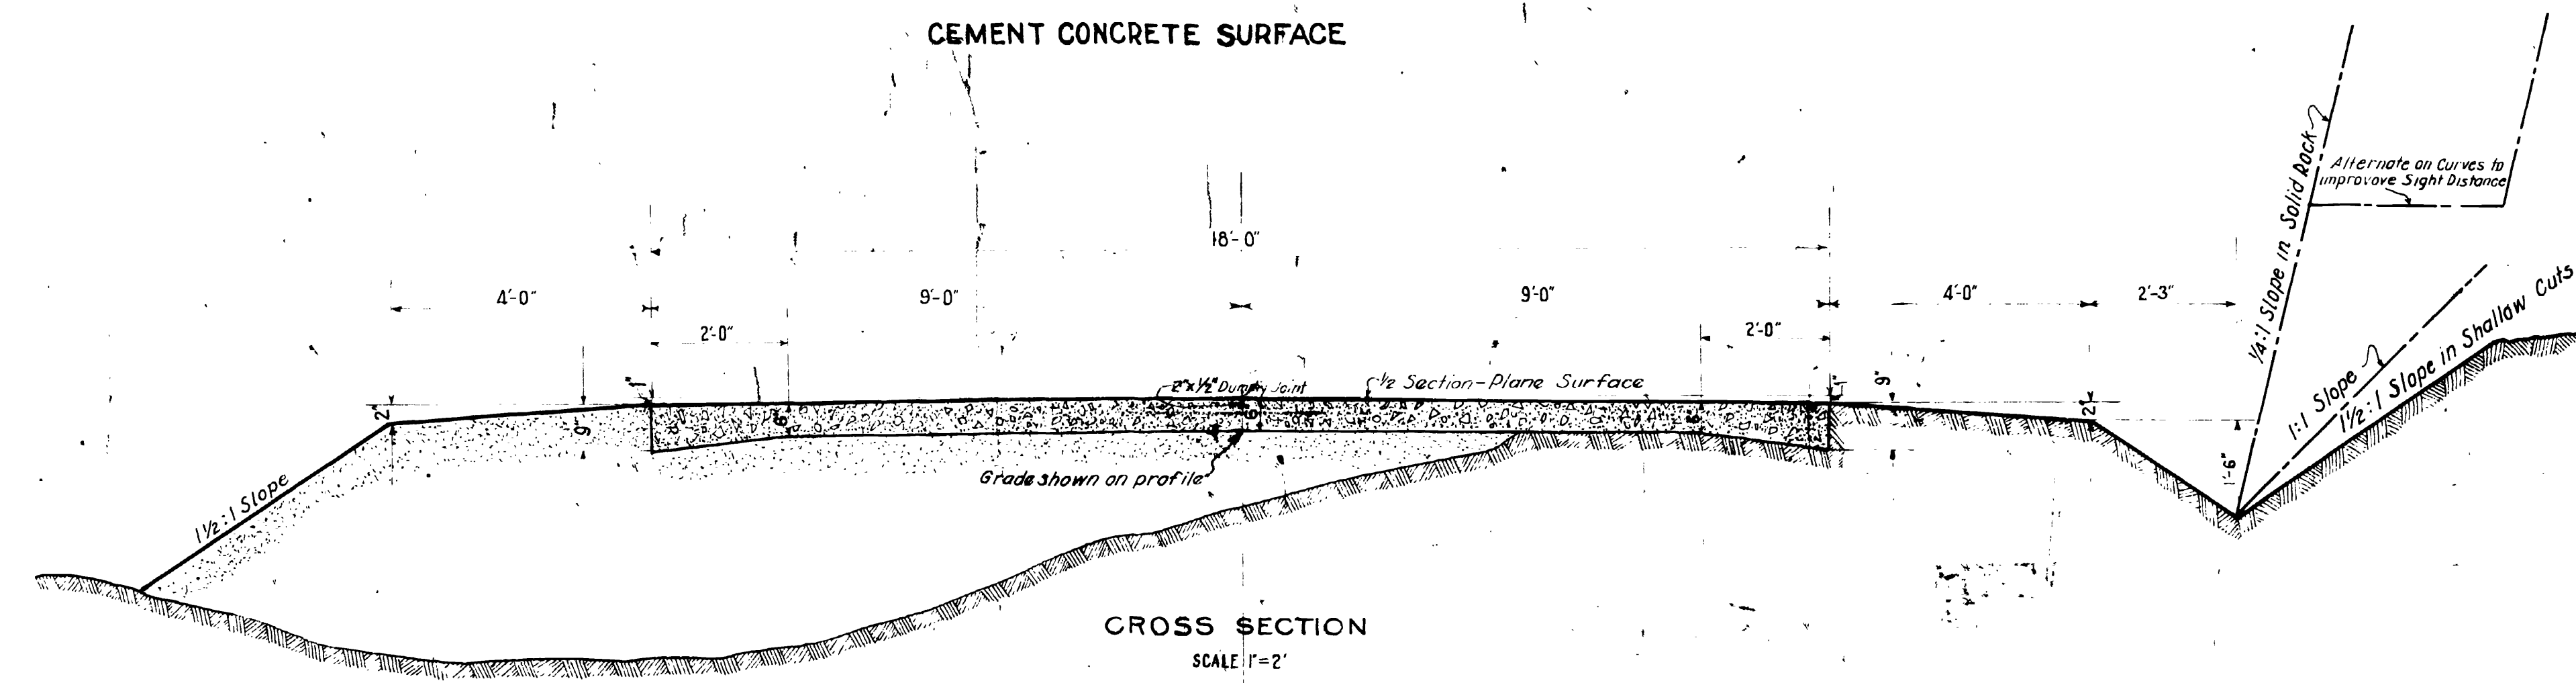


CROSS SECTION
SCALE 1"=2'

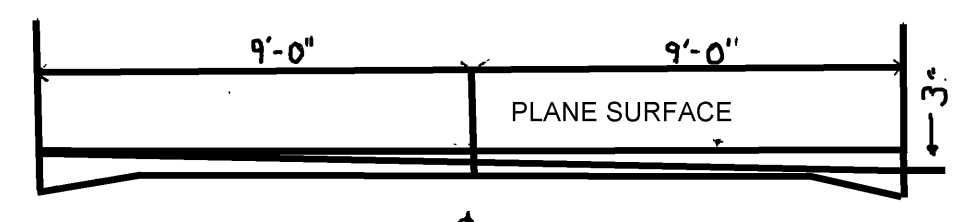


MODIFICATION OF TYPE "F"
TO BE USED ON F.A.P. 65-D
BET. STA. 0+41.25 & STA. 6+80

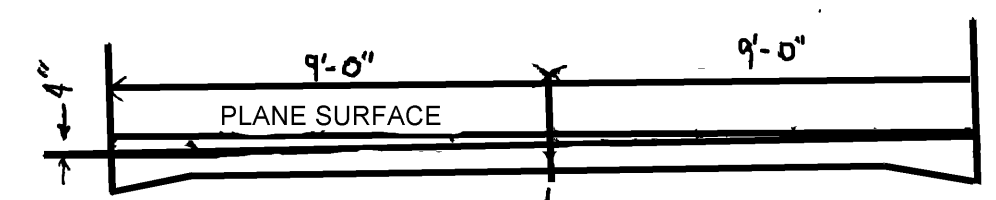

MODIFICATION OF TYPE "F"
TO BE USED ON F.A.P. 65-D
BET. STA. 0+41.25 & STA. 9+80

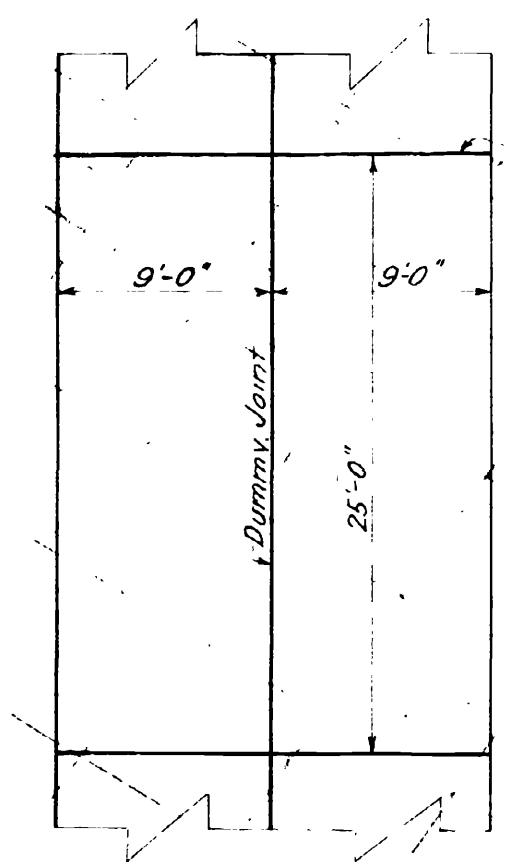


TO BE USED BETWEEN
STA. [] & STA. []
ON THIS PROJECT

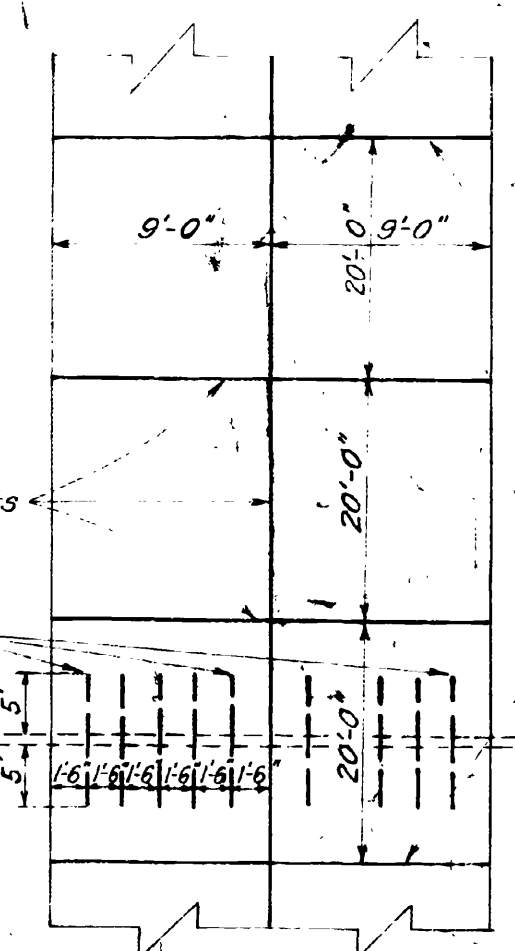

TO BE USED BETWEEN
STA. [] & STA. []
ON ENTIRE PROJECT

USED STA. 8+83.6 TO 2+26+97.8
STA. 8+83.6 TO 26+92 ON F.A.P. 2

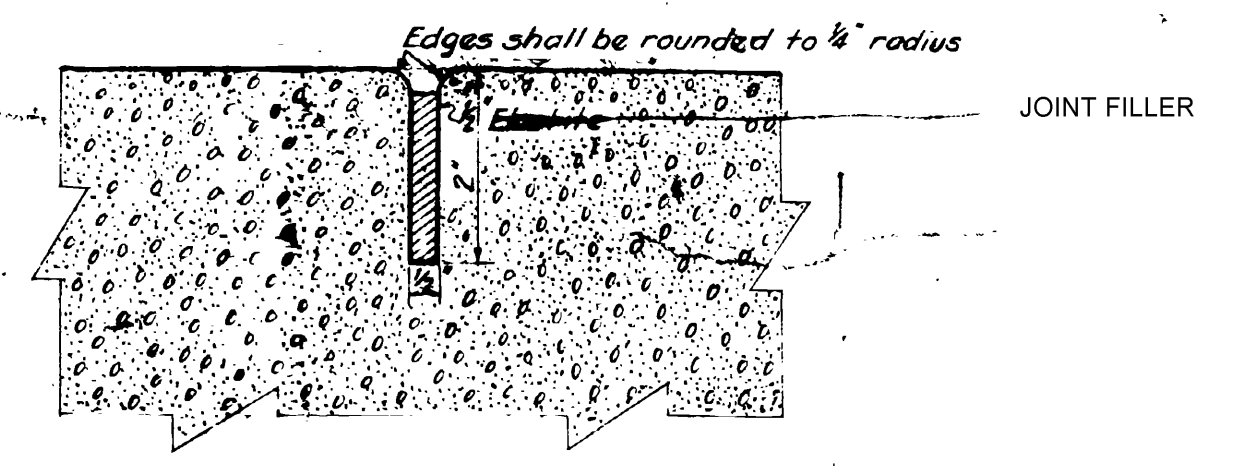

DETAILS OF DUMMY JOINT

USED ON
F.A.P. No.
40-B
40-A RESURFACED SECTION
84
72-B
107-D
107-C
(S.R.) 703-D
(S.R.) 430-C
86-A
42-A RE-OP'D
65-D
S.P. 249
S.P. 260


FED. ROAD DIST. NO.	STATE	FISCAL YEAR	SHEET NO.	TOTAL SHEETS
12	UTAH			

F.A.P.-221-A(1)
SHEET #2-A

STANDARD TYPICAL CROSS SECTION

USED ON S.P. 234

TYPE 'N' OILING
SCALE 1"=2'-0"

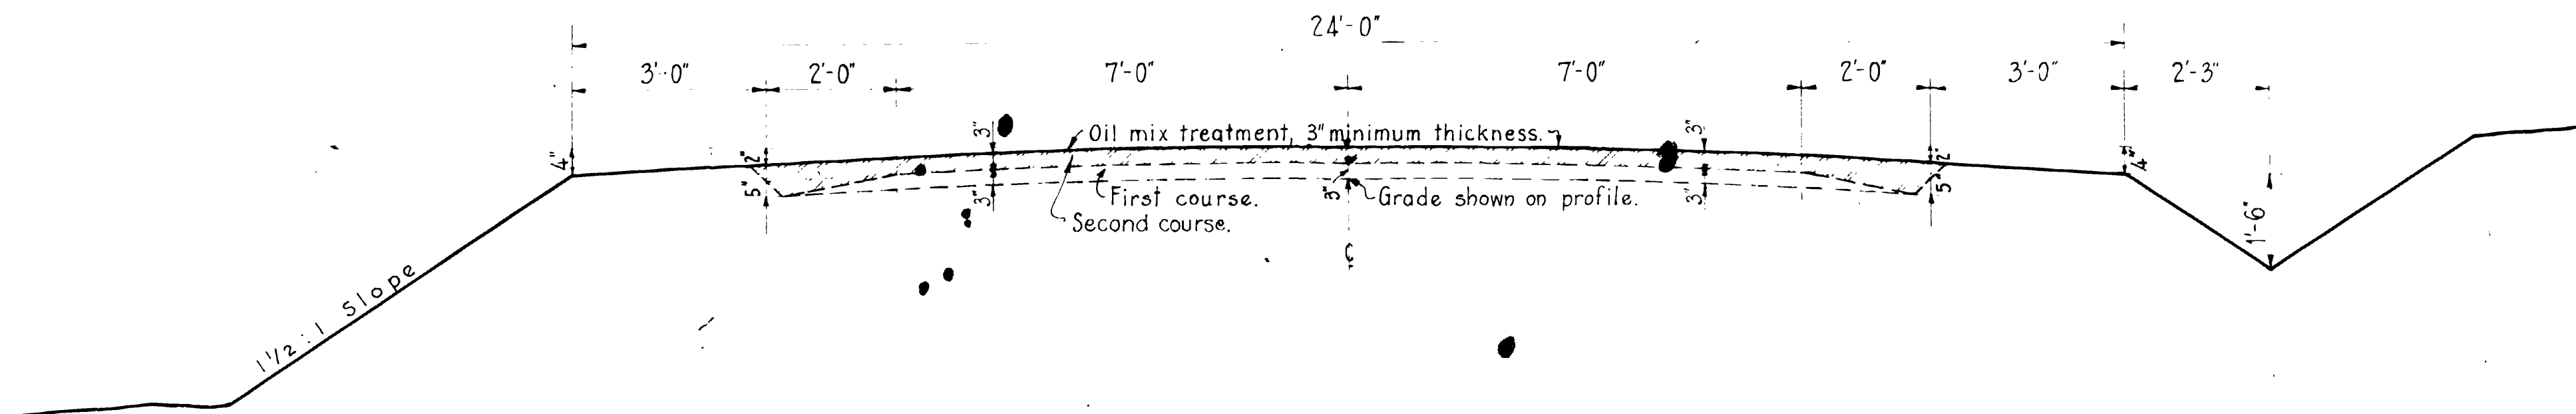

TO BE USED BETWEEN STA. 26+92 & STA. 492+00


Used On N.R.P. No.	USED ON F.A.P. No.	USED ON F.A.P. No.	USED ON F.A.P. No.	USED ON F.A.P. No.	UTAH STATE ROAD COMMISSION SALT LAKE CITY, UTAH H. S. KERR, CHIEF ENGINEER
N.R.S. 139	67				DESIGNED BY E.C.K. SCALE 1"=2'-0" DRAWN BY H.S.T. ISSUED _____ CHECKED BY W.L.A. APPROVED _____ EXAMINED BY _____ DRAWN APR 13, 1928.
N.R.S. 146	62-A				
	63-A				
	47-B-Rep.				
	70-A				
	57-Rep.				
	88C				

28'-0" C. to C. Bents

36'-0" C. to C. Bents

FED. ROAD DIST. NO.	STATE	FED. AID PROJ. NO.	FISCAL YEAR	SHEET NO.	TOTAL SHEETS
12	UTAH	222-A0			

Symmetrical by Rotation about both ϕ s of Bridge

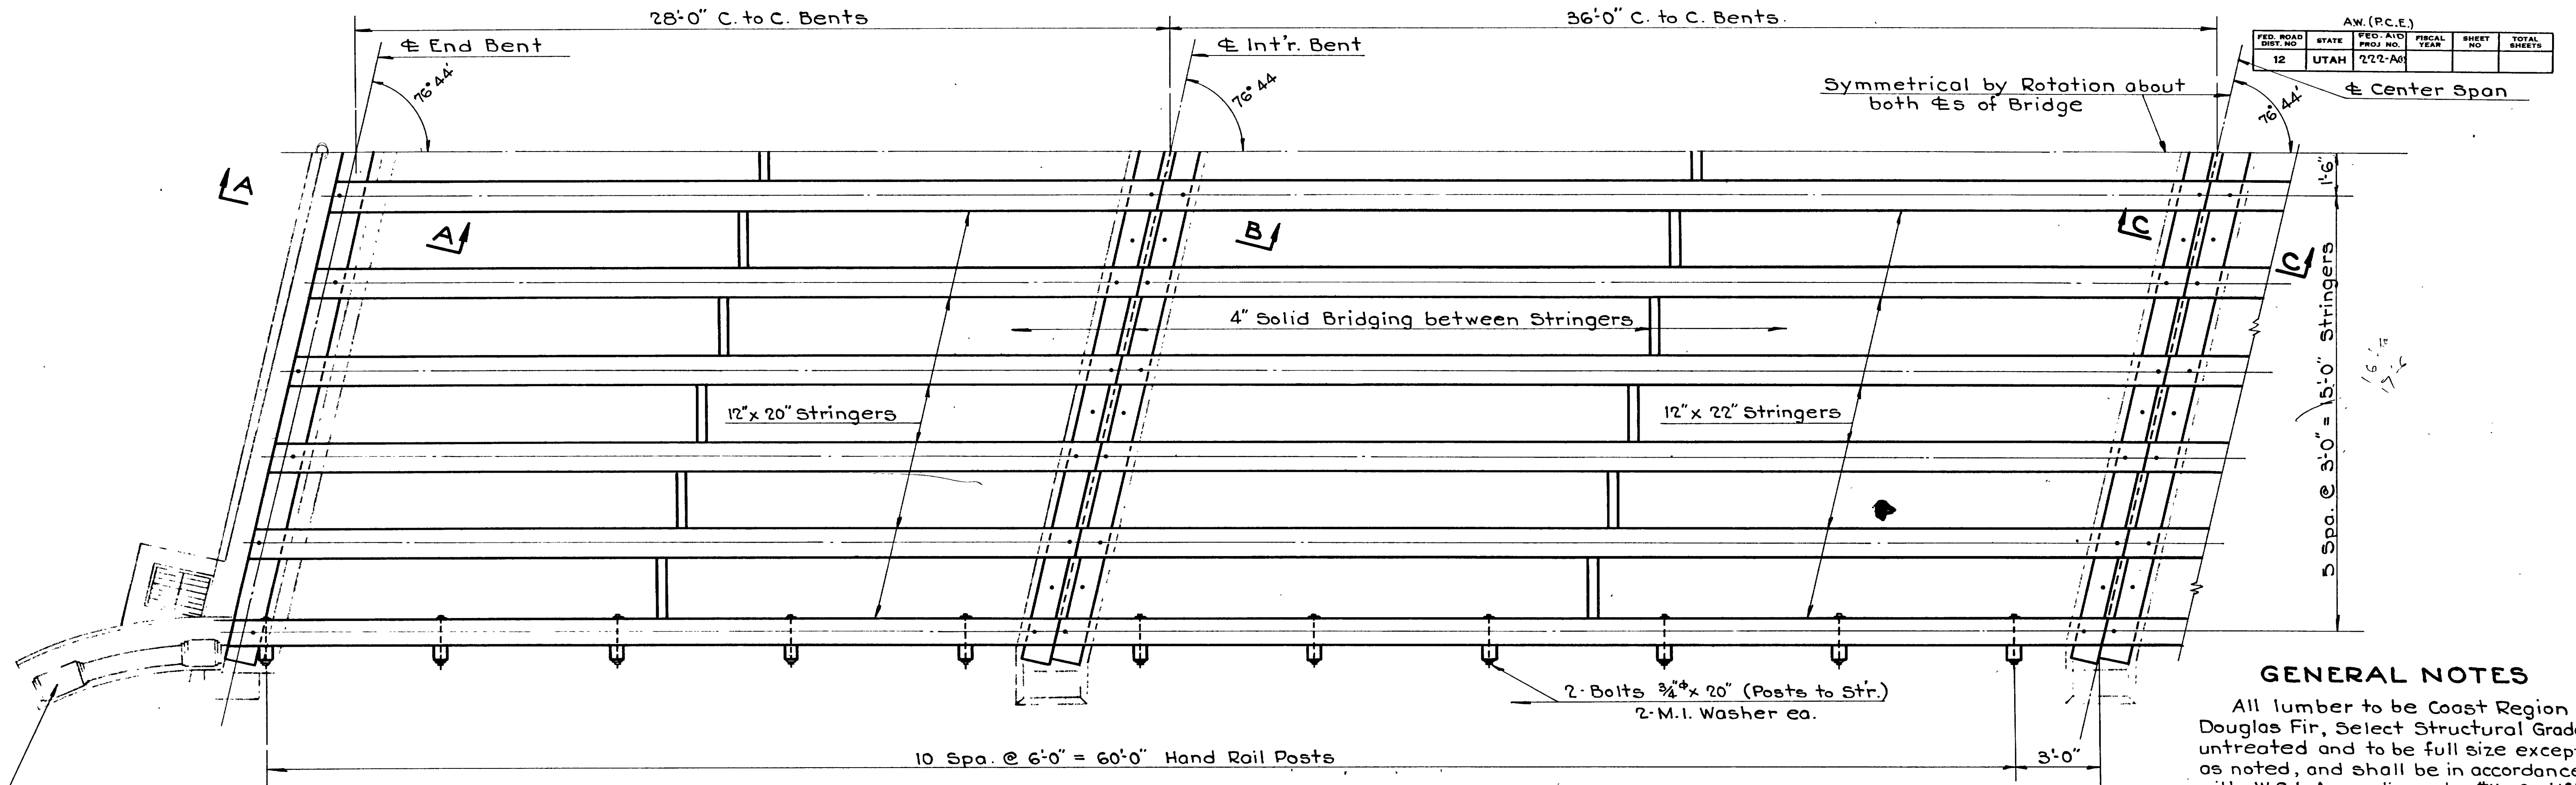

QUARTER PLAN (Showing Stringers, Sills and Posts Only. Floor not shown.)

GENERAL NOTES

All lumber to be Coast Region Douglas Fir, Select Structural Grade, untreated and to be full size except as noted, and shall be in accordance with W.C.L.A. grading rules #11. Certificates of grade to be furnished as required in the Std. Specs.

Materials, construction and workmanship shall be in accordance with State Std. Specs for Road and Bridge Const'n and Supplements thereto.

Bituminous Surface - course to be measured and paid for in accordance with State Std. Specs.


Before applying Bituminous Wearing Surface the top surface of laminated floor shall receive a tack coat of R.C.-2 $\frac{1}{2}$ Gal. per Sq. Yd.

DESIGN DATA

A.A.S.H.O. Specs. of 1941
 H-15 Loading
 Allowable Stress fw = 1600 #/sq"

Concrete End Posts to be finished in accordance with Original Plans, payment to be included in Unit Price bid for Lumber in Place.

REVISIONS	DATE	BY	NO.

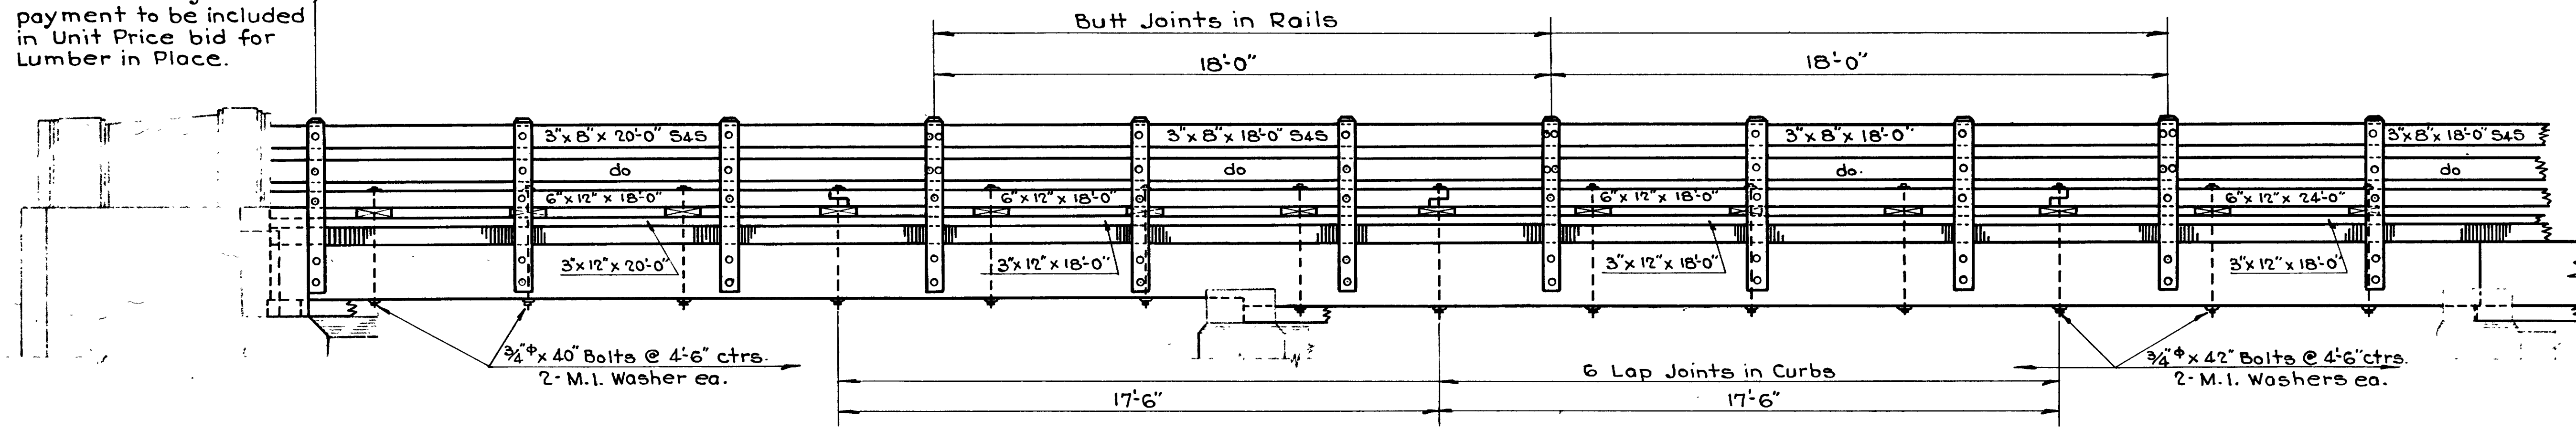


HALF ELEVATION $\frac{3}{8}'' = 1'-0''$

QUANTITIES


Lumber	66,237 F.B.M.
Hardware	2,469 Lbs.
Bituminous Surfacing	462 Sq. Yds.
Paint - State Std. White	5 Gal.

TEMPORARY WOODEN SUPER STRUCTURE

See D-466 Sheet 1 of 2 sheets

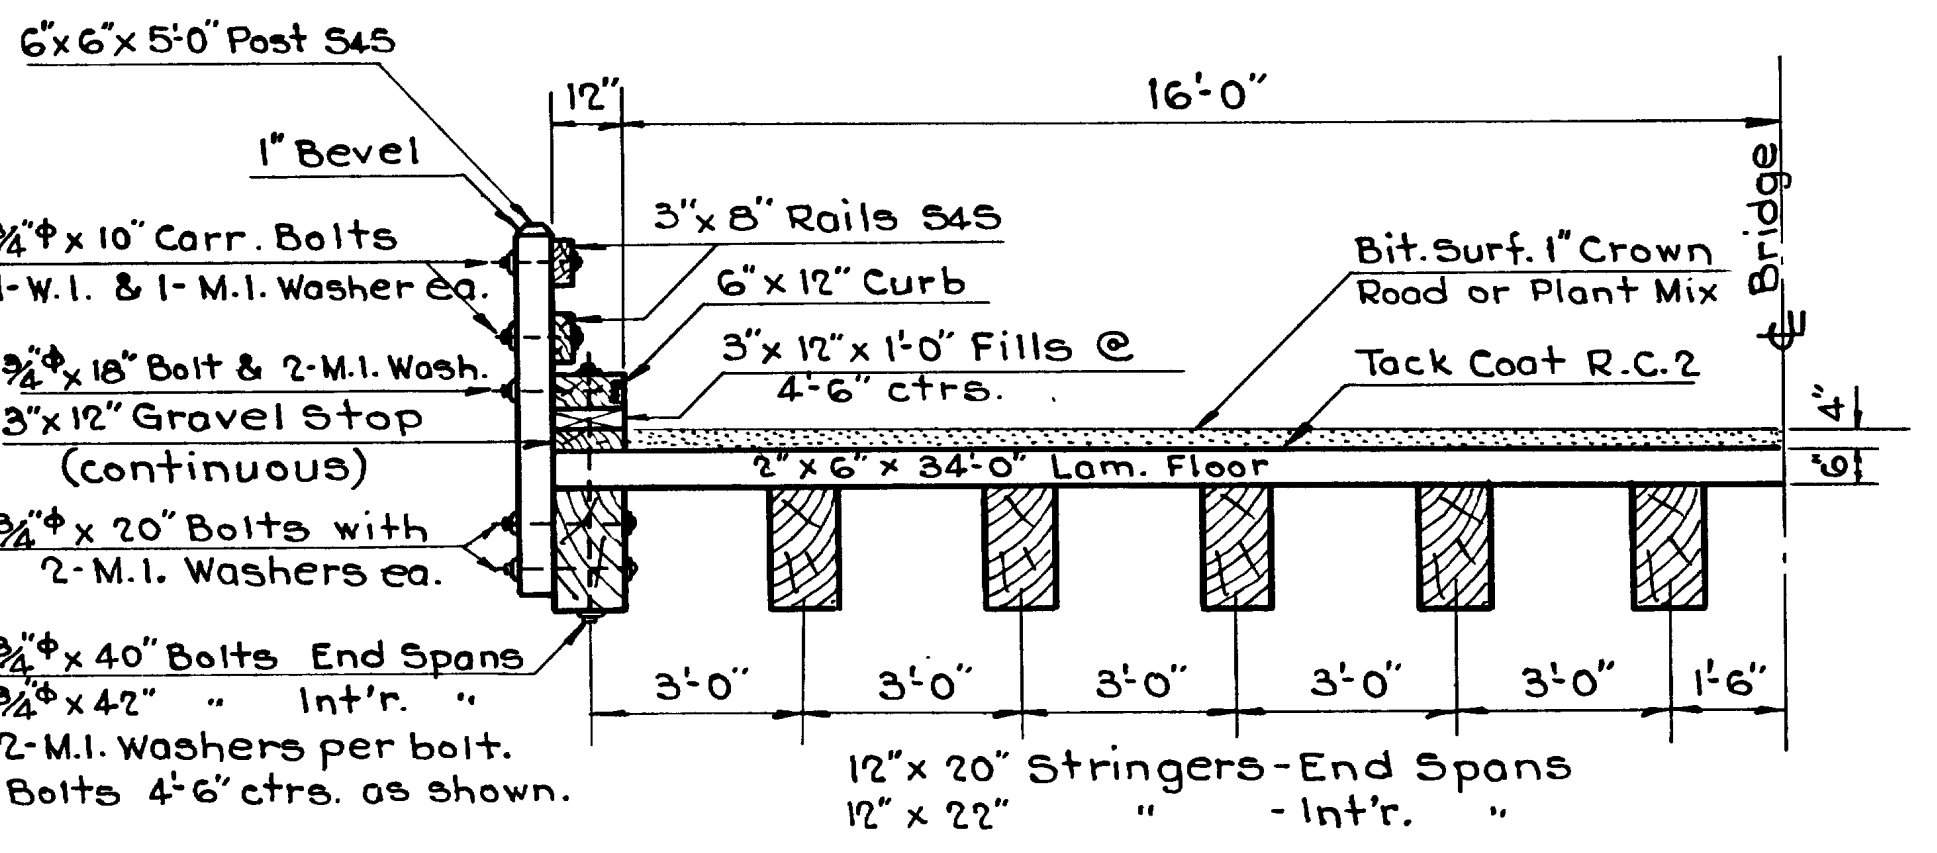

HALF SECTION $\frac{3}{8}'' = 1'-0''$

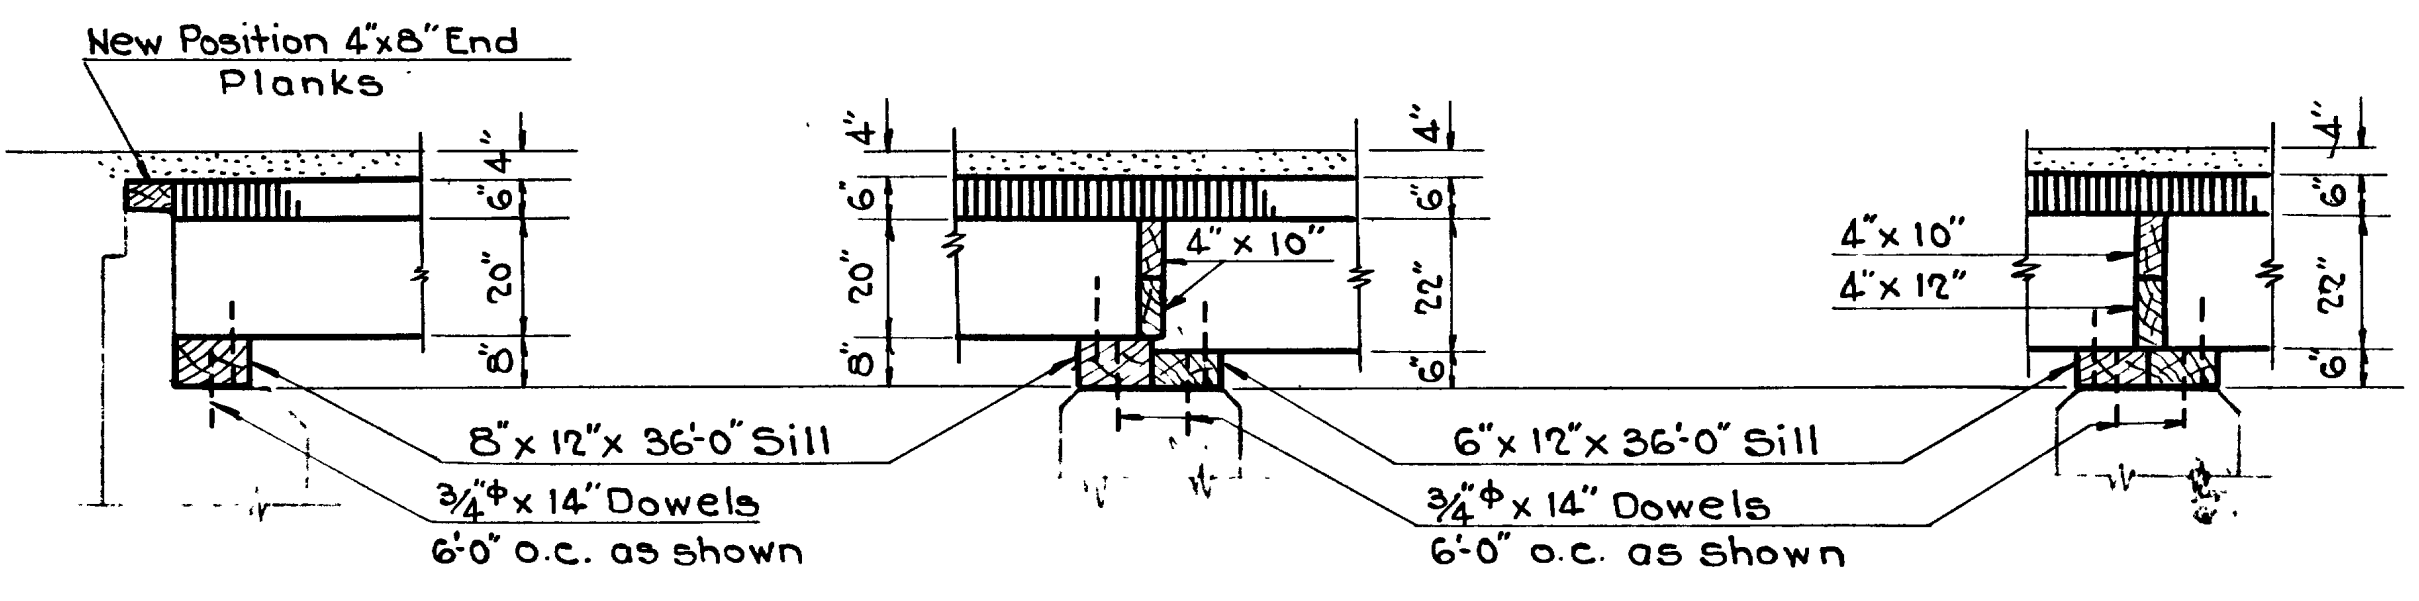

SECTION A-A (End Bents) $\frac{3}{8}'' = 1'-0''$

SECTION B-B (Int'r. Bents) $\frac{3}{8}'' = 1'-0''$

SECTION C-C (Center Bent) $\frac{3}{8}'' = 1'-0''$

UTAH STATE ROAD COMMISSION	
SALT LAKE CITY - UTAH	
BRIDGE DEPARTMENT	
BRIDGE OVER U.P. & L.CO'S.	
PENSTOCKS	
A.W.(P.C.E.) F.A.P. 222-A(4)	Weber Co.
Sta. 52+50	Ogden Arsenal - Riverdale
DESIGNED BY - F.M.E.	SCALE AS NOTED
DRAWN BY - F.M.E.	ISSUED BY - <i>[Signature]</i>
CHECKED BY - <i>[Signature]</i>	APPROVED BY - <i>[Signature]</i>
STAMPED BY - <i>[Signature]</i>	DATE 10/20
BR NO 29-259-12	DRG NO A-406

LUMBER SCHEDULE

SIZE	NO	N.L'TH	N.FBM	NO	G.L'TH	G.FBM	LOCATION	REM'KS
8x12	4	36'-0"	1152	4	36'	1152	Sills End Spans	Full Size
6x12	4	36'-0"	864	4	36'	864	" Int. "	"
4x10	44	2'-0"	293				Bridging End Spans	"
4x10	22	2'-0"	147	11	12'	440	" End & Int. "	"
4x10	44	2'-0 3/8"	301				" End "	"
4x10	11	2'-0 3/8"	75	7	18'	420	" End & Int. "	"
4x12	22	2'-0"	176	2	22'	176	" Int. "	"
4x12	11	2'-0 3/8"	90	1	24'	96	" " "	"
2x6	774	34'-0"	26,316	774	34'	26,316	Laminated Floor	"
3x12	4	19'-4"	232	4	20'	240	Gravel Stops	"
3x12	10	18'-0"	540	10	18'	540	" "	"
3x12	56	1'-0"	168	7	8'	168	Curb Fills	"
6x12	4	16'-9"	402	4	18'	432	" Ends	"
6x12	8	18'-0"	864	8	18'	864	Curb	"
6x12	2	23'-0"	276	2	24'	288	" Center	"
12x20	24	28'-5"	13,640	24	30'	14,400	Stringers	"
12x22	24	36'-0"	19,008	24	36'	19,008	"	"
6x6	44	5'-0"	660	22	10'	660	Rail Posts	54 S
3x8	8	19'-4"	309	8	20'	320	Railings	"
3x8	20	18'-0"	720	20	18'	720	"	"

TOTALS = 66,233 = 67,104 FBM.

All Lumber to be Full Size Rough, Except Railing and Rail Posts as Noted and Shown.

HARDWARE SCHEDULE

ITEM	NO.	SIZE	LENGTH	WT.	LOCATION
Dowels	48	3/4"	14"	85#	Sills
"	96	3/4"	14"	170#	Stringers to Sills
Bolts	24	3/4"	40"	126#	Curbs to Stringers
"	32	3/4"	42"	176#	" " "
"	44	3/4"	18"	114#	Posts to Curb
"	88	3/4"	20"	250#	" " Stringers
Carr. Bolts	112	3/4"	10"	174#	Rails to Posts
Nails	14,000	40d	5"	800#	Laminated Floor
"	10,000	20d	4"	400#	Toe Nail Lam. Floor
M.I. Washers	488	3/4"	—	161#	3/4" Bolts
W.I. Washers	112	3/4"	—	13#	" "

TOTAL = 2469 Lbs.

REVISIONS	DATE	BY	DATE	BY

Sheet No. 2 of 2 Sheets


UTAH STATE ROAD COMMISSION
SALT LAKE CITY - UTAH
BRIDGE DEPARTMENT

**BRIDGE OVER U.P. & L.C.O.S.
PENSTOCKS**
A.W. (P.C.E.) F.A.P. 222-A(1)
Sta. 52 + 50 Weber Co.
Ogden Arsenal-Riverdale

DESIGNED BY: F.M.E. SCALE: None
DRAWN BY: F.M.E. ISSUED: *Jan. 1, 1942*
CHECKED BY: *Paul D. Mott* APPROVED: *Paul D. Mott*
EXAMINED BY: _____




NO. 29-259-1-2 DRG. NO. A-406

TYPICAL CROSS SECTION

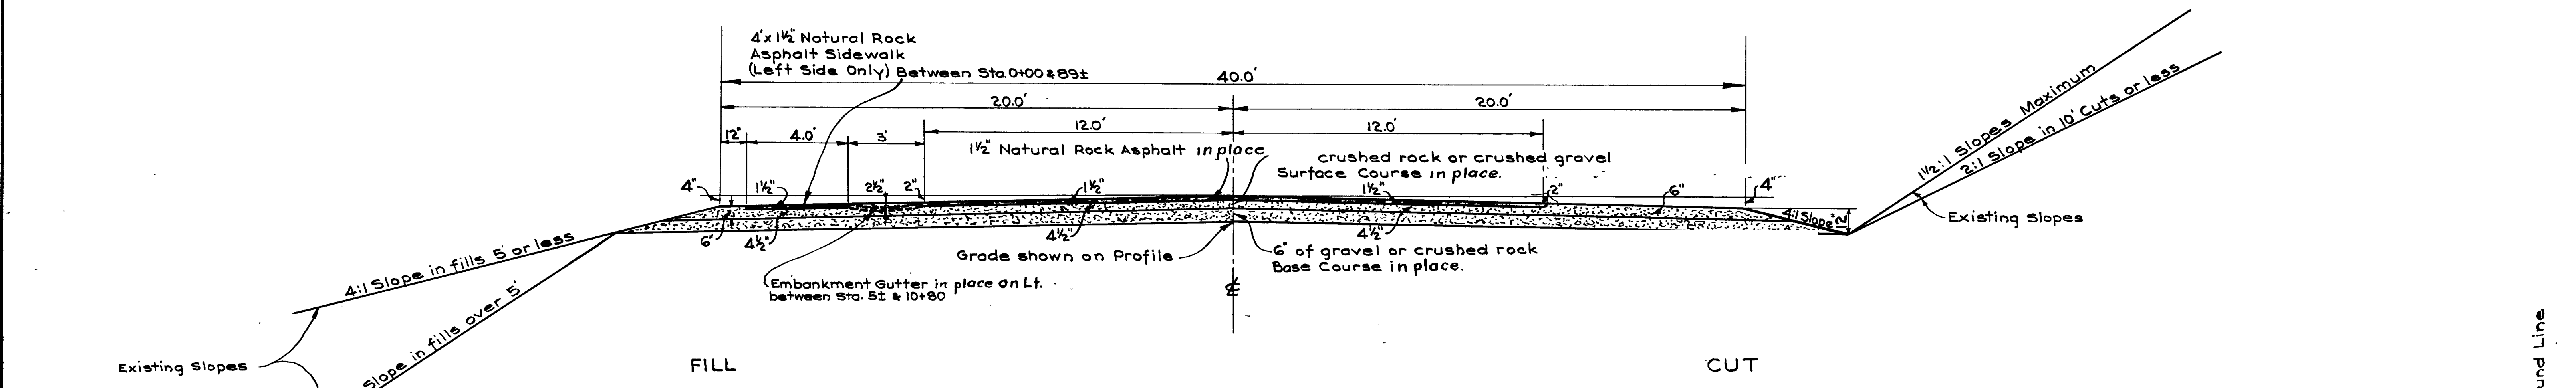

AW(PCE) R.A.P. No. 222-A(1) Consisted of Grading and Placing of Structures only.

REVISIONS	
DATE	BY

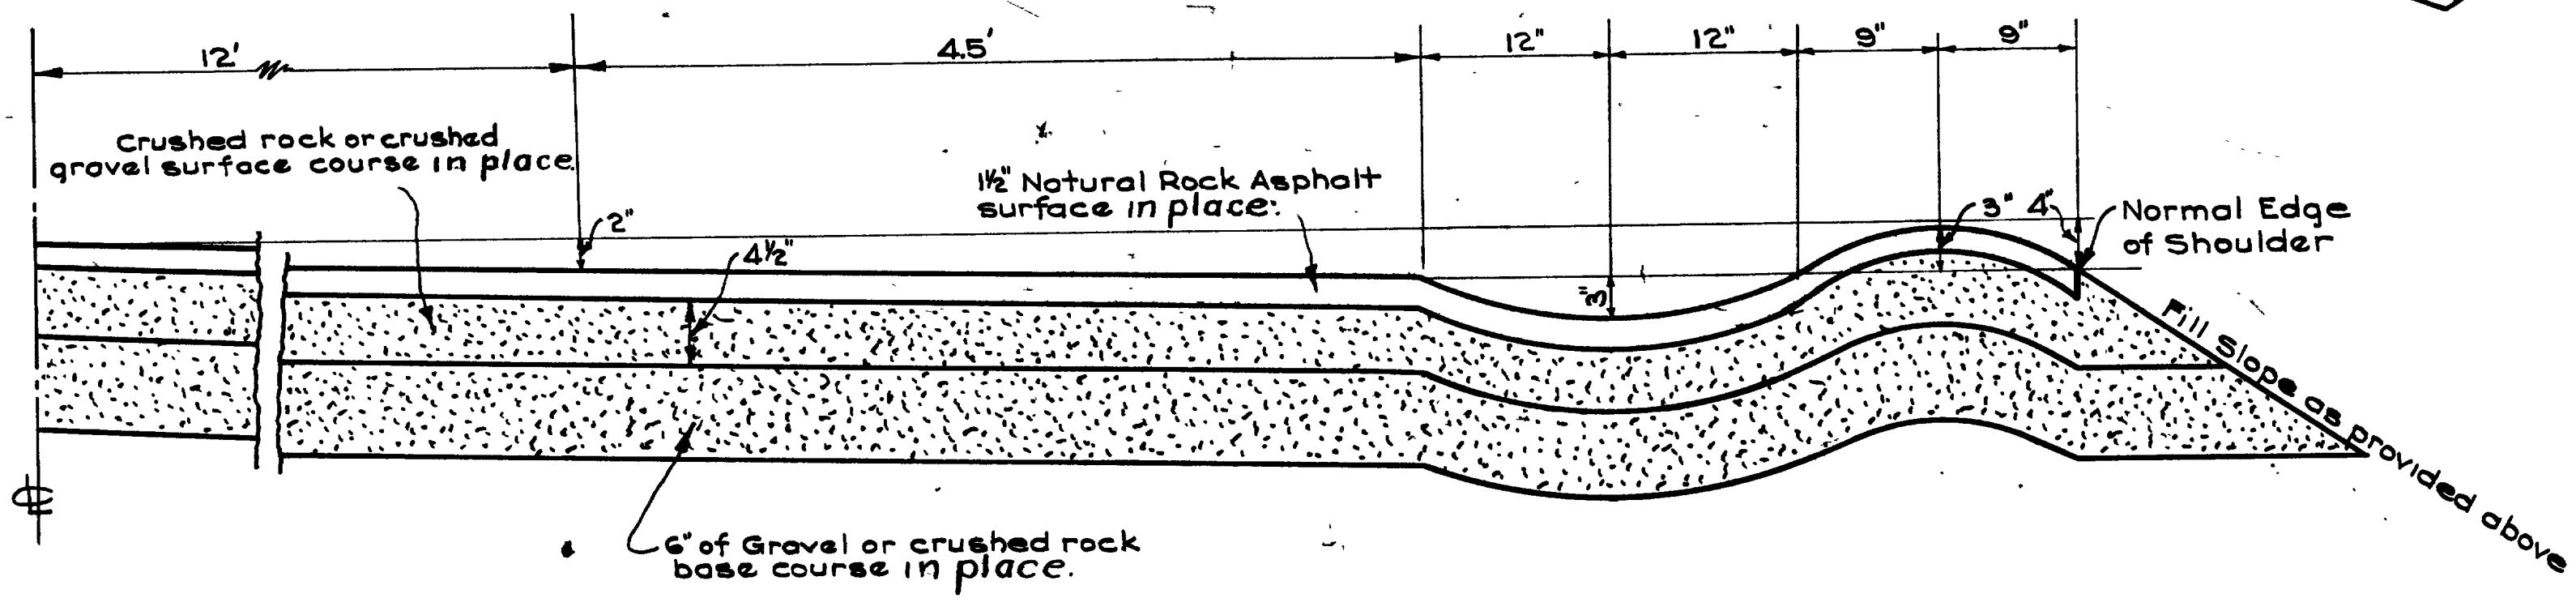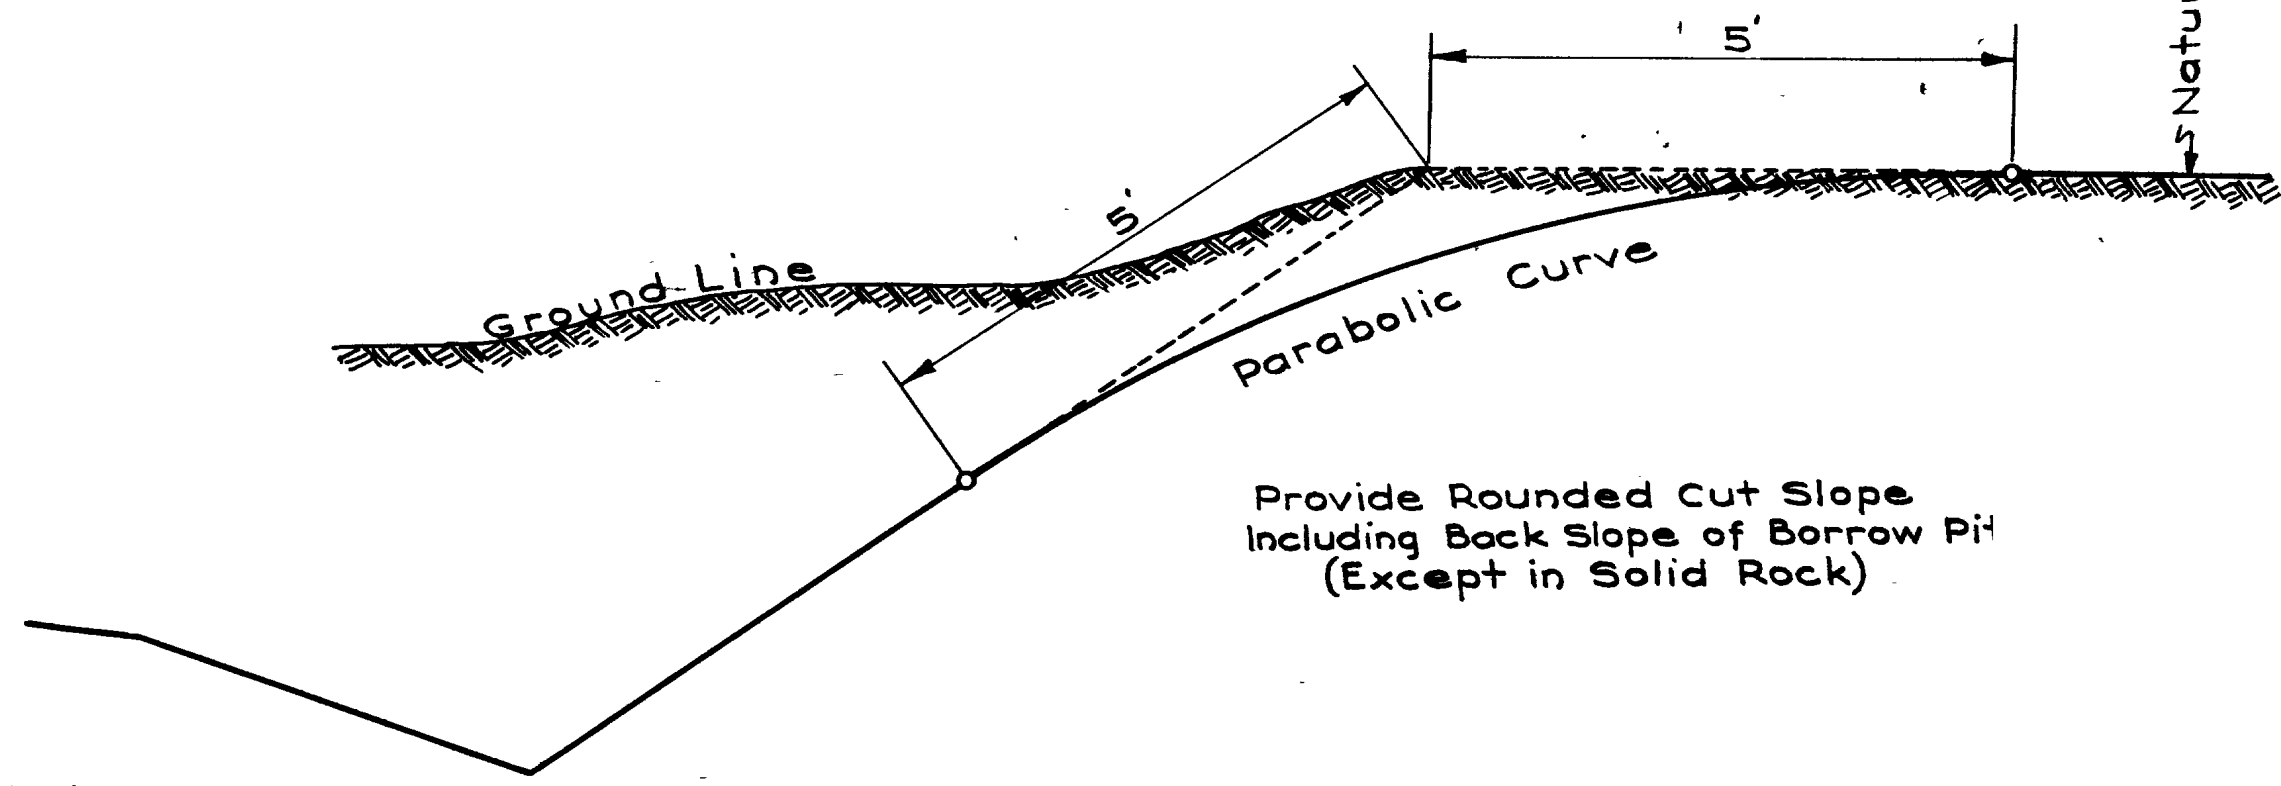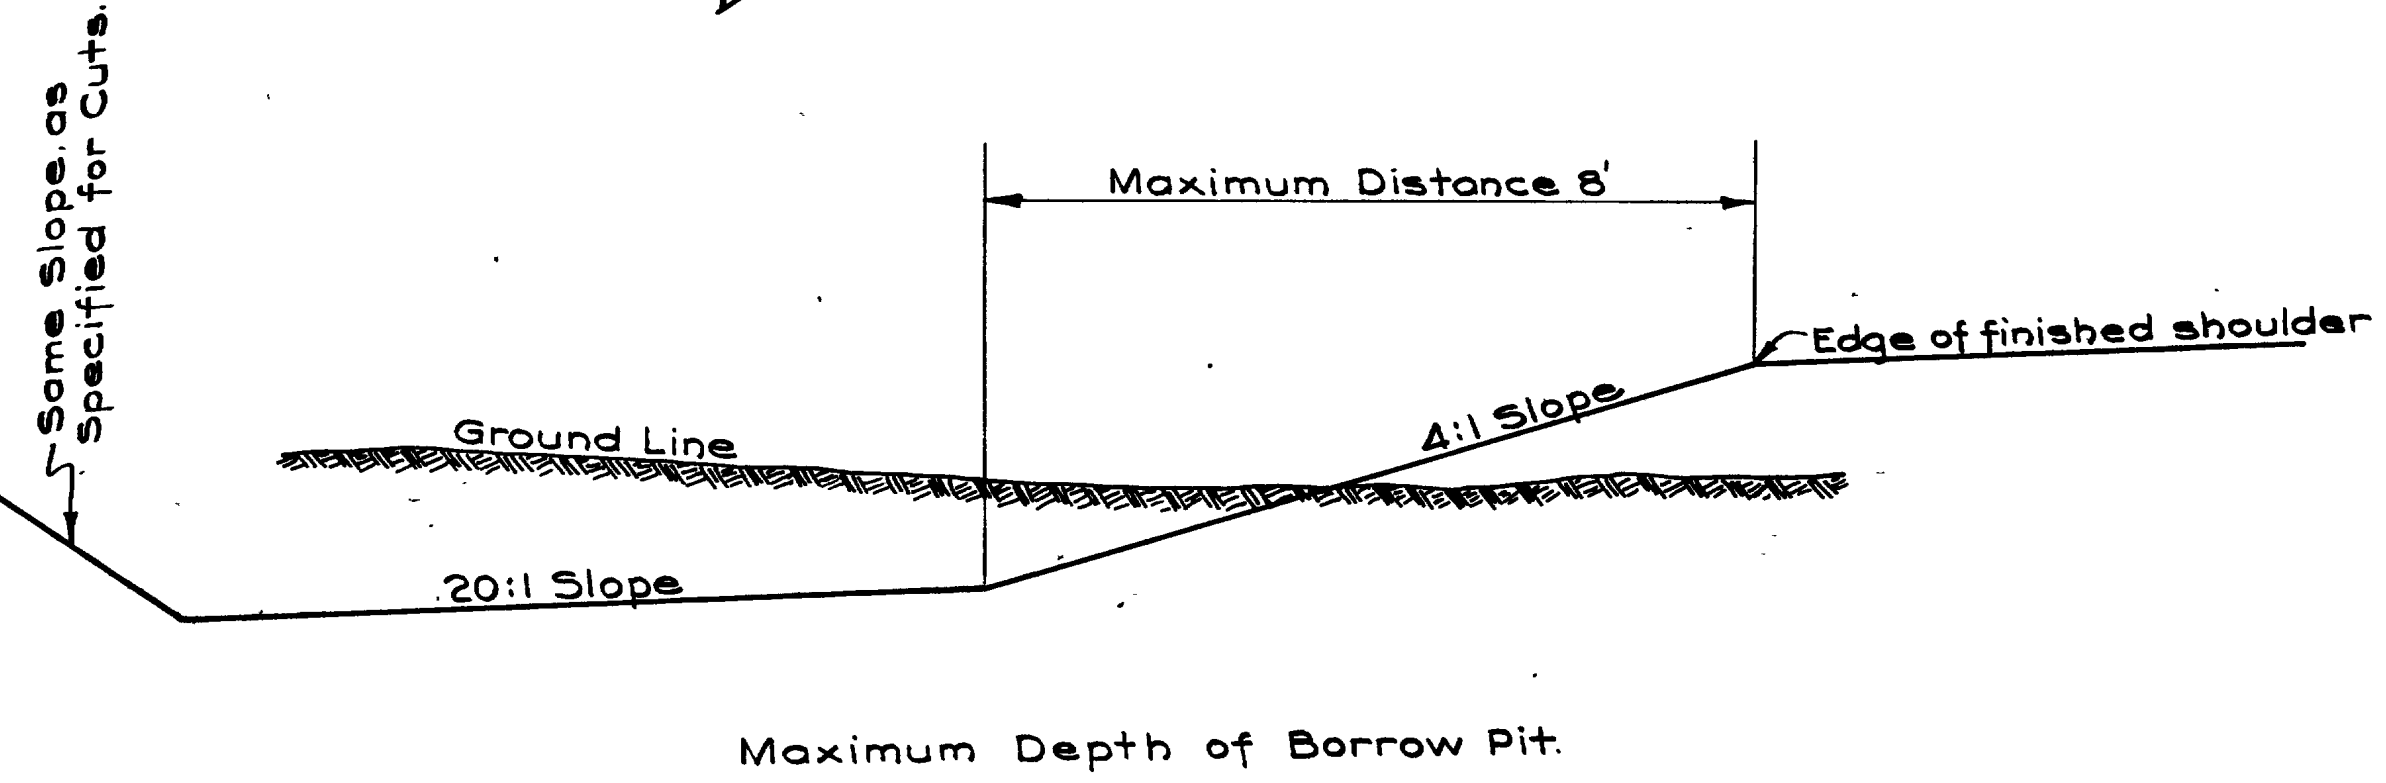



PAVED EMBANKMENT GUTTER & SHOULDER

Use between Sta. 12± to Sta. 20+30
 " " 46+50± " 51+50±
 " " 53+15 " 56+20±

Widen and Superelevate Curves According to Drwg. No. M-37

UTAH STATE ROAD COMMISSION SALT LAKE CITY - UTAH	
- TYPE -	
2" NATURAL ROCK ASPHALT ROADWAY	


TYPICAL CROSS SECTION

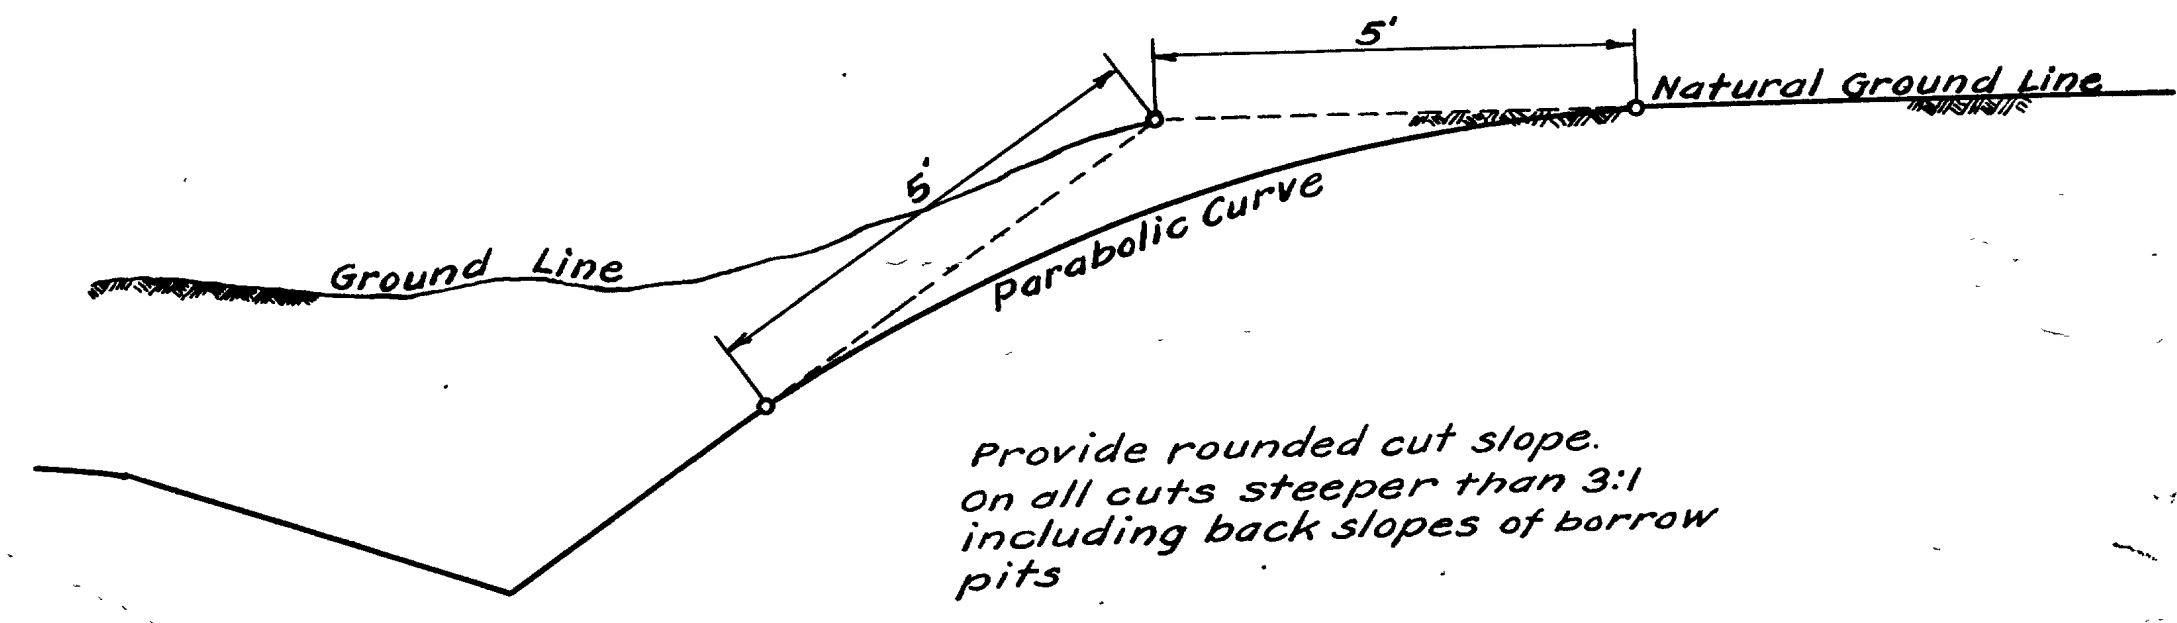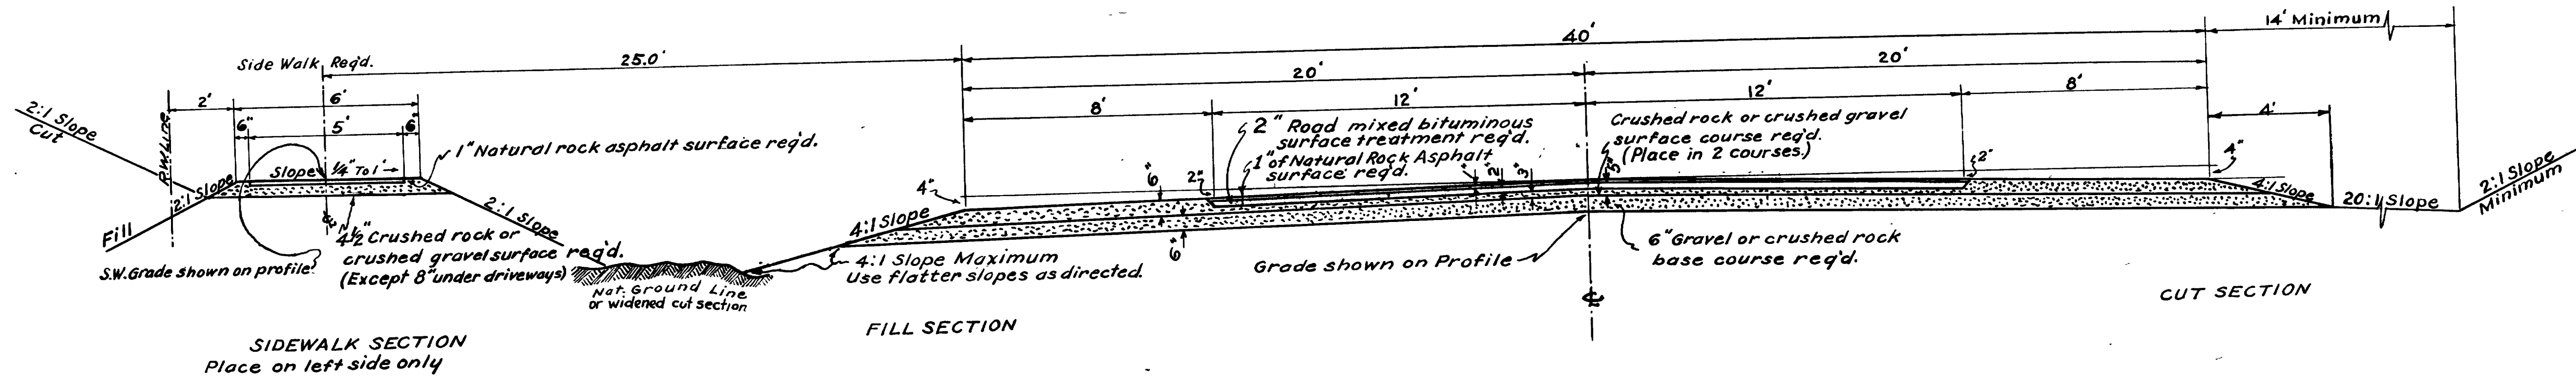

REVISIONS	
NO.	DATE

UTAH STATE ROAD COMMISSION
 SALT LAKE CITY, UTAH
 W. L. ANDERSON DESIGN ENGINEER
 — TYPE —
 Bituminous Surfaced Roadway

DATE	7/24/42
BY	J.E. DAVIS
CHECKED	H.S. WILSON
APPROVED	H.S. WILSON
NOTE BOOK	NO. 4799
ALIGNED CHECKED	
RT. OF WAY CHECKED	

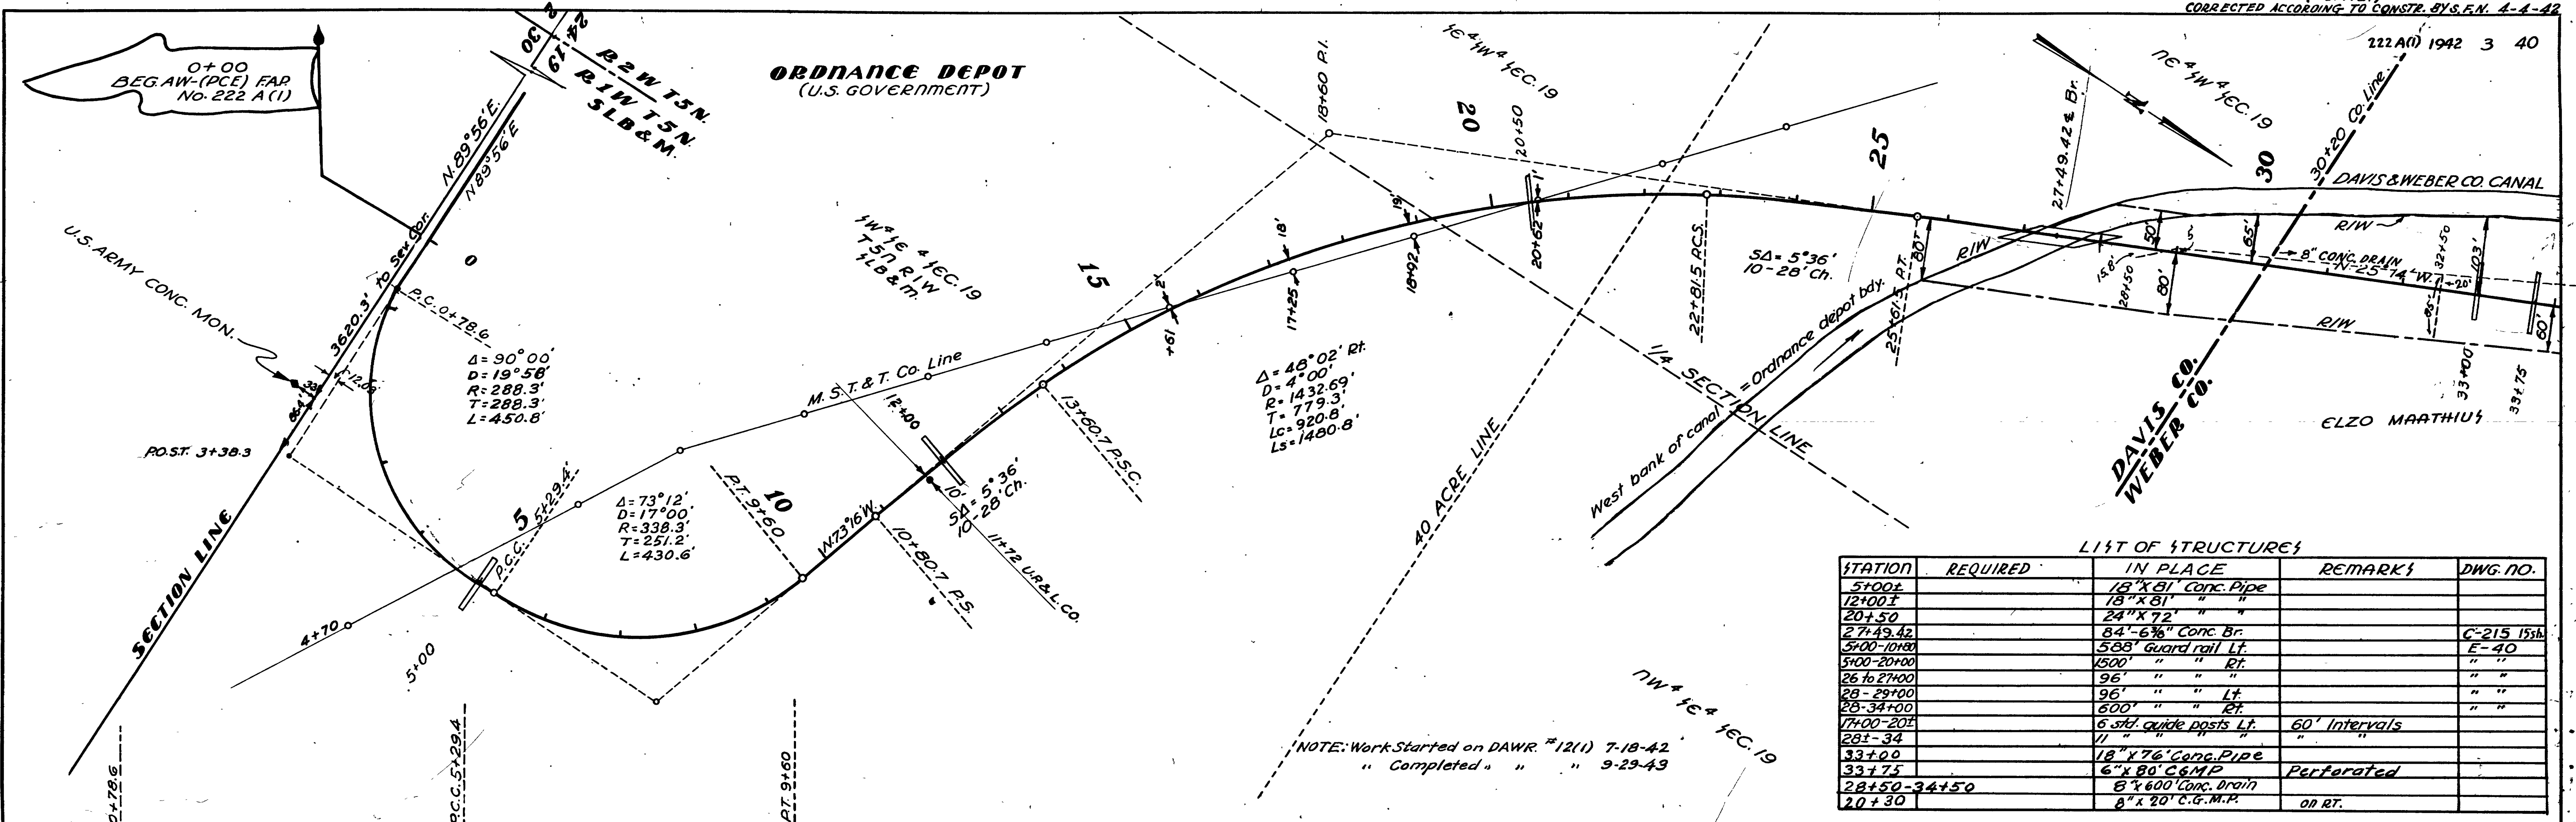


LIST OF STRUCTURES

STATION	REQUIRED	IN PLACE	REMARKS	DWG. NO.
5+00±		18" x 81" Conc. Pipe		
12+00±		18" x 81" "		
20+50		24" x 72" "		
27+49.42		84'-6 3/4" Conc. Br.		C-215 15th
5+00-10+00		588' Guard rail Lt.		E-40
5+00-20+00		1500' " " Rt.		" "
26 to 27+00		96' " " "		" "
28 - 29+00		96' " " Lt.		" "
28-34+00		600' " " Rt.		" "
17+00-20±		6 std. guide posts Lt.	60' Intervals	
28±-34		11' " " "		
33+00		18" x 76" Conc. Pipe		
33+75		6" x 80" C&MP	Perforated	
28+50-34+50		8" x 600" Conc. Drain		
20+30		8" x 20" C.G.M.P.	on RT.	

NOTE: Work Started on DAWR #12(1) 7-18-42
" Completed " " 9-29-43


DATE	7/24/42
BY	J.E. DAVIS
CHECKED	H.S. WILSON
APPROVED	H.S. WILSON
NOTE BOOK	NO. 4799
GRADES CHECKED	
B.M. NOTED	
STRUCTURE CHECKED	

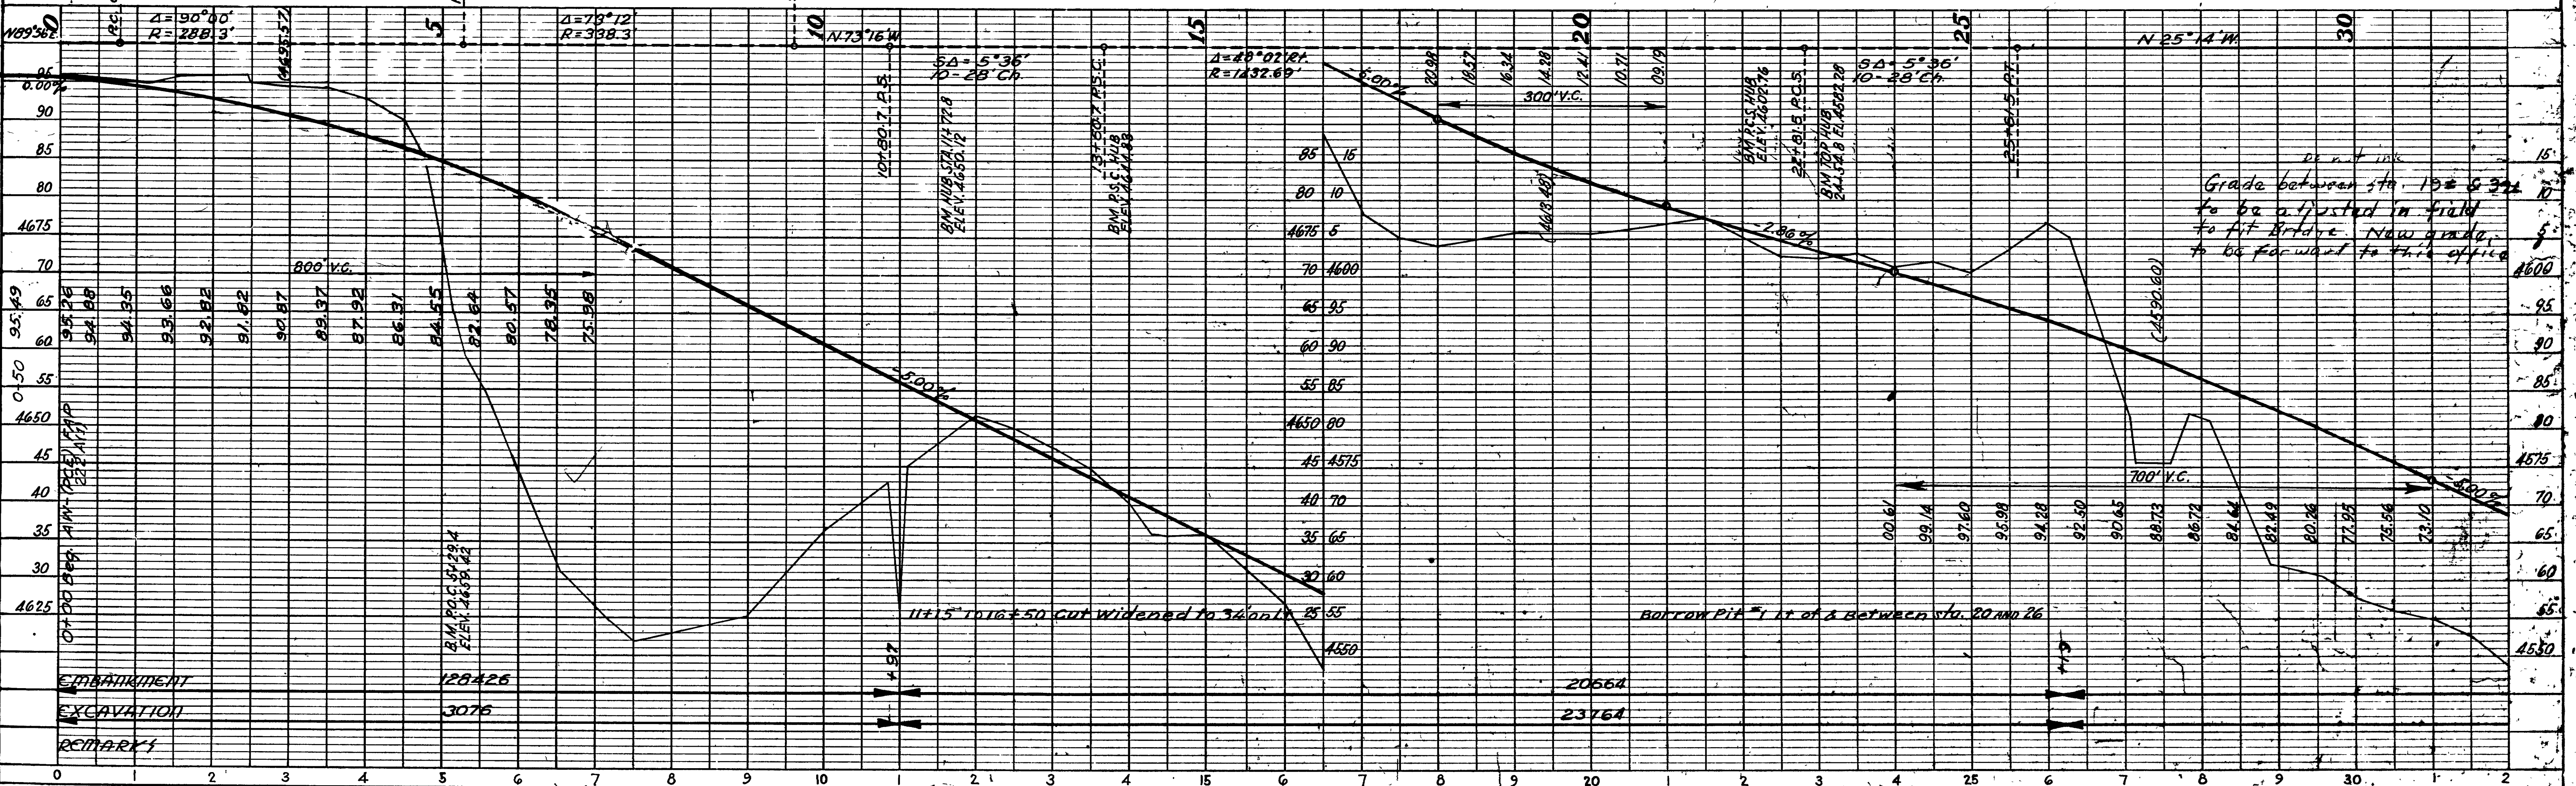

EMBANKMENT
EXCAVATION
REMARKS


DATE 7/27/77
 BY J.B. BURNS
 CHECKED J.B. BURNS
 NO. 2793

DATE 7/27/77
 BY J.B. BURNS
 CHECKED J.B. BURNS
 NO. 2793

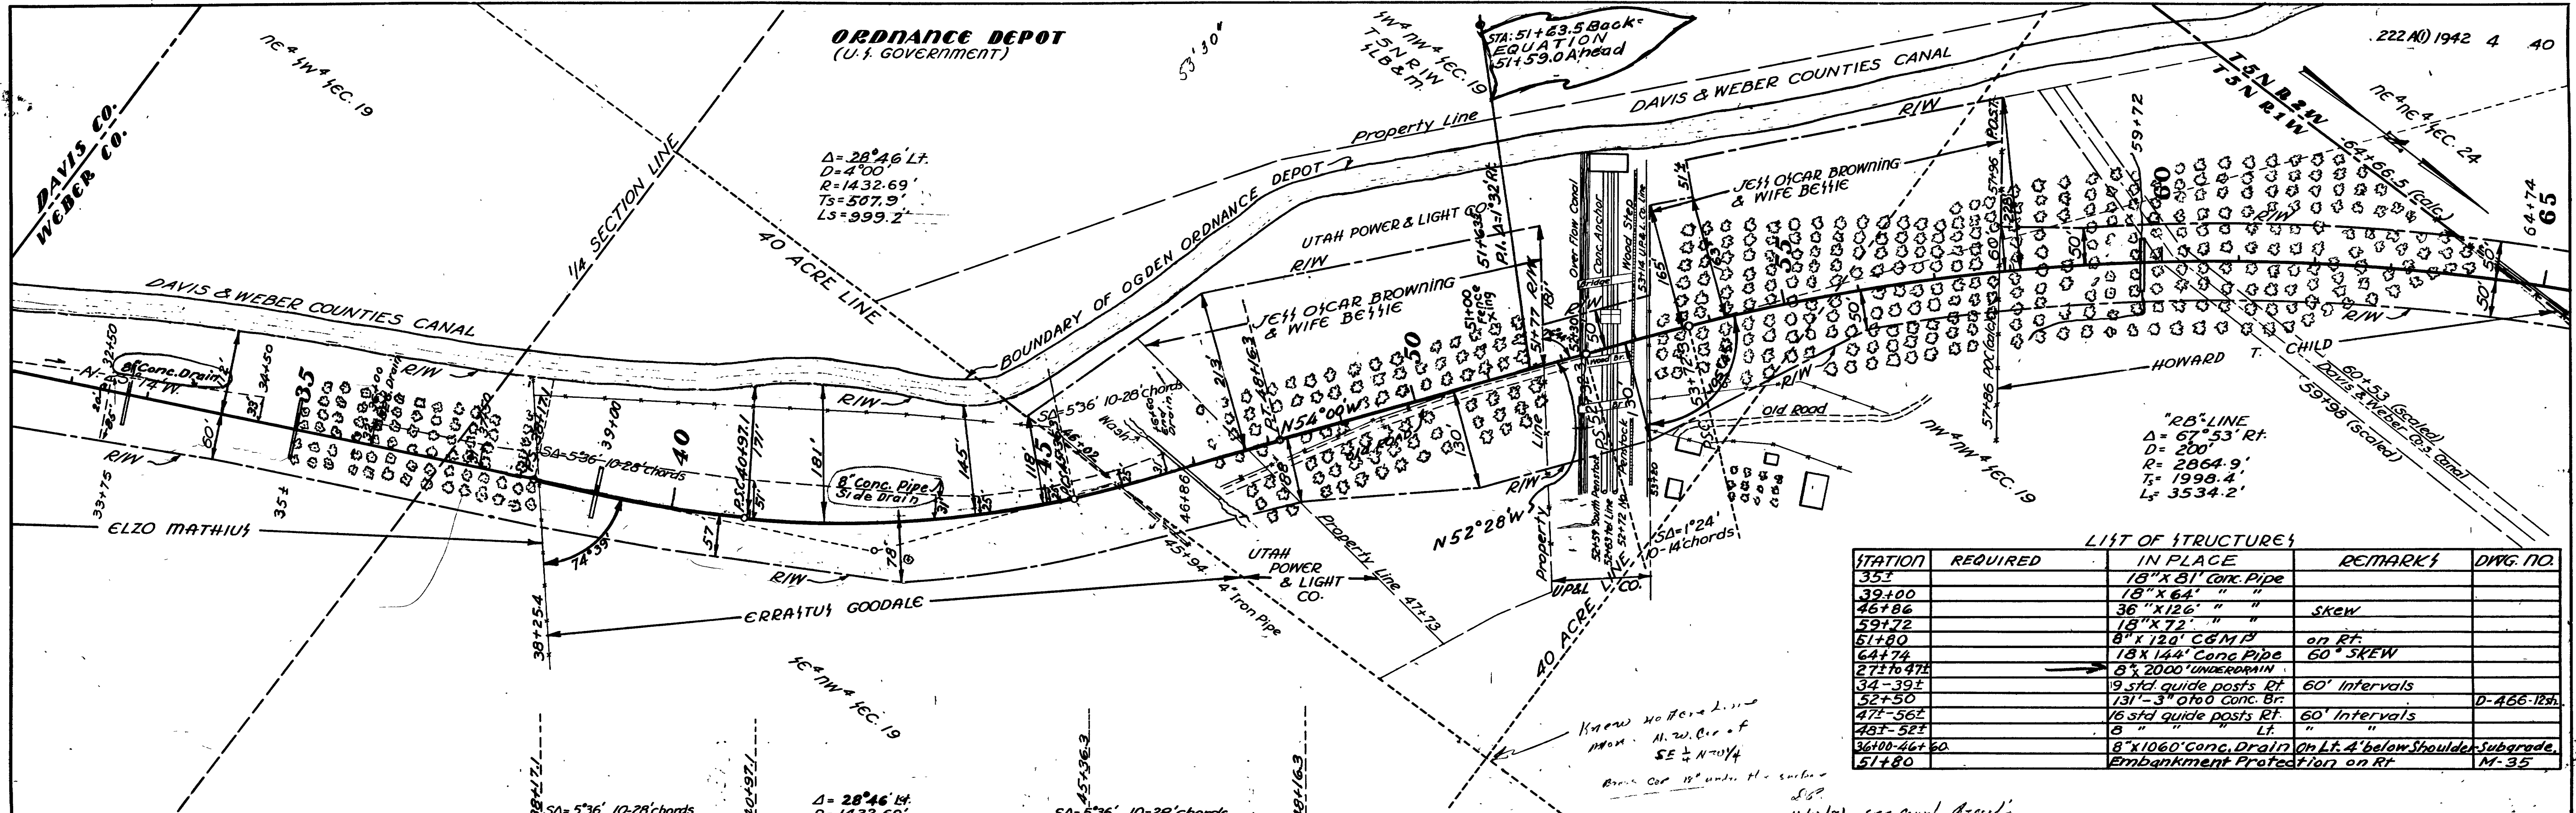


LIST OF STRUCTURES

STATION	REQUIRED	IN PLACE	REMARKS	DWG. NO.
35+		18" x 81' Conc. Pipe		
39+00		18" x 64' " "		
46+86		36" x 126' " "	skew	
59+72		18" x 72' " "		
51+80		8" x 120' C&M P	on Rt.	
64+74		18" x 144' Conc. Pipe	60' SKEW	
271 to 471		8" x 2000' UNDERDRAIN		
34-39±		9 std guide posts Rt	60' Intervals	
52+50		131'-3" old conc. Br.		D-466-12h
47+56±		16 std guide posts Rt	60' Intervals	
48+52±		8" " " Lt.		
36+00-46+60		8" x 1060' Conc. Drain on Lt. 4' below Shoulder	Subgrade	
51+80		Embankment Protection on Rt.		M-35

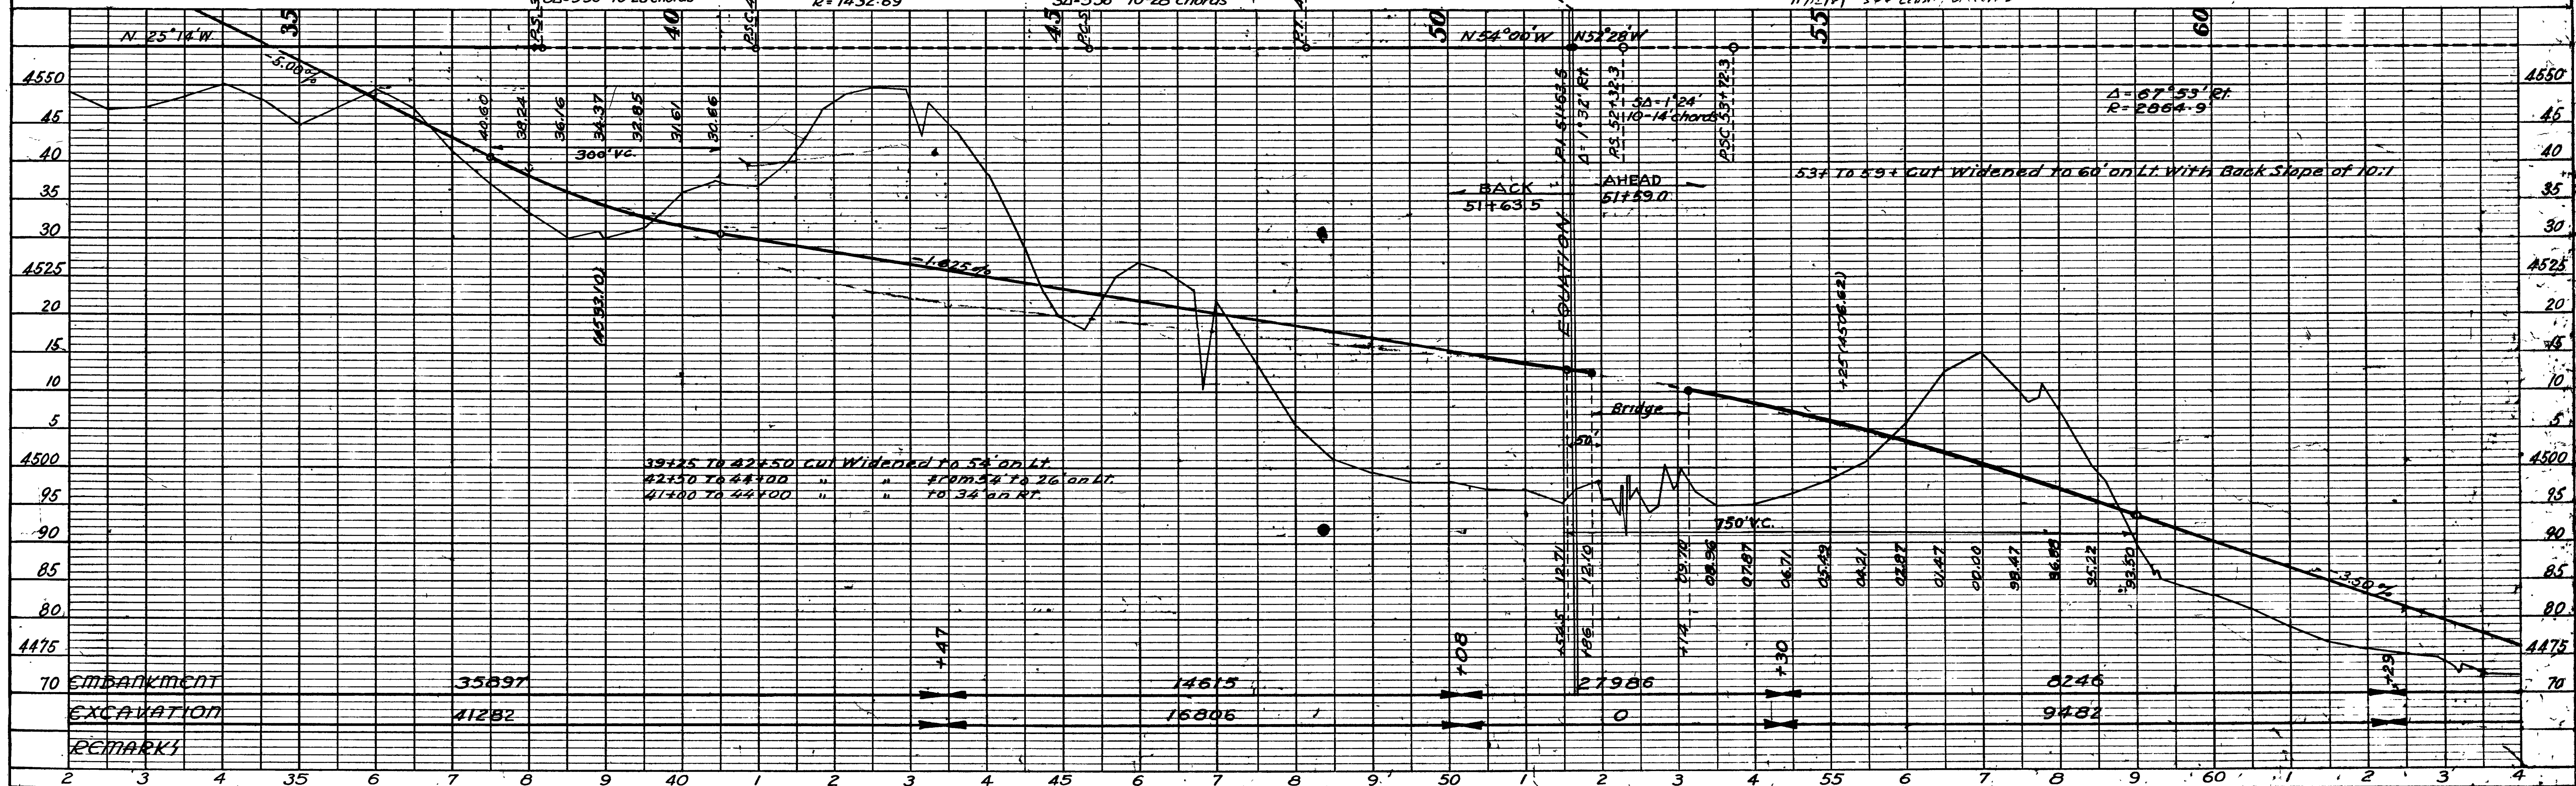

RES. NO.	STATE	PROJECT	FISCAL YEAR	SHEET NO.	TOTAL SHEETS
12	UTAH	222-A(1)	1942	5	10
		DA-WR 12(1)		3	10

DATE	BY	REVISION
7-9-42	L. B. RICHENS	PLANNING
7-11-42	L. B. RICHENS	CONSTRUCTION
7-11-42	L. B. RICHENS	AS BUILT
7-11-42	L. B. RICHENS	REVISION
7-11-42	L. B. RICHENS	REVISION
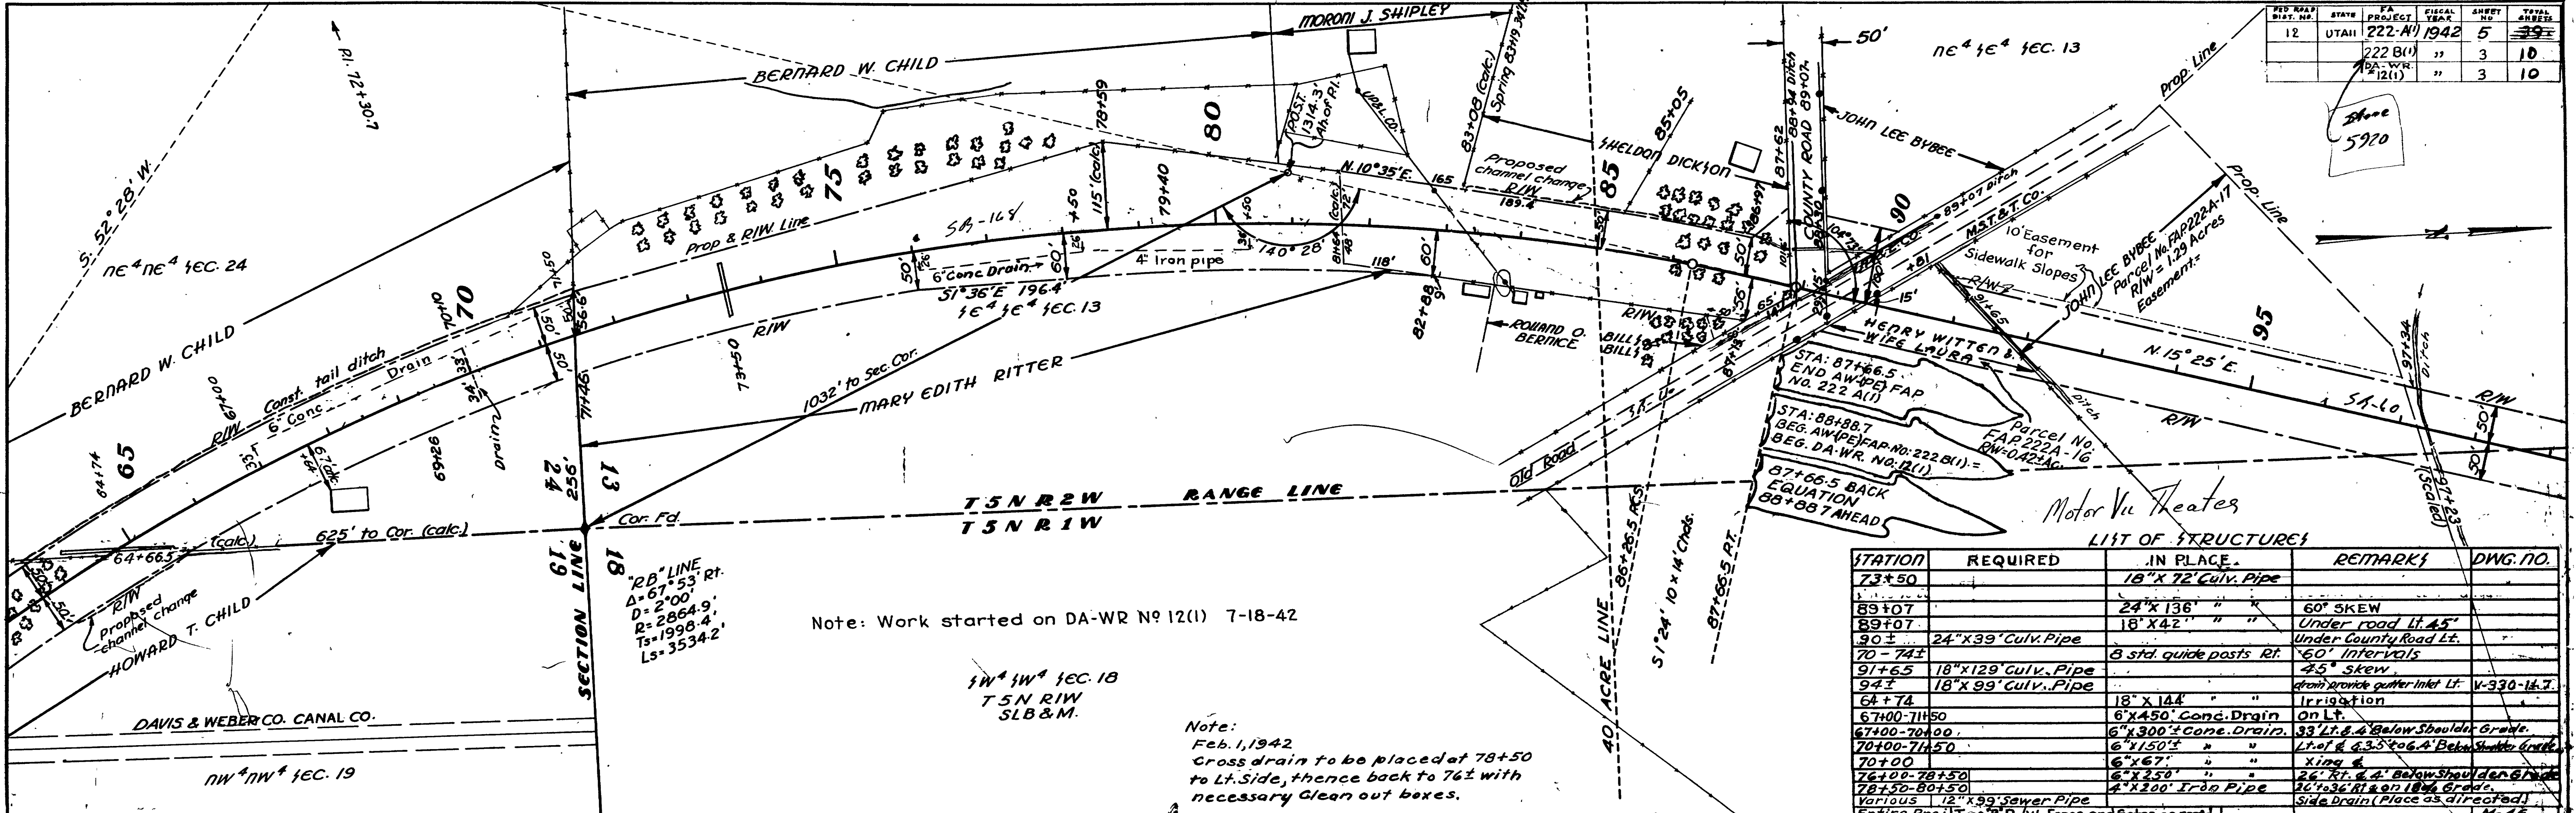


Note: Work started on DA-WR No 12(1) 7-18-42

Note:
Feb. 1, 1942
Cross drain to be placed at 78+50
to Lt. Side, thence back to 76+1 with
necessary clean out boxes.



STATION	REQUIRED	IN PLACE	REMARKS	DWG. NO.
73+50		18" x 72" Culv. Pipe		
89+07		24" x 136" "	60' SKEW	
89+07		18" x 42" "	Under road lt. 45'	
90±	24" x 39" Culv. Pipe		Under County Road Lt.	
70-74±		3 std. guide posts Rt.	60' Intervals	
91+65	18" x 129" Culv. Pipe		45' skew	
94±	18" x 99" Culv. Pipe		drawn on right gutter inlet Lt.	V-330-H.T.
64+74		18" x 144"	Irrigation	
67+00-71+50		6" x 450' Conc. Drain on Lt.		
67+00-70+00		6" x 300' Conc. Drain.	33' Lt. & 4' Below Shoulder Grade	
70+00-71+50		6" x 150' "	Lt. of & 4.35' to 6.4' Below Shoulder Grade	
70+00		6" x 67' "	King &	
76+100-78+150		6" x 250' "	26' Lt. & 4' Below Shoulder Grade	
78+150-80+150		4" x 200' Iron Pipe	36' Lt. & 8' on 18" Grade	
Various		12" x 99' Sewer Pipe	Side Drain (Place as directed)	M-46
Entire Proj. Type B R.W. Fence and Gates as reqd.				

DATE	BY	REVISION
7-9-42	L. B. RICHENS	PLANNING
7-11-42	L. B. RICHENS	CONSTRUCTION
7-11-42	L. B. RICHENS	AS BUILT
7-11-42	L. B. RICHENS	REVISION
7-11-42	L. B. RICHENS	REVISION
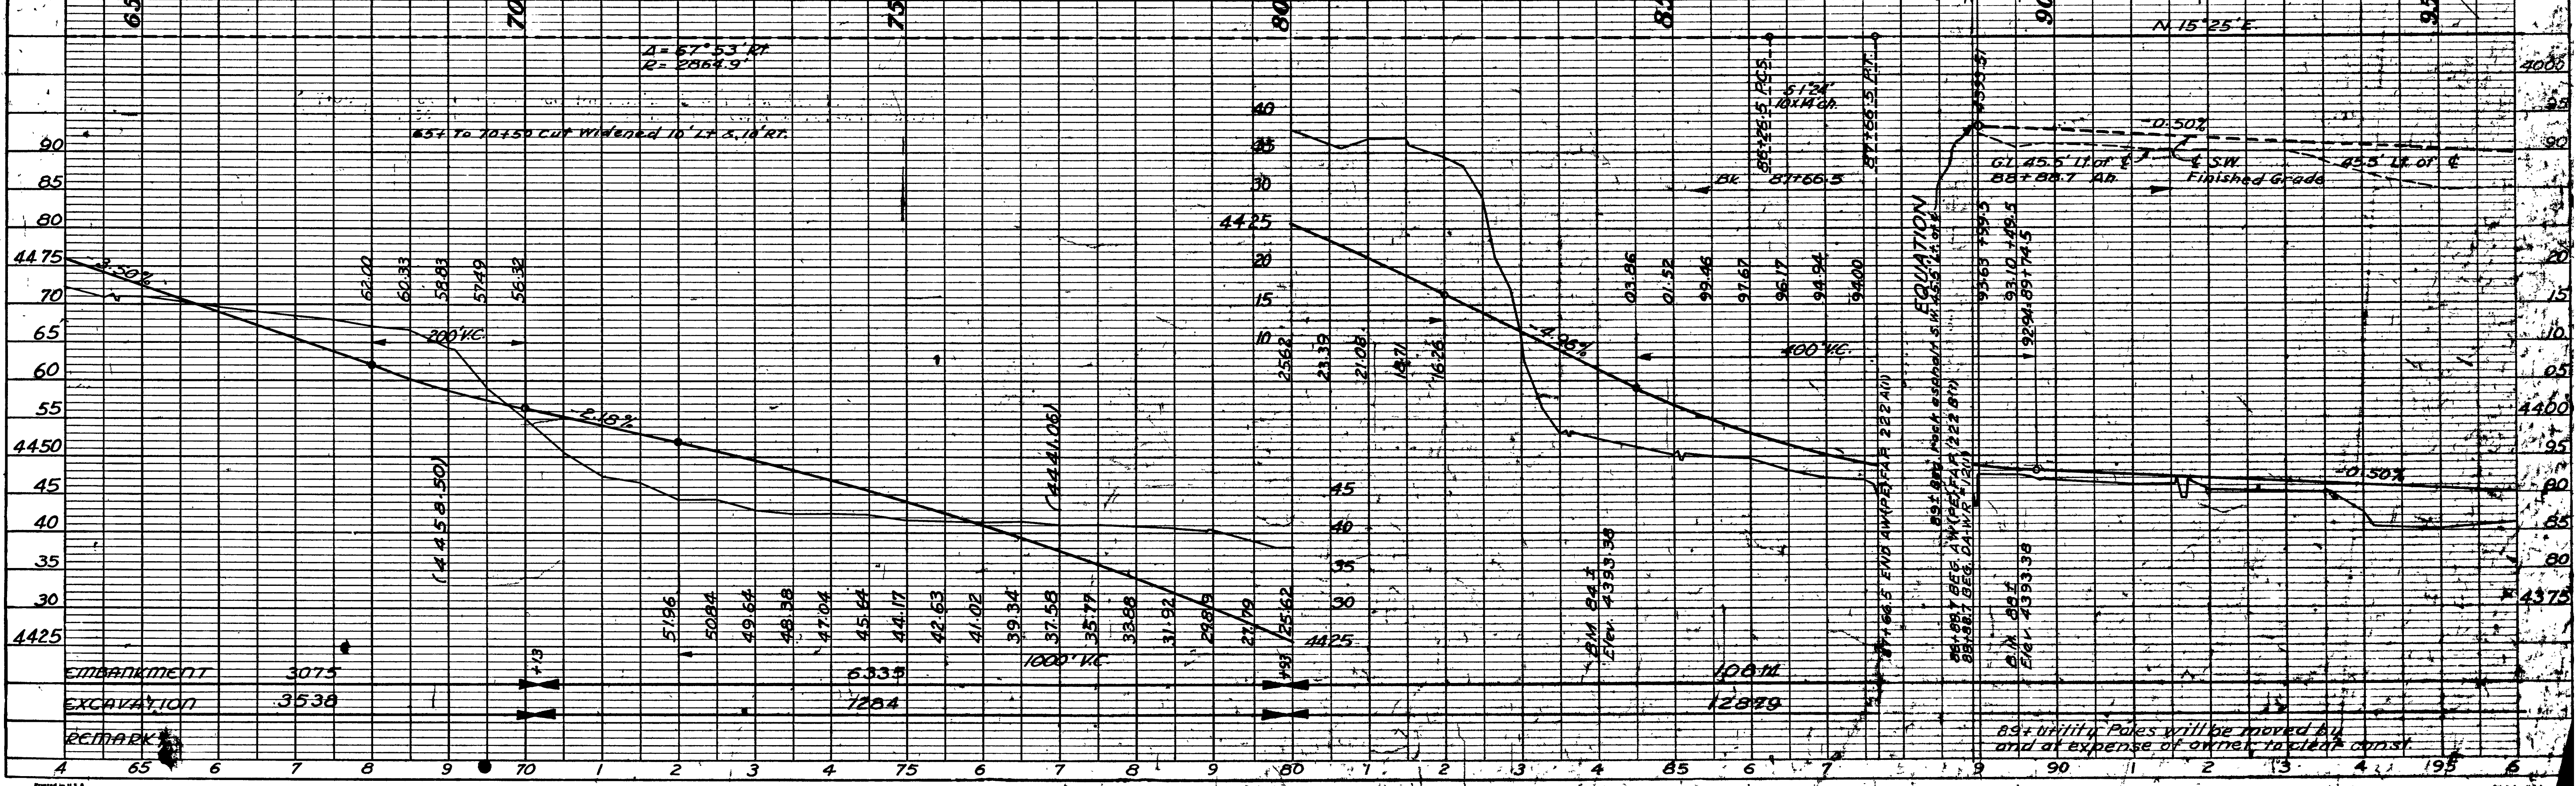


DATE	
BY	
APPROVED	
PLANNED	
ALIGNED CHECKED	
RT. OF WAY CHECKED	
NO.	

DATE	
BY	
SURVEYED	
GRADES CHECKED	
STRUCTURE NOTATIONS CHECKED	
NO.	

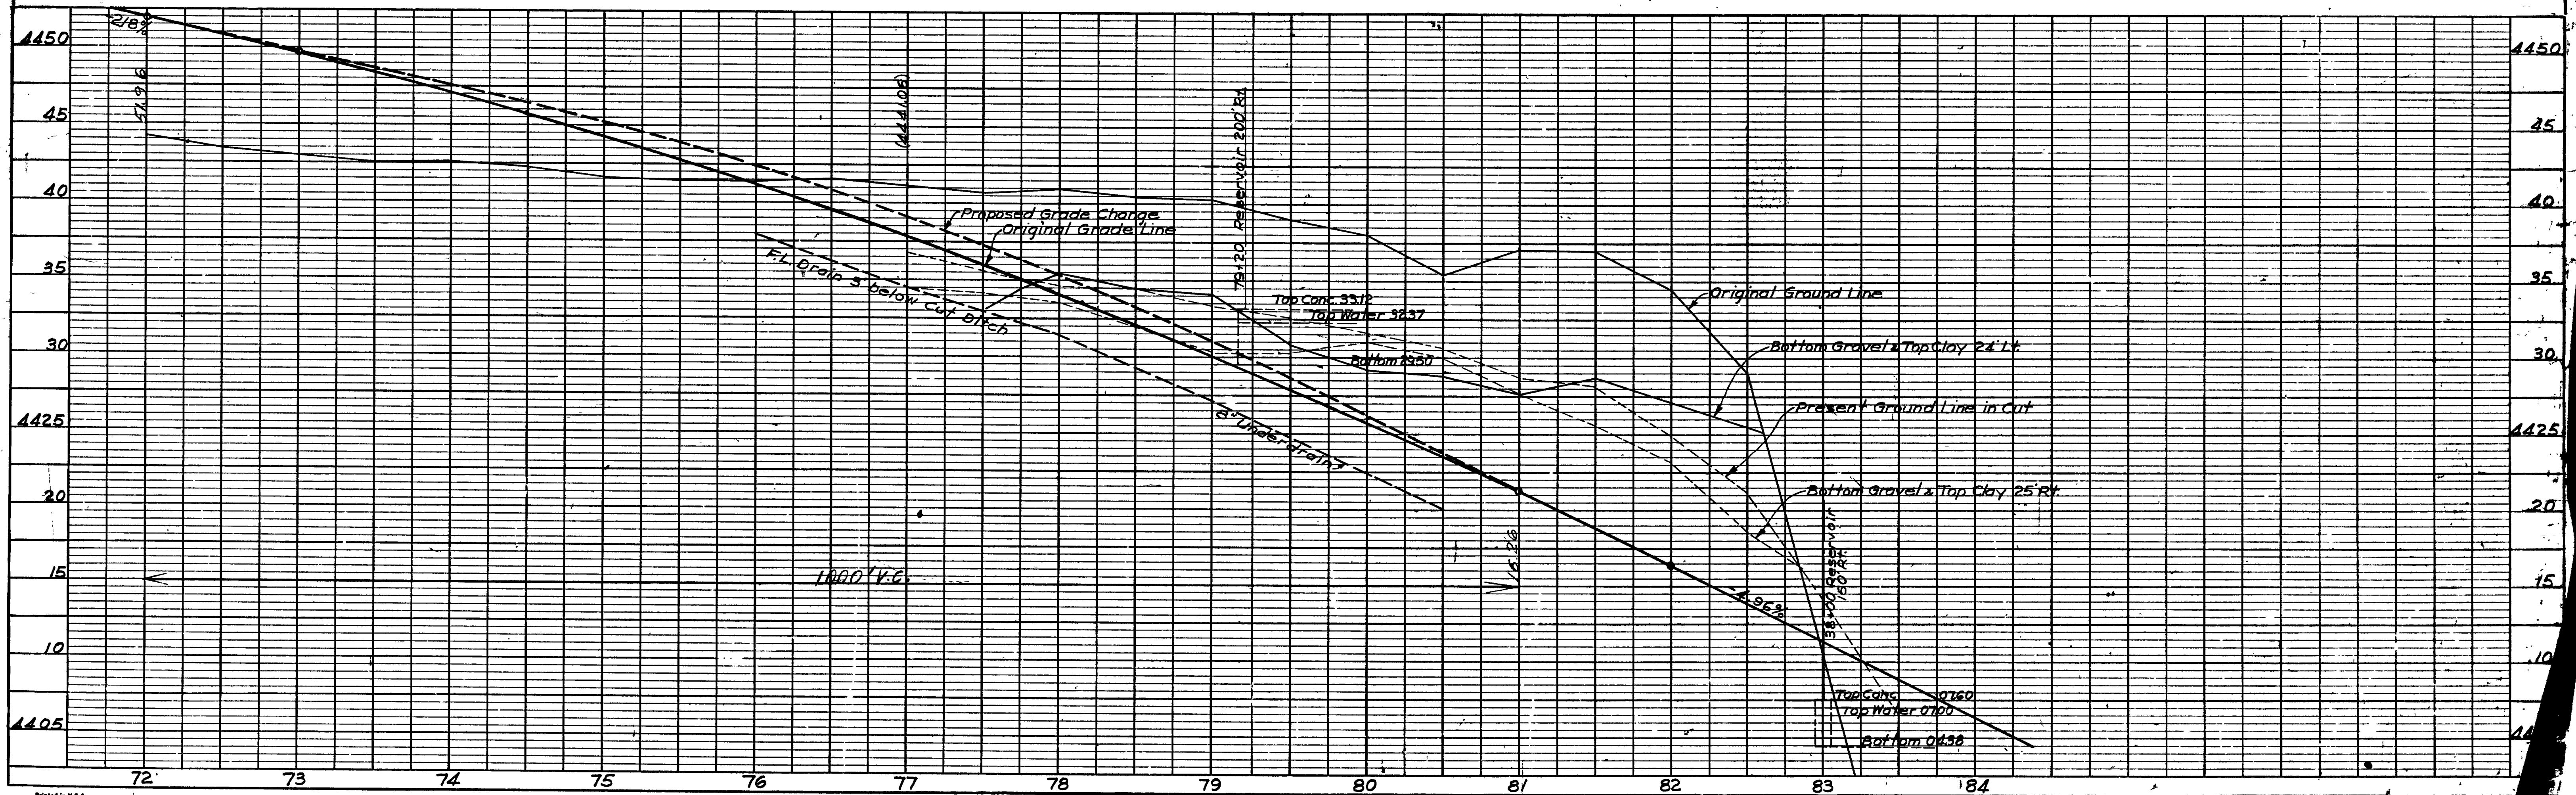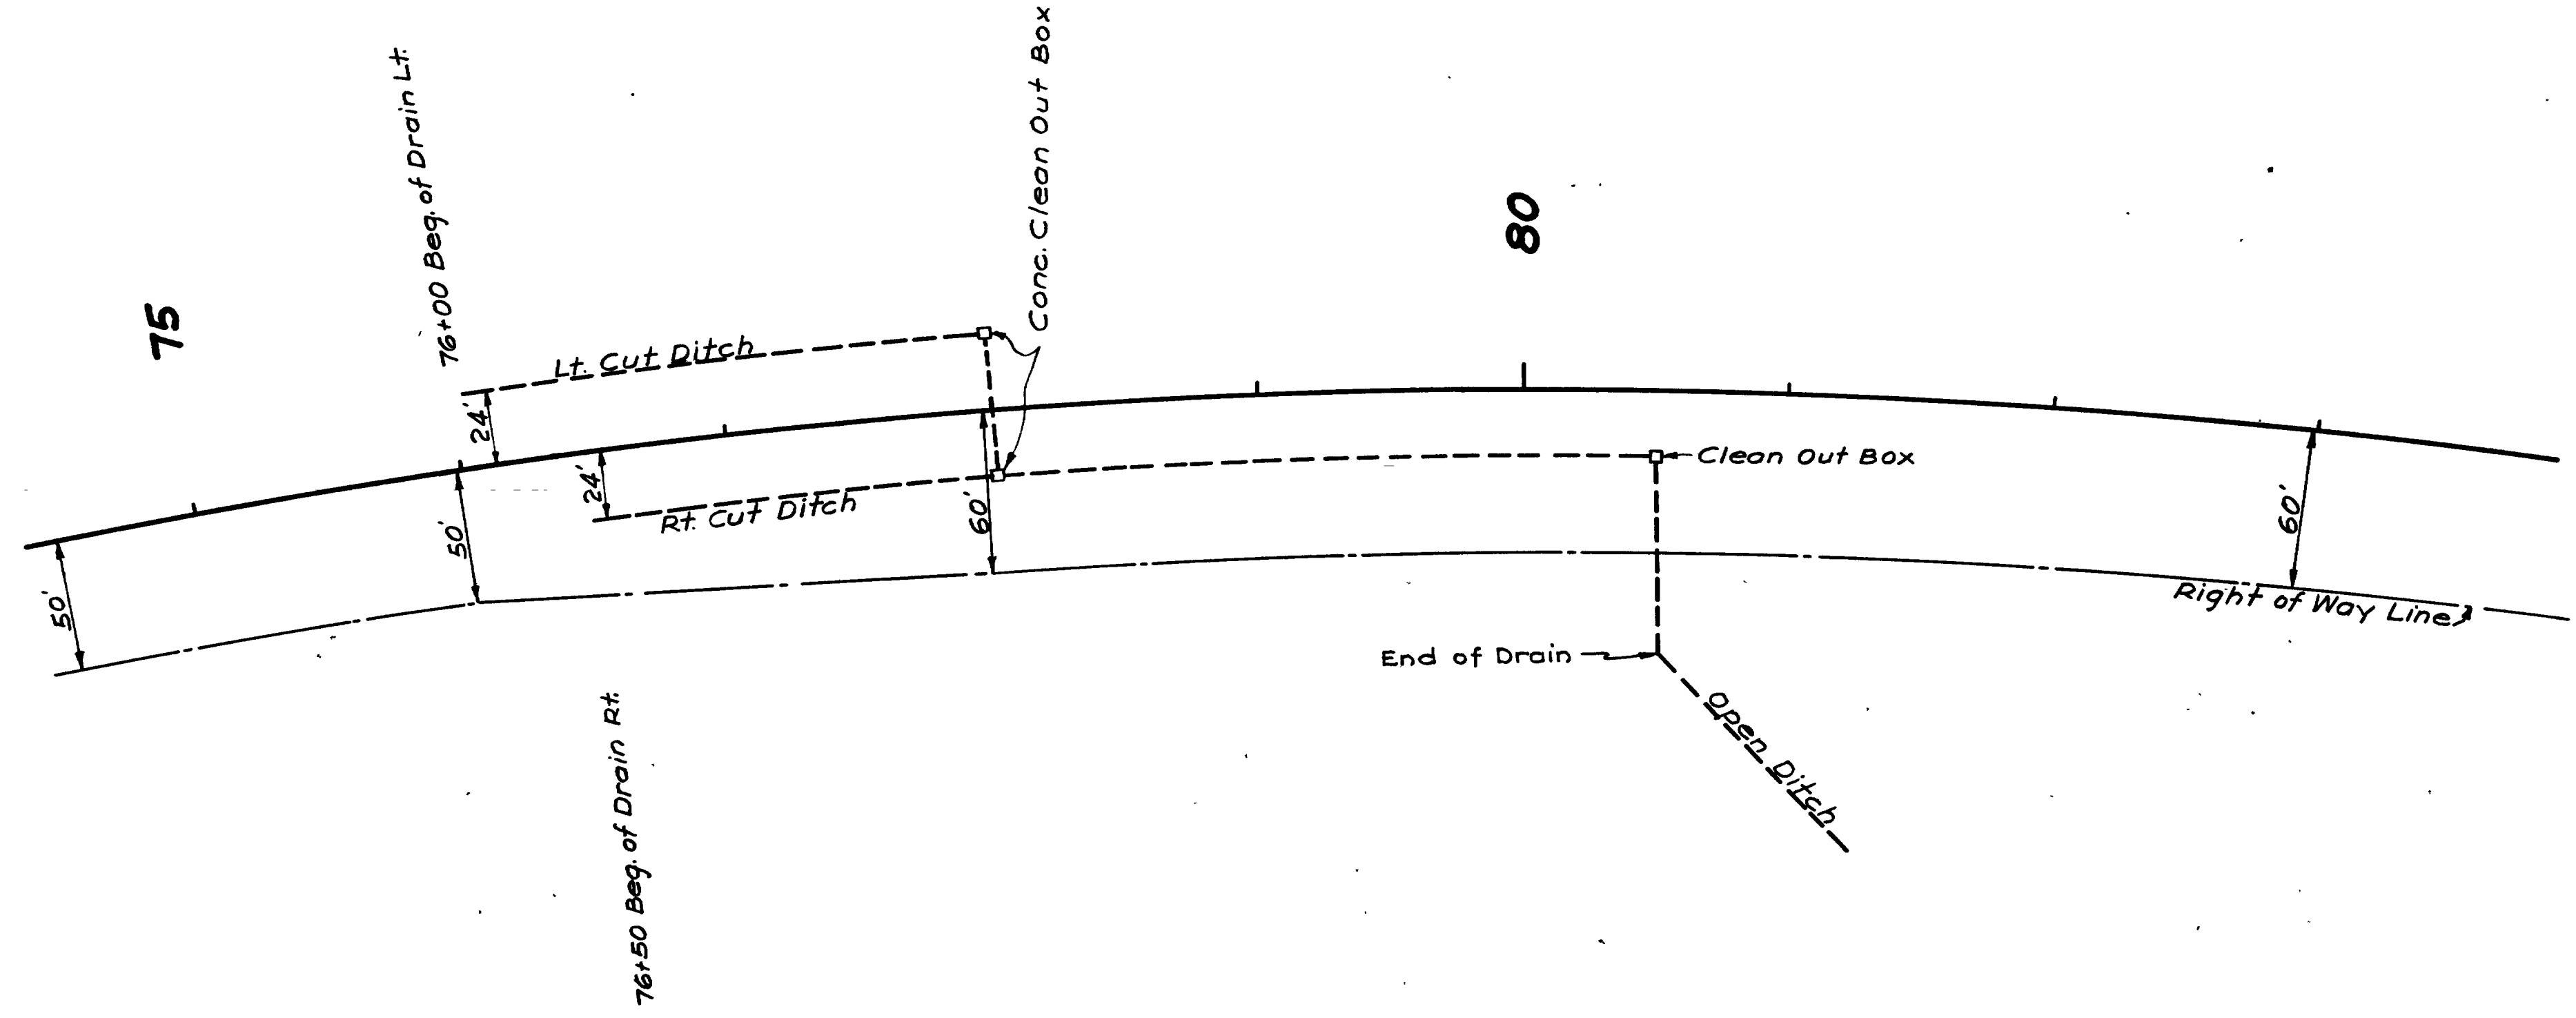


PLAN
 SURVEYED BY
 PLOTTED BY
 CHECKED BY
 DATE

PROFILE
 SURVEYED BY
 PLOTTED BY
 CHECKED BY
 DATE



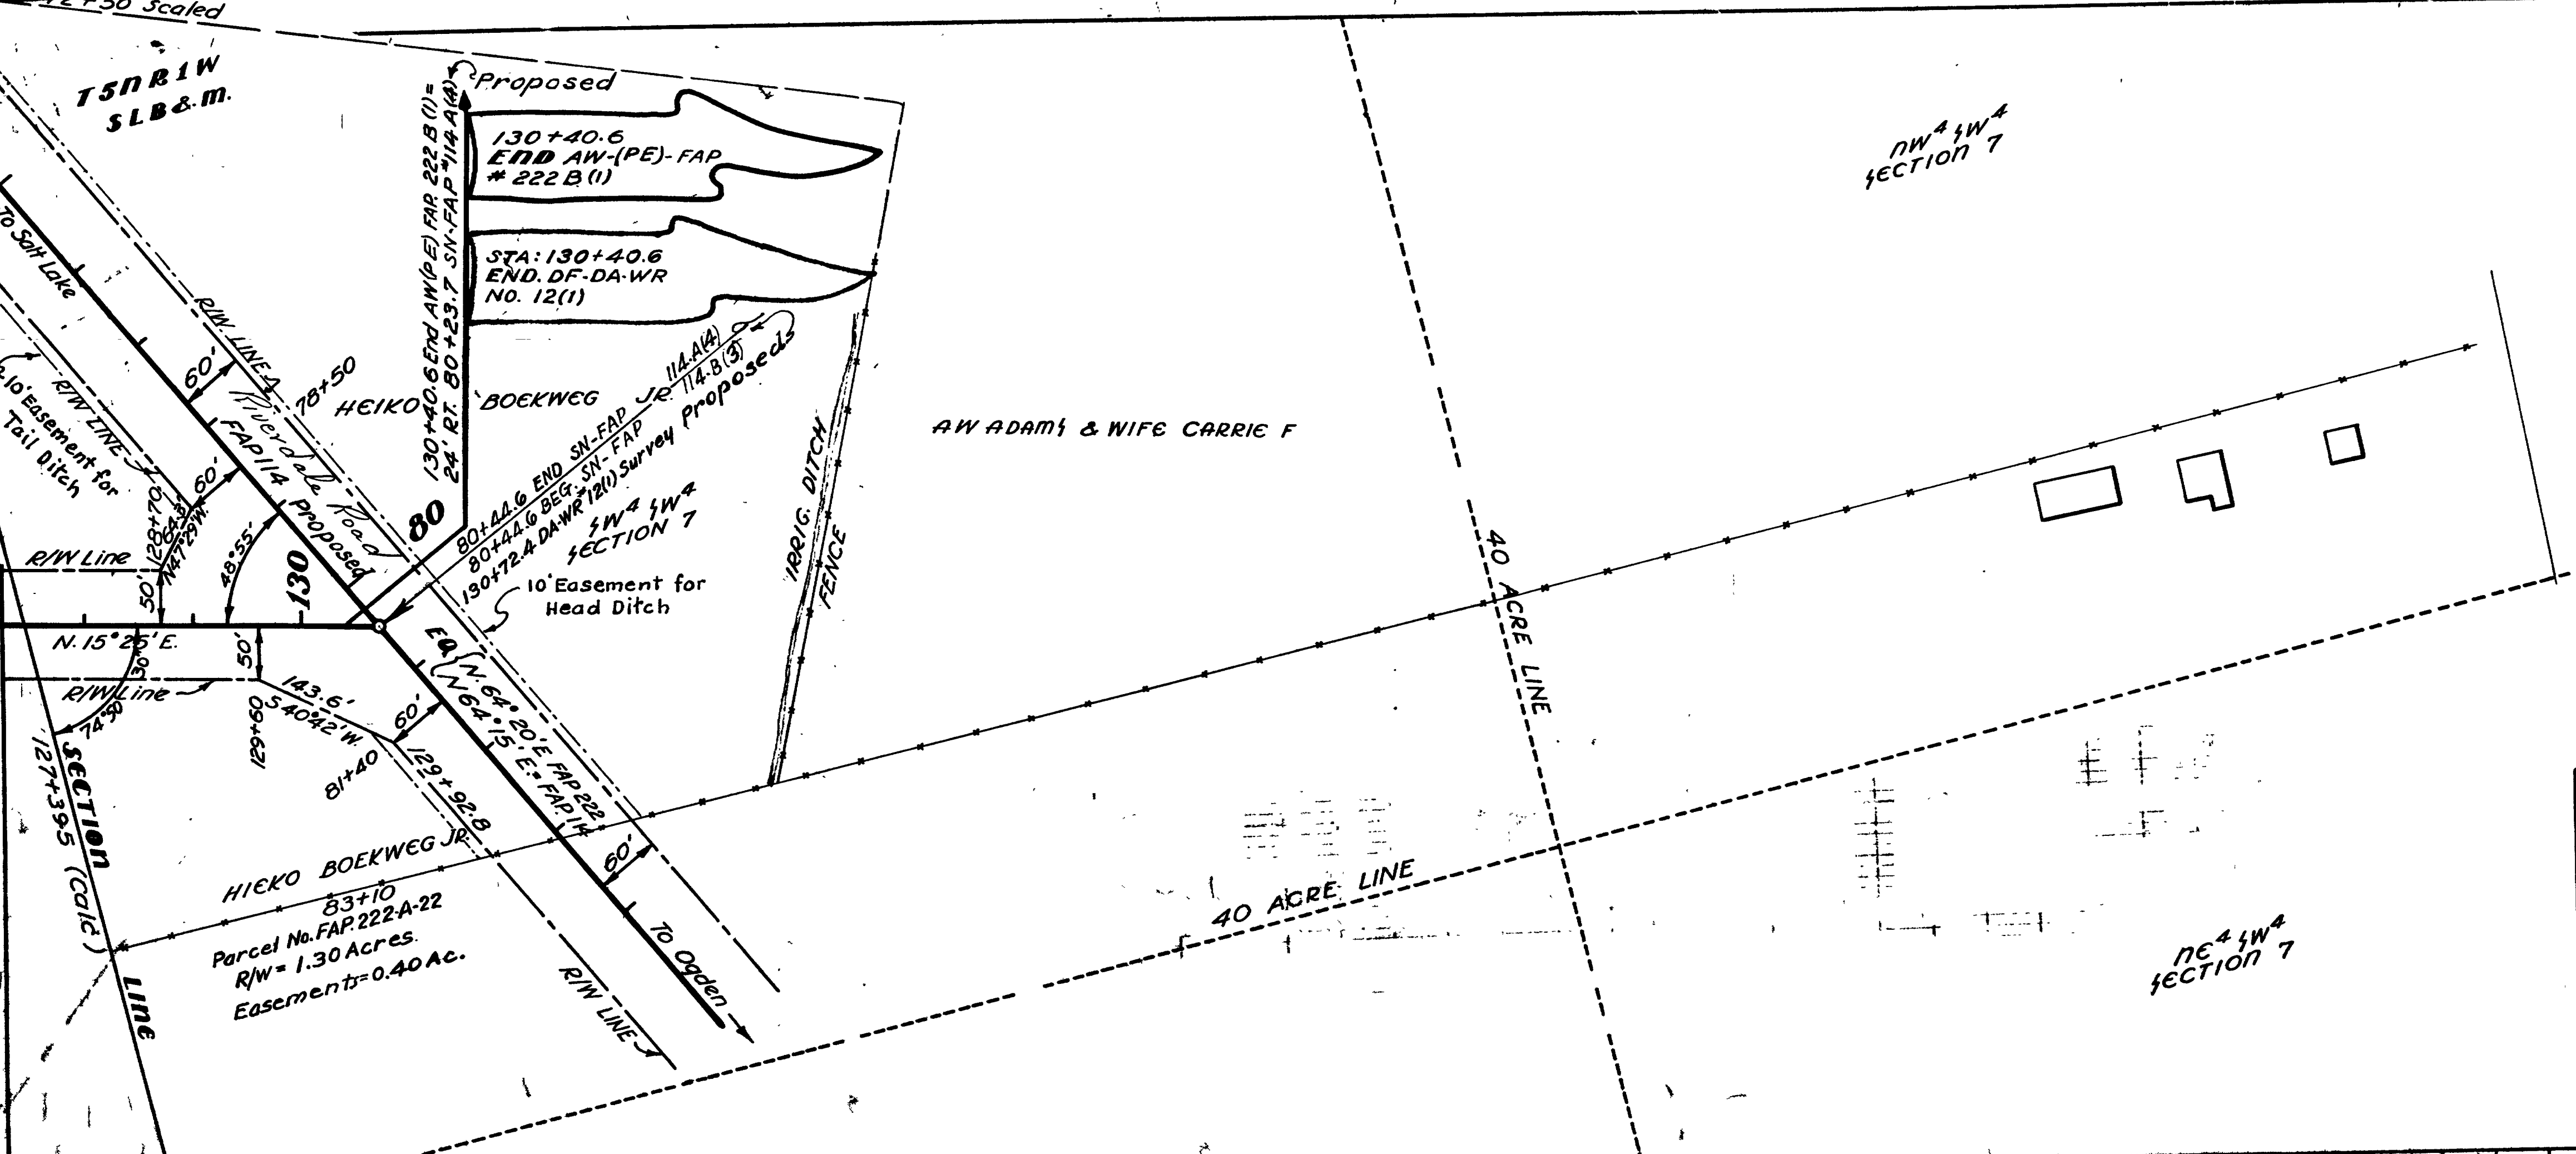


LIST OF STRUCTURES

STATION	IN PLACE	REQUIRED	REMARKS	DWG. NO.

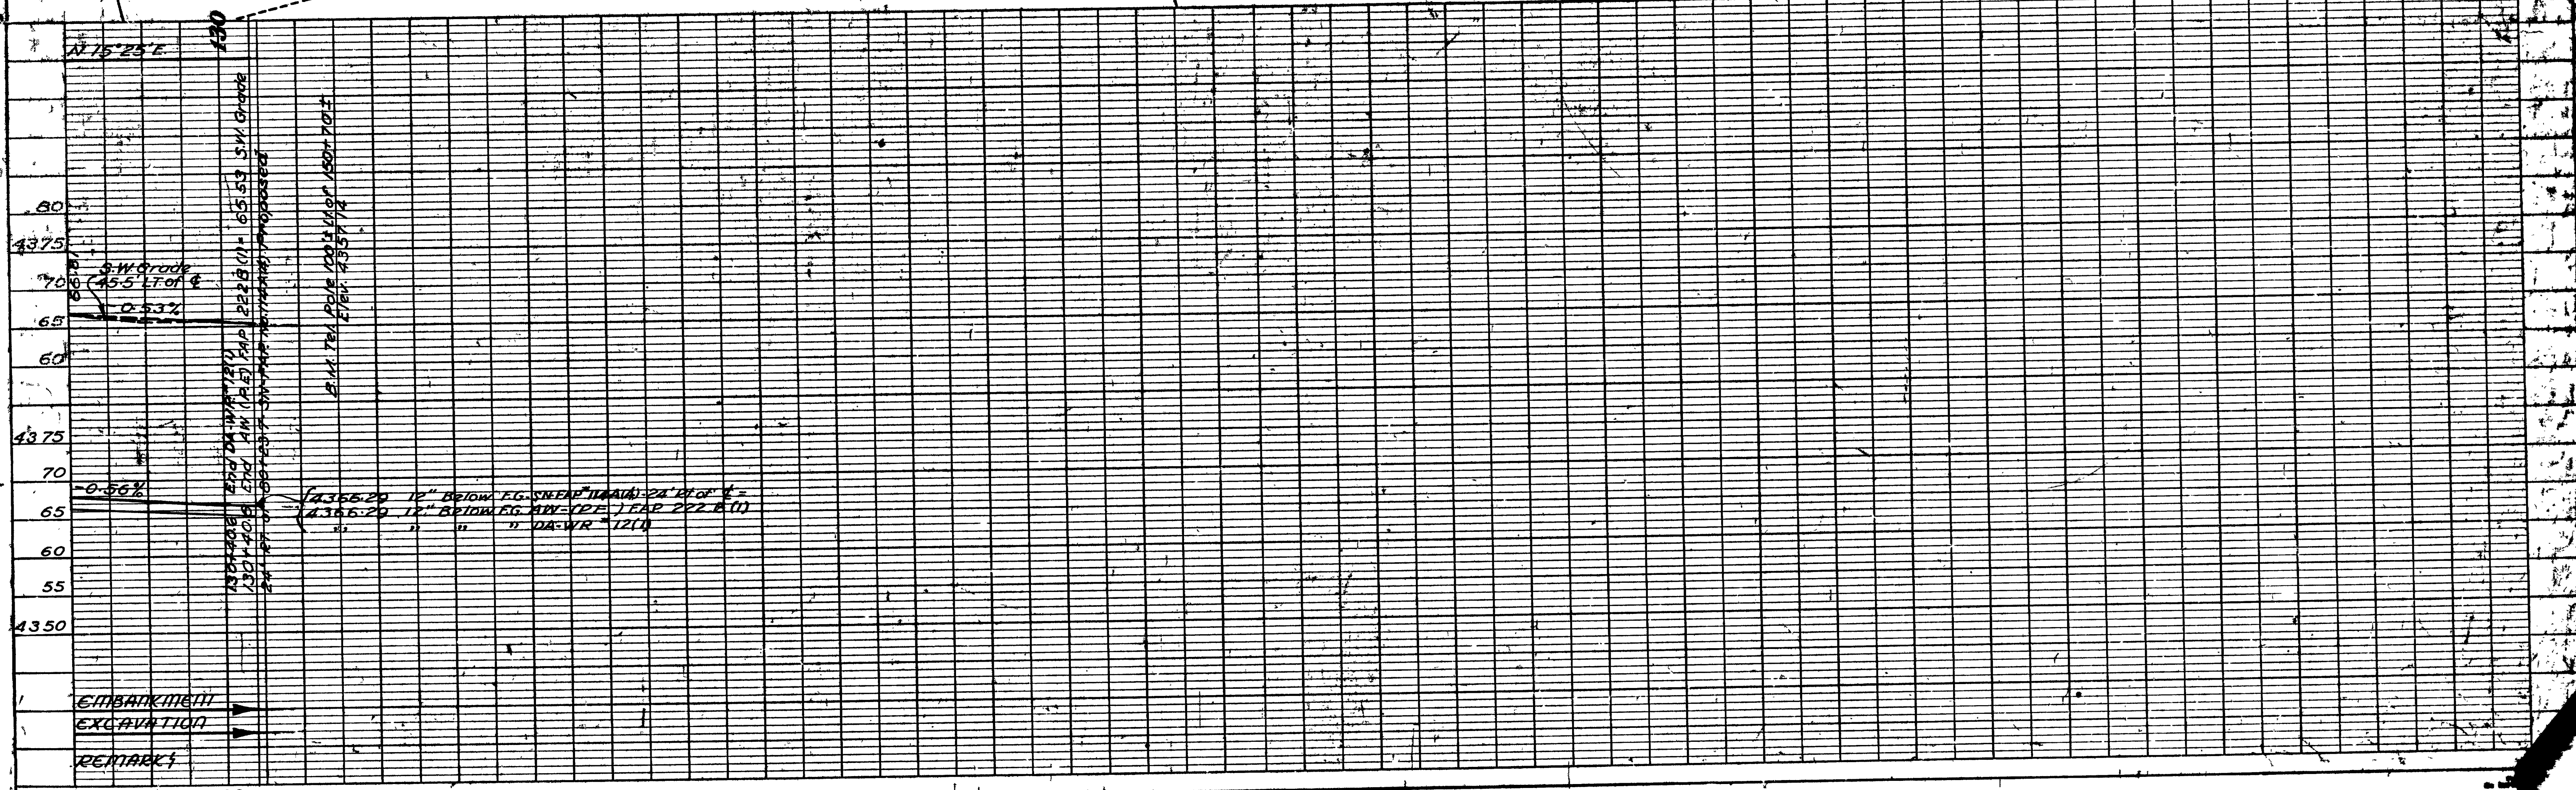

FED. ROAD DIST. NO.	STATE	F.A.P. NO.	DATE	SHEET NO.	TOTAL SHEETS
12	UTAH	114-A(4)	1942	7	11
12	UTAH	114-B(3)	1942	5	10
12	UTAH	222-B(1)	1942	11	

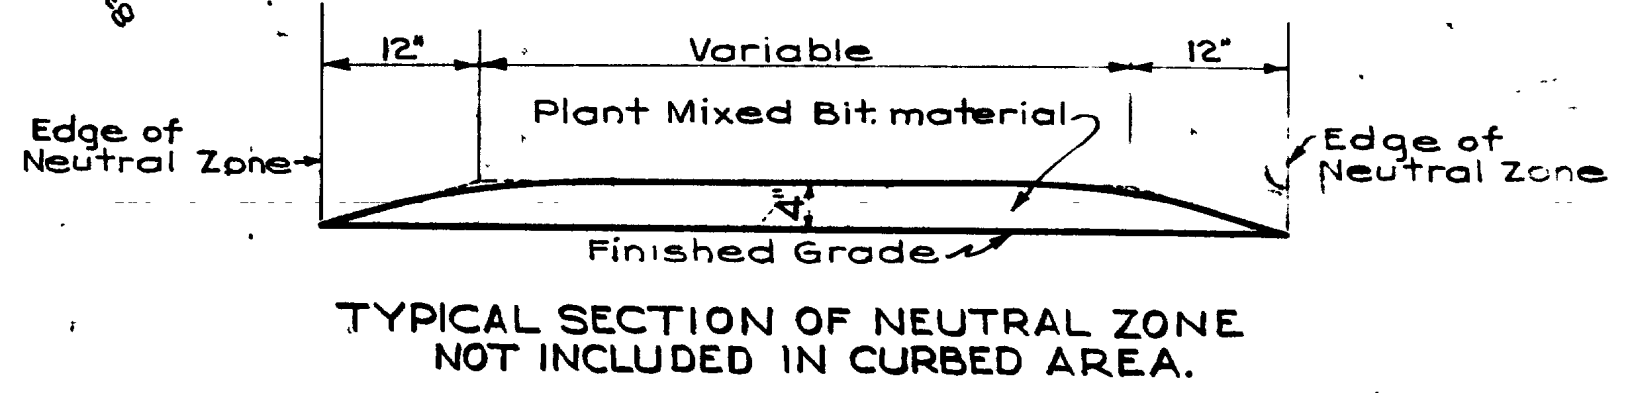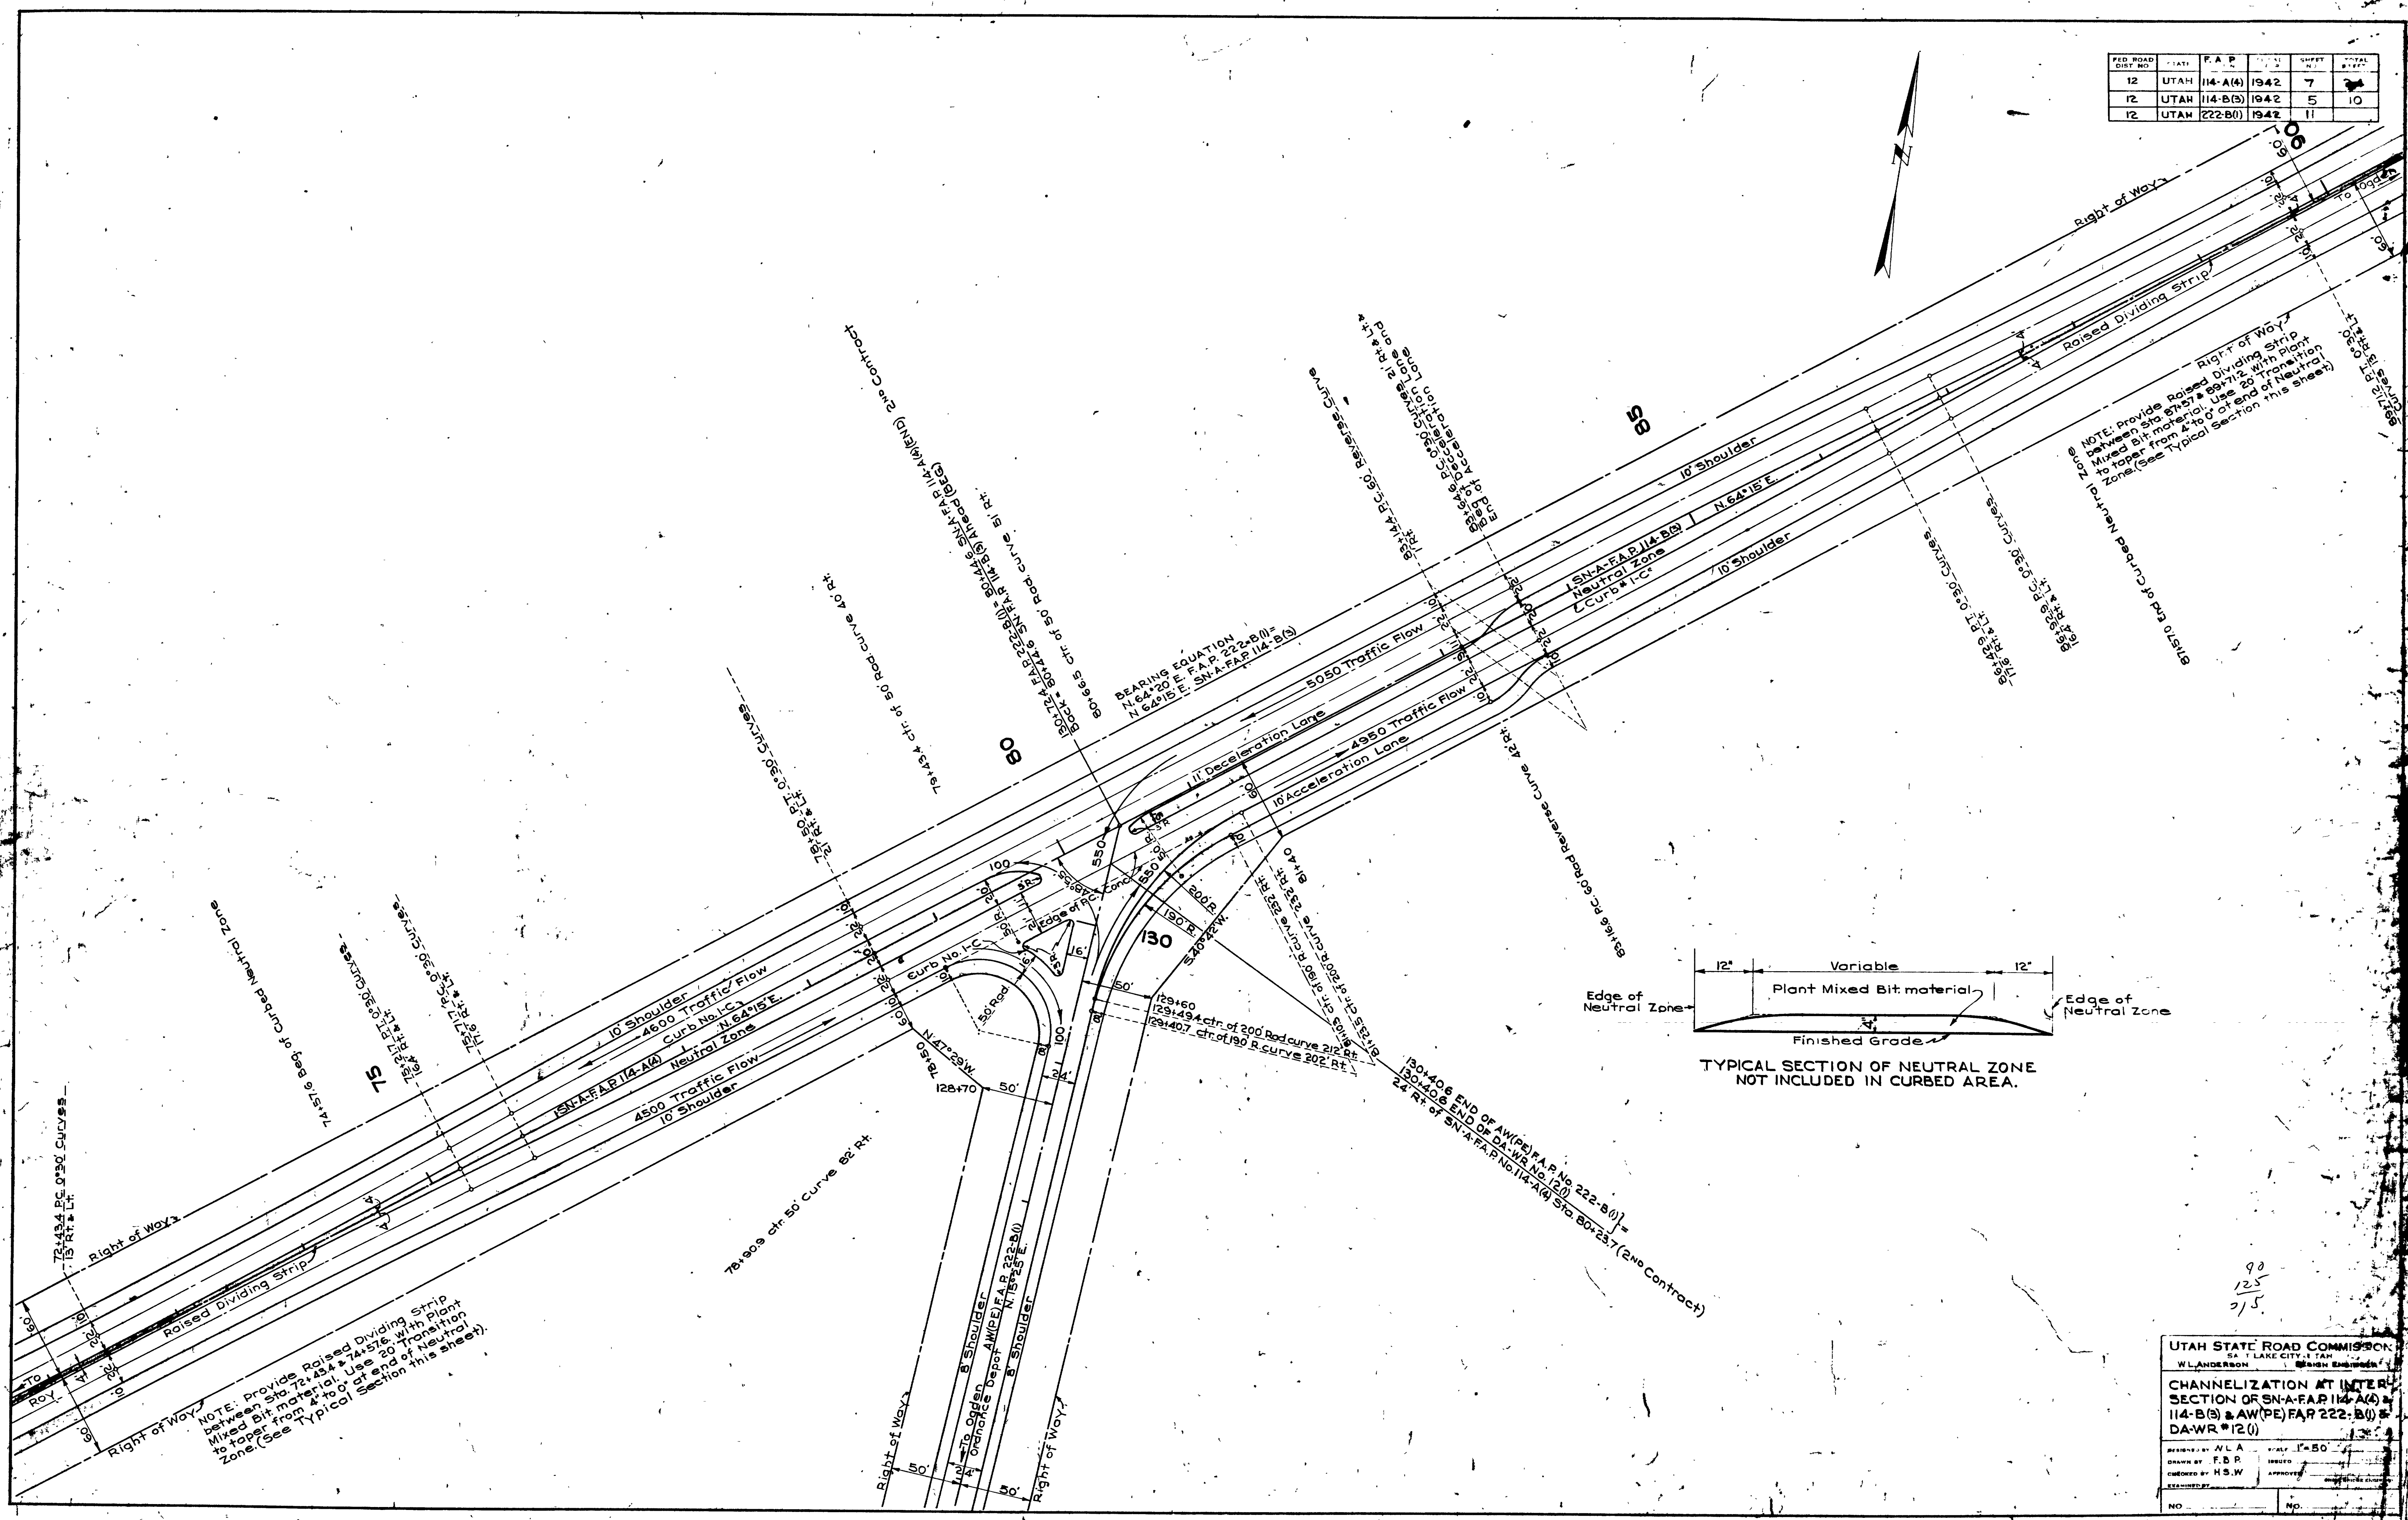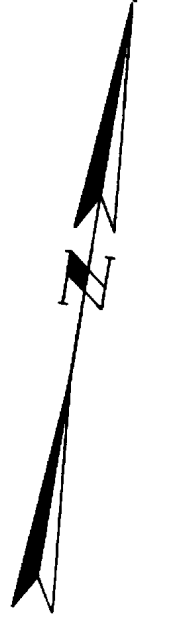


NOTE: Provide Raised Dividing Strip between Sta. 74+57.6 & 74+57.6 with Plant Mixed Bit material. Use 20' Transition to taper from 4' to 0' at end of Neutral Zone (See Typical Section this sheet).

UTAH STATE ROAD COMMISSION	
W. LANDERSON	DESIGN ENGINEER
CHANNELIZATION AT INTERSECTION OF SN-A-FAP 114-A(4) & 114-B(3) & AW(PE) FAP 222-B(1) & DA-WR #12(1)	
DRAWN BY: A.L.A.	CHECKED BY: H.S.W.
ISSUED BY: F.B.R.	APPROVED BY: [Signature]
NO. _____	NO. _____

90
125
215


DATE	7/27
BY	J.A. BURMAN
PLANNED	
GRADES CHECKED	
STRUCTURE NOTATION CHECKED	
NO.	2793

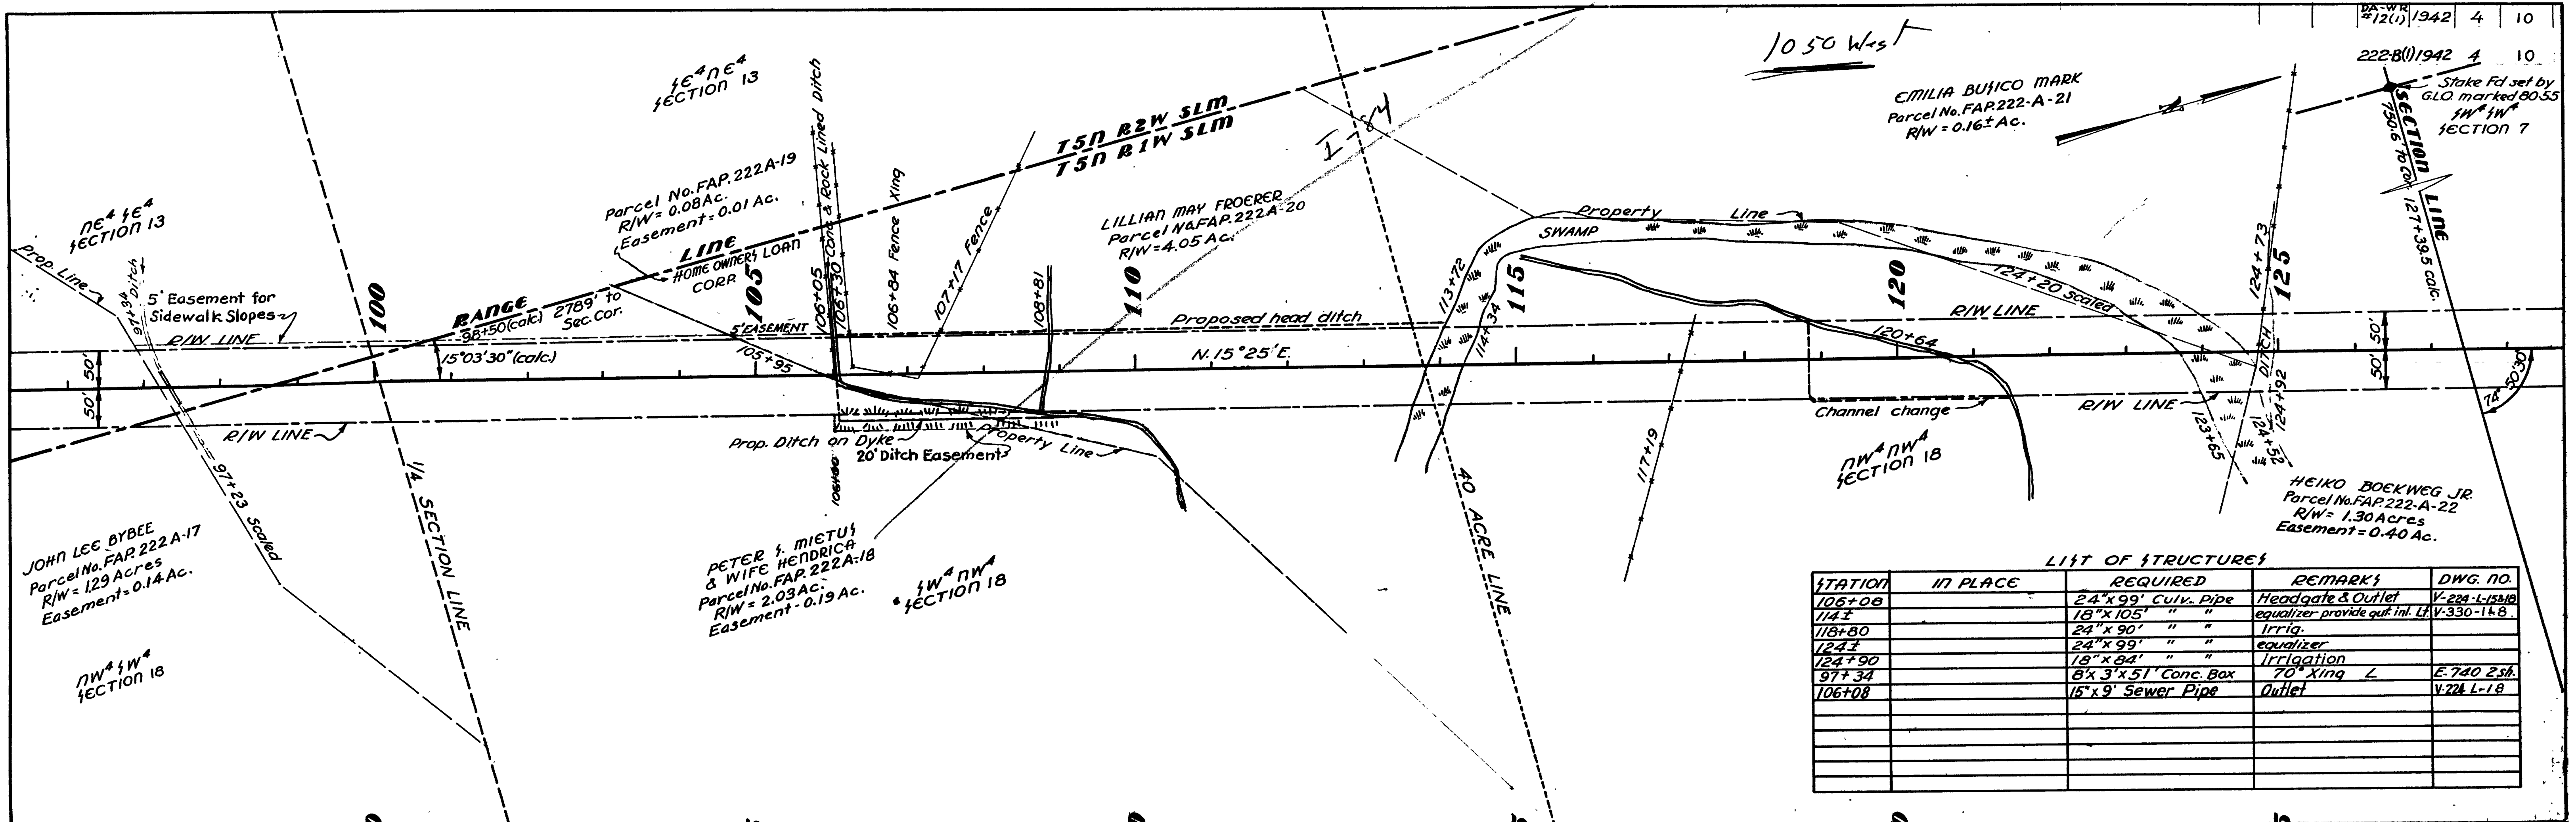

LIST OF STRUCTURES

STATION	IN PLACE	REQUIRED	REMARKS	DWG. NO.
106+08		24" x 99" Cuv. Pipe	Headgate & Outlet	V. 224-L-153B
114±		18" x 105" " "	equalizer provide quit. int. Lf	V. 330-14B
118+80		24" x 90" " "	Irrig.	
124±		24" x 99" " "	equalizer	
124+90		18" x 84" " "	Irrigation	
97+34		6" x 3' x 51" Conc. Box	70' Xing L	E. 740 2sh
106+08		15" x 9" Sewer Pipe	Outlet	V. 224-L-18

DATE	7/27
BY	J.A. BURMAN
PLANNED	
GRADES CHECKED	
STRUCTURE NOTATION CHECKED	
NO.	2793

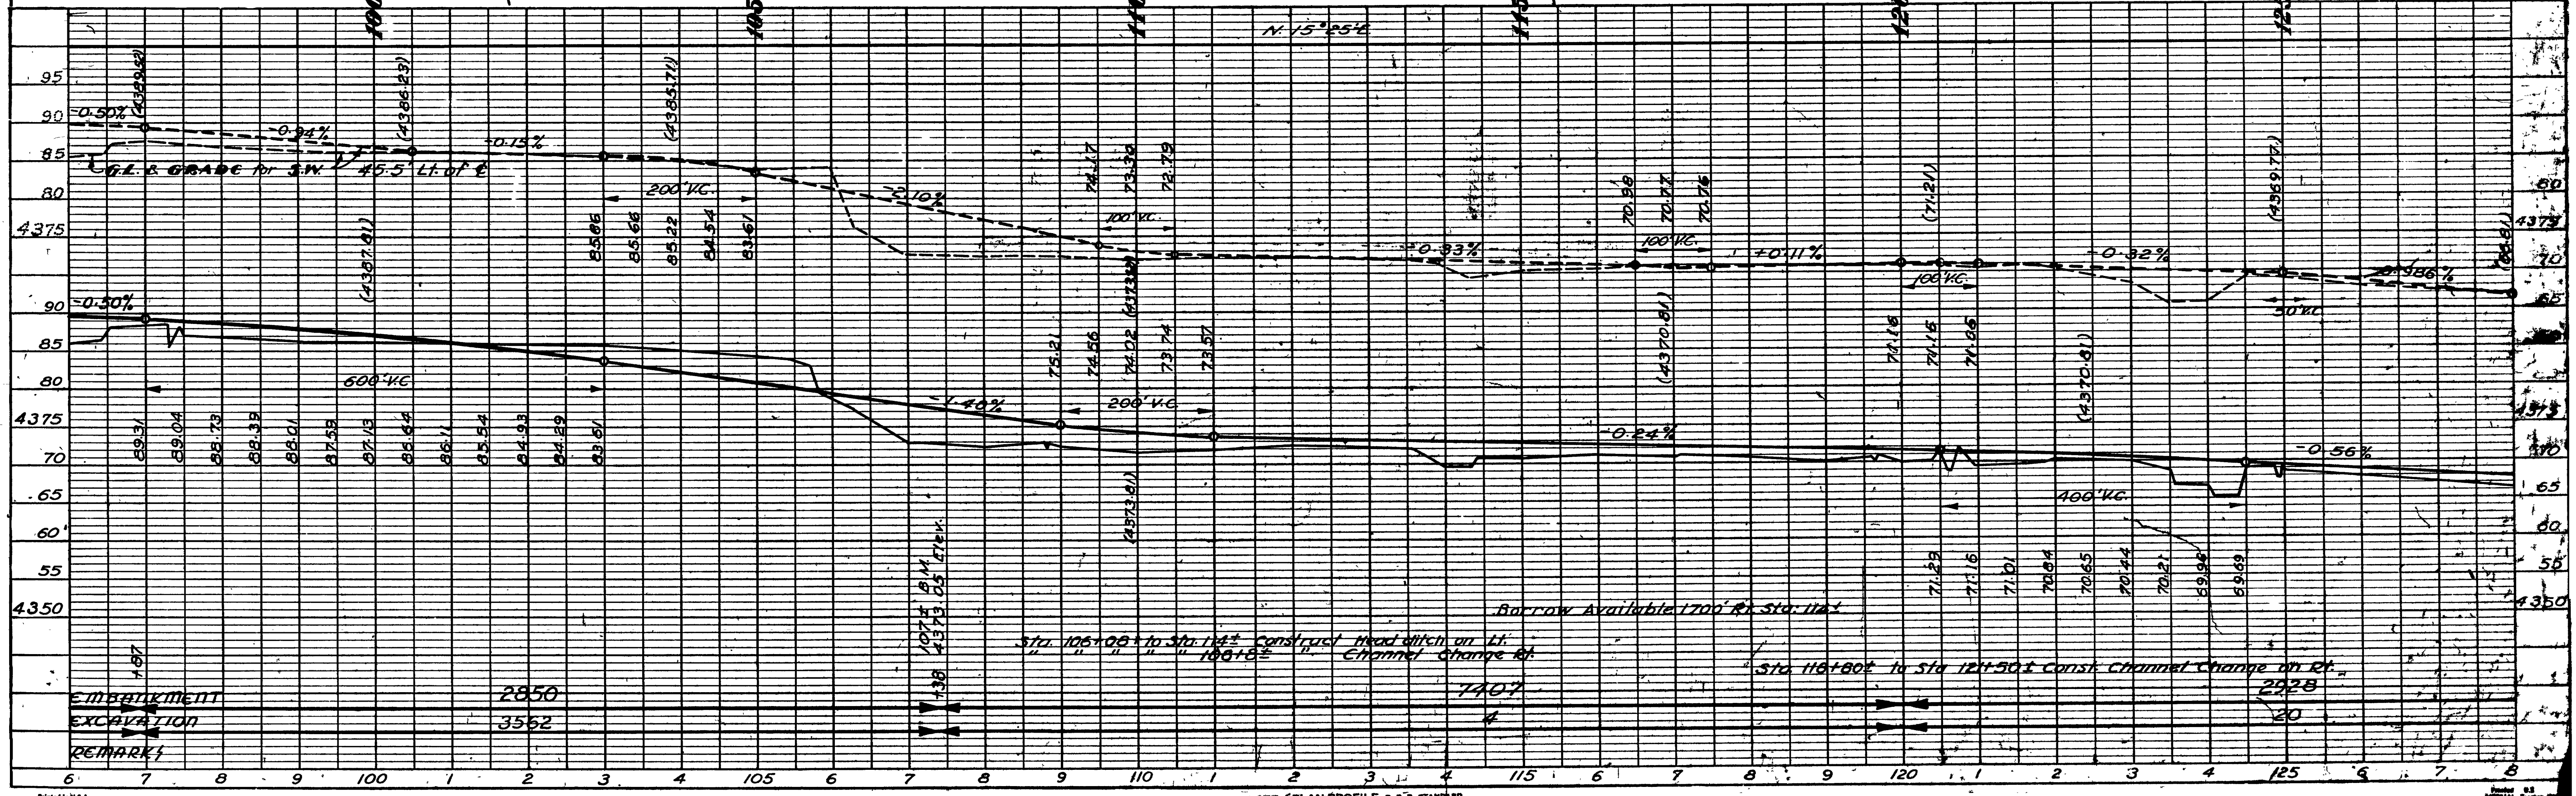

See #4

GENERAL NOTES

Materials, construction, and workmanship shall be in accordance with State Standard Specifications for Road and Bridge construction, edition of 1939.

NOTE: Before Cast-in Place Pile shells are ordered a Timber test pile should be driven to ascertain the correct length of shell to be ordered.

DESIGN DATA

A.A.S.H.O. Specifications of 1941
 H-15 Loading
 $f_c = 1000\%$ $f_s = 18,000\%$


QUANTITIES

Excav. for Structures	150	Cu.Yds.
Gravel Backfill	21	" "
8" C.G.M. Pipe Perforated (1-end plug) (Under drain)	60	Lin. Ft.
8" C.G.M. Pipe Not " (2-30"ells)	118	" "
18" ϕ 7ga. Steel Shell Cast-in-place Conc. Piles	870	" "
16" ϕ 7ga. " " " " " "	428	" "
Structural Steel	1167	Lbs.
Reinforcing Steel	79728	" "
Concrete Class "A"	372	Cu.Yds
Hand Rail (Concrete)	284.25	Lin. Ft.
Wood Stairway Complete as Req'd.	1	each
Structural Steel Bin Type Retaining Wall (Sh.#3)	1	each

SITUATION PLAN


Sheet 1 of 12 sheets

UTAH STATE ROAD COMMISSION
 SALT LAKE CITY - UTAH
 EZRA C. KNOWLTON, CHIEF ENGINEER
BRIDGE OVER U.P. & L. CO'S PENSTOCKS
 A.W. (P.C.E.) F.A.P. 222-A0
 Sta. 52+50 Weber Co.
 Ogden Arsenal - Riverdale
 DRAWING BY: J.H.B. ISSUED: May 22, 1941
 CHECKED BY: APPROVED: *[Signature]*
 No. 222-A0-12 D-466

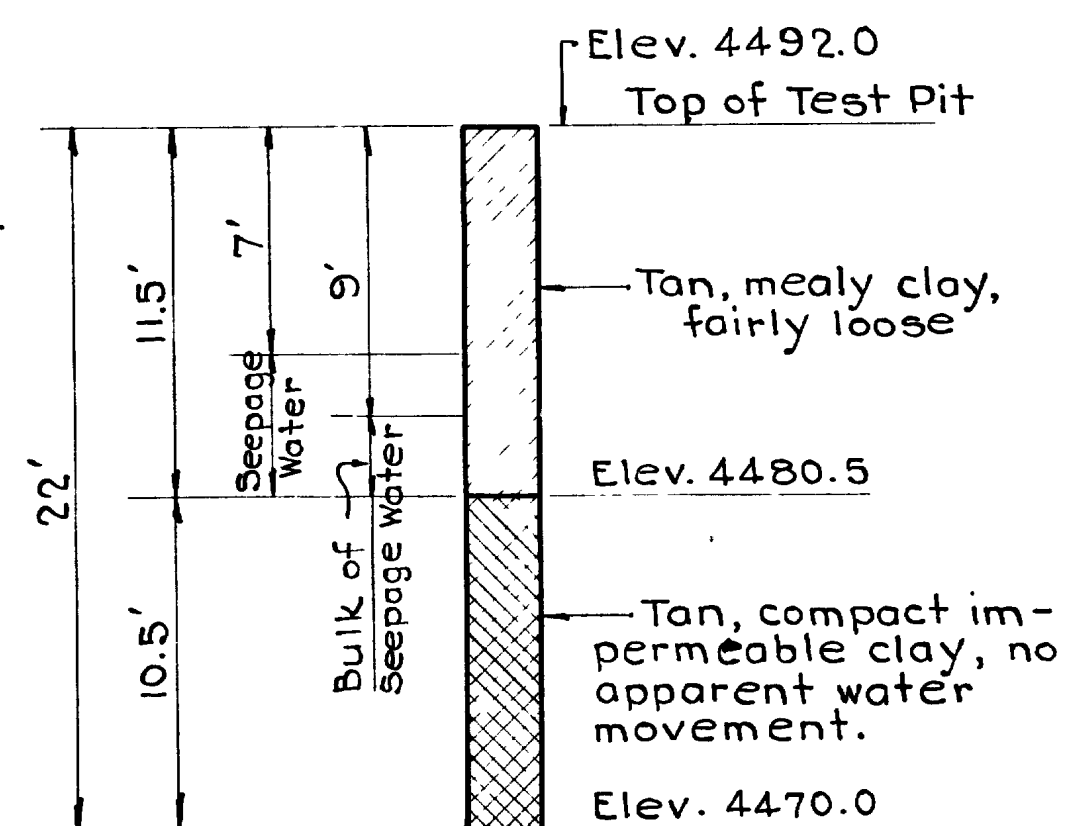




TEST PIT No. 1

(Located 5' Rt. of Sta. 52+48.0)

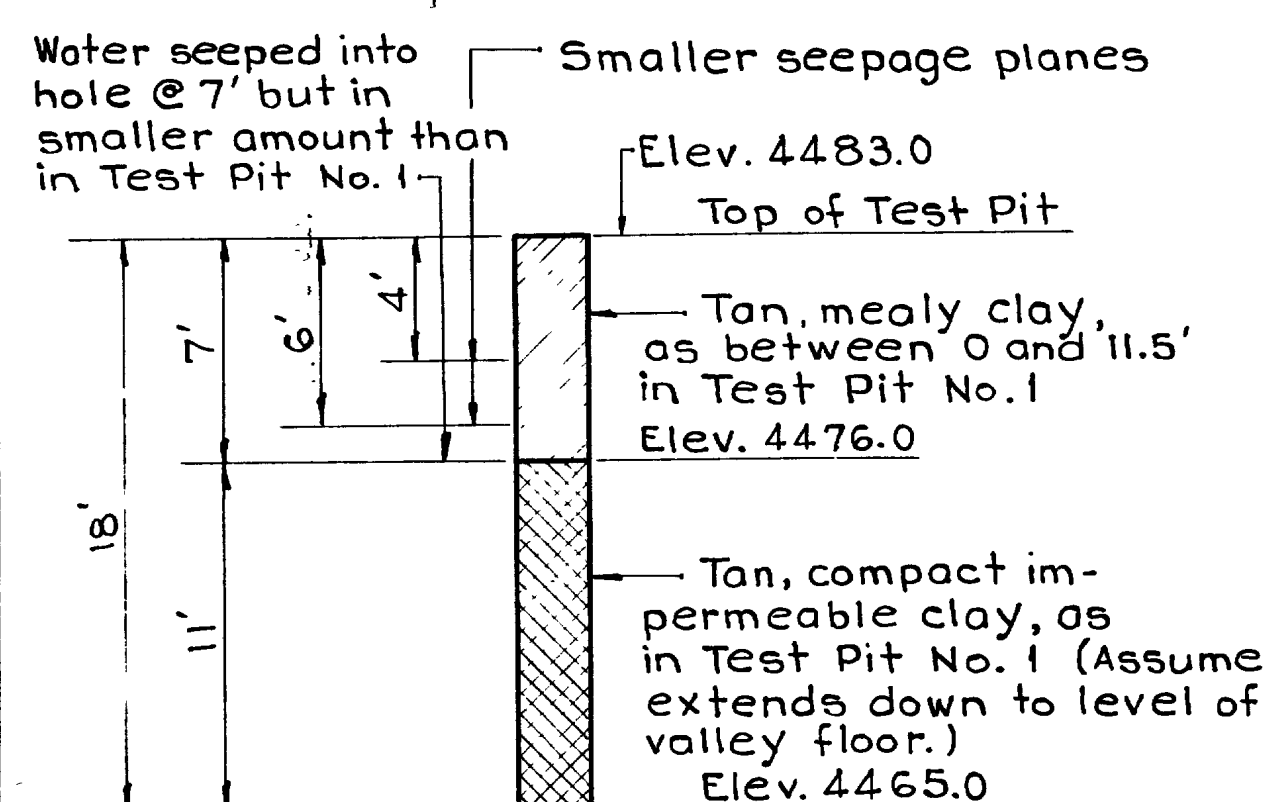

TEST PIT No. 2

(Located 23' Rt. of Sta. 52+48)

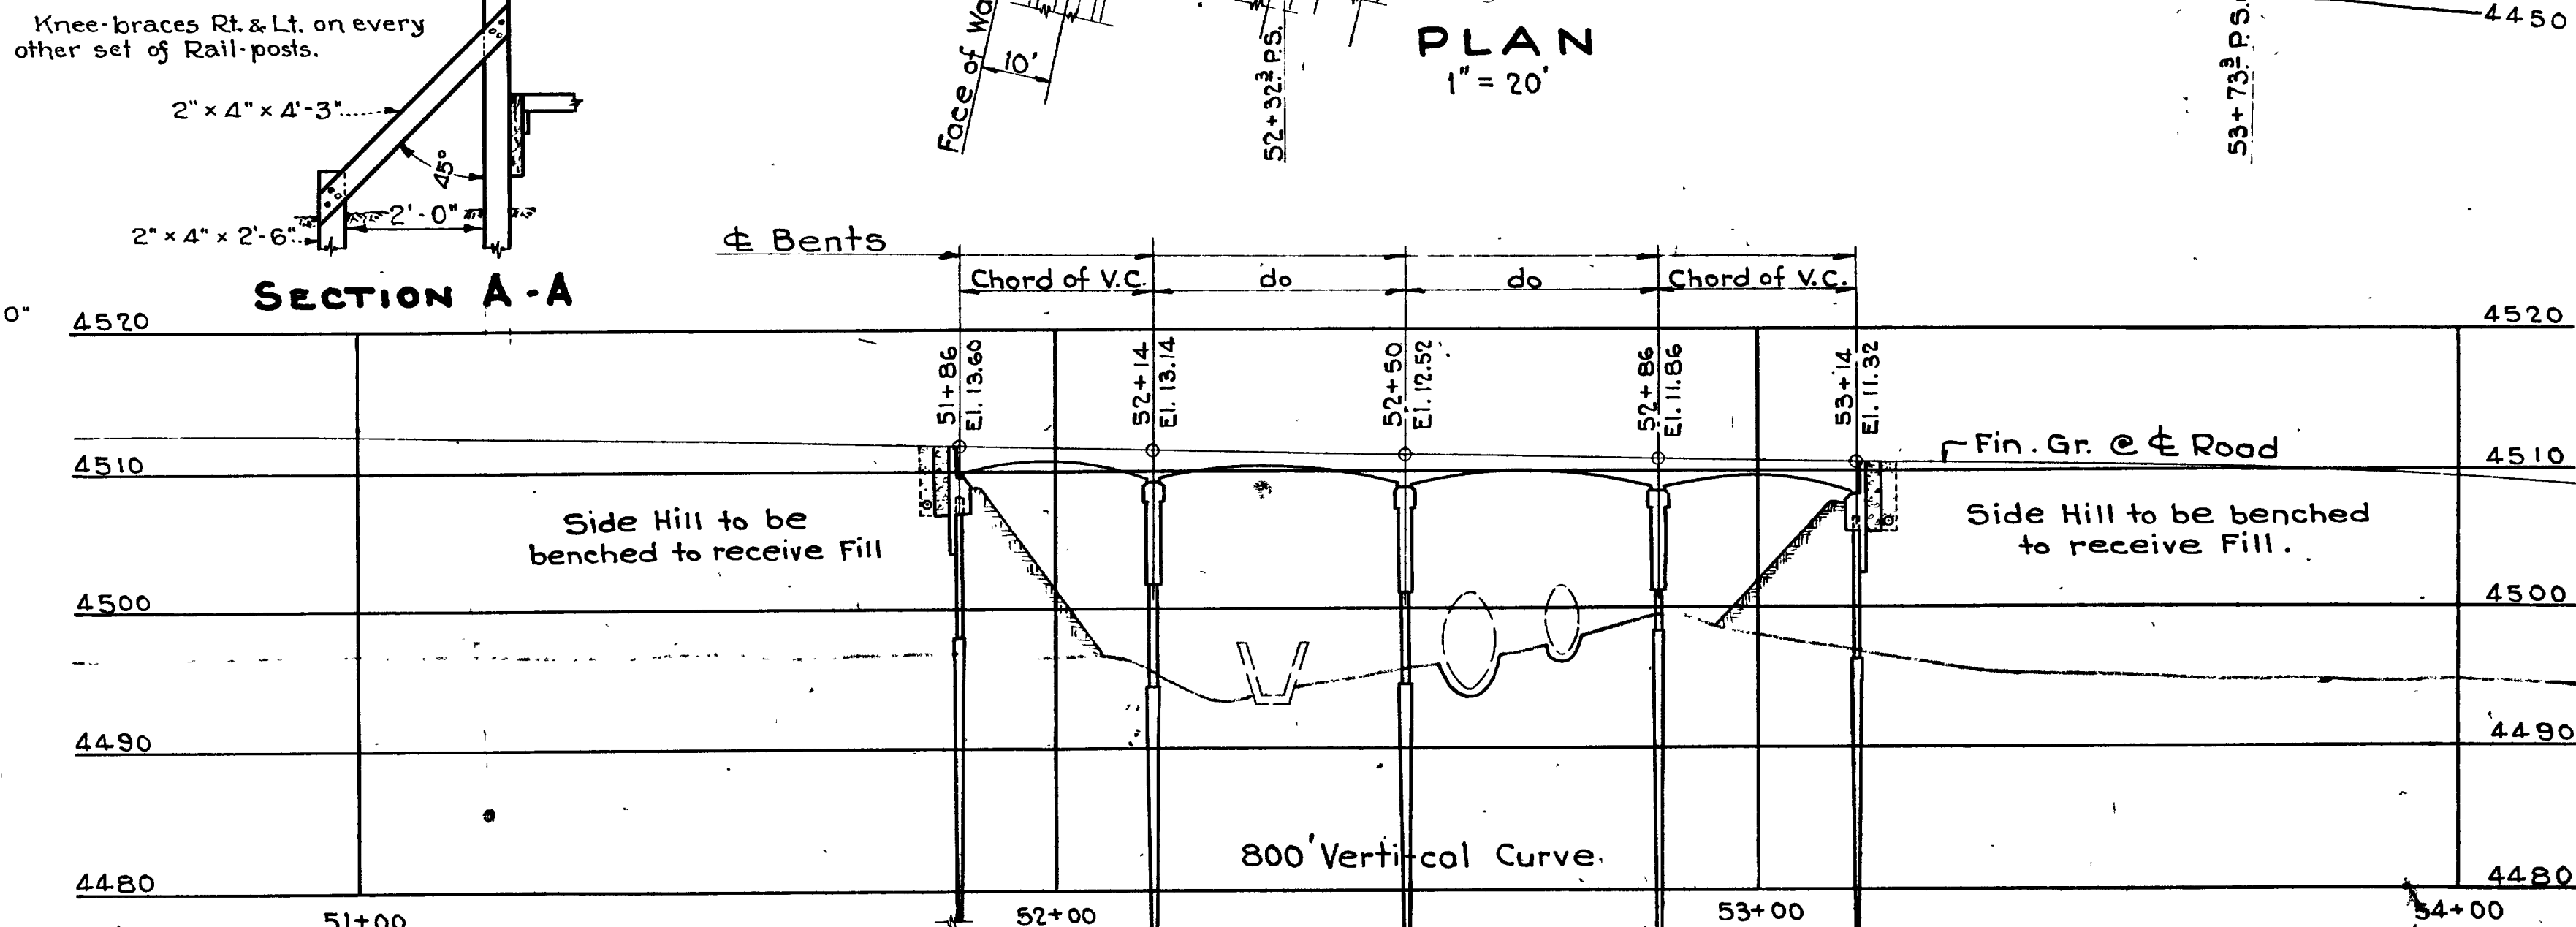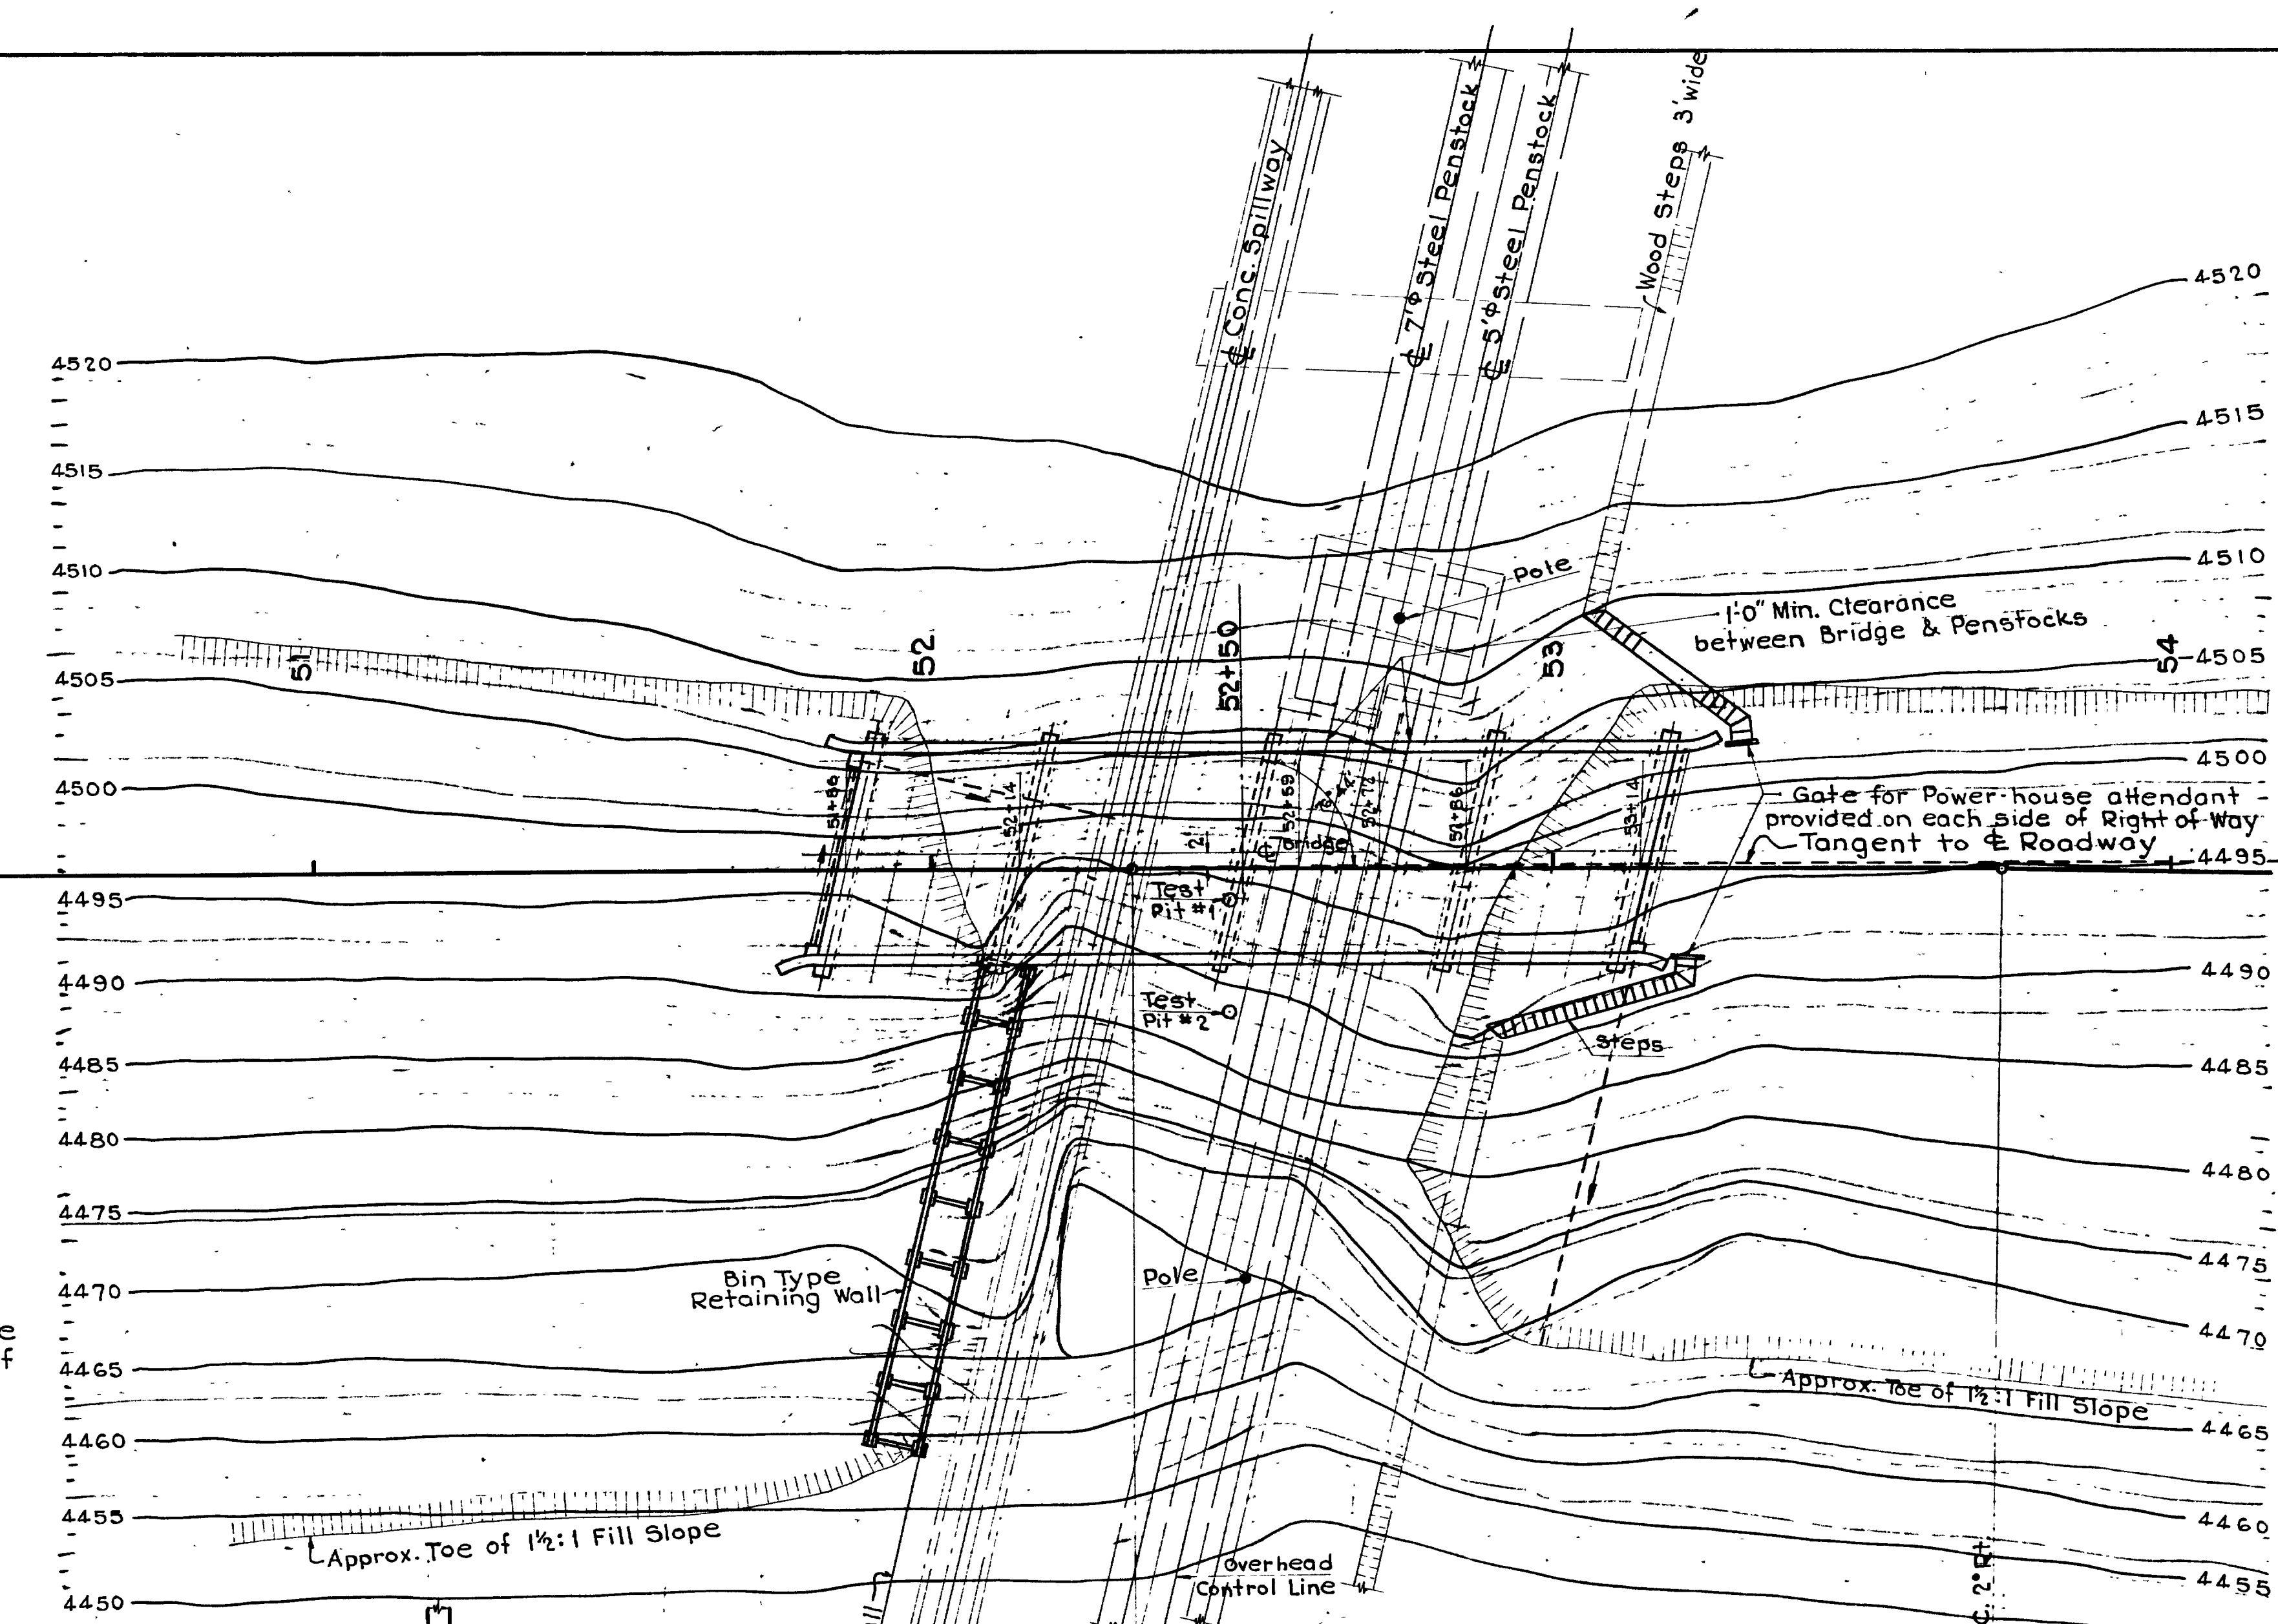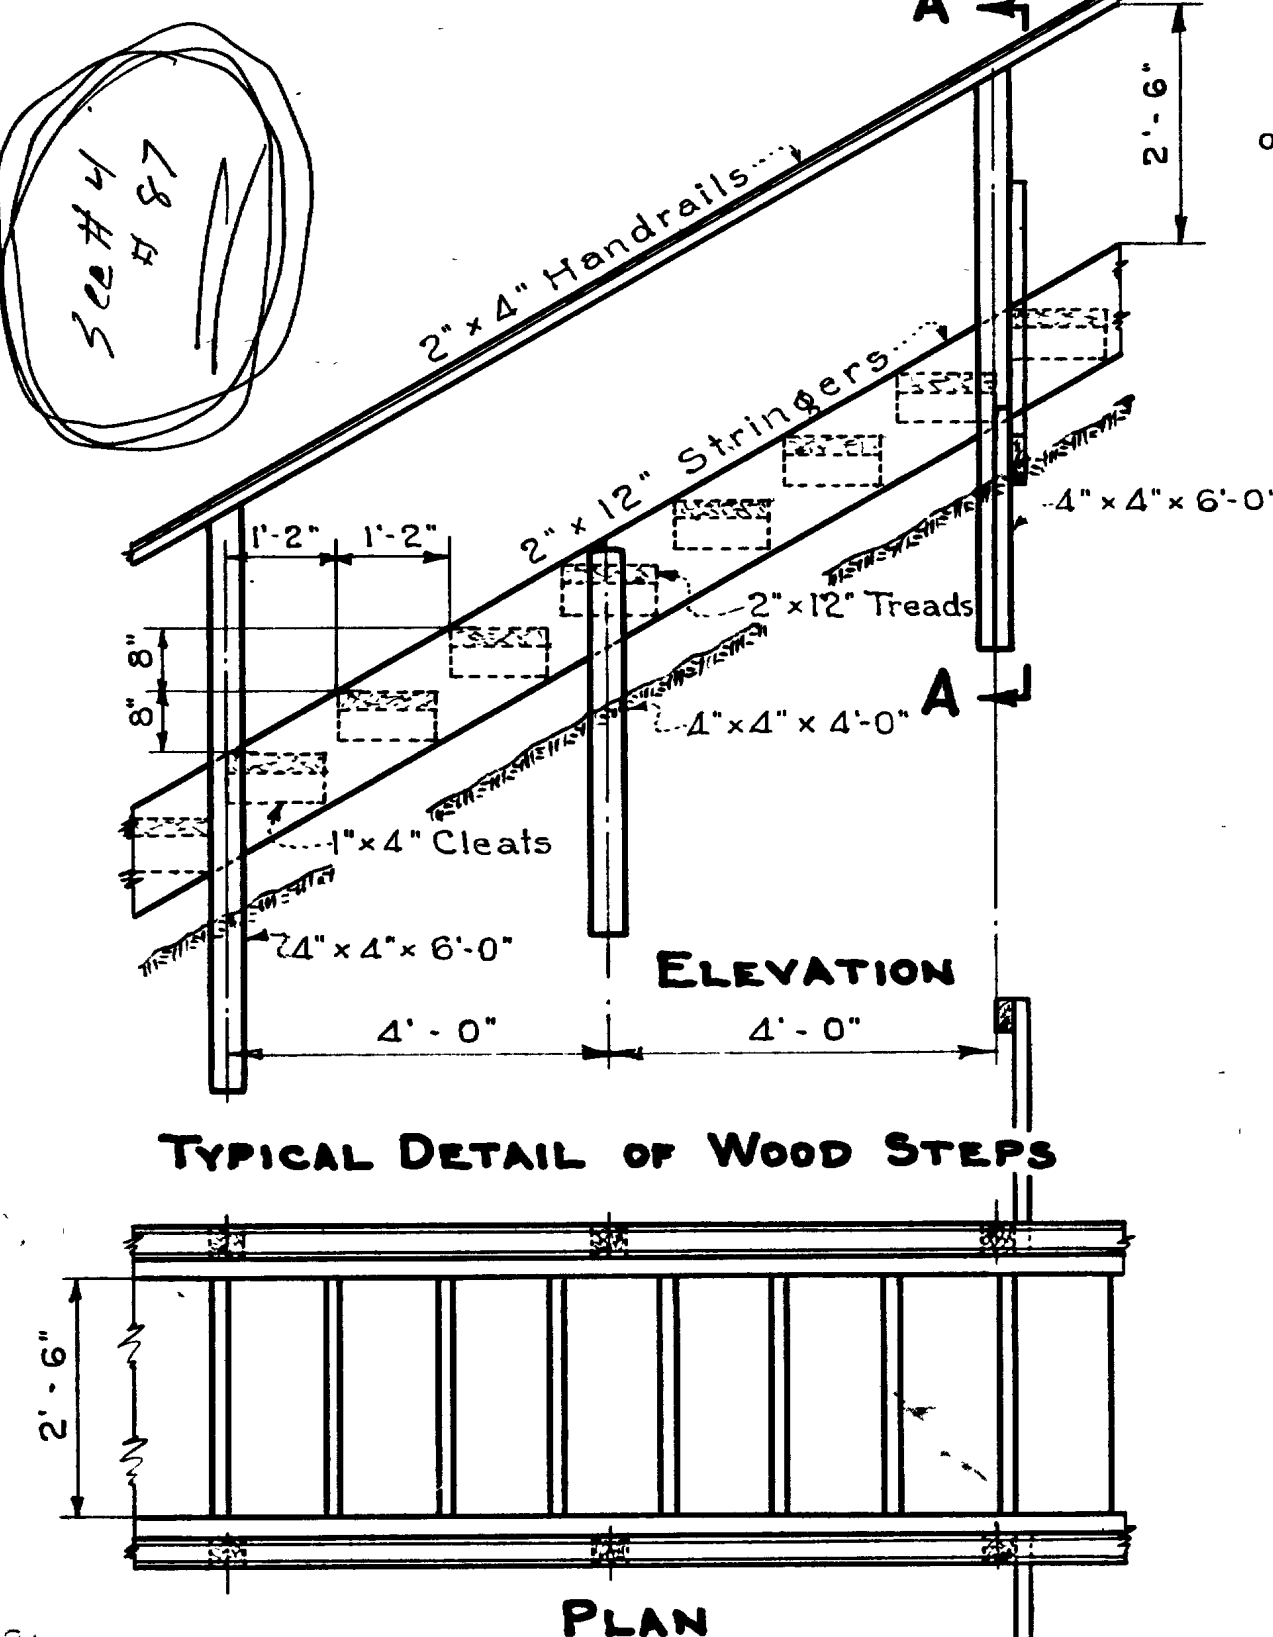

REVISIONS	DATE	BY	CHKD.

FED. ROAD DIST. NO.	STATE	FED. AID PROJ. NO.	FISCAL YEAR	SHEET NO.	TOTAL SHEETS
12	UTAH	272-A0			

GENERAL NOTES

Materials, construction, and workmanship shall be in accordance with State Standard Specifications for Road and Bridge construction, edition of 1939.

NOTE: Before Cast-in Place Pile shells are ordered a Timber test pile should be driven to ascertain the correct length of shell to be ordered.

DESIGN DATA





A.A.S.H.O. Specifications of 1941
 H-15 Loading
 $f_c = 1000 \text{ psi}$ $f_s = 18,000 \text{ psi}$

QUANTITIES

Excav. for Structures	150 Cu. Yds.
Gravel Backfill	21 "
8" C.G.M. Pipe Perforated (1-end plug)	60 Lin. Ft.
8" C.G.M. Pipe Not (2-30"ells)	118 "
18" 7ga. Steel Shell Cast-in-place Conc. Piles	870 "
16" 7ga. " " " " " "	428 "
Structural Steel	1157 Lbs.
Reinforcing Steel	79728 "
Concrete Class "A"	372 Cu. Yds.
Hand Rail (Concrete)	284.25 Lin. Ft.
Wood Stairway Complete as Req'd.	1 each
Structural Steel Bin Type Retaining Wall (5h#3)	1 each


SITUATION PLAN

Sheet 14 of 12 sheets
 UTAH STATE ROAD COMMISSION
 SALT LAKE CITY, UTAH
 ERNA C. KNOWLTON, CHIEF ENGINEER
 BRIDGE OVER U.P. & L.C.S.
 PENSTOCKS
 A.W.(D.C.E.) F.A.P. 222-AM
 Sta. 52+50 Weber Co.
 Ogden Arsenal - River Side
 Approved by: J.H.B. Date: 11-22-40
 D-466

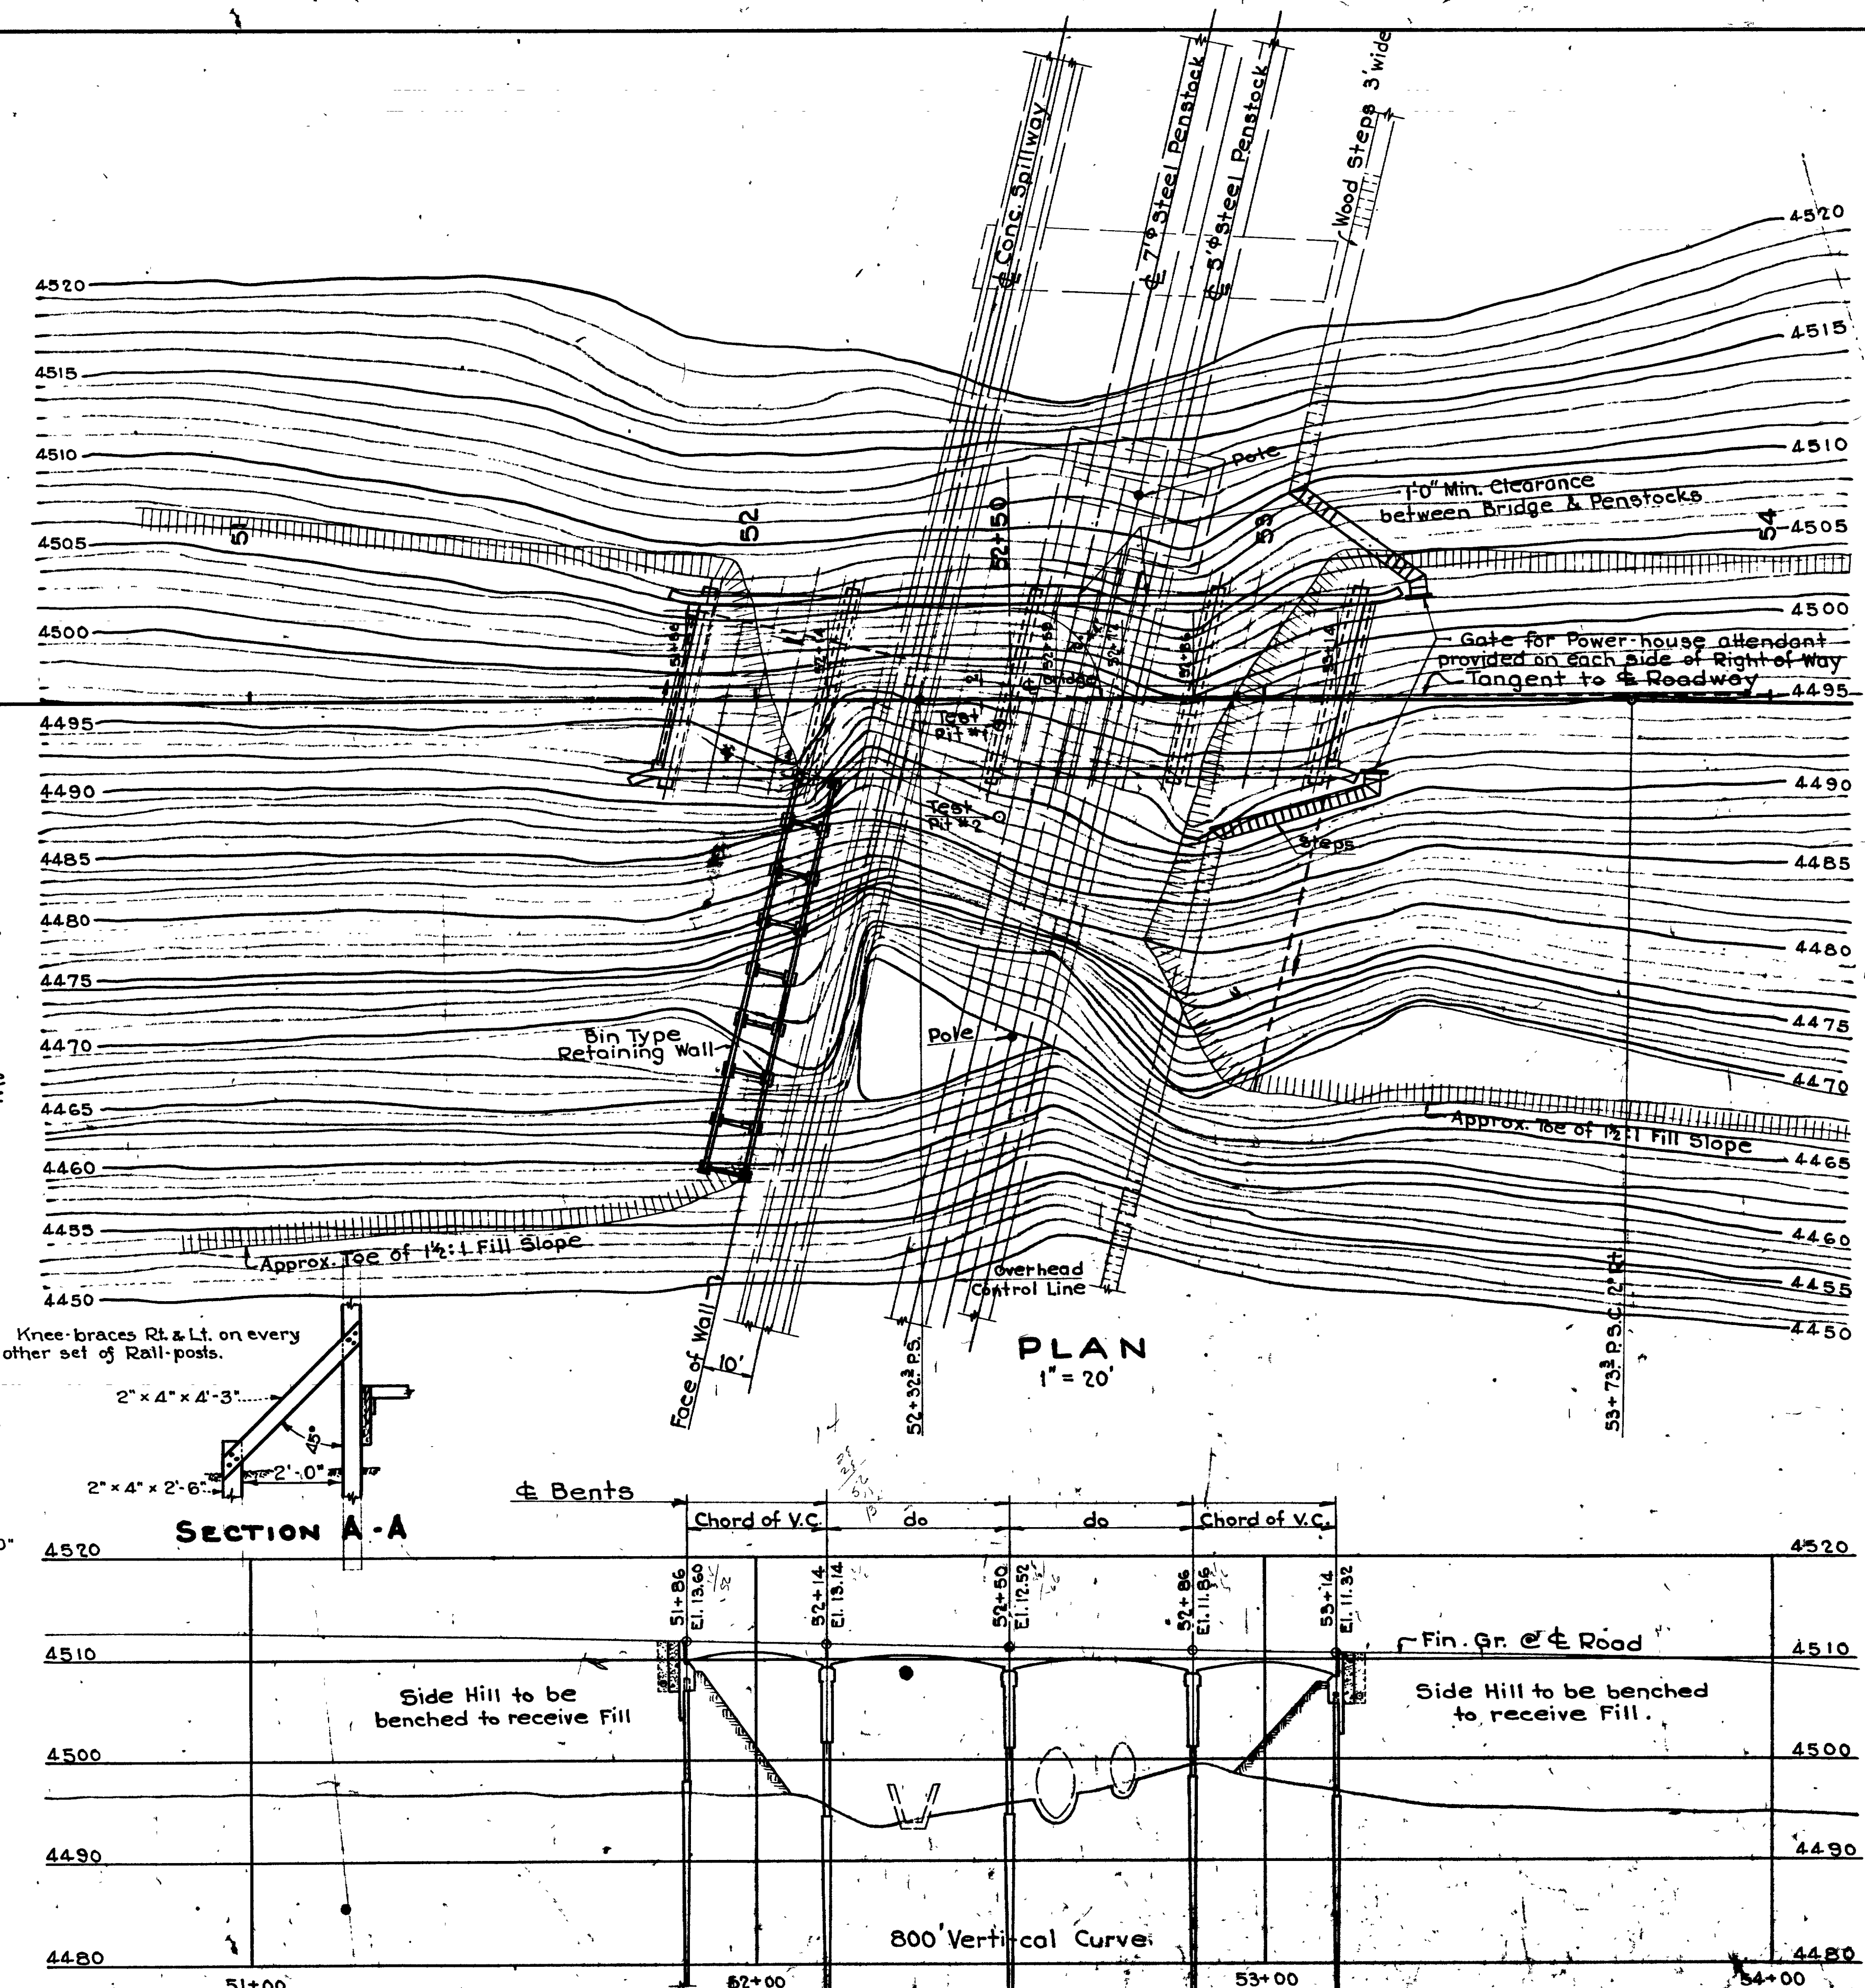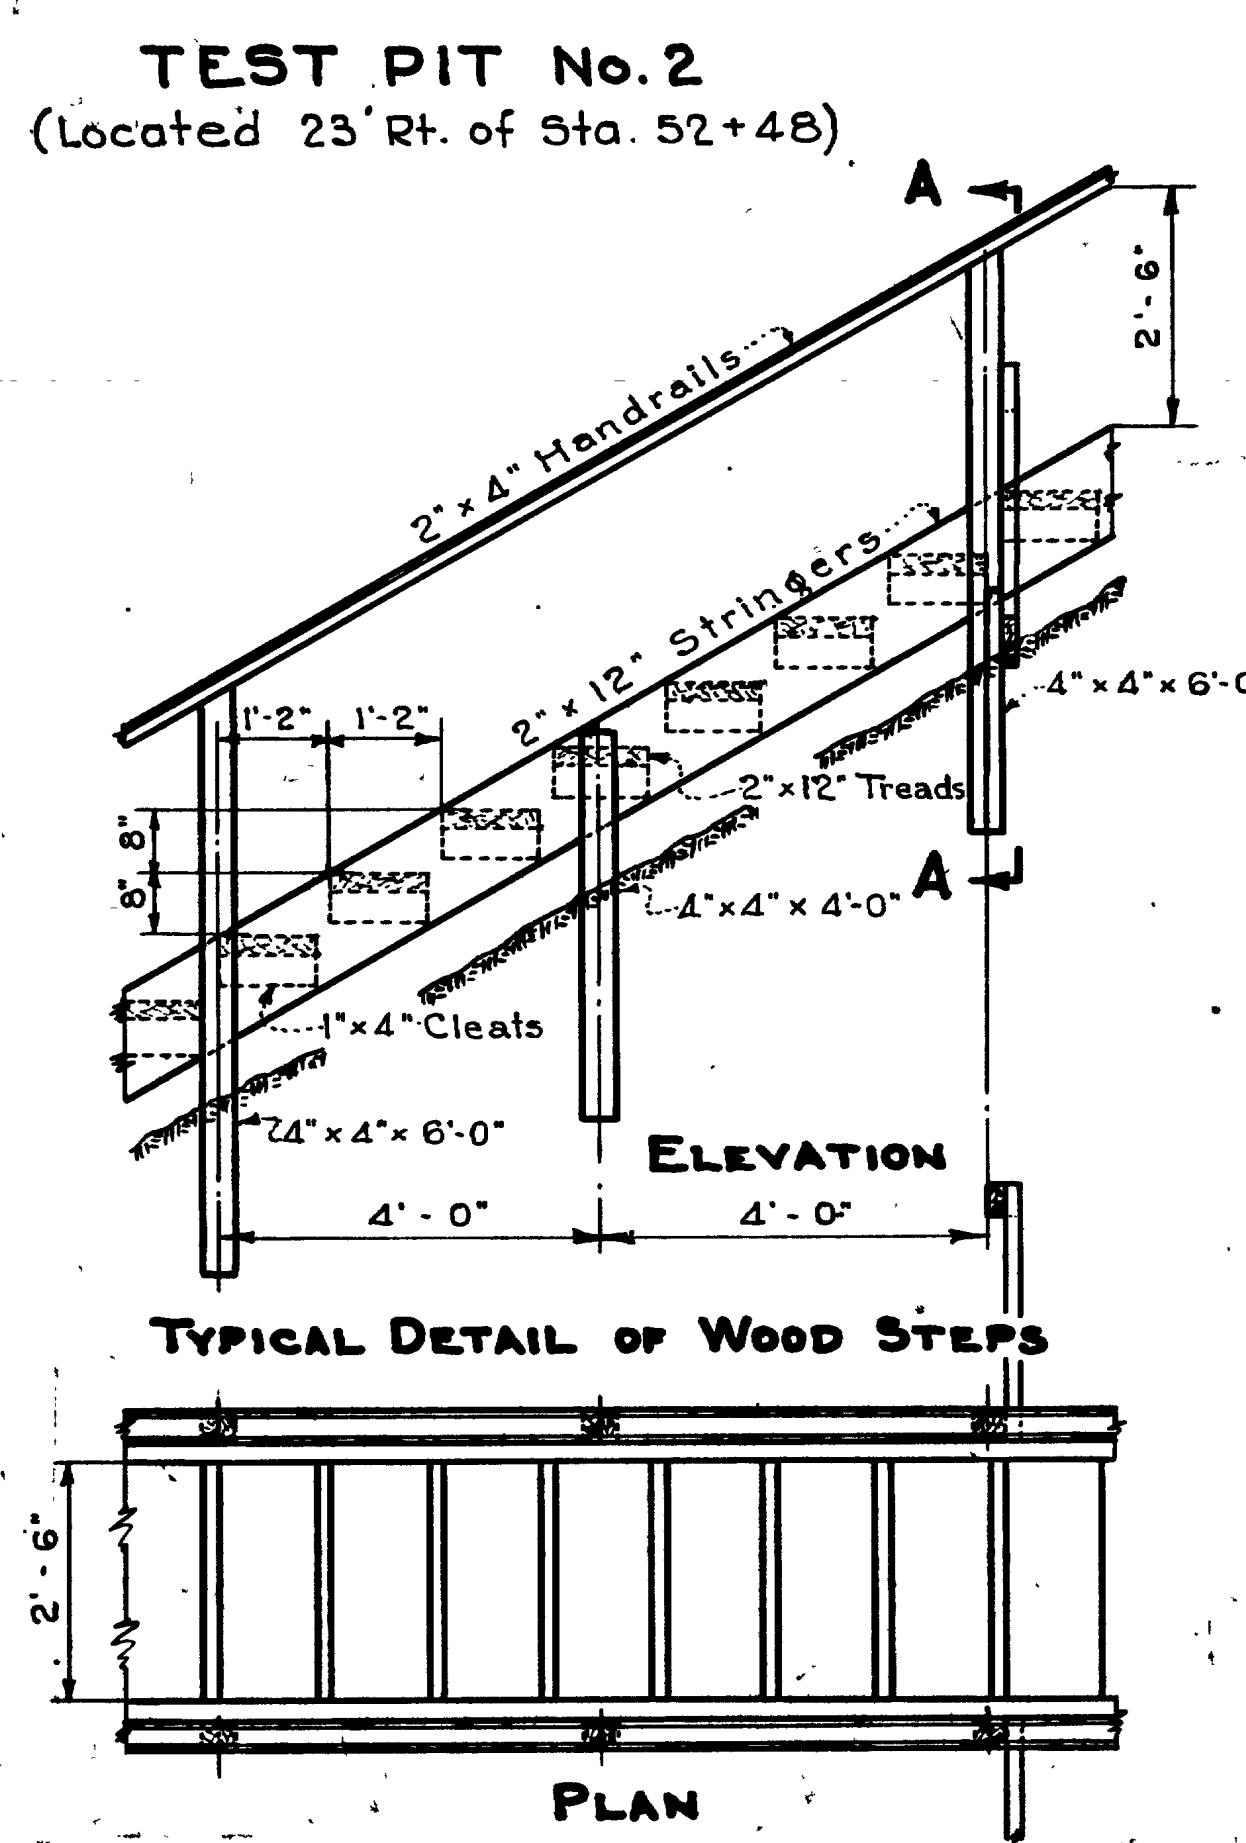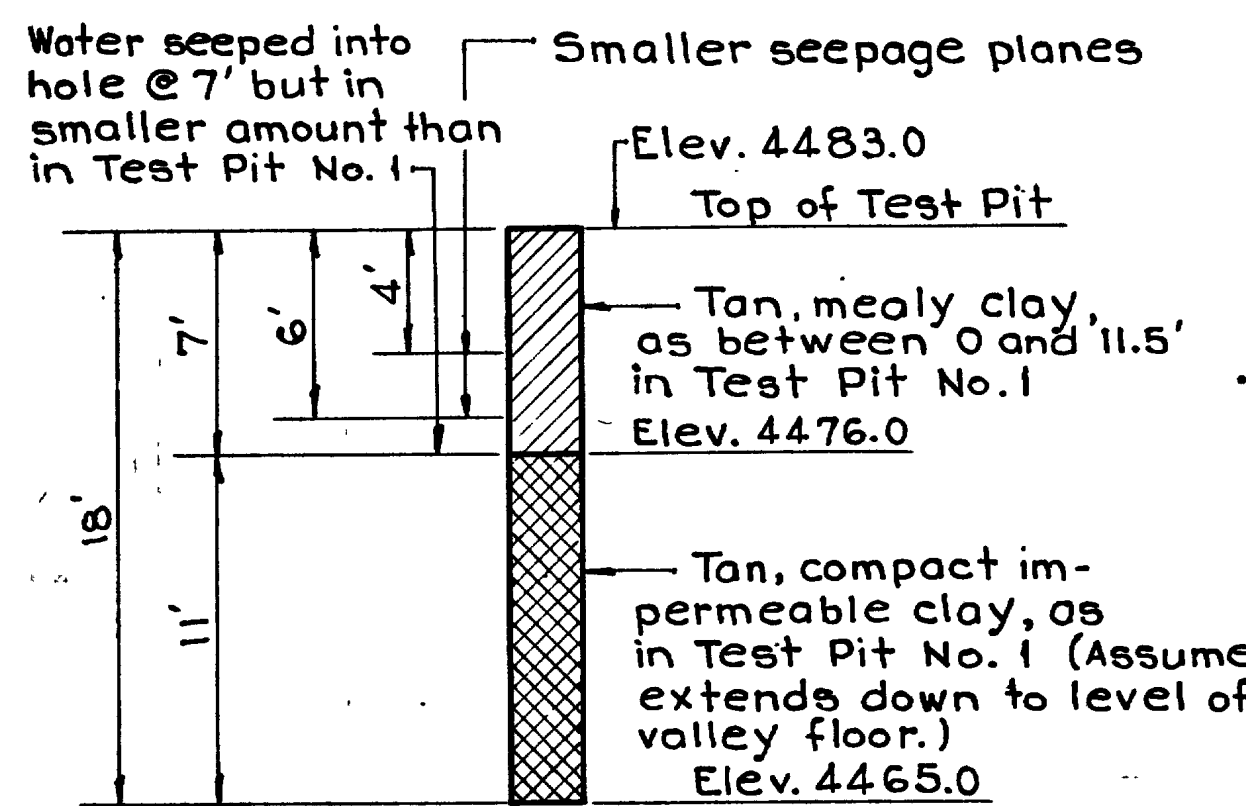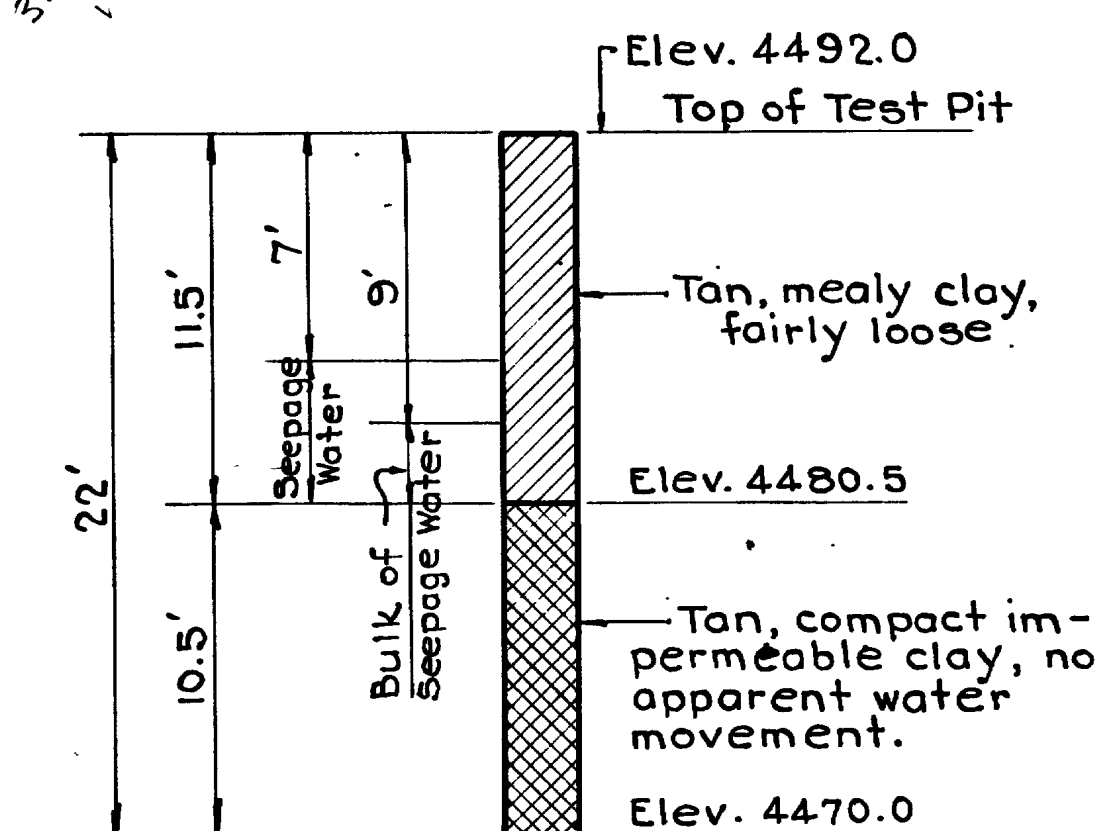

For Superstructure see drawing D-406

FED. ROAD DIST. NO.	STATE	FED. AID PROJ. NO.	FISCAL YEAR	SHEET NO.	TOTAL SHEETS
12	UTAH	222-A0			

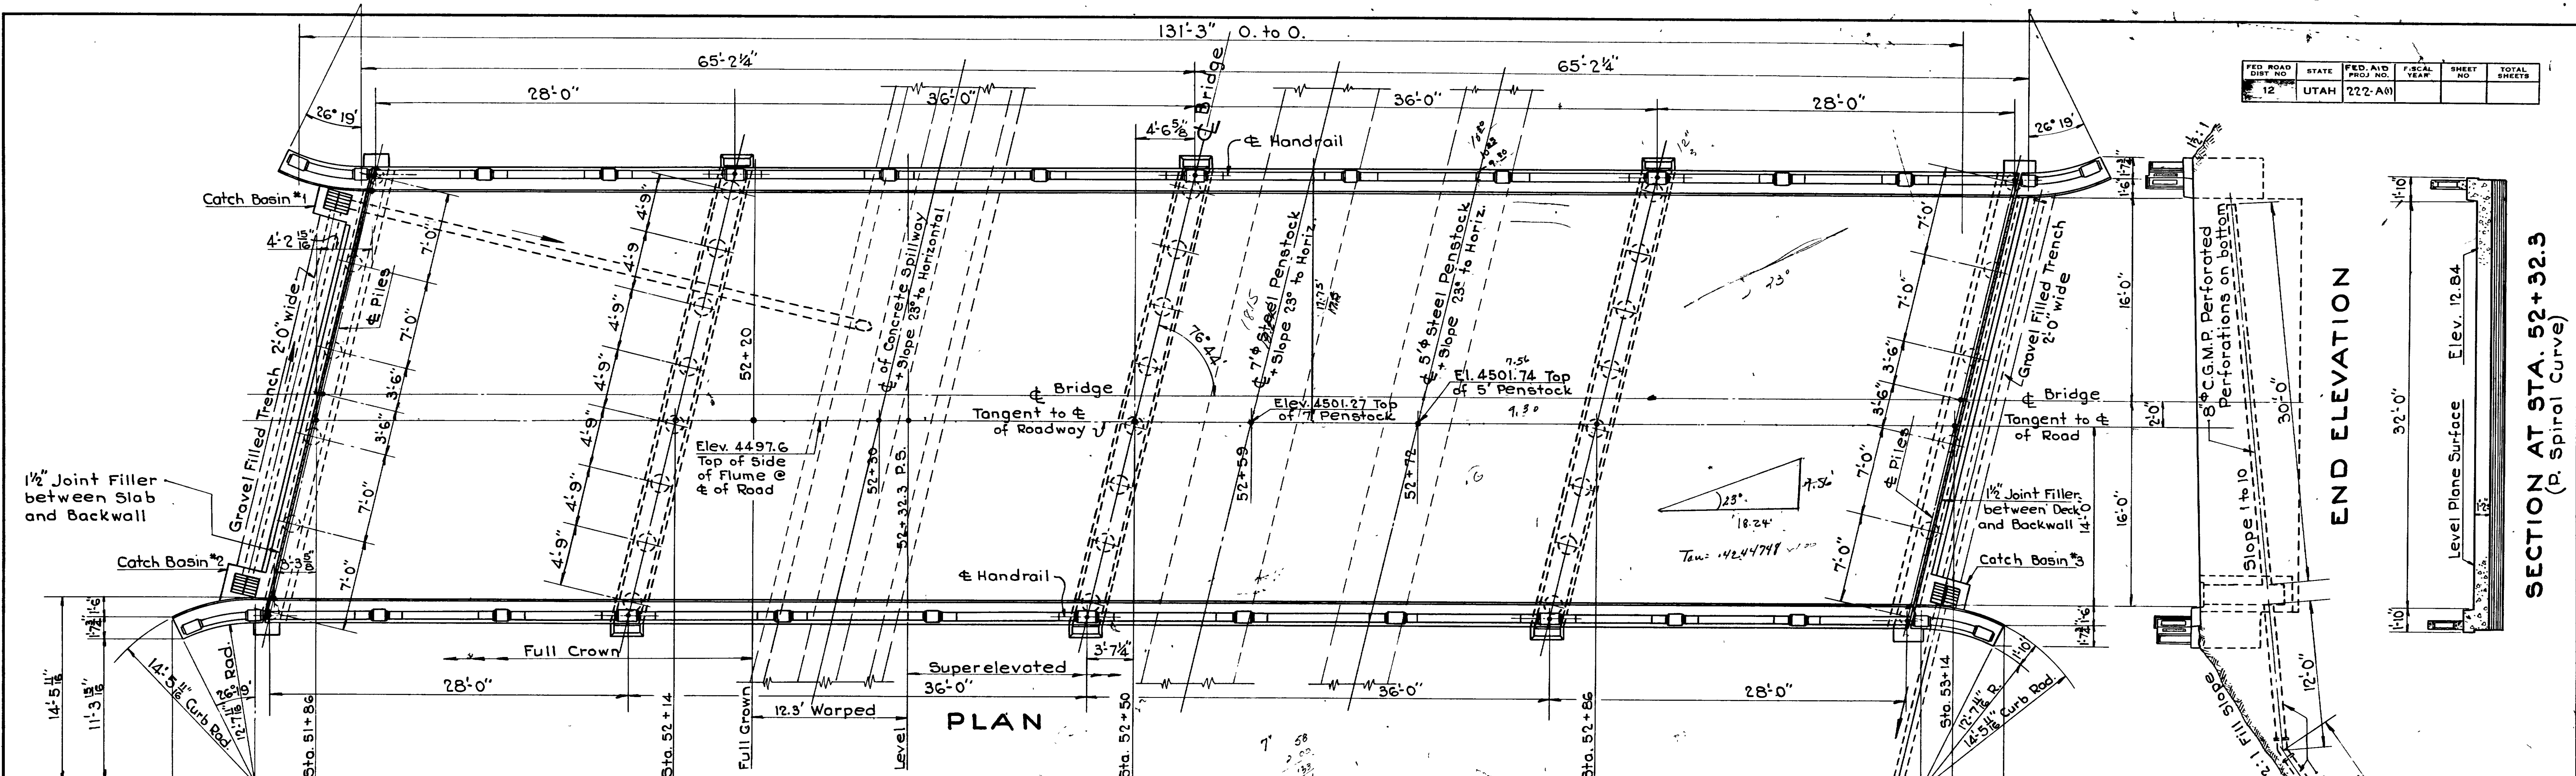


PLAN

END ELEVATION

SECTION AT STA. 52+32.5
(P. Spiral Curve)

REVISIONS	DATE	BY

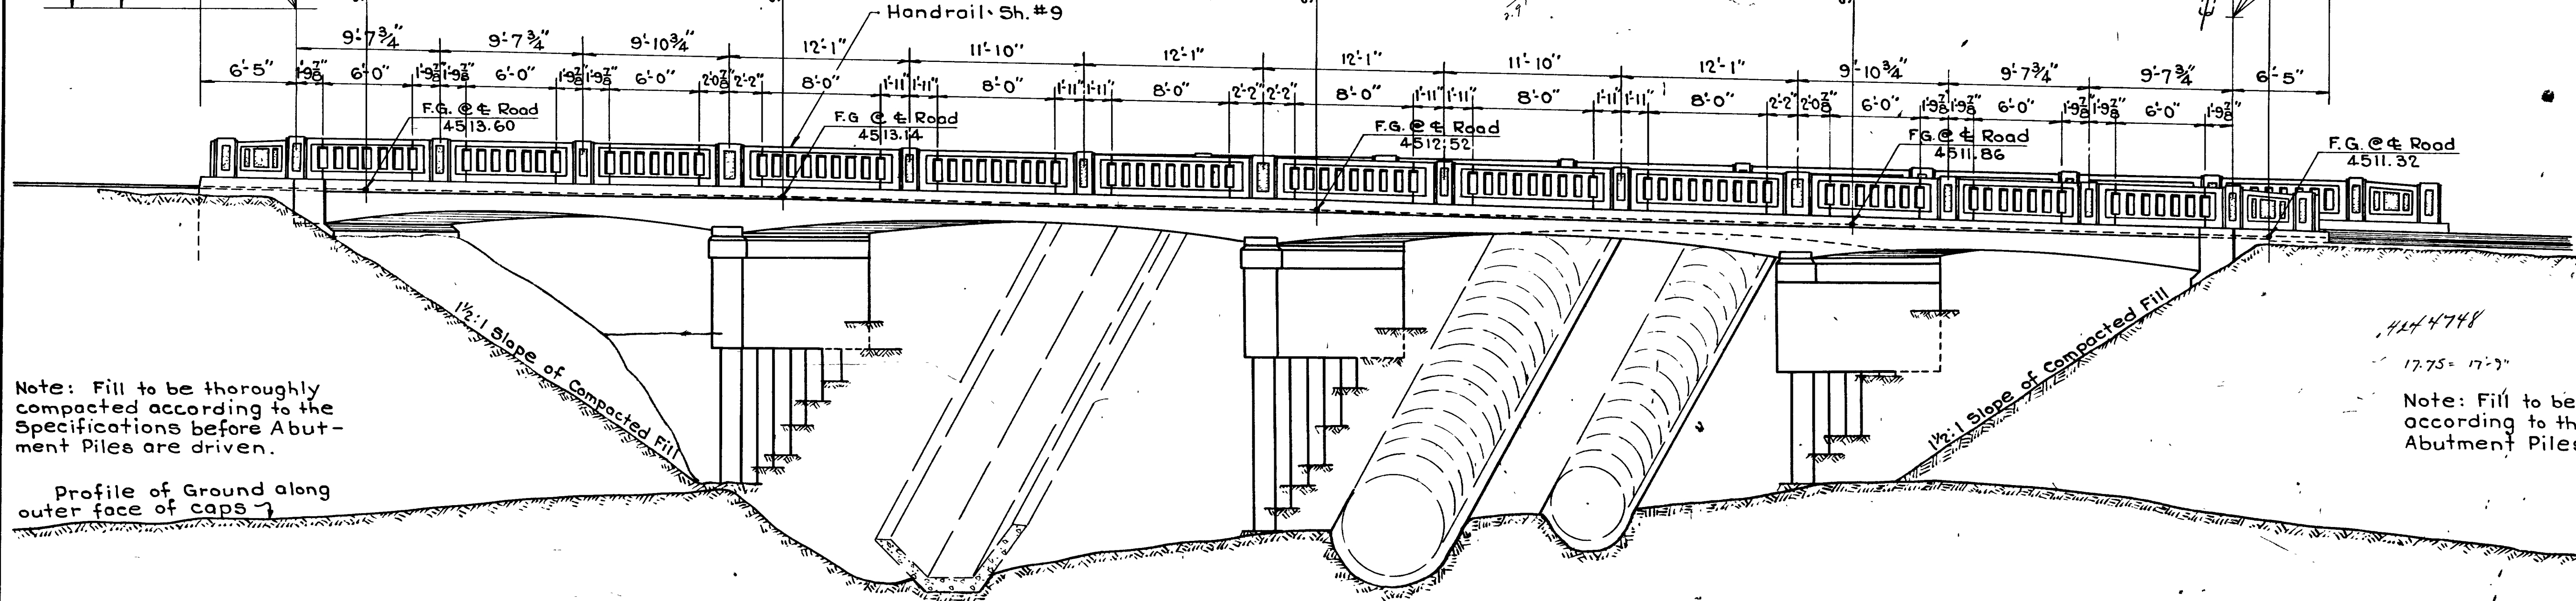

SIDE ELEVATION

Note: Fill to be thoroughly compacted according to the Specifications before Abutment Piles are driven.

Note: Fill to be thoroughly compacted according to the Specifications before Abutment Piles are driven.

GENERAL DRAWING


Sheet 2 of 12 sheets

UTAH STATE ROAD COMMISSION
SALT LAKE CITY - UTAH
EZRA C. KNOWLTON, CHIEF ENGINEER


BRIDGE OVER U.P. & L. CO'S
PENSTOCKS
A.W. (P.C.E.) F.A.P. 222-A0
Sta. 52+50 Weber Co.
Ogden Arsenal - Riverdale

DESIGNED BY: F.M.E. SCALE: 1" = 6'-0"
DRAWN BY: J.H.B. CHECKED BY: J.H.B.
APPROVED BY: J.H.B. DATE: May 23, 1944

22-259-12 D-466

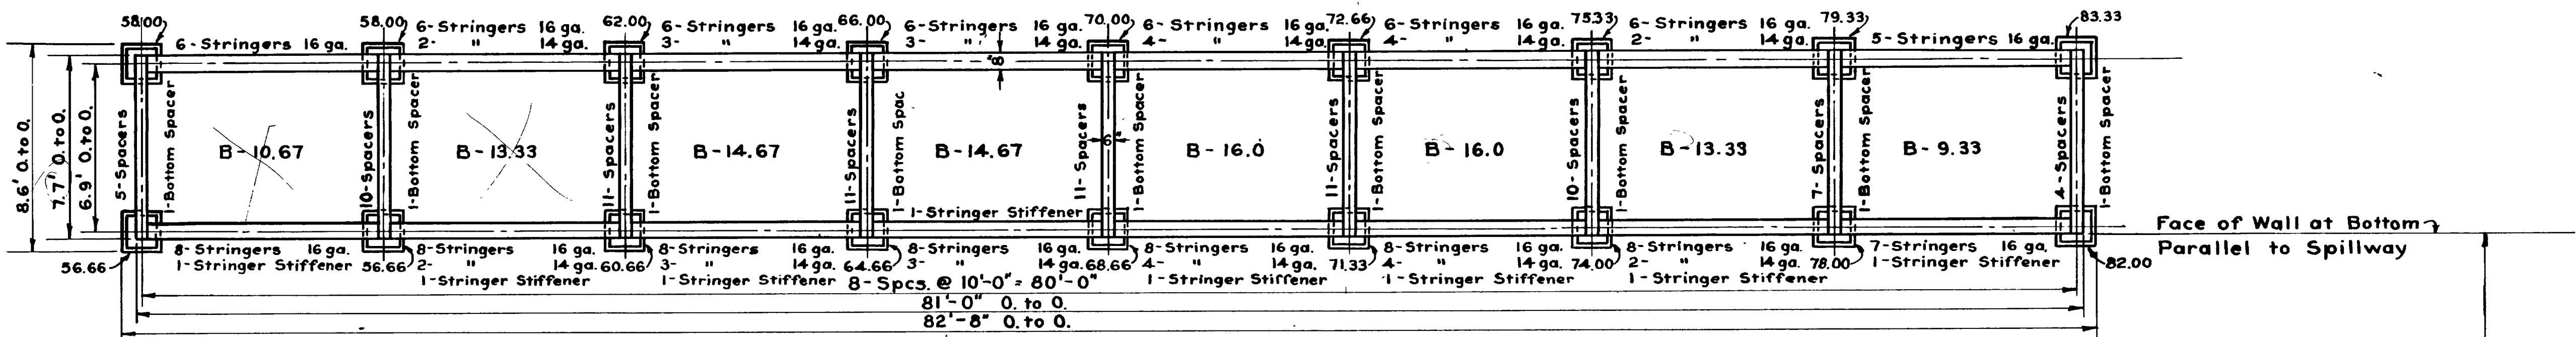

FOUNDATION PLAN DESIGN "B"
 $\frac{1}{4} = 1'-0"$

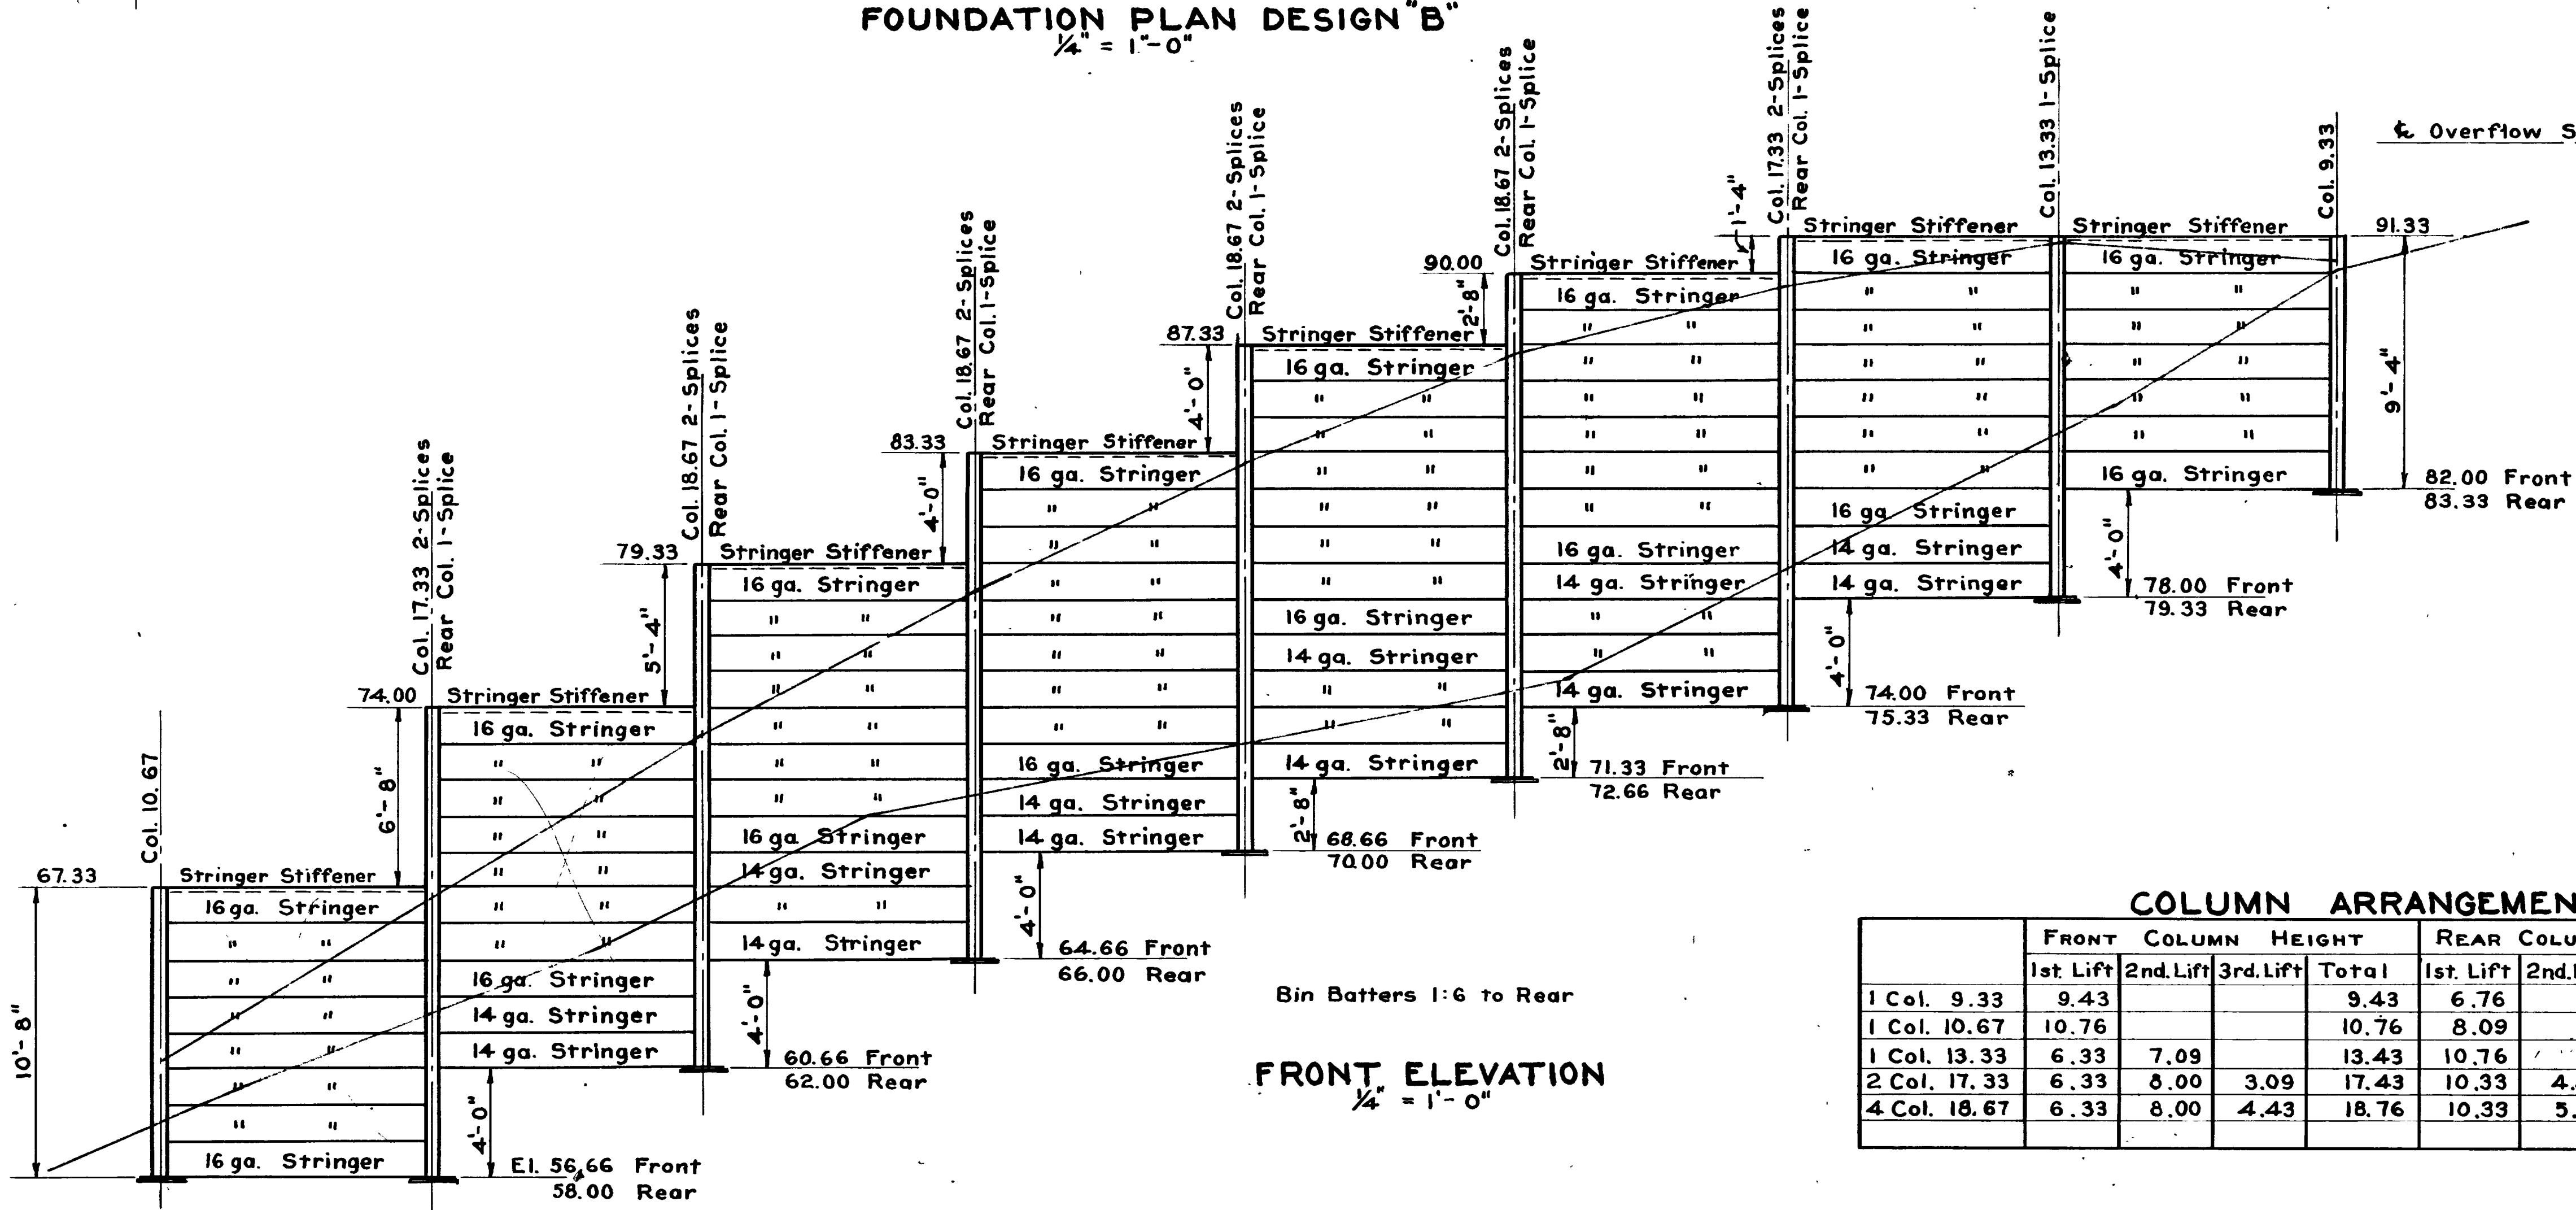


FRONT ELEVATION
 $\frac{1}{4} = 1'-0"$

COLUMN ARRANGEMENT

	FRONT COLUMN HEIGHT			REAR COLUMN HEIGHT			FRONT & REAR COLUMN HEIGHT	
	1st Lift	2nd Lift	3rd Lift	1st Lift	2nd Lift	Total		
1 Col. 9.33	9.43			9.43	6.76	6.76	16.19 x 1 = 16.19	
1 Col. 10.67	10.76			10.76	8.09	8.09	18.85 x 1 = 18.85	
1 Col. 13.33	6.33	7.09		13.43	10.76	10.76	24.19 x 1 = 24.19	
2 Col. 17.33	6.33	8.00	3.09	17.43	10.33	4.43	14.76	32.19 x 2 = 64.38
4 Col. 18.67	6.33	8.00	4.43	18.76	10.33	5.76	16.09	34.85 x 4 = 139.40
								Total = 263.01

MATERIAL LIST

110 - Stringers	16 ga. x 9.5'
36 - Stringers	14 ga. x 9.5'
80 - Spacers	16 ga. x 7.4'
9 - Bottom Spacers	16 ga. x 7.4'
8 - Stringer Stiffeners	8 ga. x 9.5'
9 - Column Caps	12 ga.
19 - Column Splices	14 ga.
18 - Bearing Plates	16" x 16" x 1 ga.
18 - Bearing Plates	20" x 20" x 1 ga.
263 - Lin. Ft. Columns	8 ga.

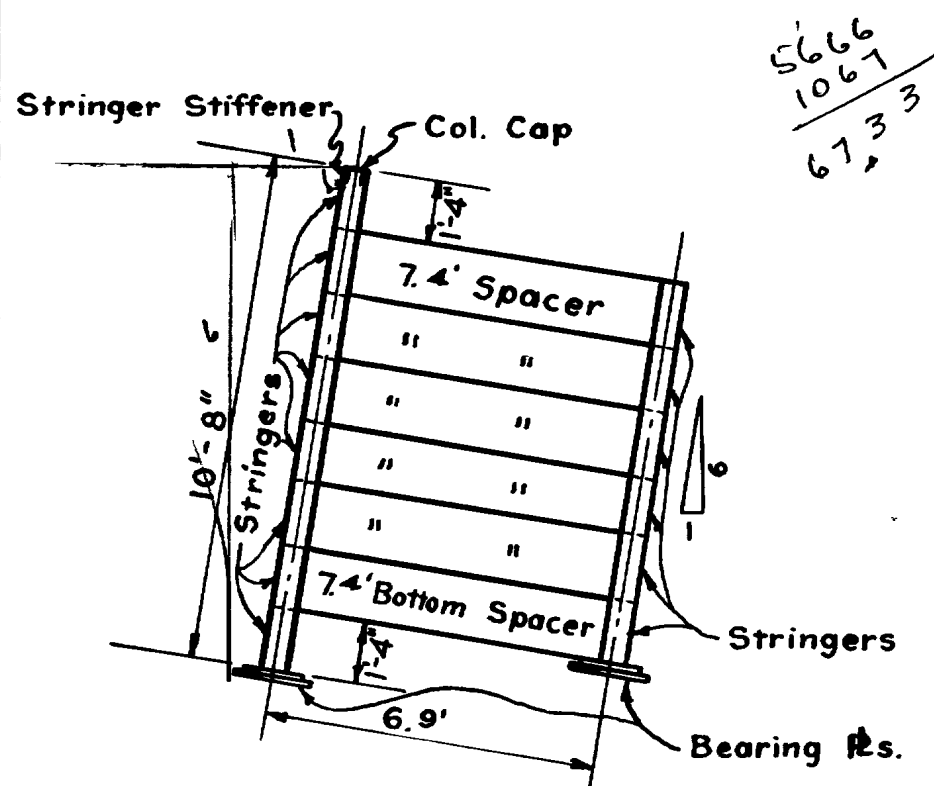

SECTION B 10.67
 TYPICAL OF ALL SECTIONS

RETAINING WALL

Sheet 3 of 12 sheets





UTAH STATE ROAD COMMISSION
 SALT LAKE CITY - UTAH
 ESRA C. KNOWLTON, CHIEF ENGINEER

**BRIDGE OVER U.P. & L. CO'S
 PENSTOCKS
 A.W.(P.C.E.) F.A.P. 222-A0
 Sta. 52+50. Weber Co.
 Ogden Arsenal-Riverdale**

DESIGNED BY: F.M.E. SCALE: AS SHOWN
 DRAWN BY: F.M.E. ISSUED: 2/28/42
 CHECKED BY: [Signature] APPROVED: [Signature]
 EXAMINED BY: [Signature] DATE: 2/28/42

No. 19-258-12 Dwg No. **D-466**

FED. ROAD DIST. NO.	STATE	FED. AID PROJ. NO.	FISCAL YEAR	SHEET NO.	TOTAL SHEETS
12	UTAH	222-A(0)			

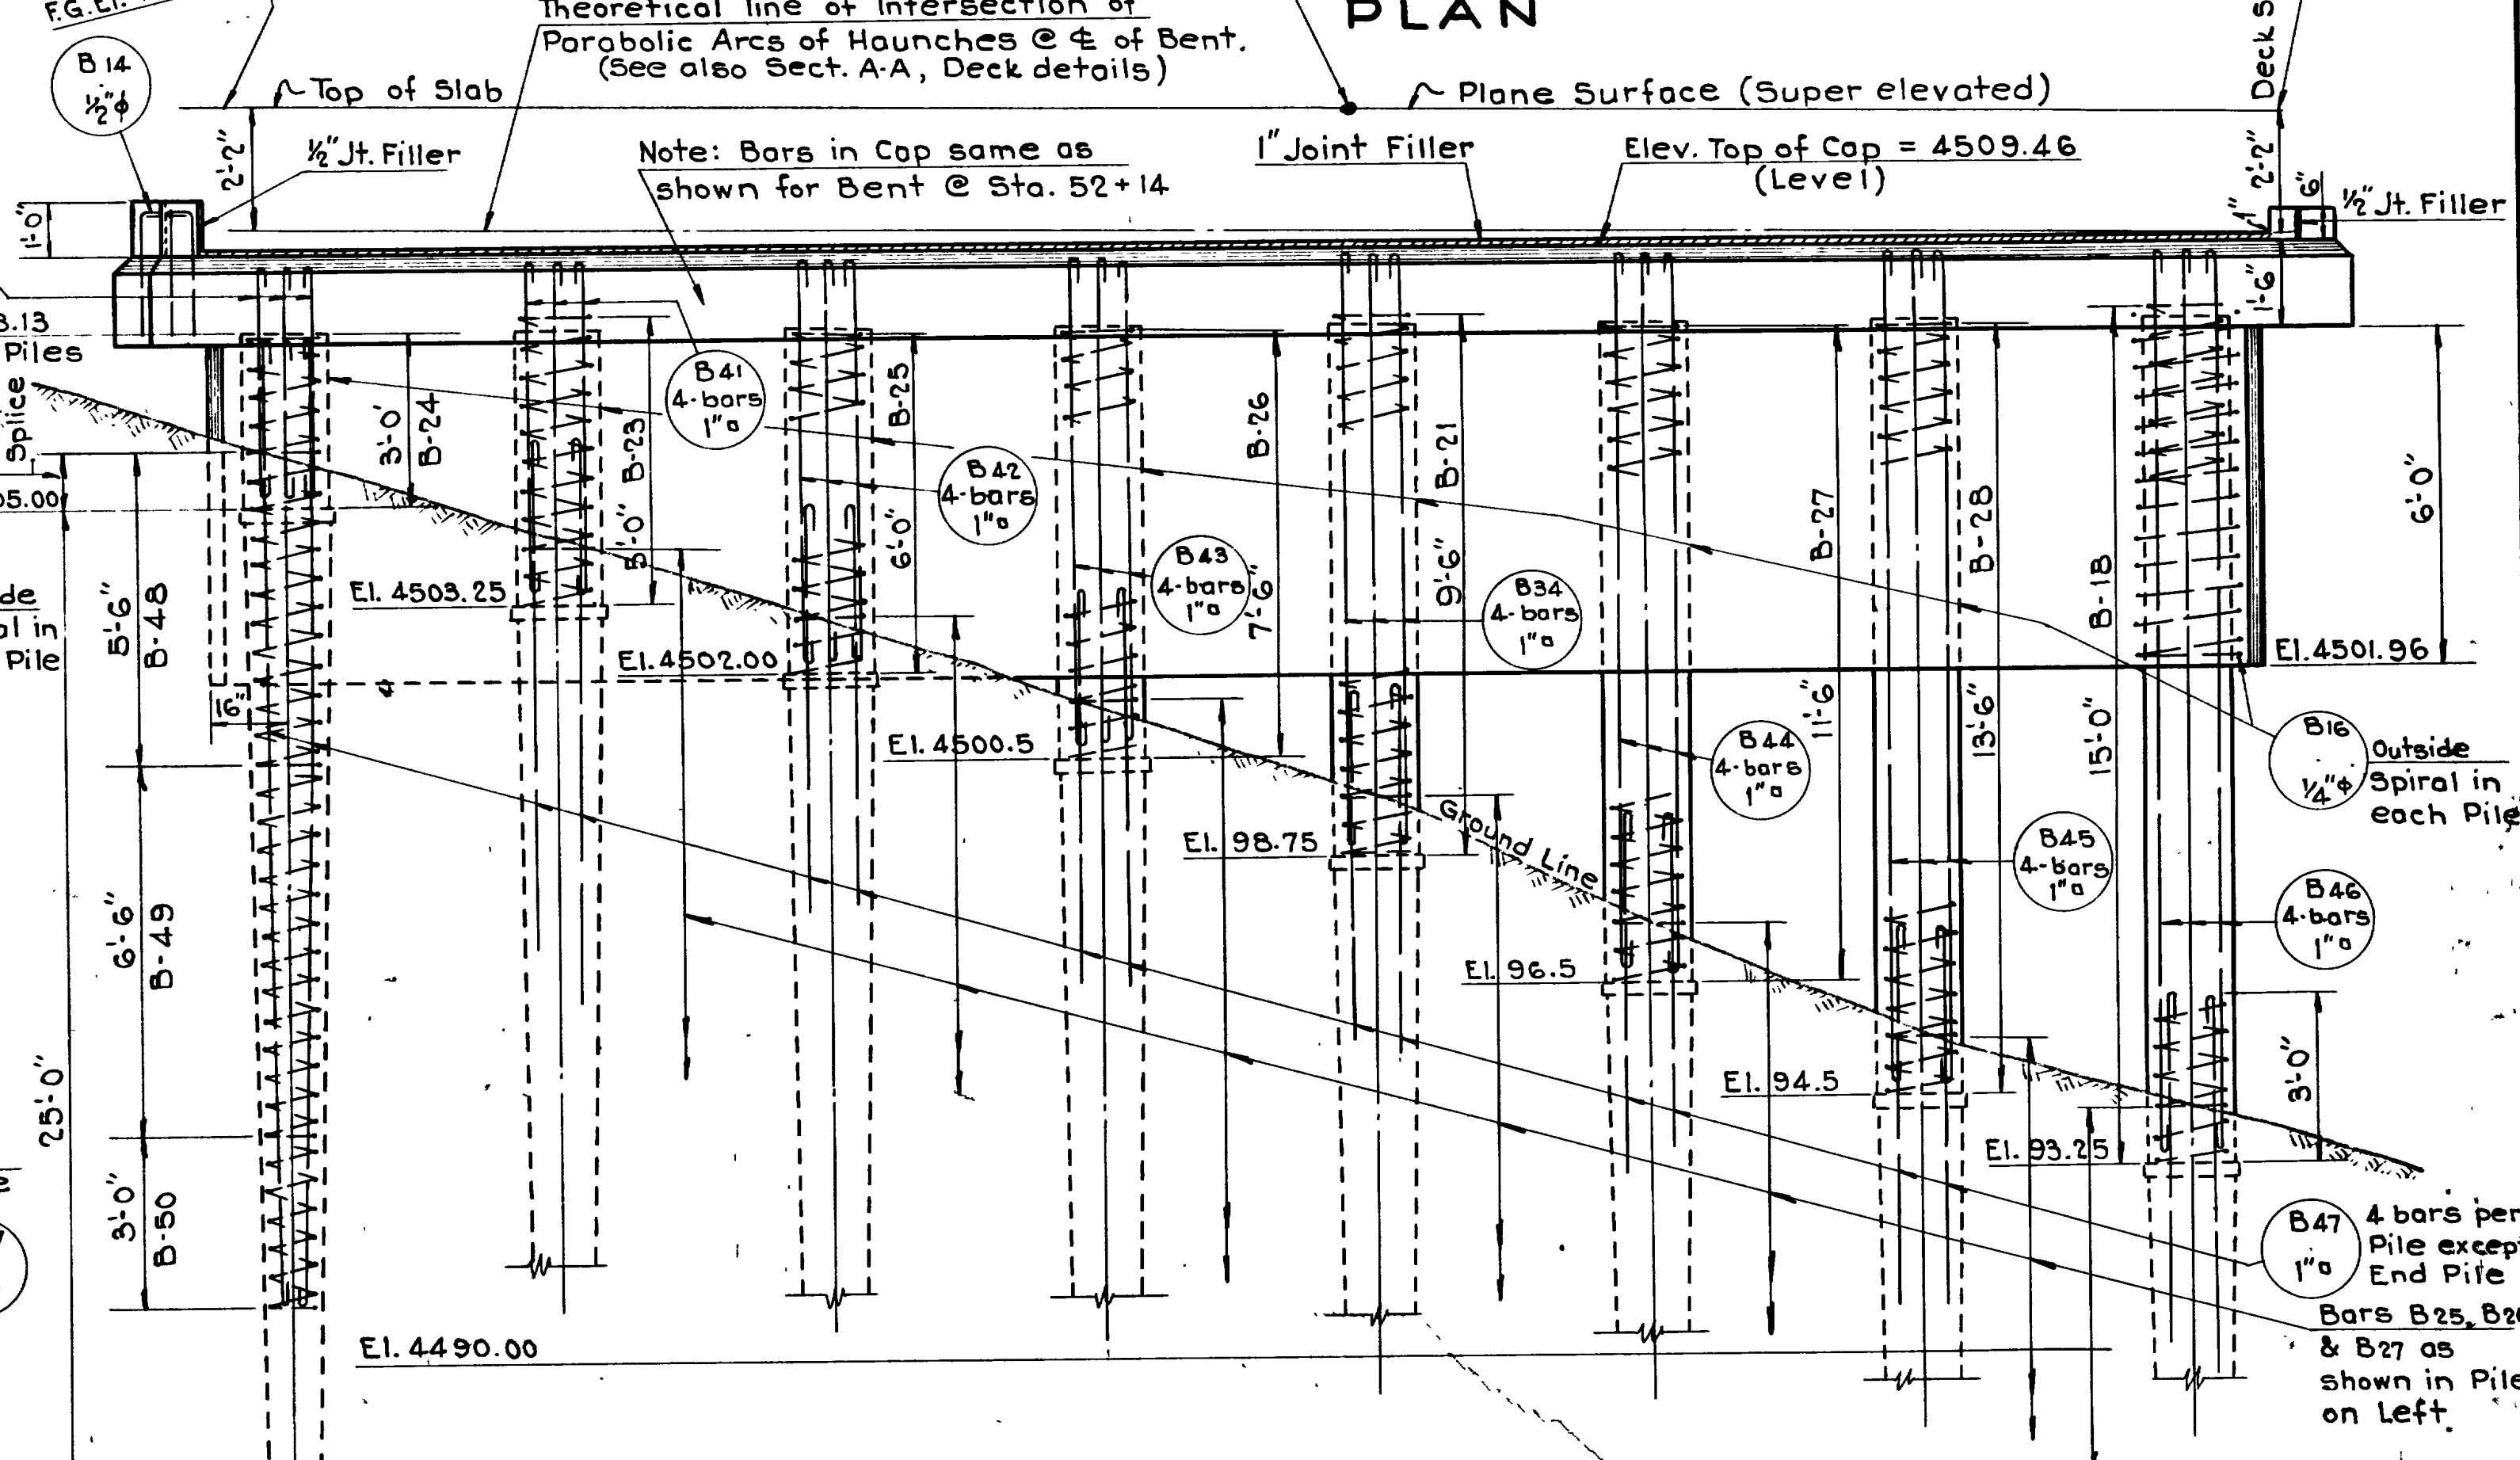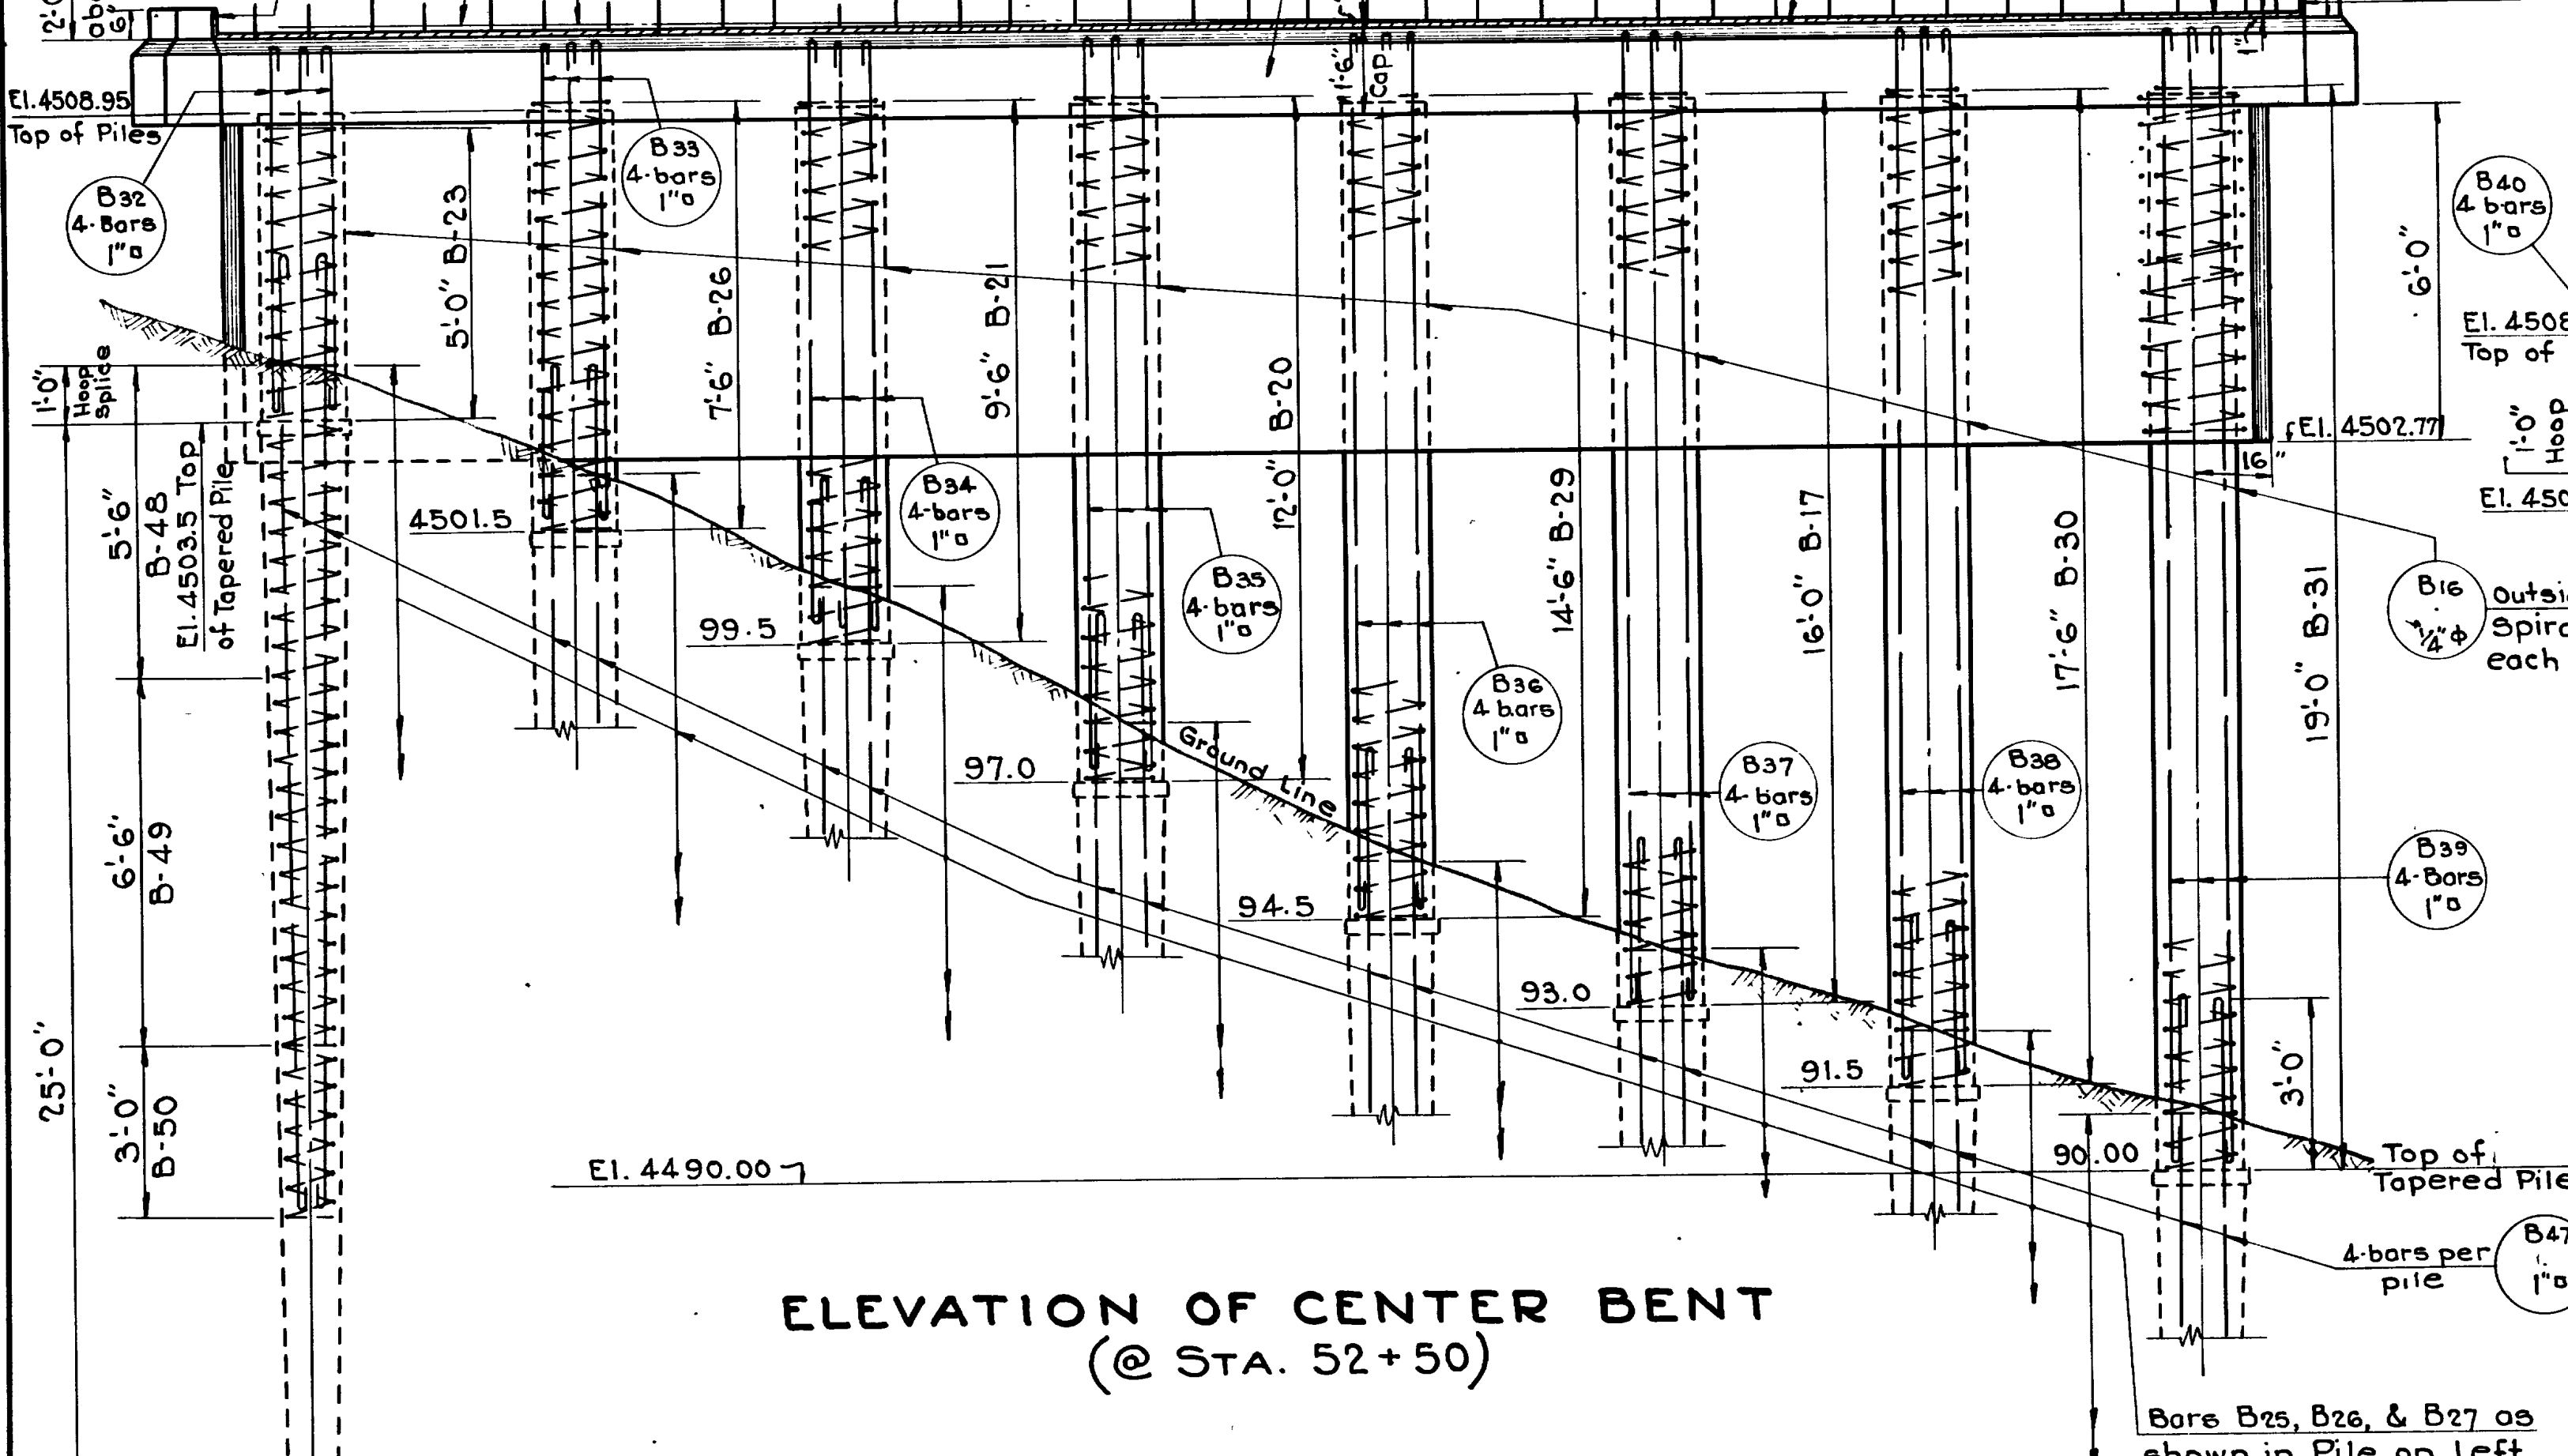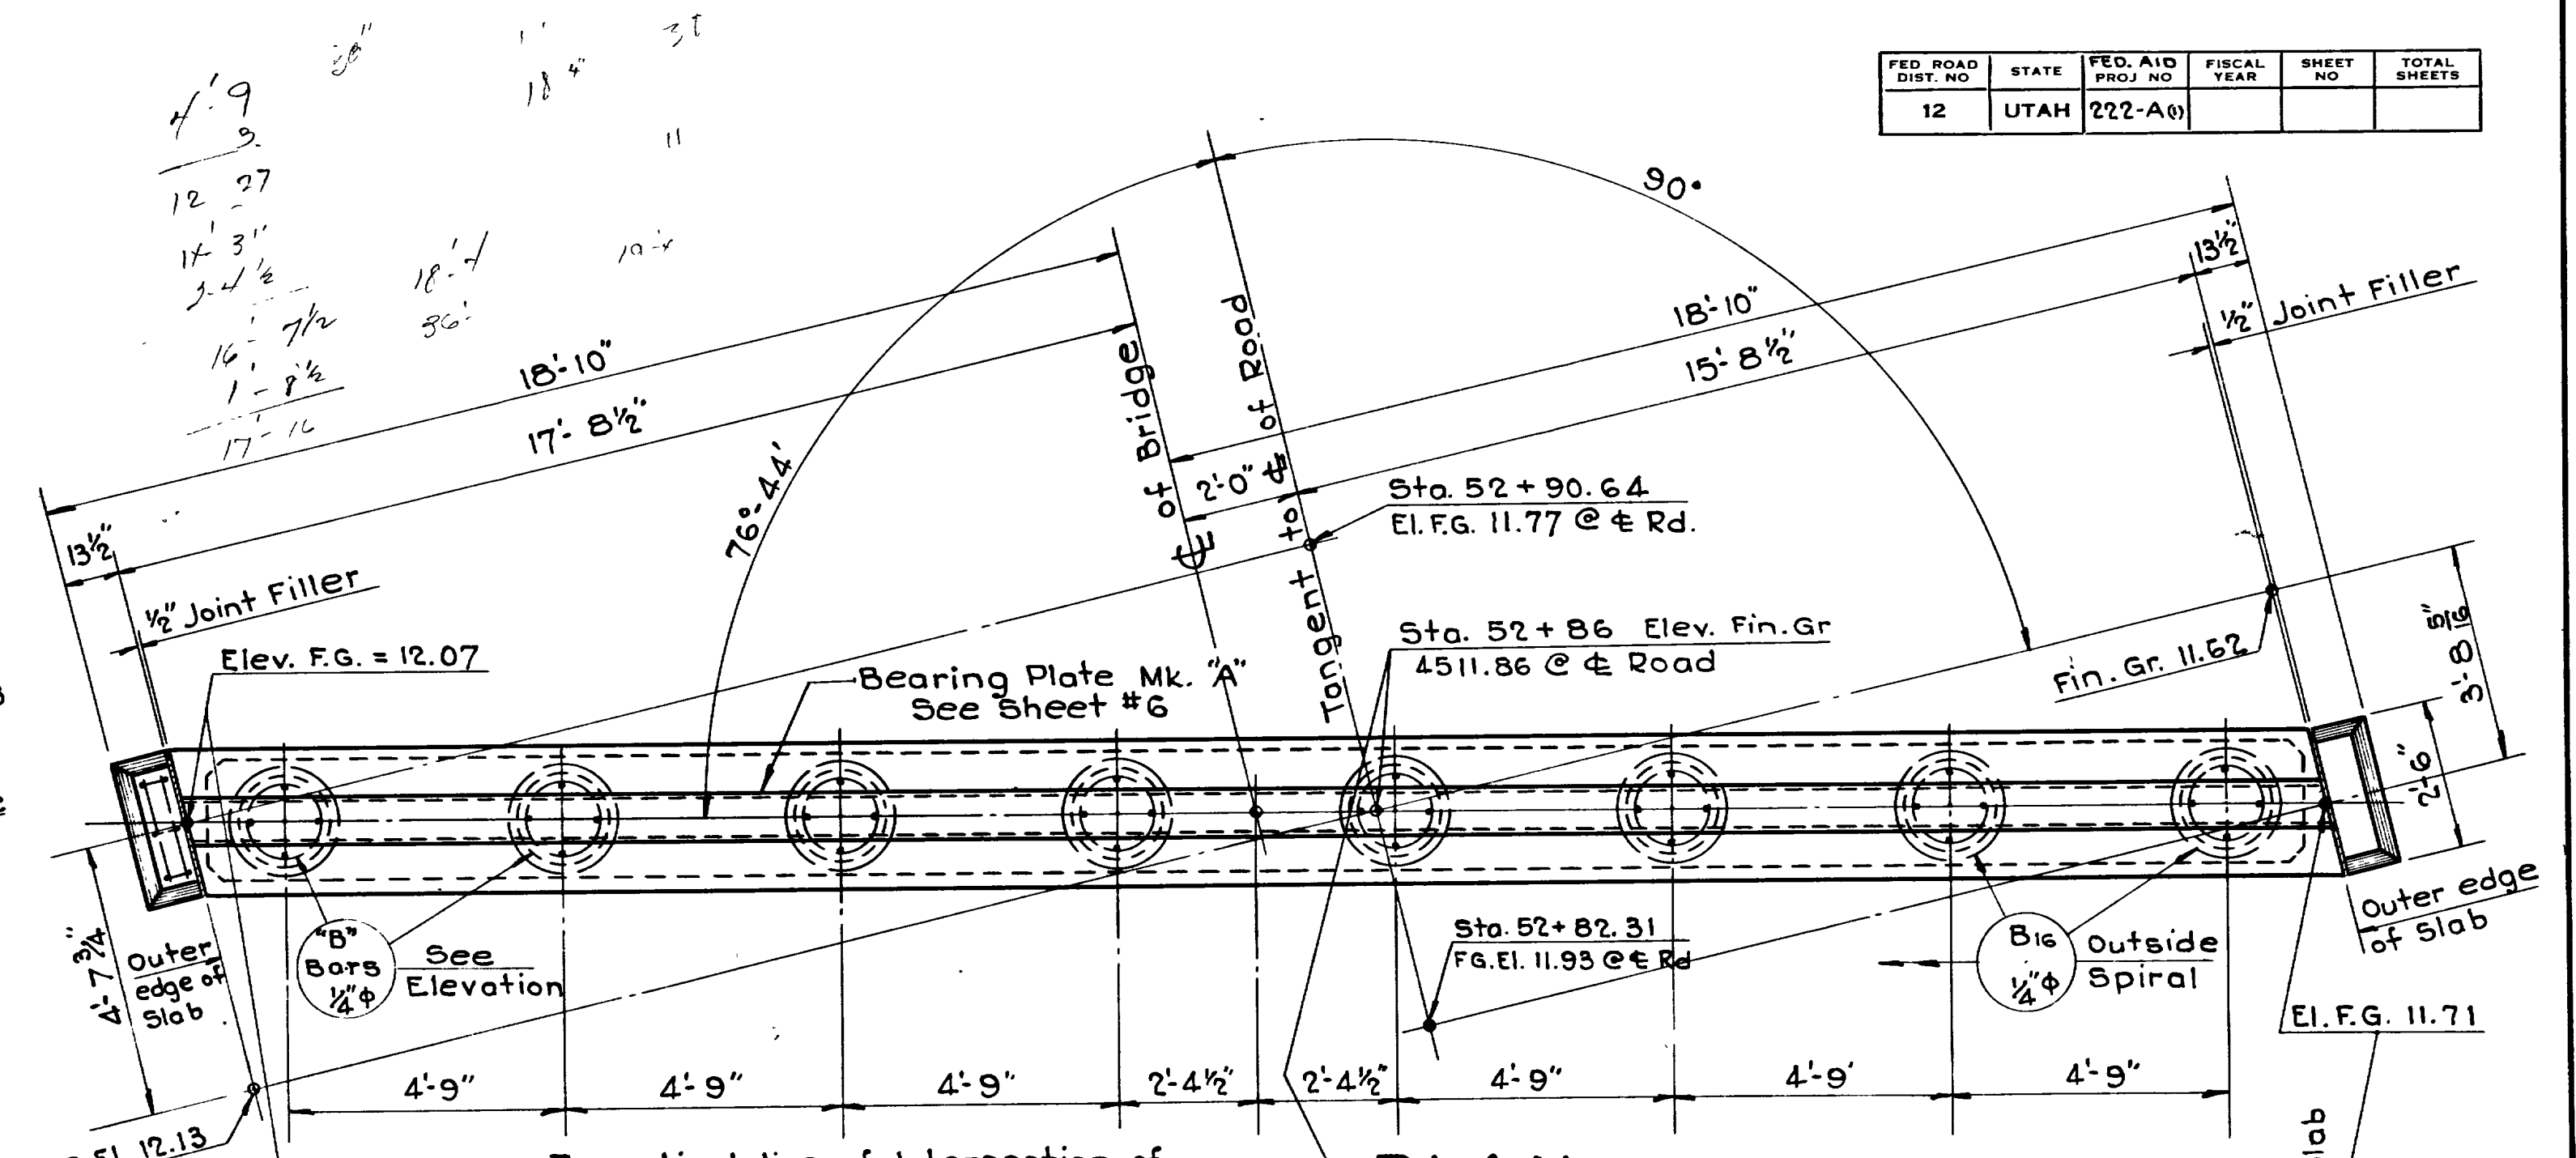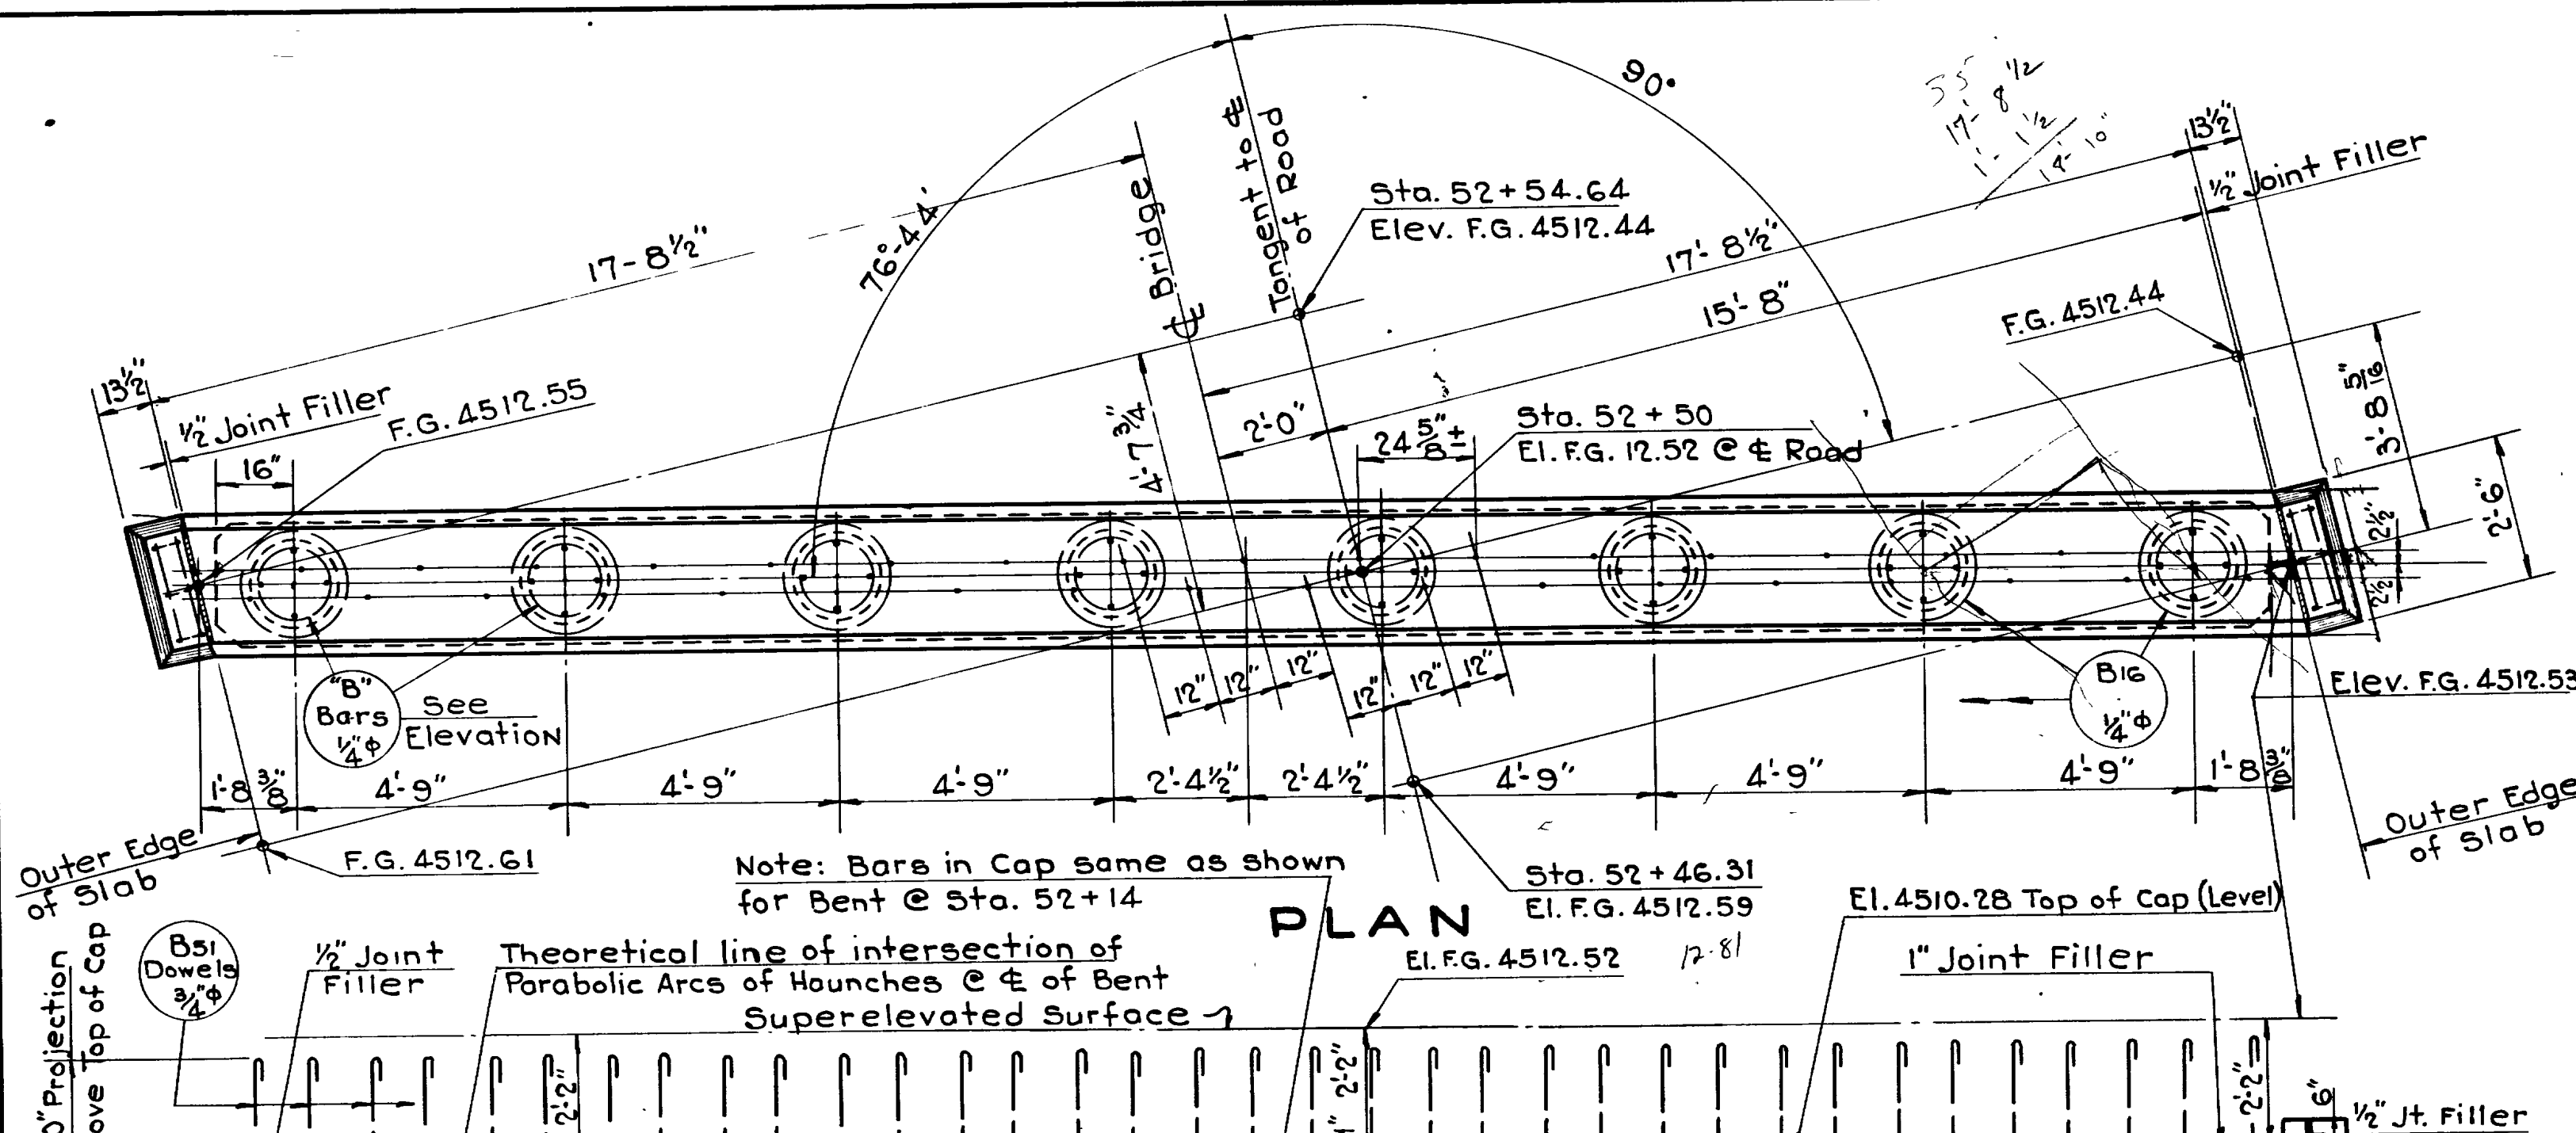

REVISIONS	DATE	BY

Note:
See Sheet 5 for Section of Diaphragms
See " 6 " " " Bearings

Sheet 4 of 12 sheets



UTAH STATE ROAD COMMISSION
SALT LAKE CITY - UTAH
EZRA C. KNOWLTON, CHIEF ENGINEER

BRIDGE OVER U.P. & L. CO'S
PENSTOCKS
A.W.(P.C.E.) F.A.P. 222-A(0)
Sta. 52+50 - Weber Co.
Ogden Arsenal - Riverdale

DESIGNED BY F.M.E. SCALE 3/8" = 1'-0"
DRAWN BY J.H.B. ISSUED 10/22/47
CHECKED BY APPROVED 10/22/47

222512 RC D-466


FED. ROAD DIST. NO.	STATE	PROJ. NO.	FISCAL YEAR	SHEET NO.	TOTAL SHEETS
12	UTAH				

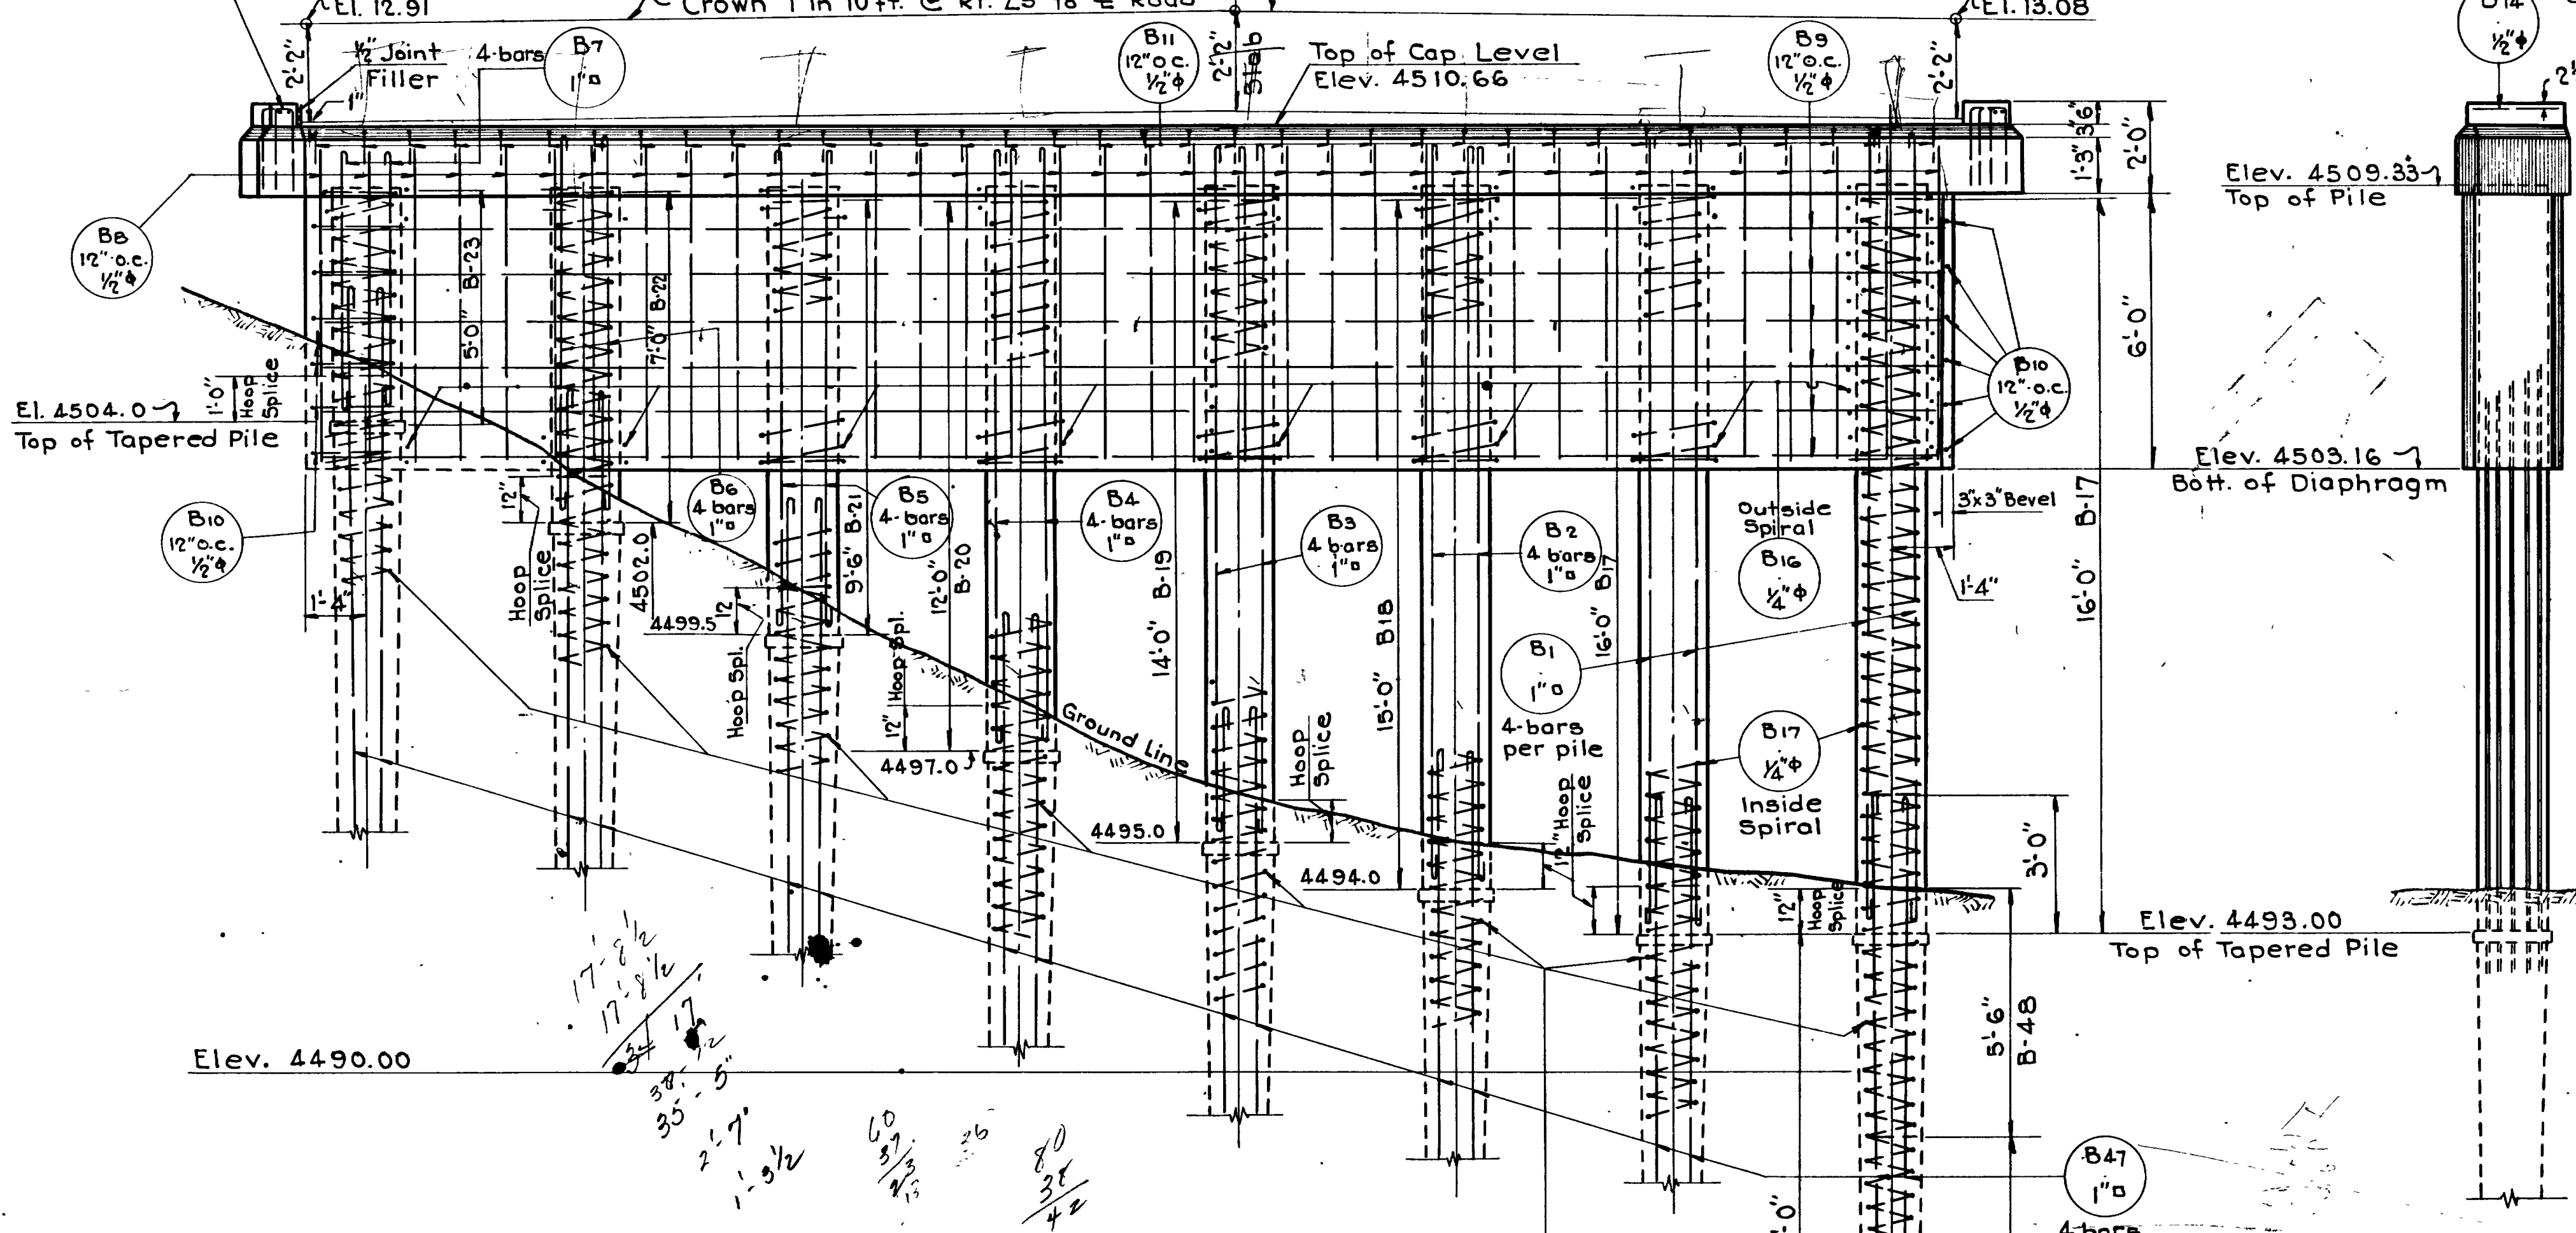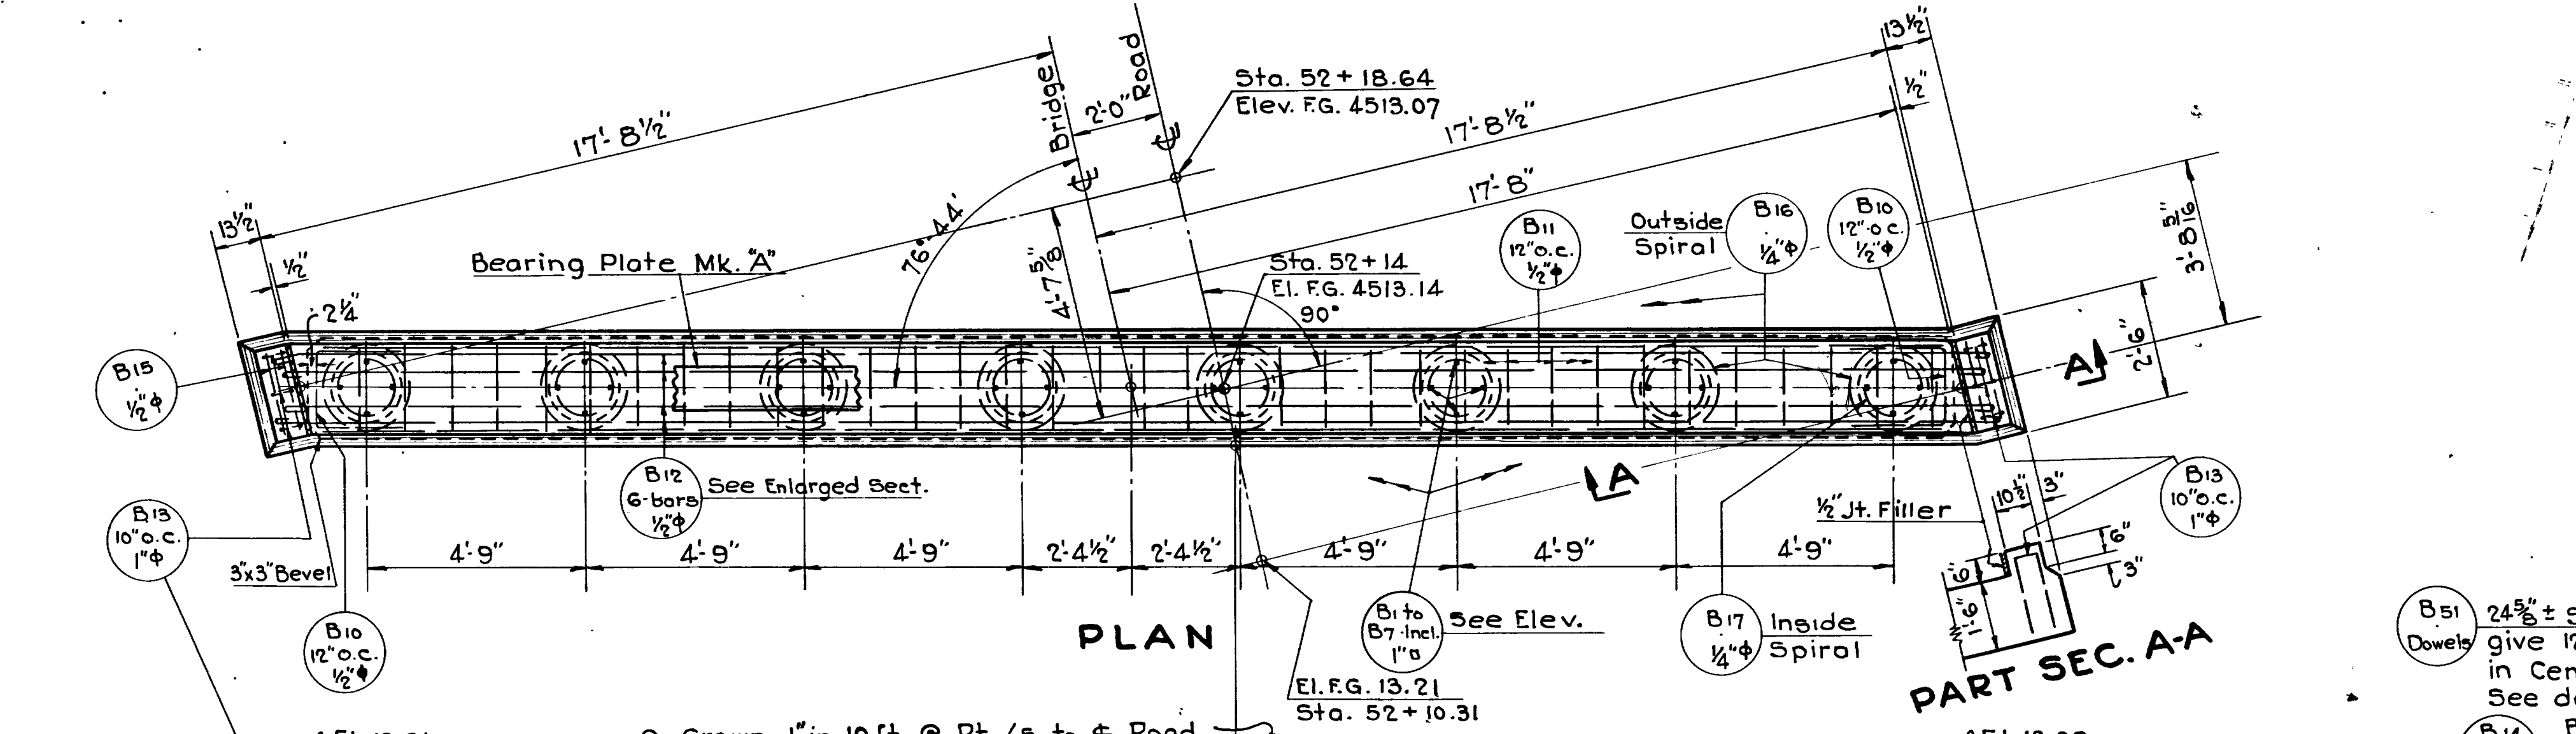

ELEVATION OF INTERMEDIATE BENT
(© Sta. 52+14)
 $\frac{3}{8}'' = 1'-0''$

49
7
28 63
33' 8"

B15, B16 & B17
Tapered Inside Spirals as shown in Pile on Right

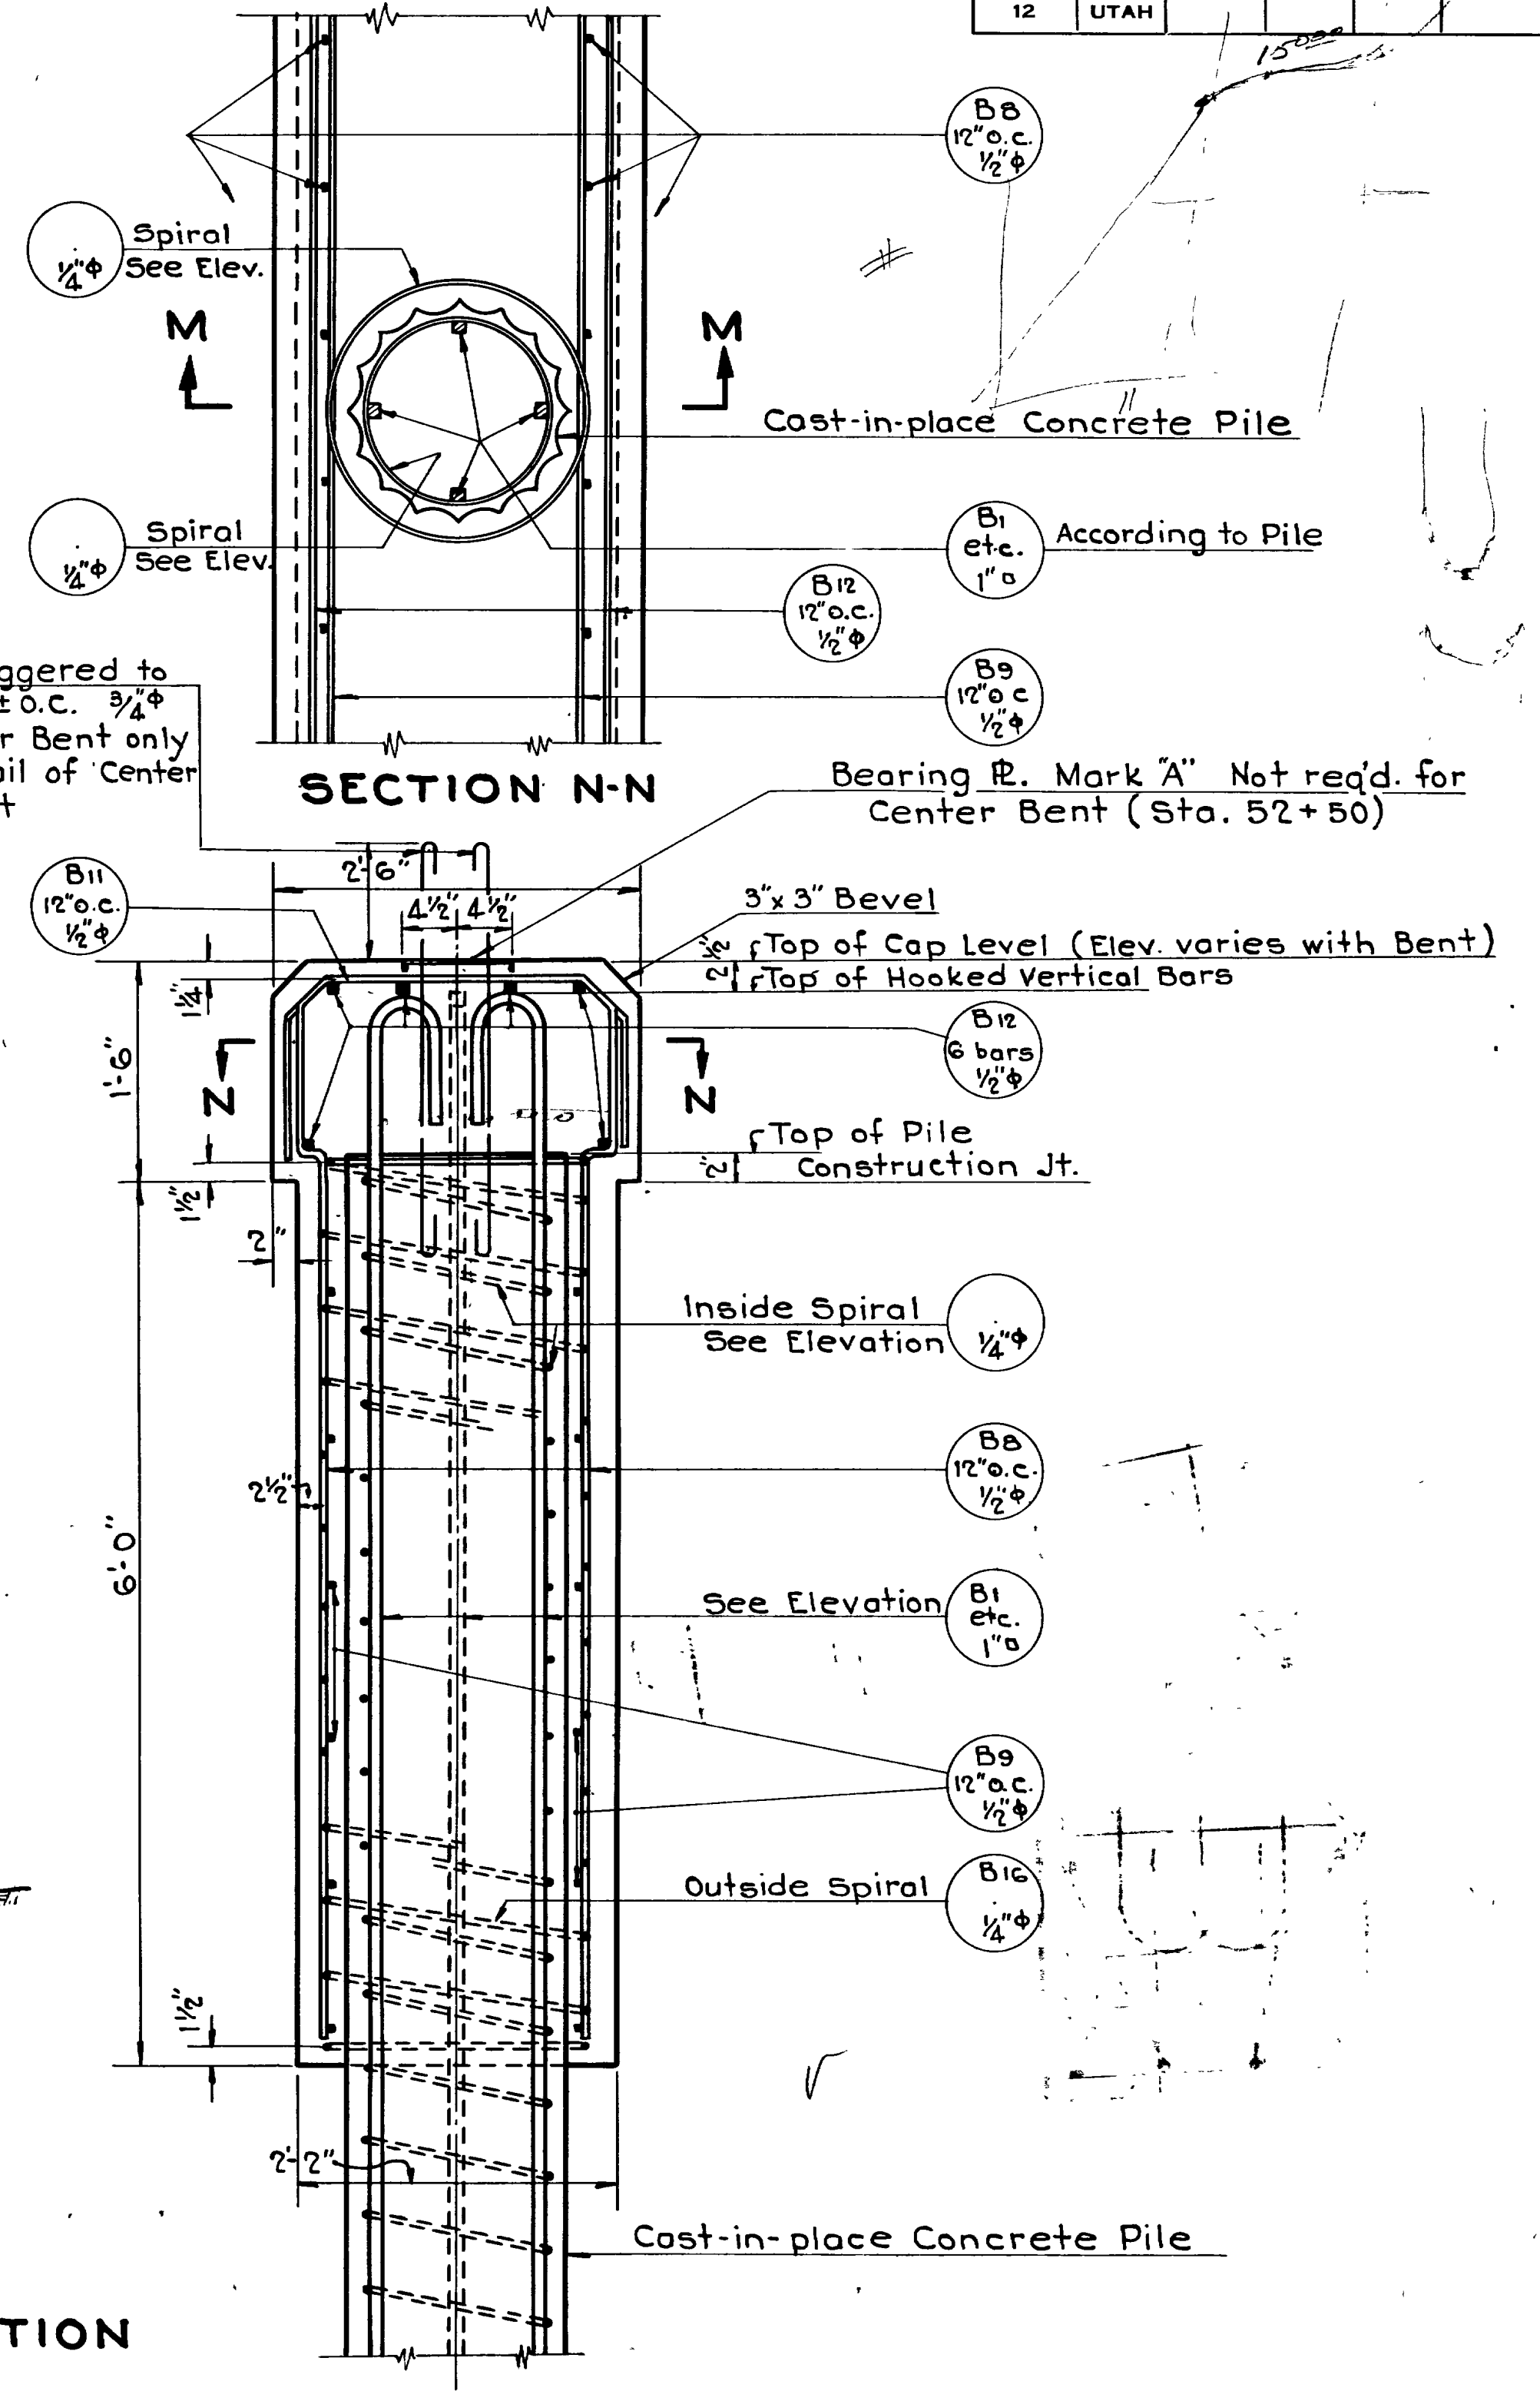

ENLARGED SECTION M-M
 $1'' = 1'-0''$
(Typical of All Piles in the Intermediate Bents)

BENTS


REVISIONS	DATE	BY

Sheet 5 of 12 sheets


UTAH STATE ROAD COMMISSION
SALT LAKE CITY - UTAH
EZRA C. KNOWLTON, CHIEF ENGINEER

BRIDGE OVER U.P. & L. CO'S.
PENSTOCKS
A.W.(P.C.E.) F.A.P. 222-A(0)
Sta. 52+50 Weber Co.
Ogden Arsenal-Riverdale


DESIGNED BY F.M.F. SCALE As noted
DRAWN BY J.H.B. DATE May 21, 1918
CHECKED BY APPROVED
BR No. 29-259-1-2 Dwg. No. D-466

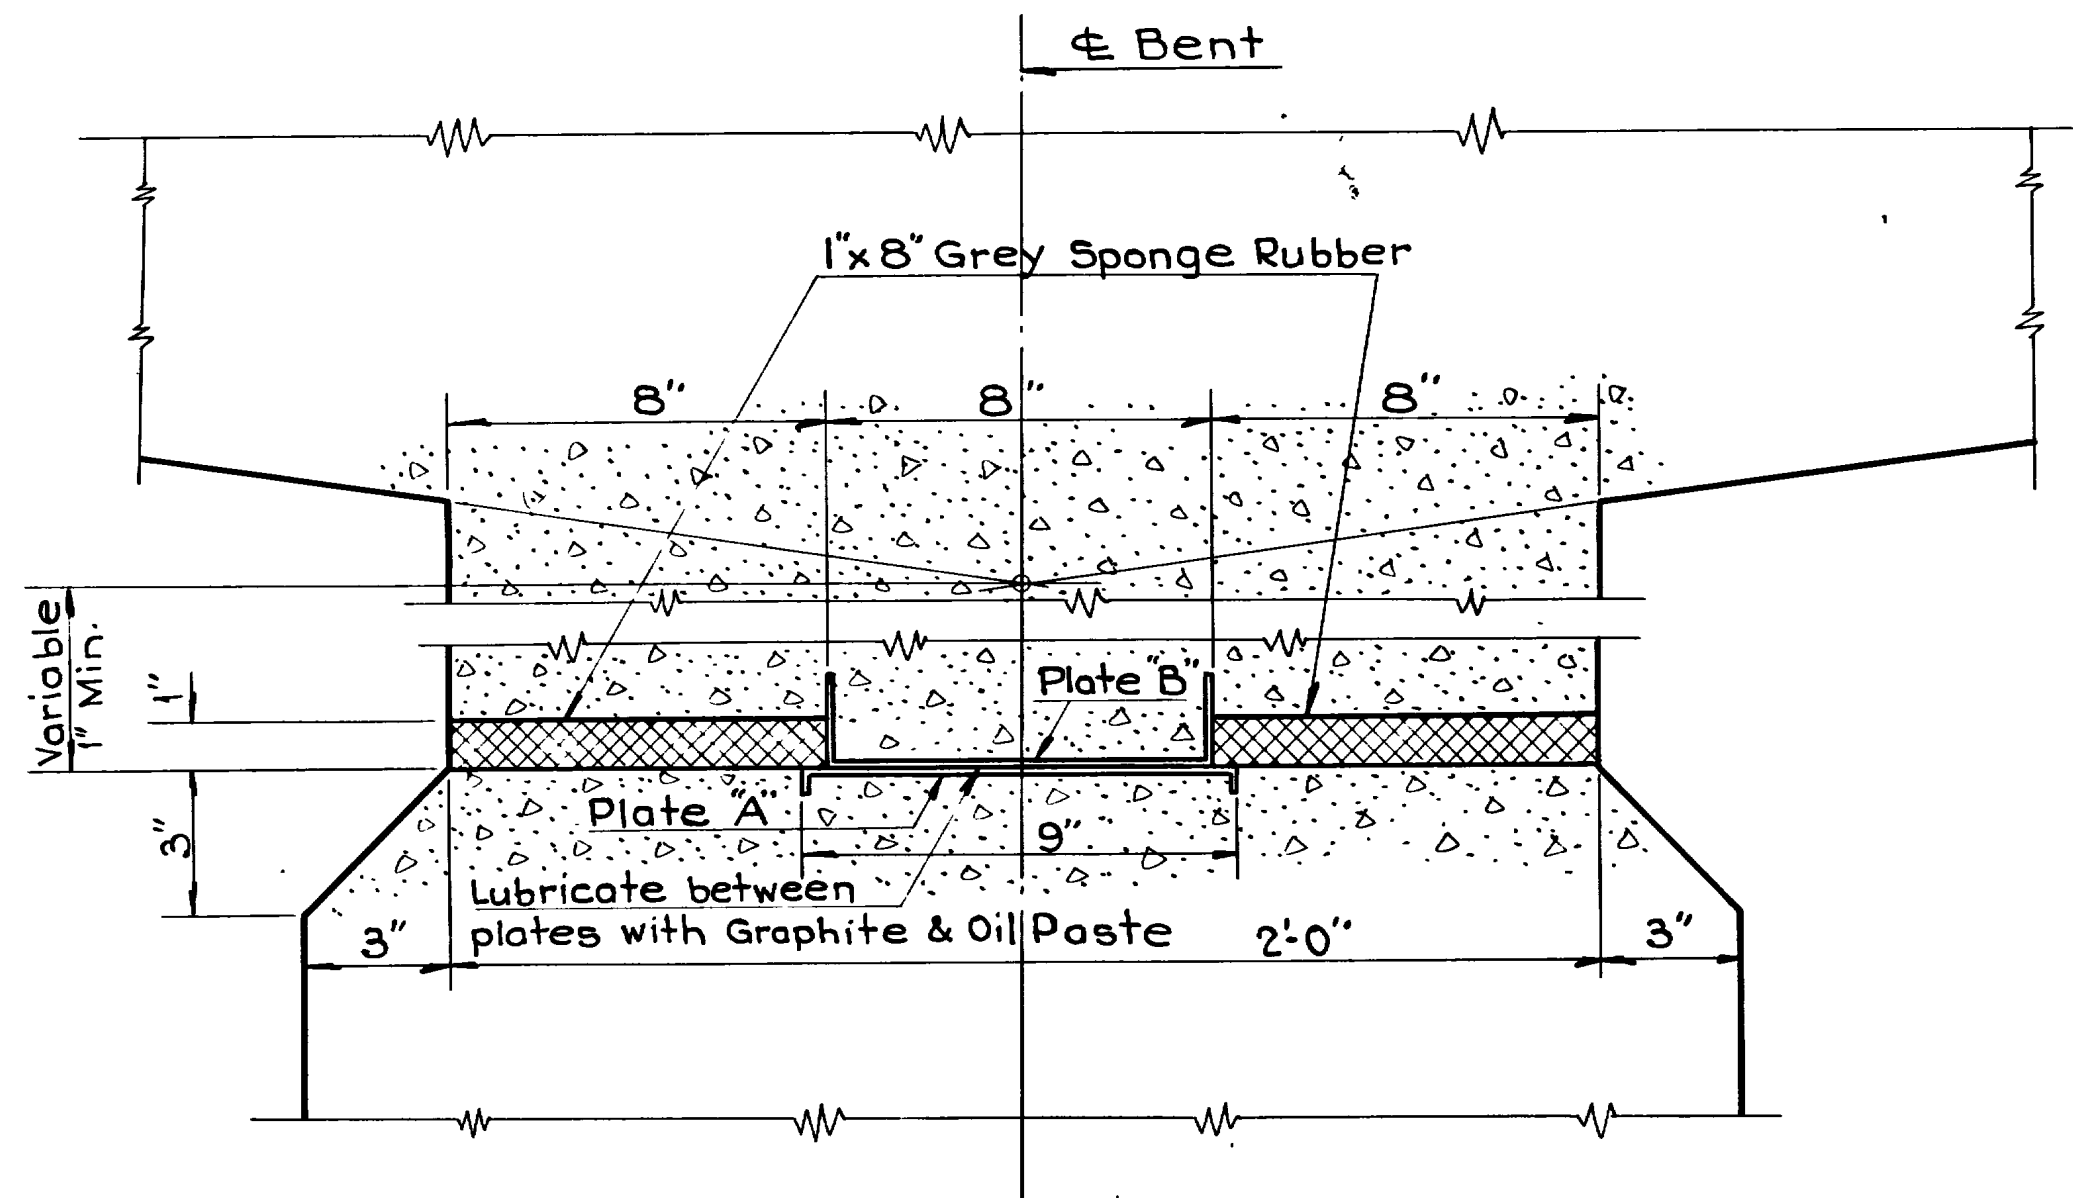


DETAIL OF FREE BEARINGS - INT. BENTS

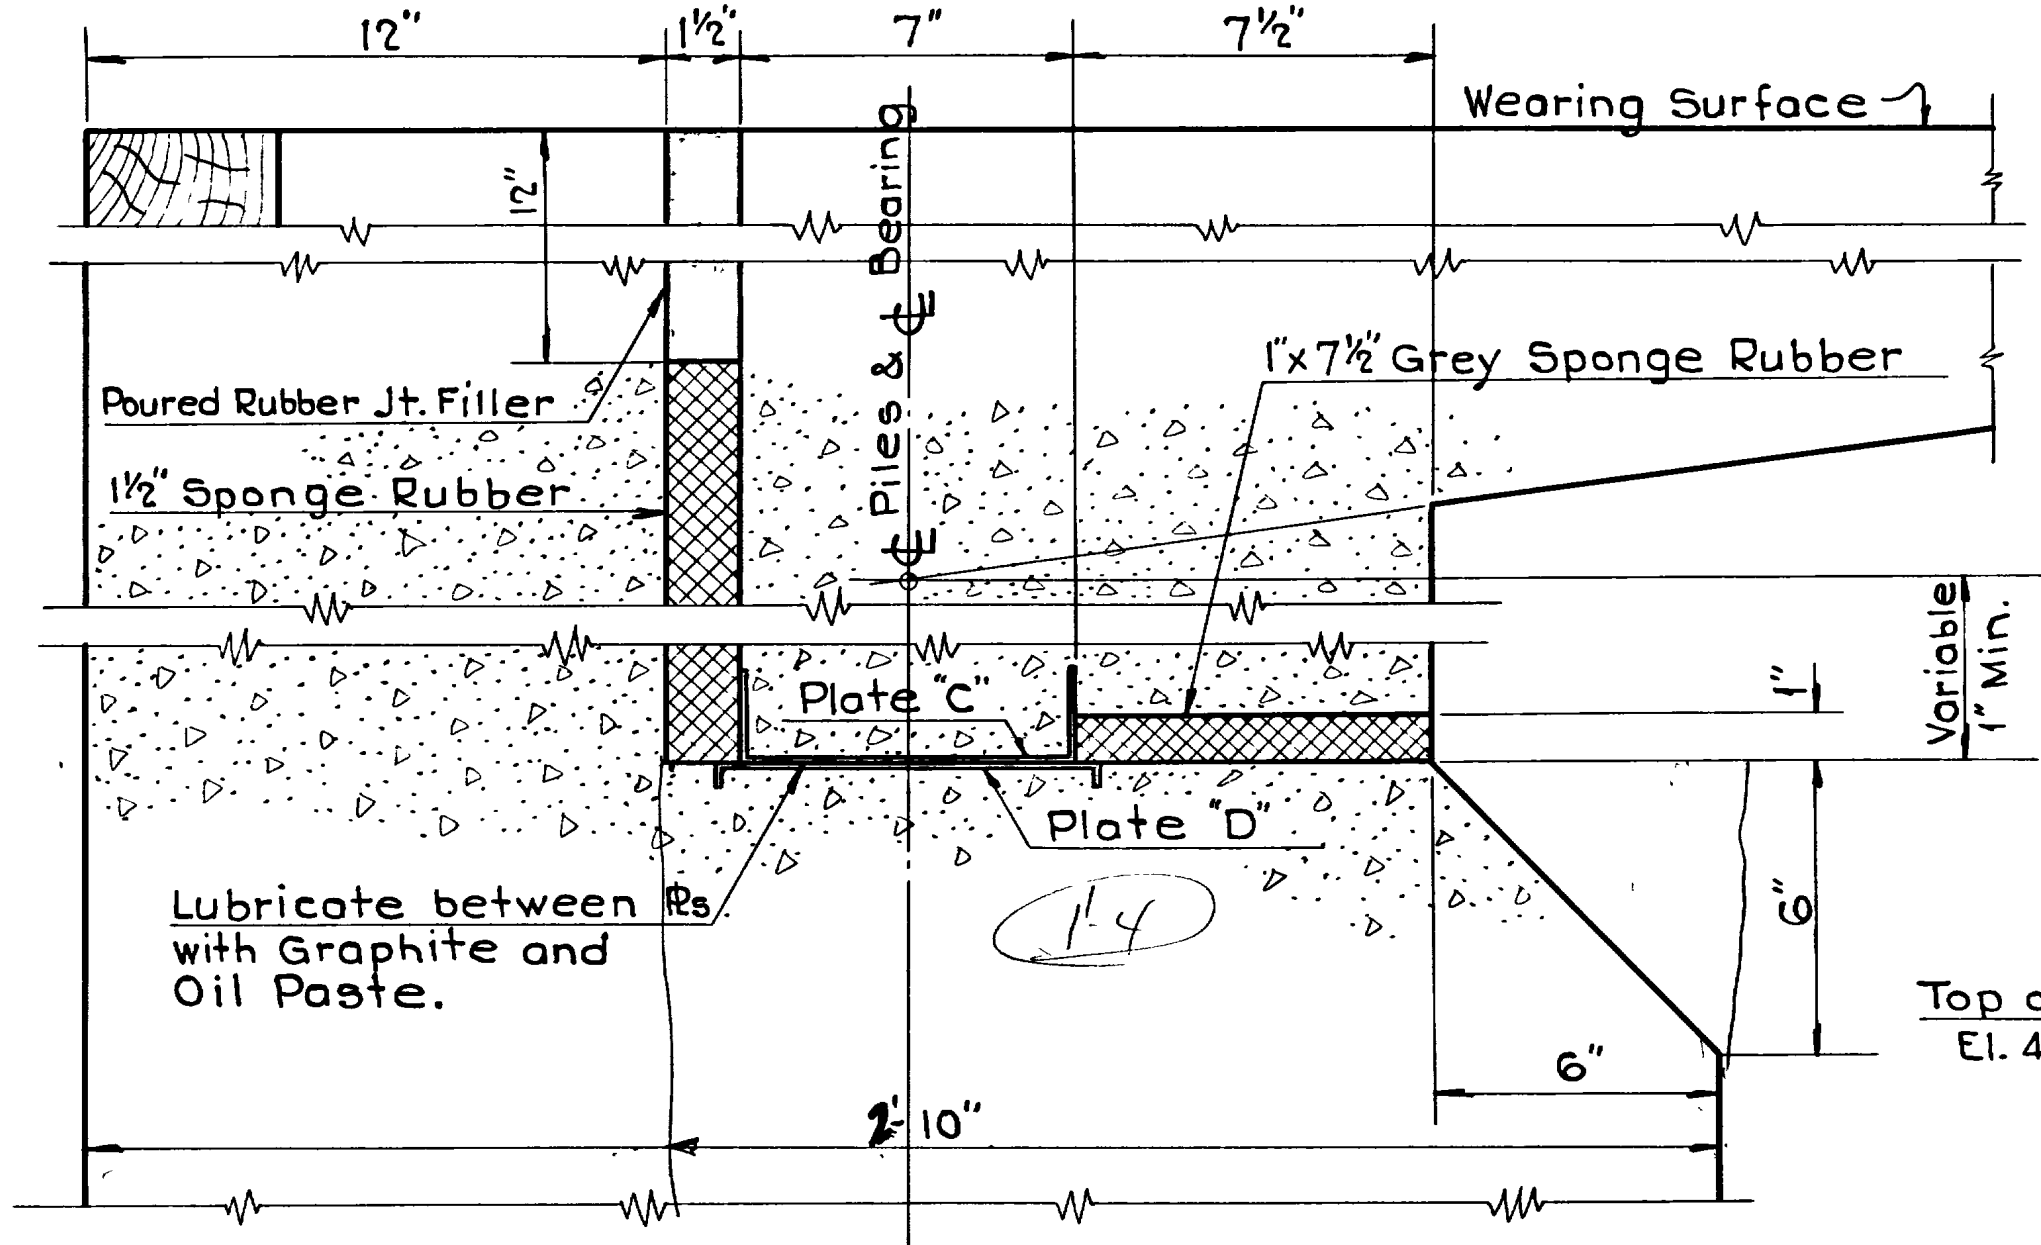

DETAIL OF BEARING AT ABUTMENTS FREE ENDS

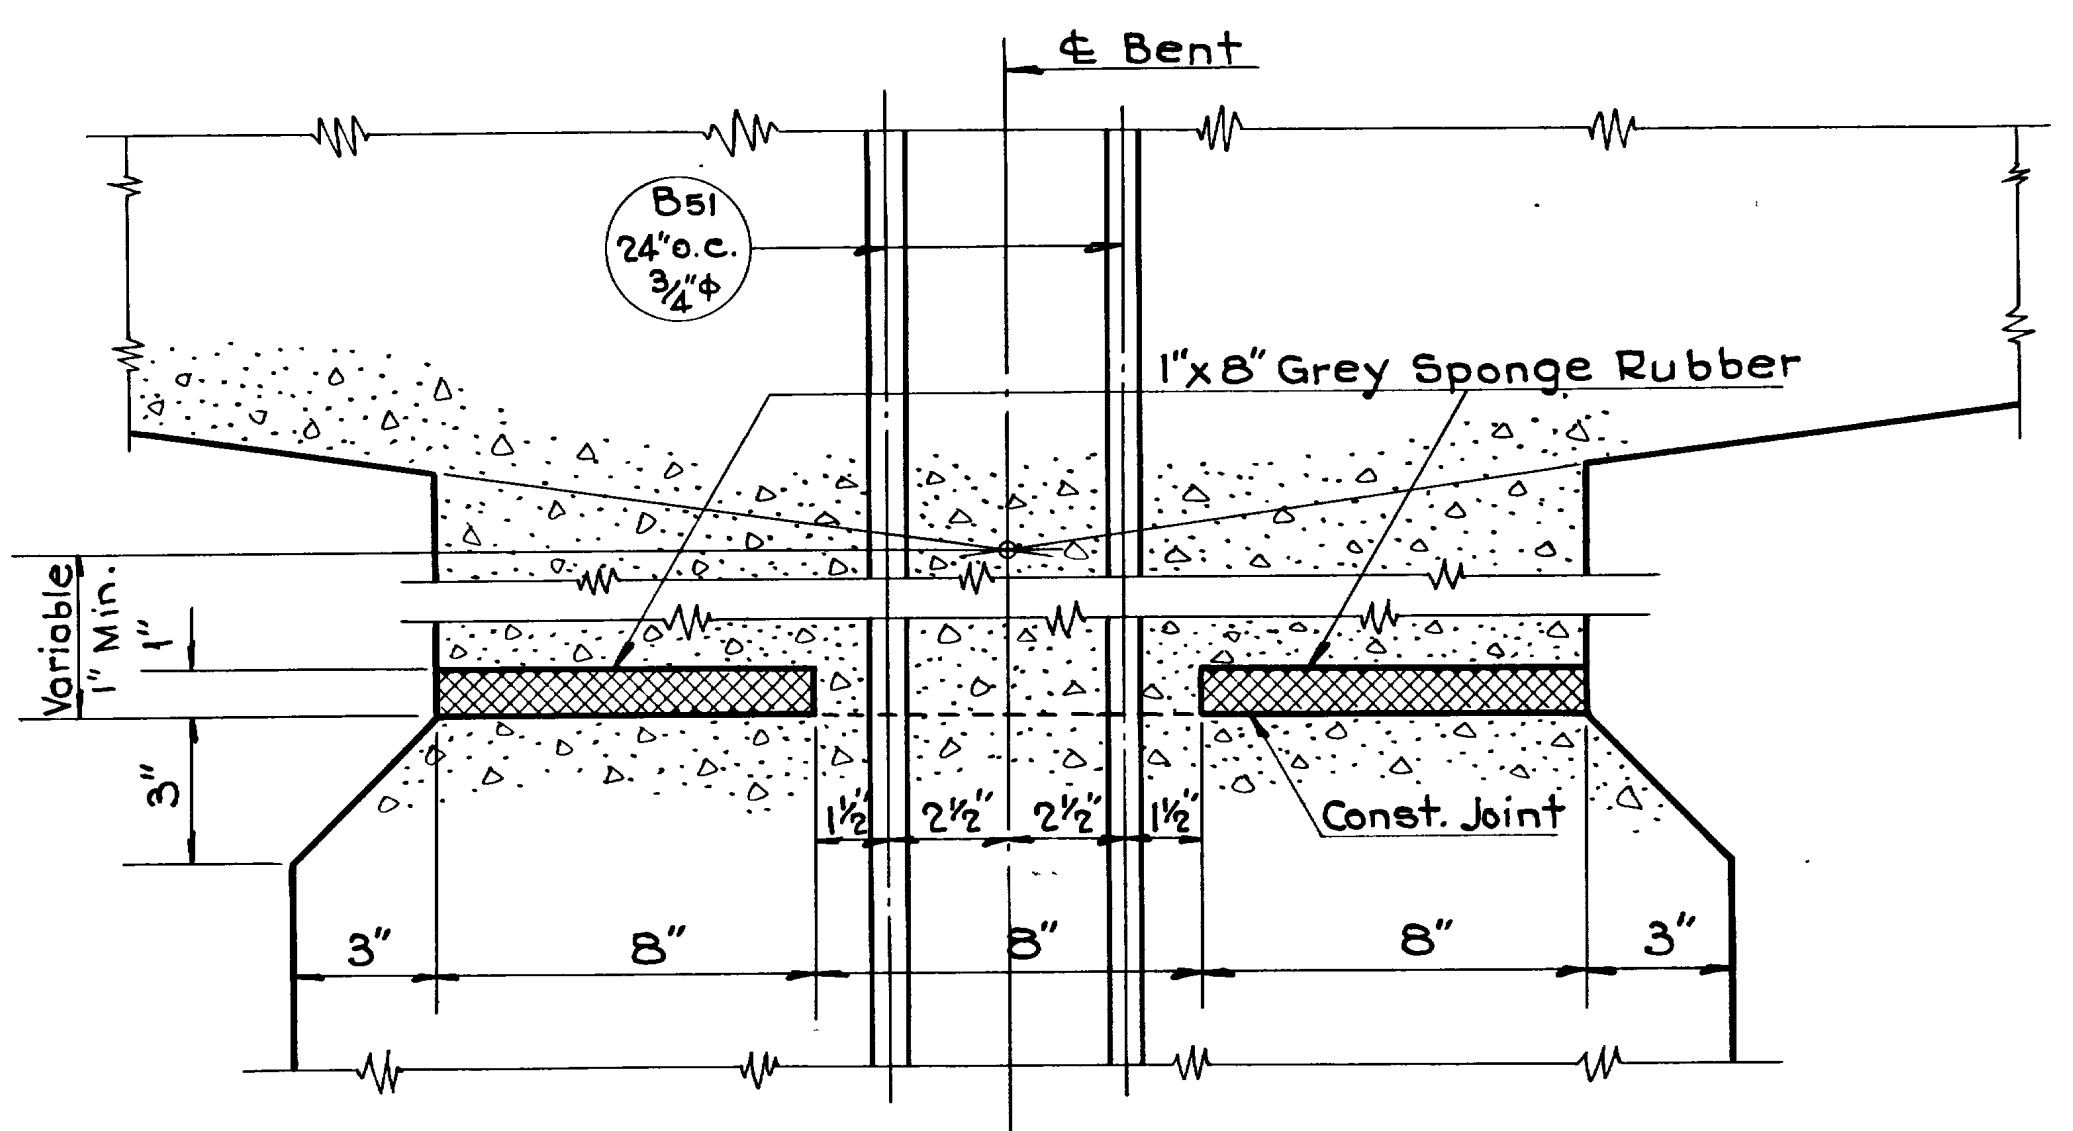


DETAIL OF FIXED BEARING - CENTER BENT

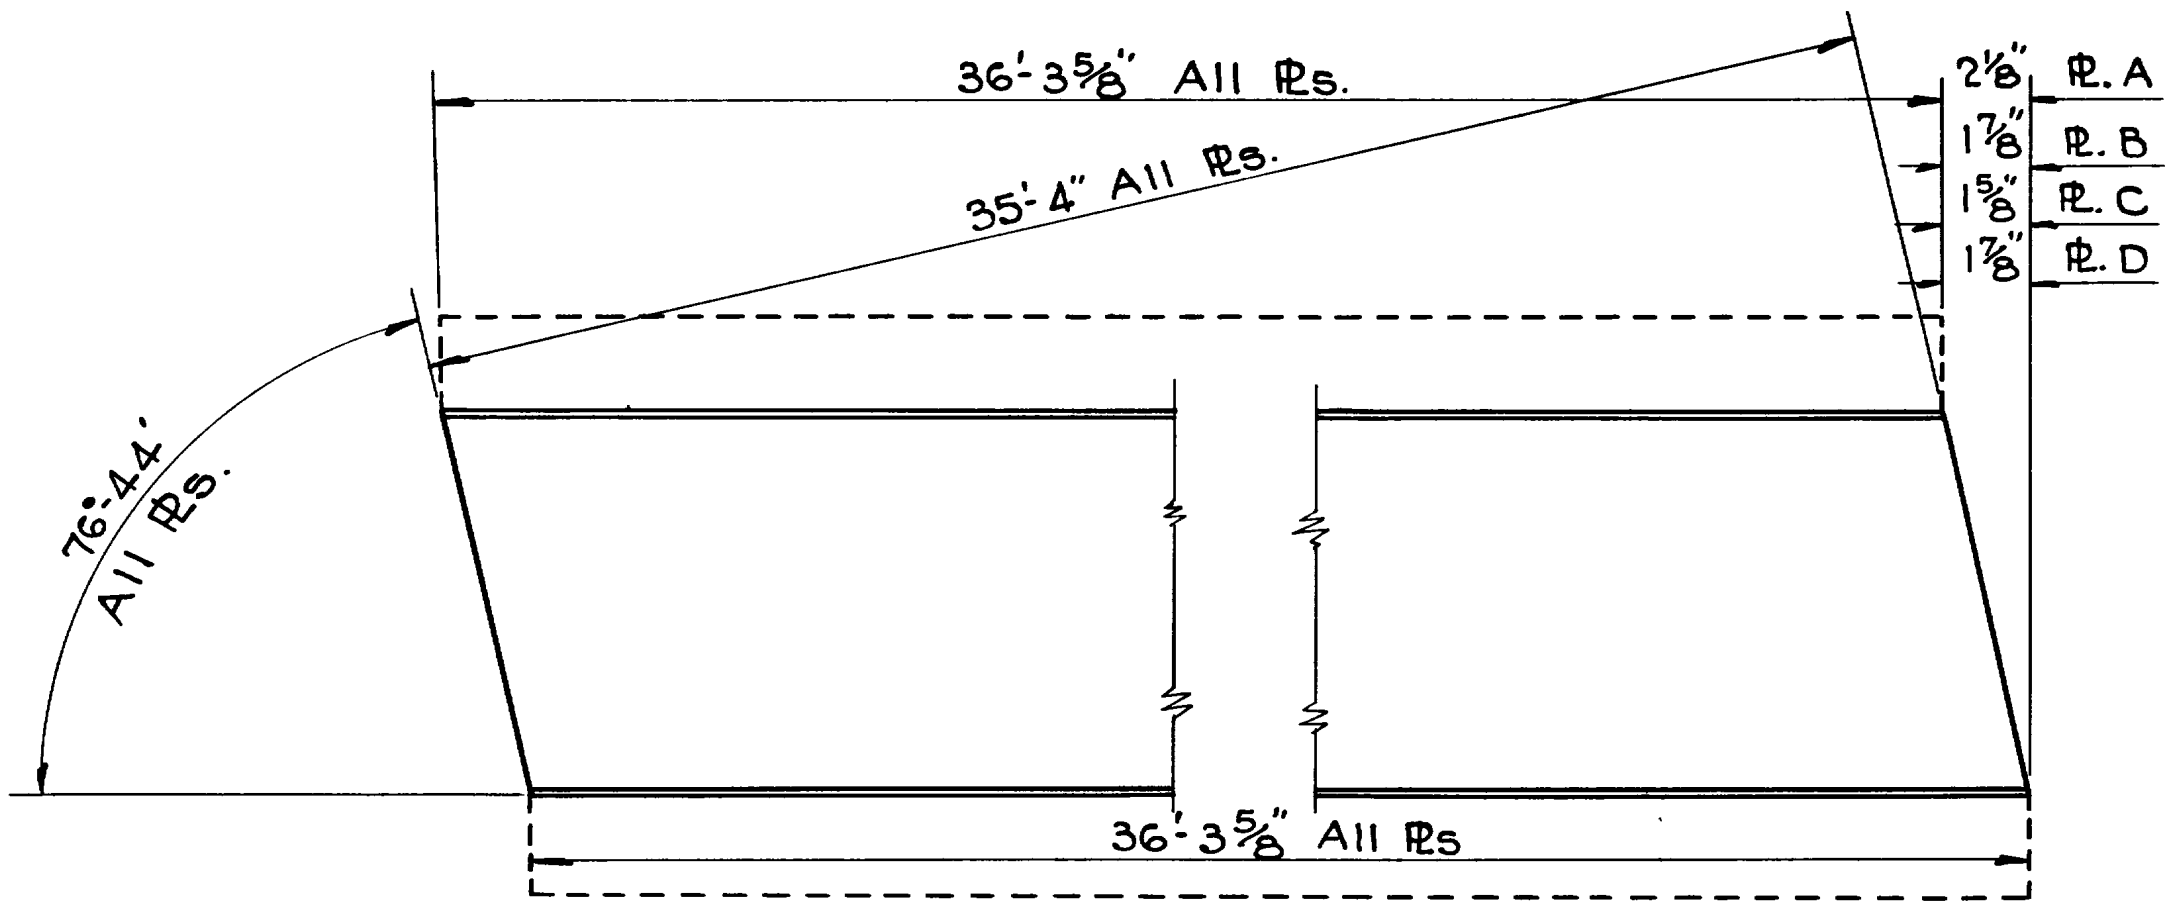


DETAIL OF BEARING PLATES

Make	2 - R.s.	as shown	Mark	"A"	10" x 1/16" x 36'-5 3/4" @ 2.125# = 155.0 Lbs
"	2	"	"	"B"	12" x 1/16" x 36'-5 1/2" @ 2.550# = 185.9 "
"	2	"	"	"C"	11" x 1/16" x 36'-5 1/2" @ 2.338# = 170.4 "
"	2	"	"	"D"	9" x 1/16" x 36'-5 1/2" @ 1.913# = 139.5 "
Total Wt. All Plates = 650.8 Lbs. Gross					

Plate "A"	9"
Plate "B"	8"
Plate "C"	7"
Plate "D"	8"

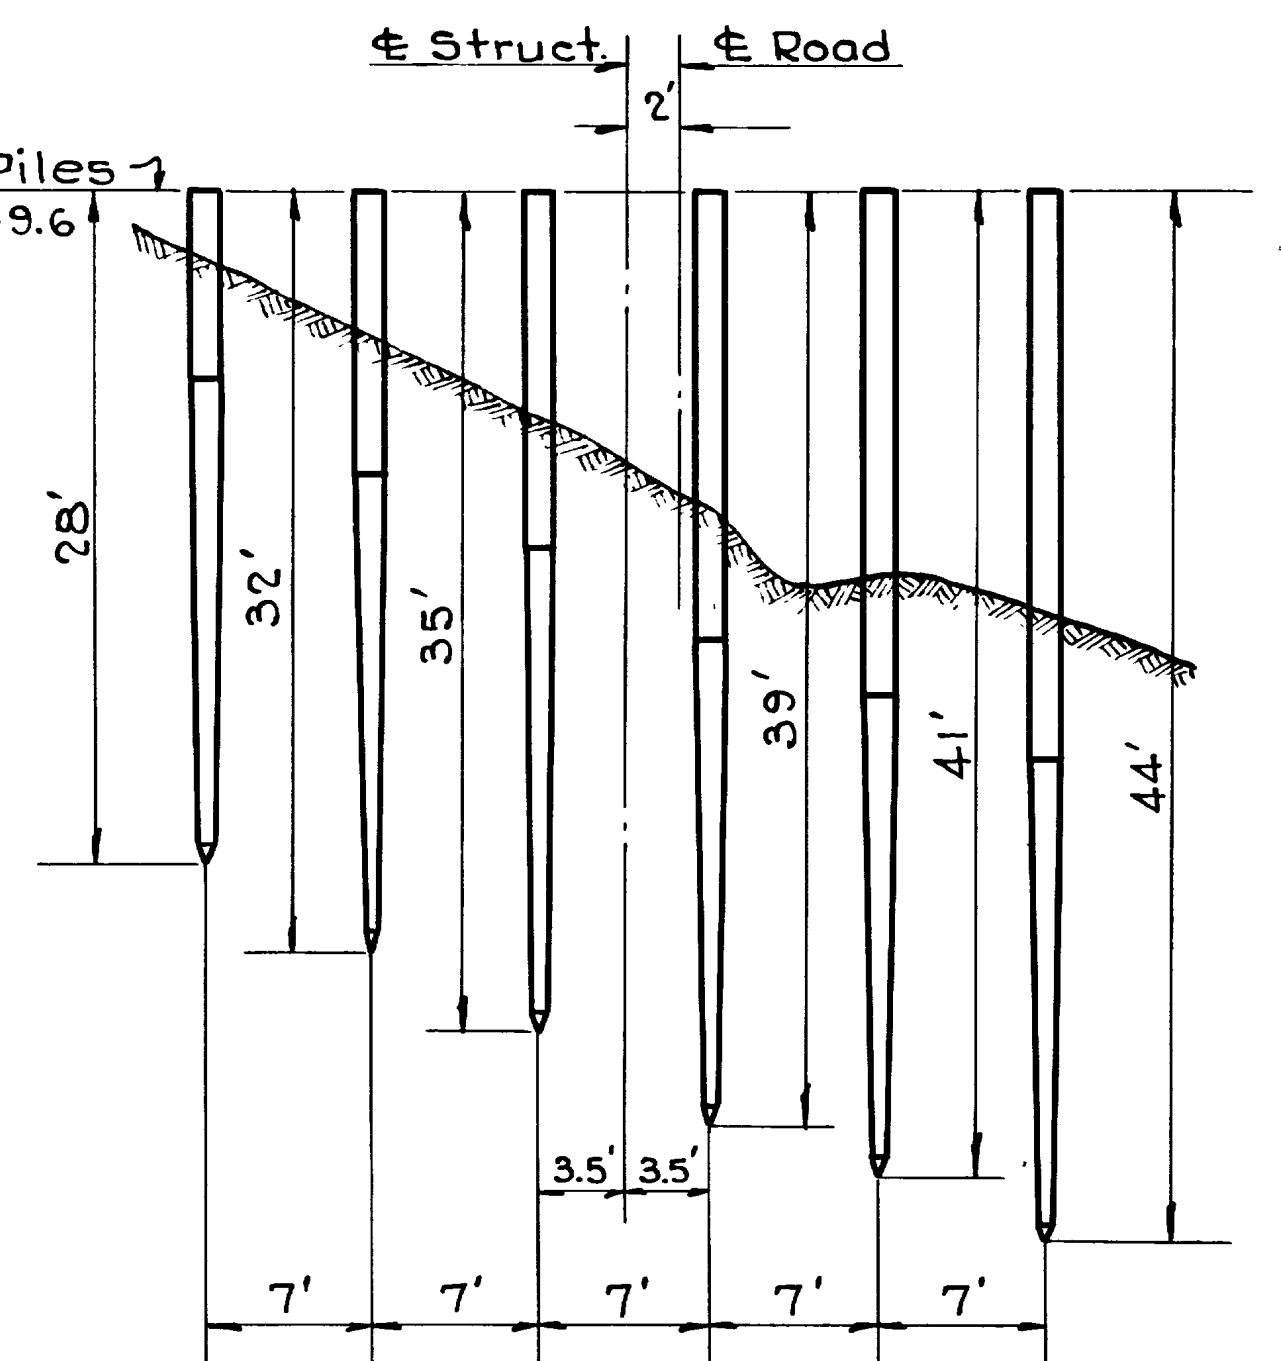

ELEVATION PILING (Upgrade Abut.) Sta. 51+86 1/8" = 1'-0"

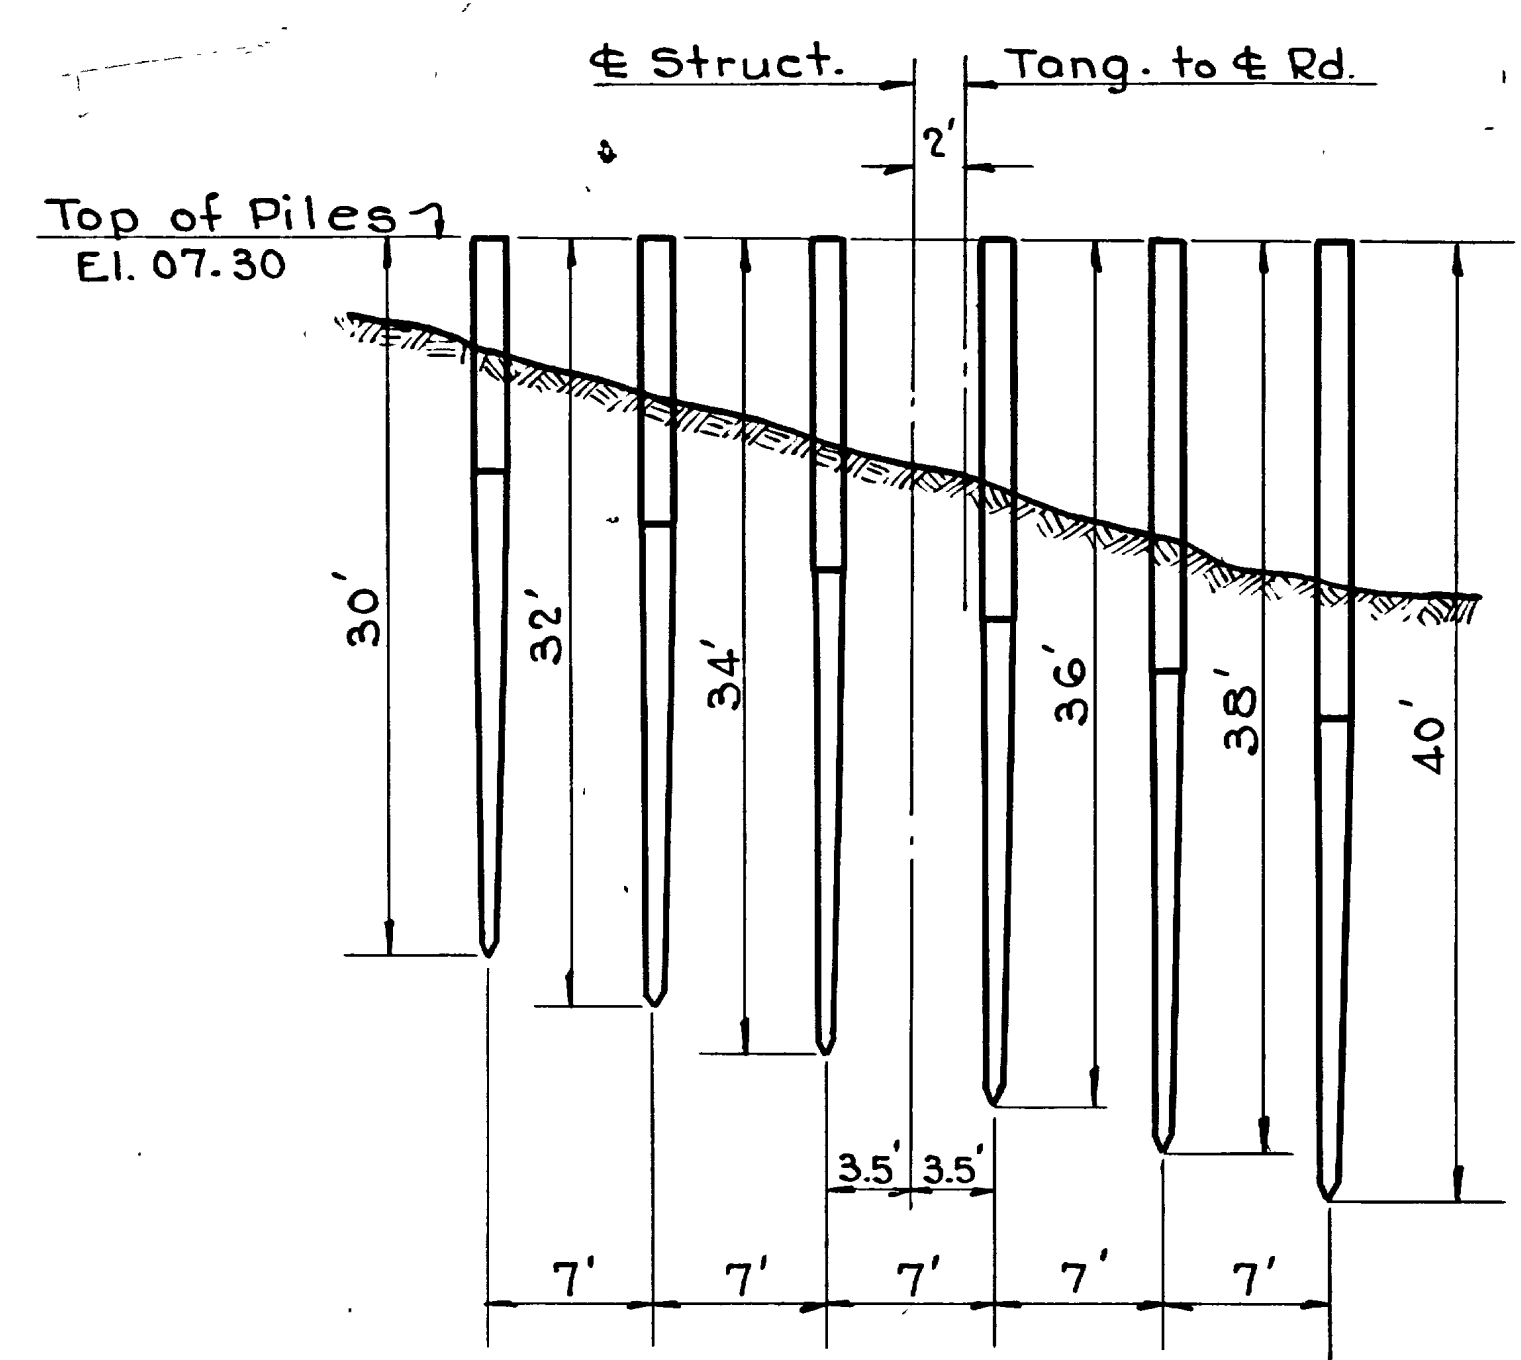

ELEVATION PILING (Downgrade Abut.) Sta. 53+14 1/8" = 1'-0"


BEARINGS & BRG. PLATES

Sheet 6 of 12 sheets
 UTAH STATE ROAD COMMISSION
 SALT LAKE CITY - UTAH
 ERNA C. KNOWLTON, CHIEF ENGINEER
 BRIDGE OVER U.P. & L. CO'S PENSTOCKS
 A.W.(P.C.E.) F.A.P. 222-A0
 Sta. 52+50 Weber Co.
 Ogden Arsenal-Riverdale
 DESIGNED BY F.M.E. SCALE As noted
 DRAWN BY F.M.E. ISSUED 11/19/51
 CHECKED BY F.M.E. APPROVED [Signature]
 EXAMINED BY [Signature]
 No. 29-259-1-2 DRG. No. D-466

REVISIONS	DATE	BY






FED. ROAD DIST. NO.	STATE	PROJ. NO.	FISCAL YEAR	SHEET NO.	TOTAL SHEETS
12	UTAH				

05/16
186
31
496

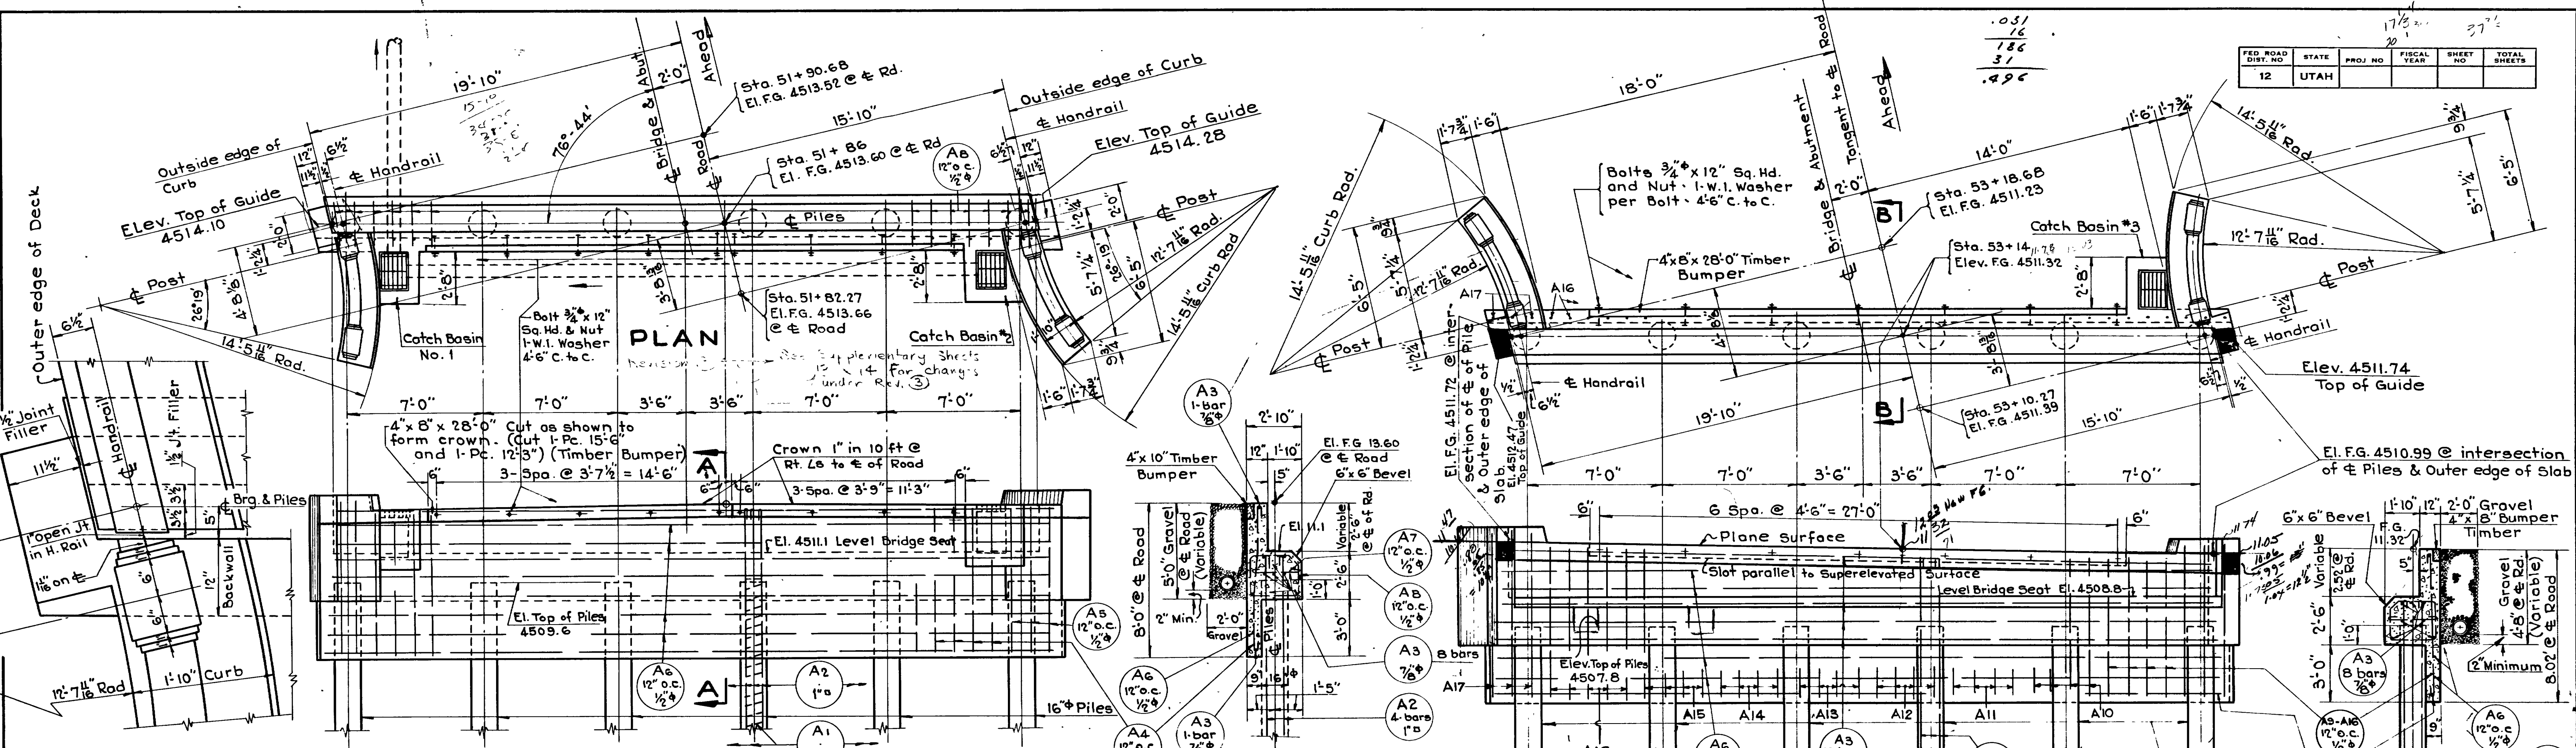

ENLARGED TYPICAL PLAN
 (Hand Rail End Post)
 1" = 1'-0"



REVISIONS	DATE	BY	CHKD.
1	3-22-51	J.M.B.	J.M.B.
2	4-11-51	J.M.B.	J.M.B.

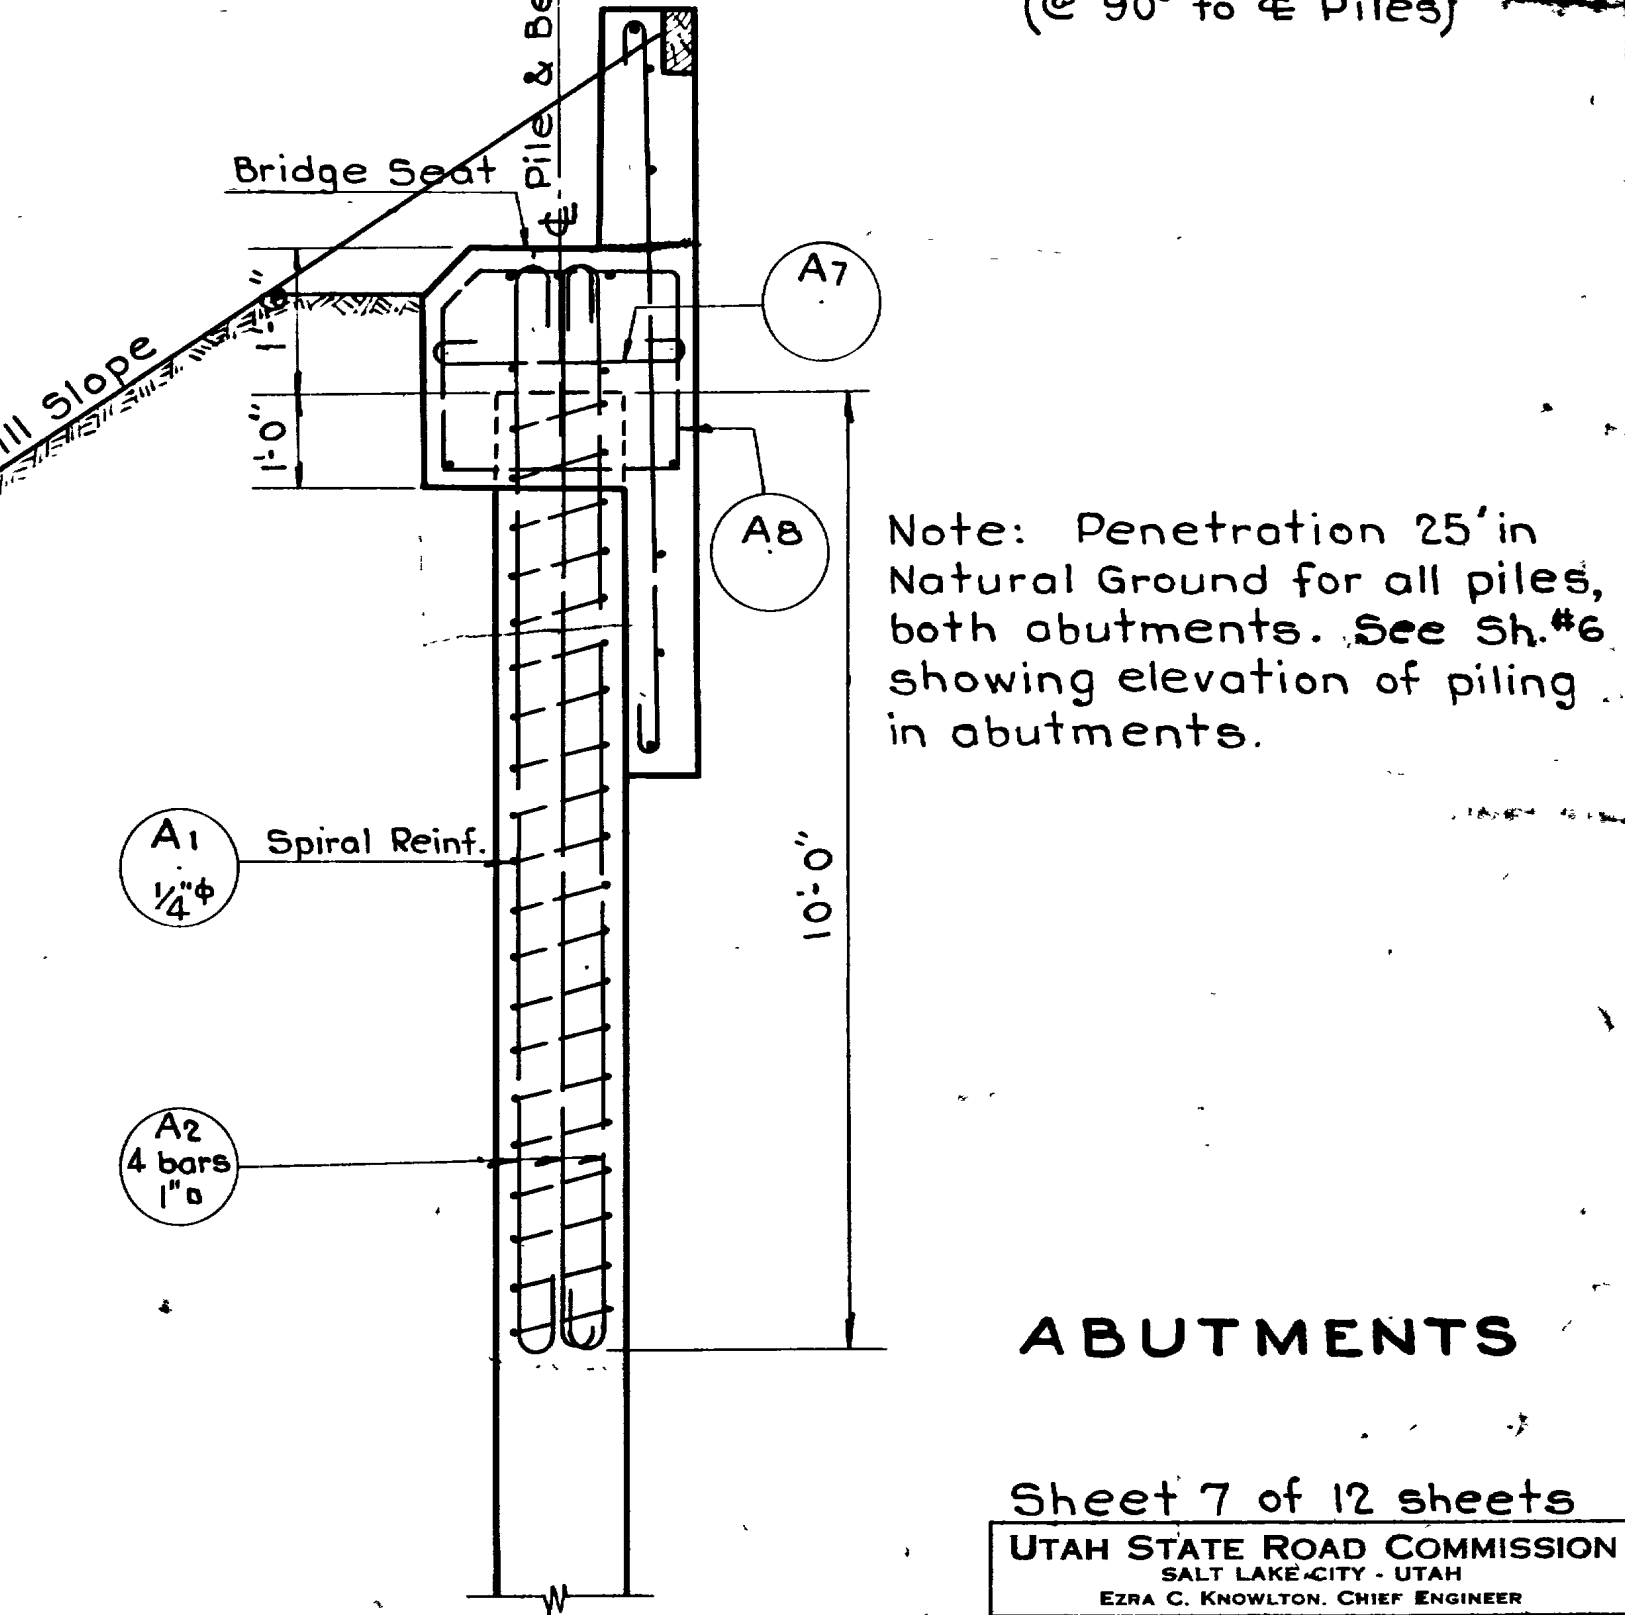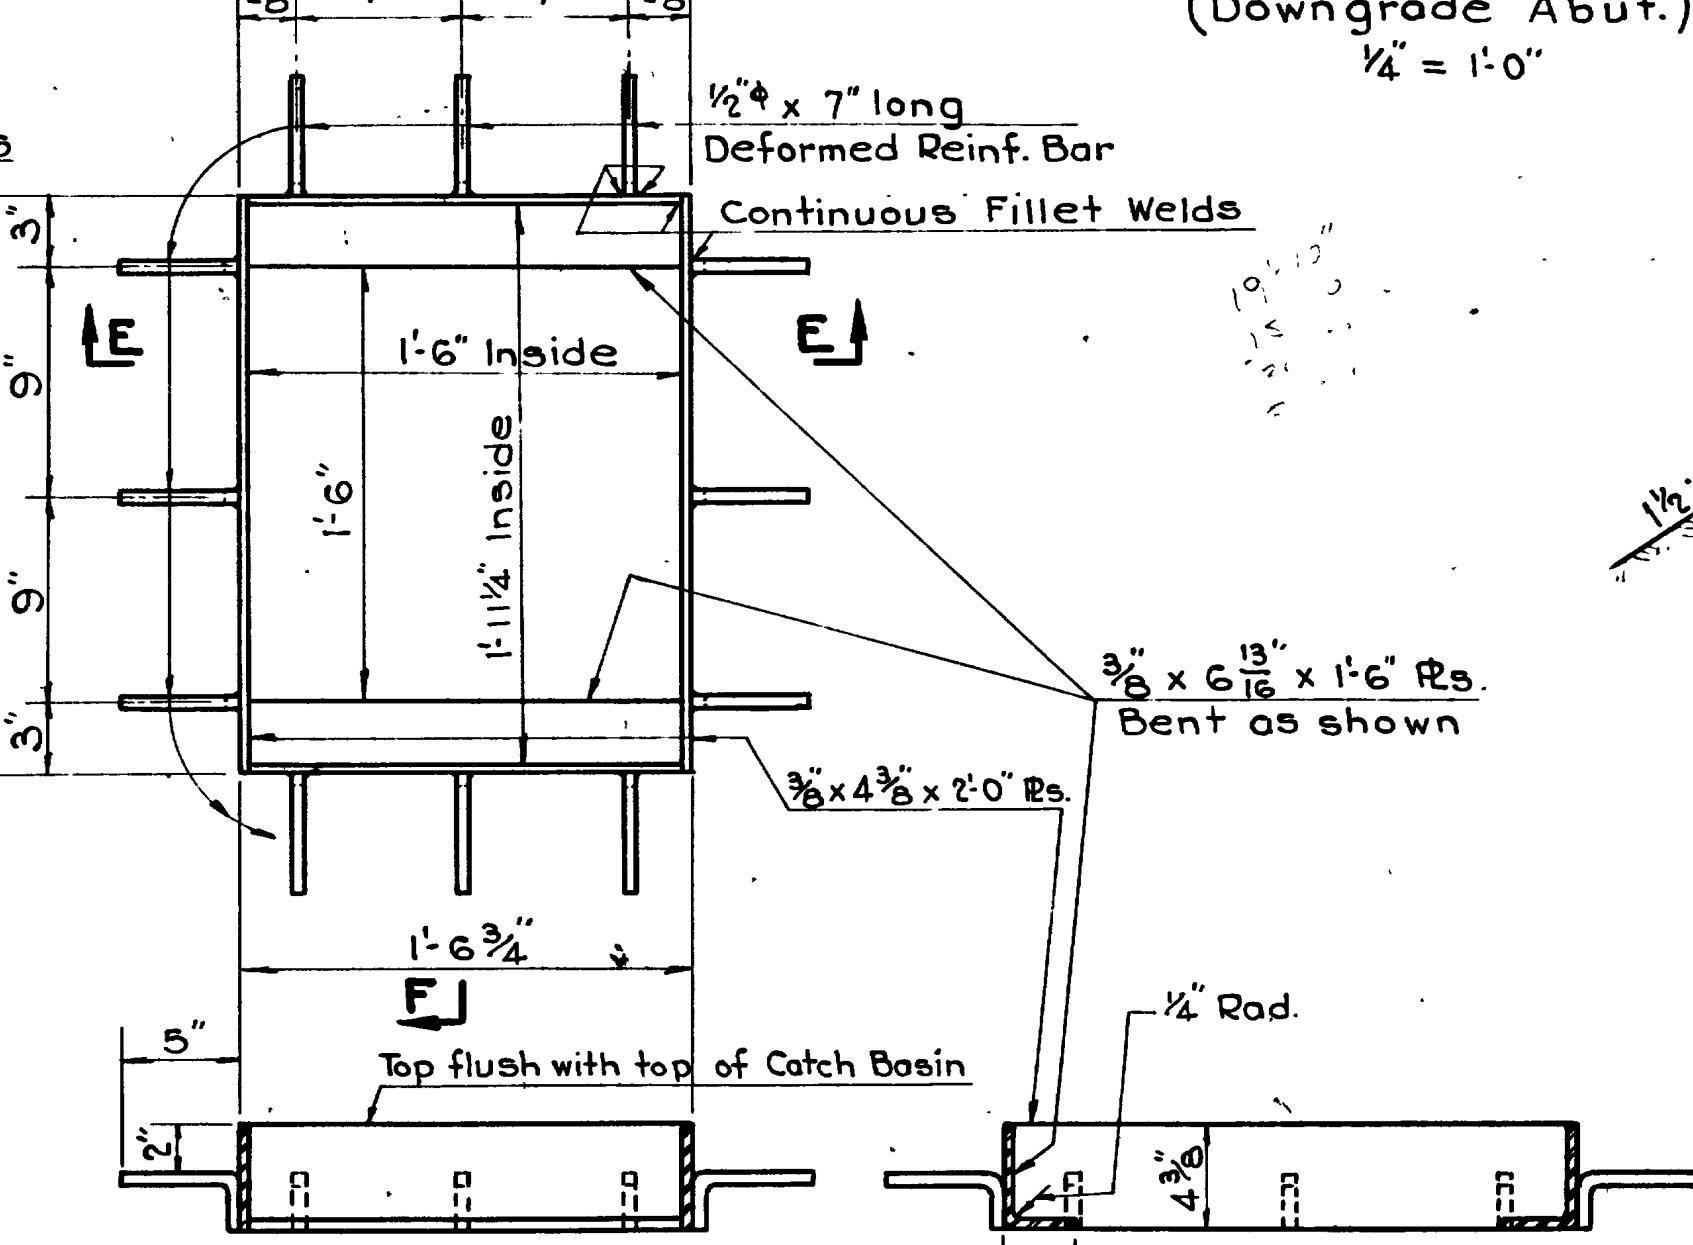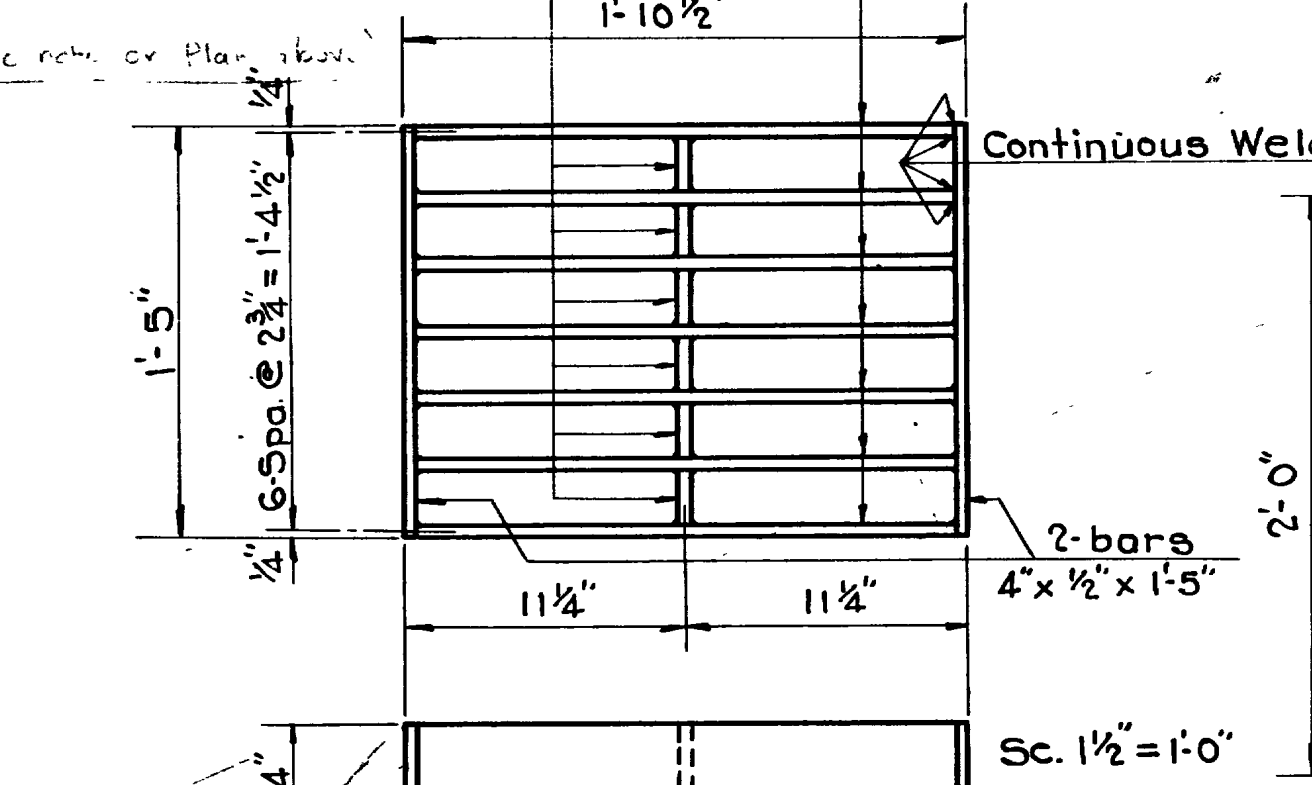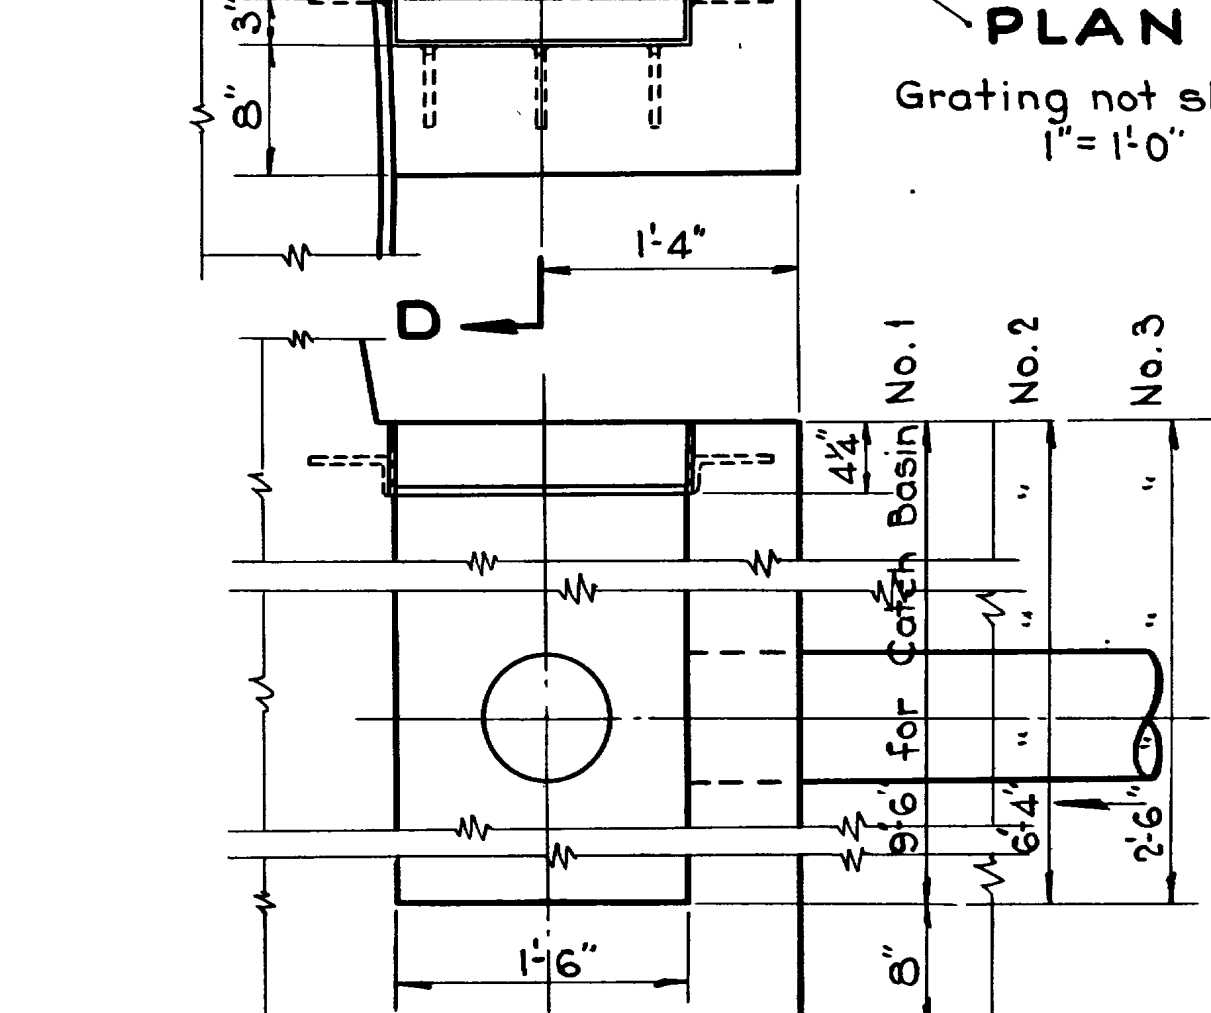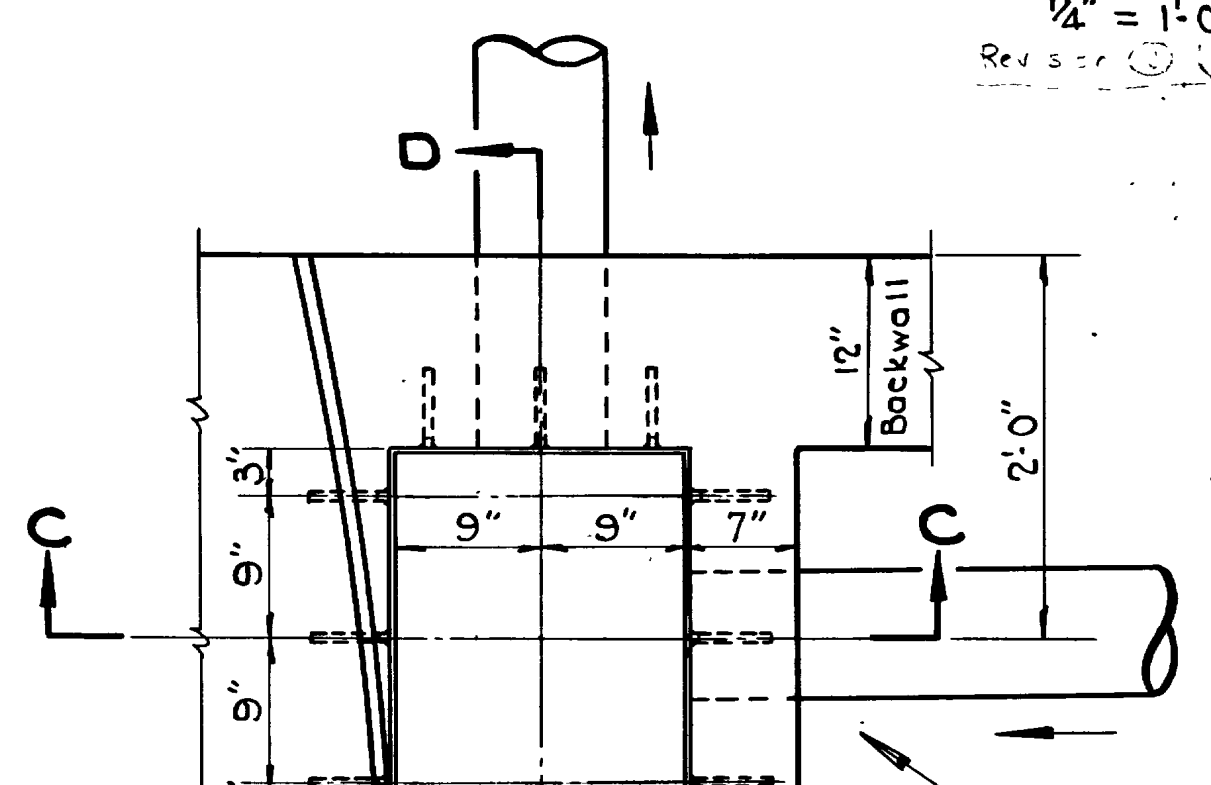

Sheet 7 of 12 sheets
 UTAH STATE ROAD COMMISSION
 SALT LAKE CITY, UTAH
 EZRA C. KNOWLTON, CHIEF ENGINEER
BRIDGE OVER U.P. & L. CO'S PENSTOCKS
 A.W. (P.C.E.) F.A.P. 222-A(0)
 Sta. 52 + 50 Weber Co.
 Ogden Arsenal- Riverdale

DESIGNED BY: F.M.E. SCALE: As noted
 DRAWN BY: J.M.B. ISSUED: May 27, 1951
 CHECKED BY: J.M.B. APPROVED: J.M.B.
 REVISIONS: 1, 2
 No. 29-259-1-2 DRG. NO. D-466

FED. ROAD DIST. NO.	STATE	FED. AID PROJ. NO.	FISCAL YEAR	SHEET NO.	TOTAL SHEETS
12	UTAH	222-A0			

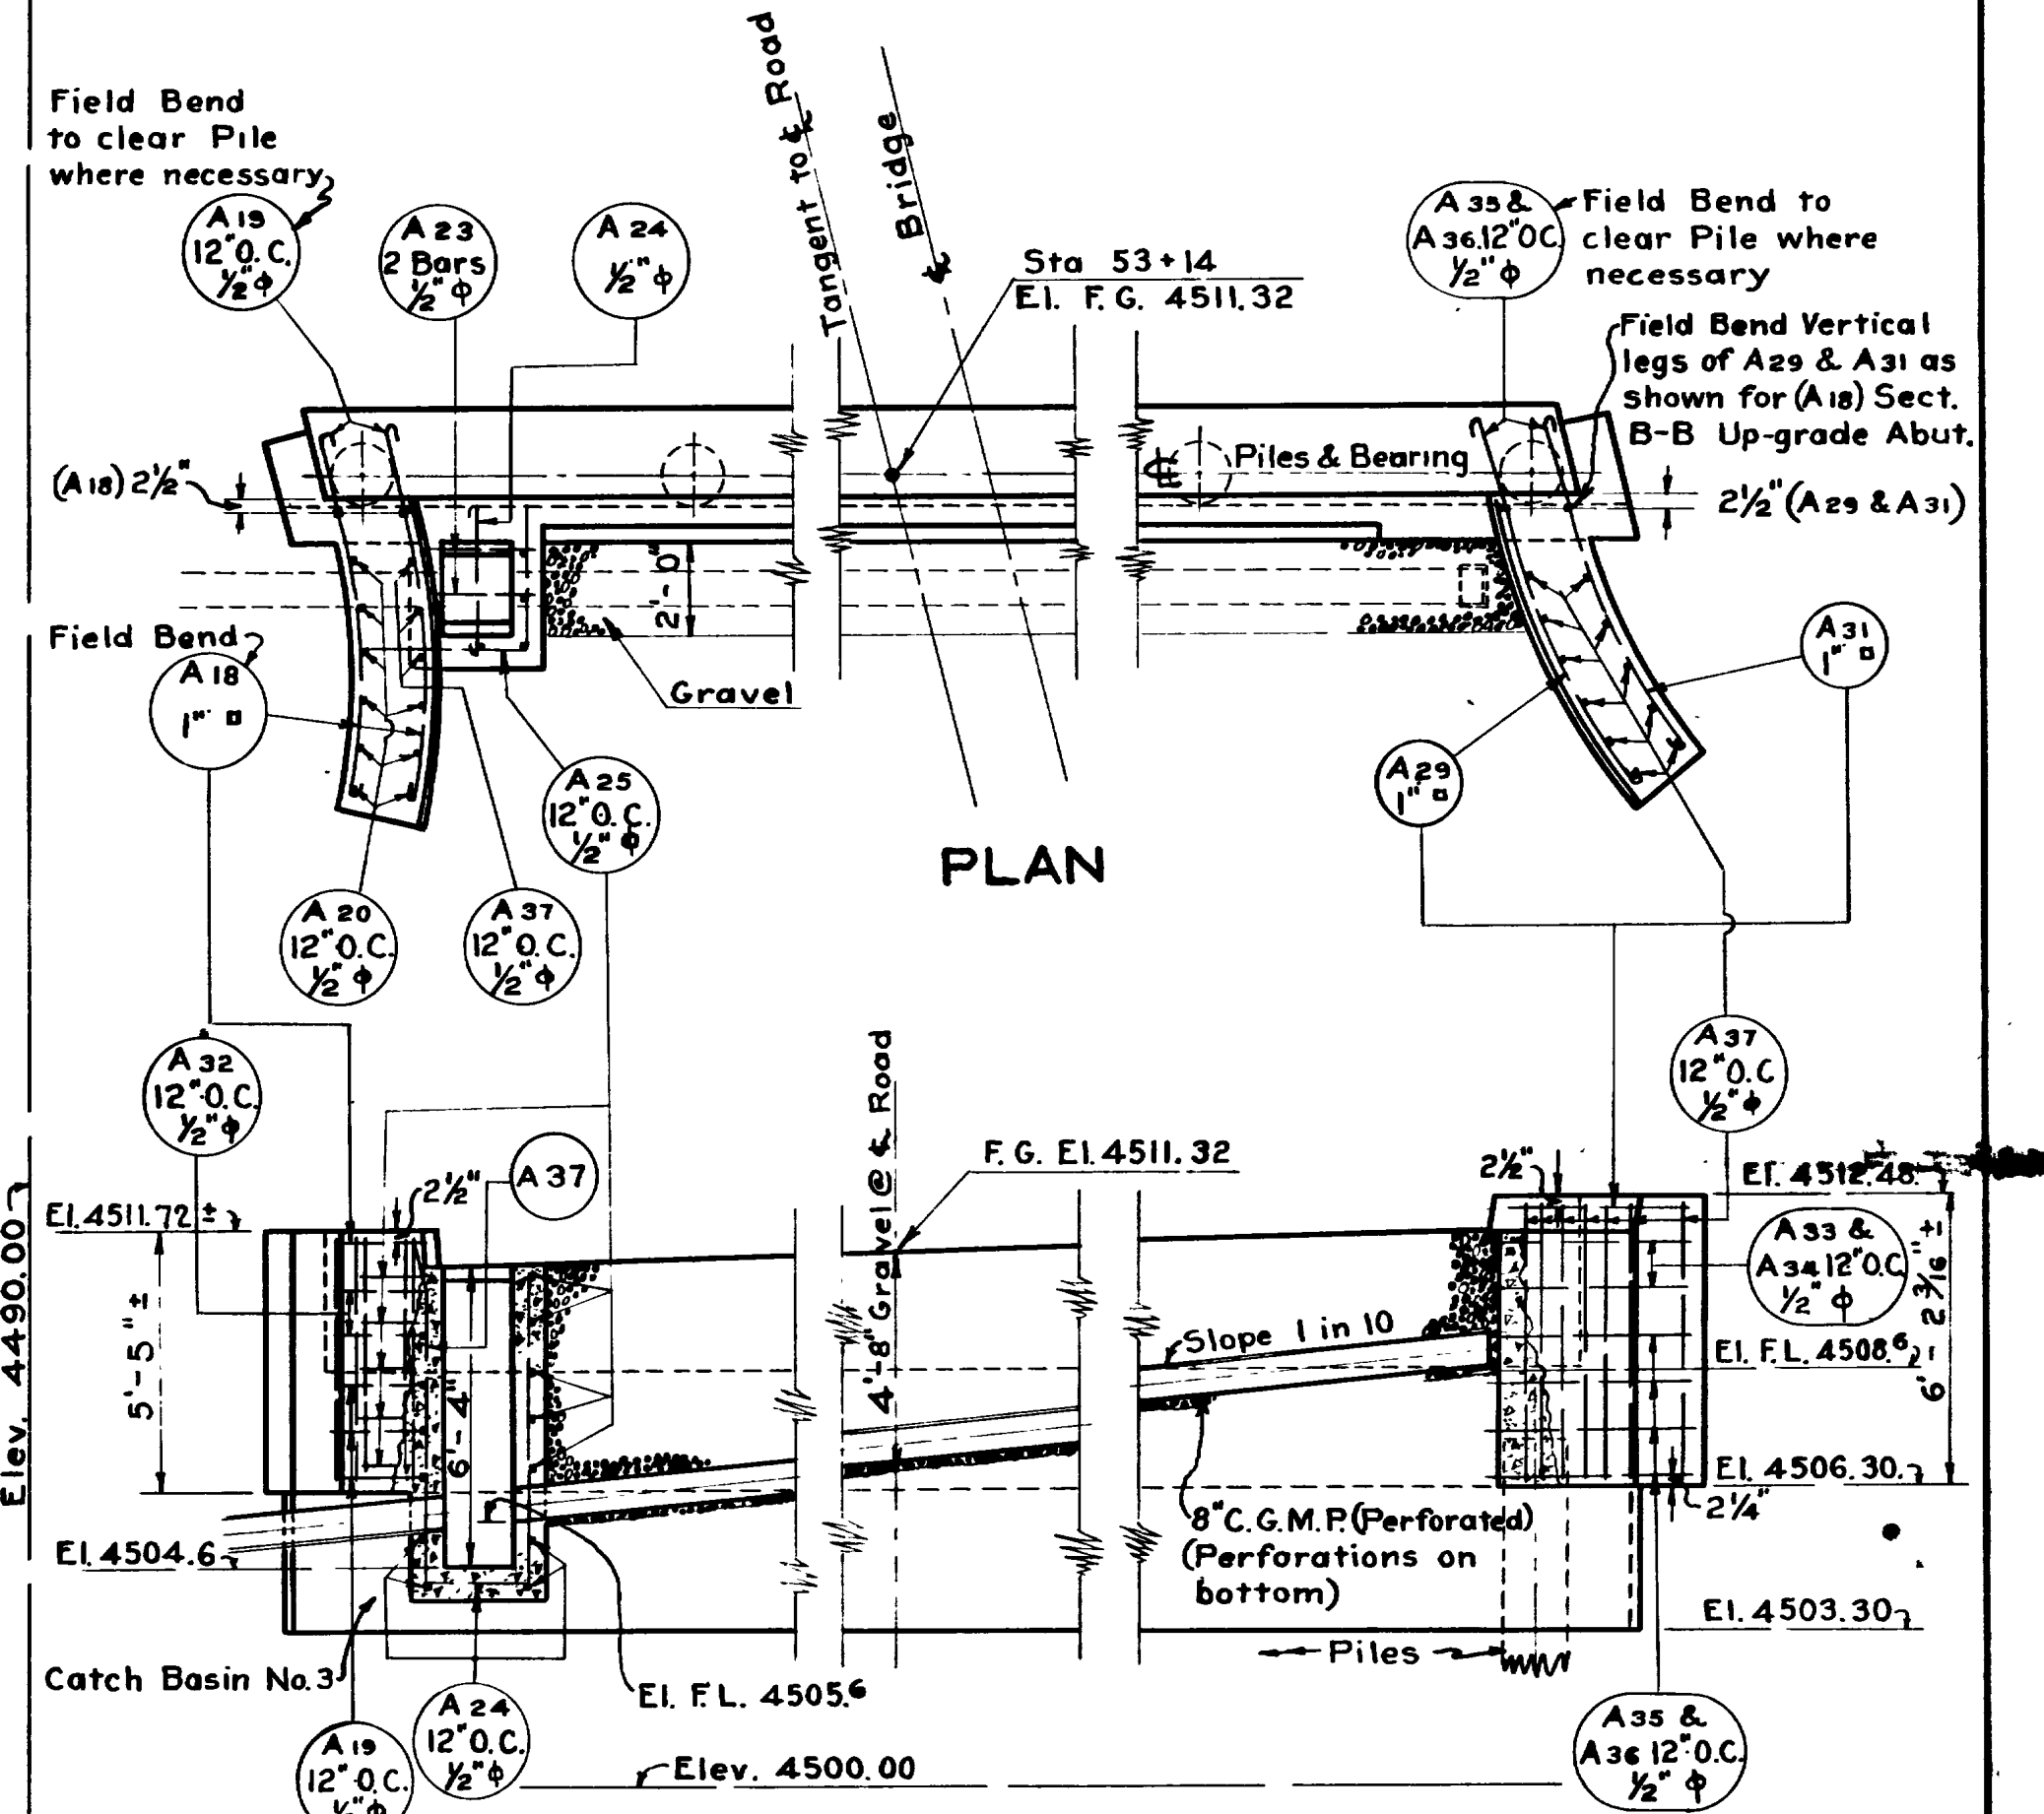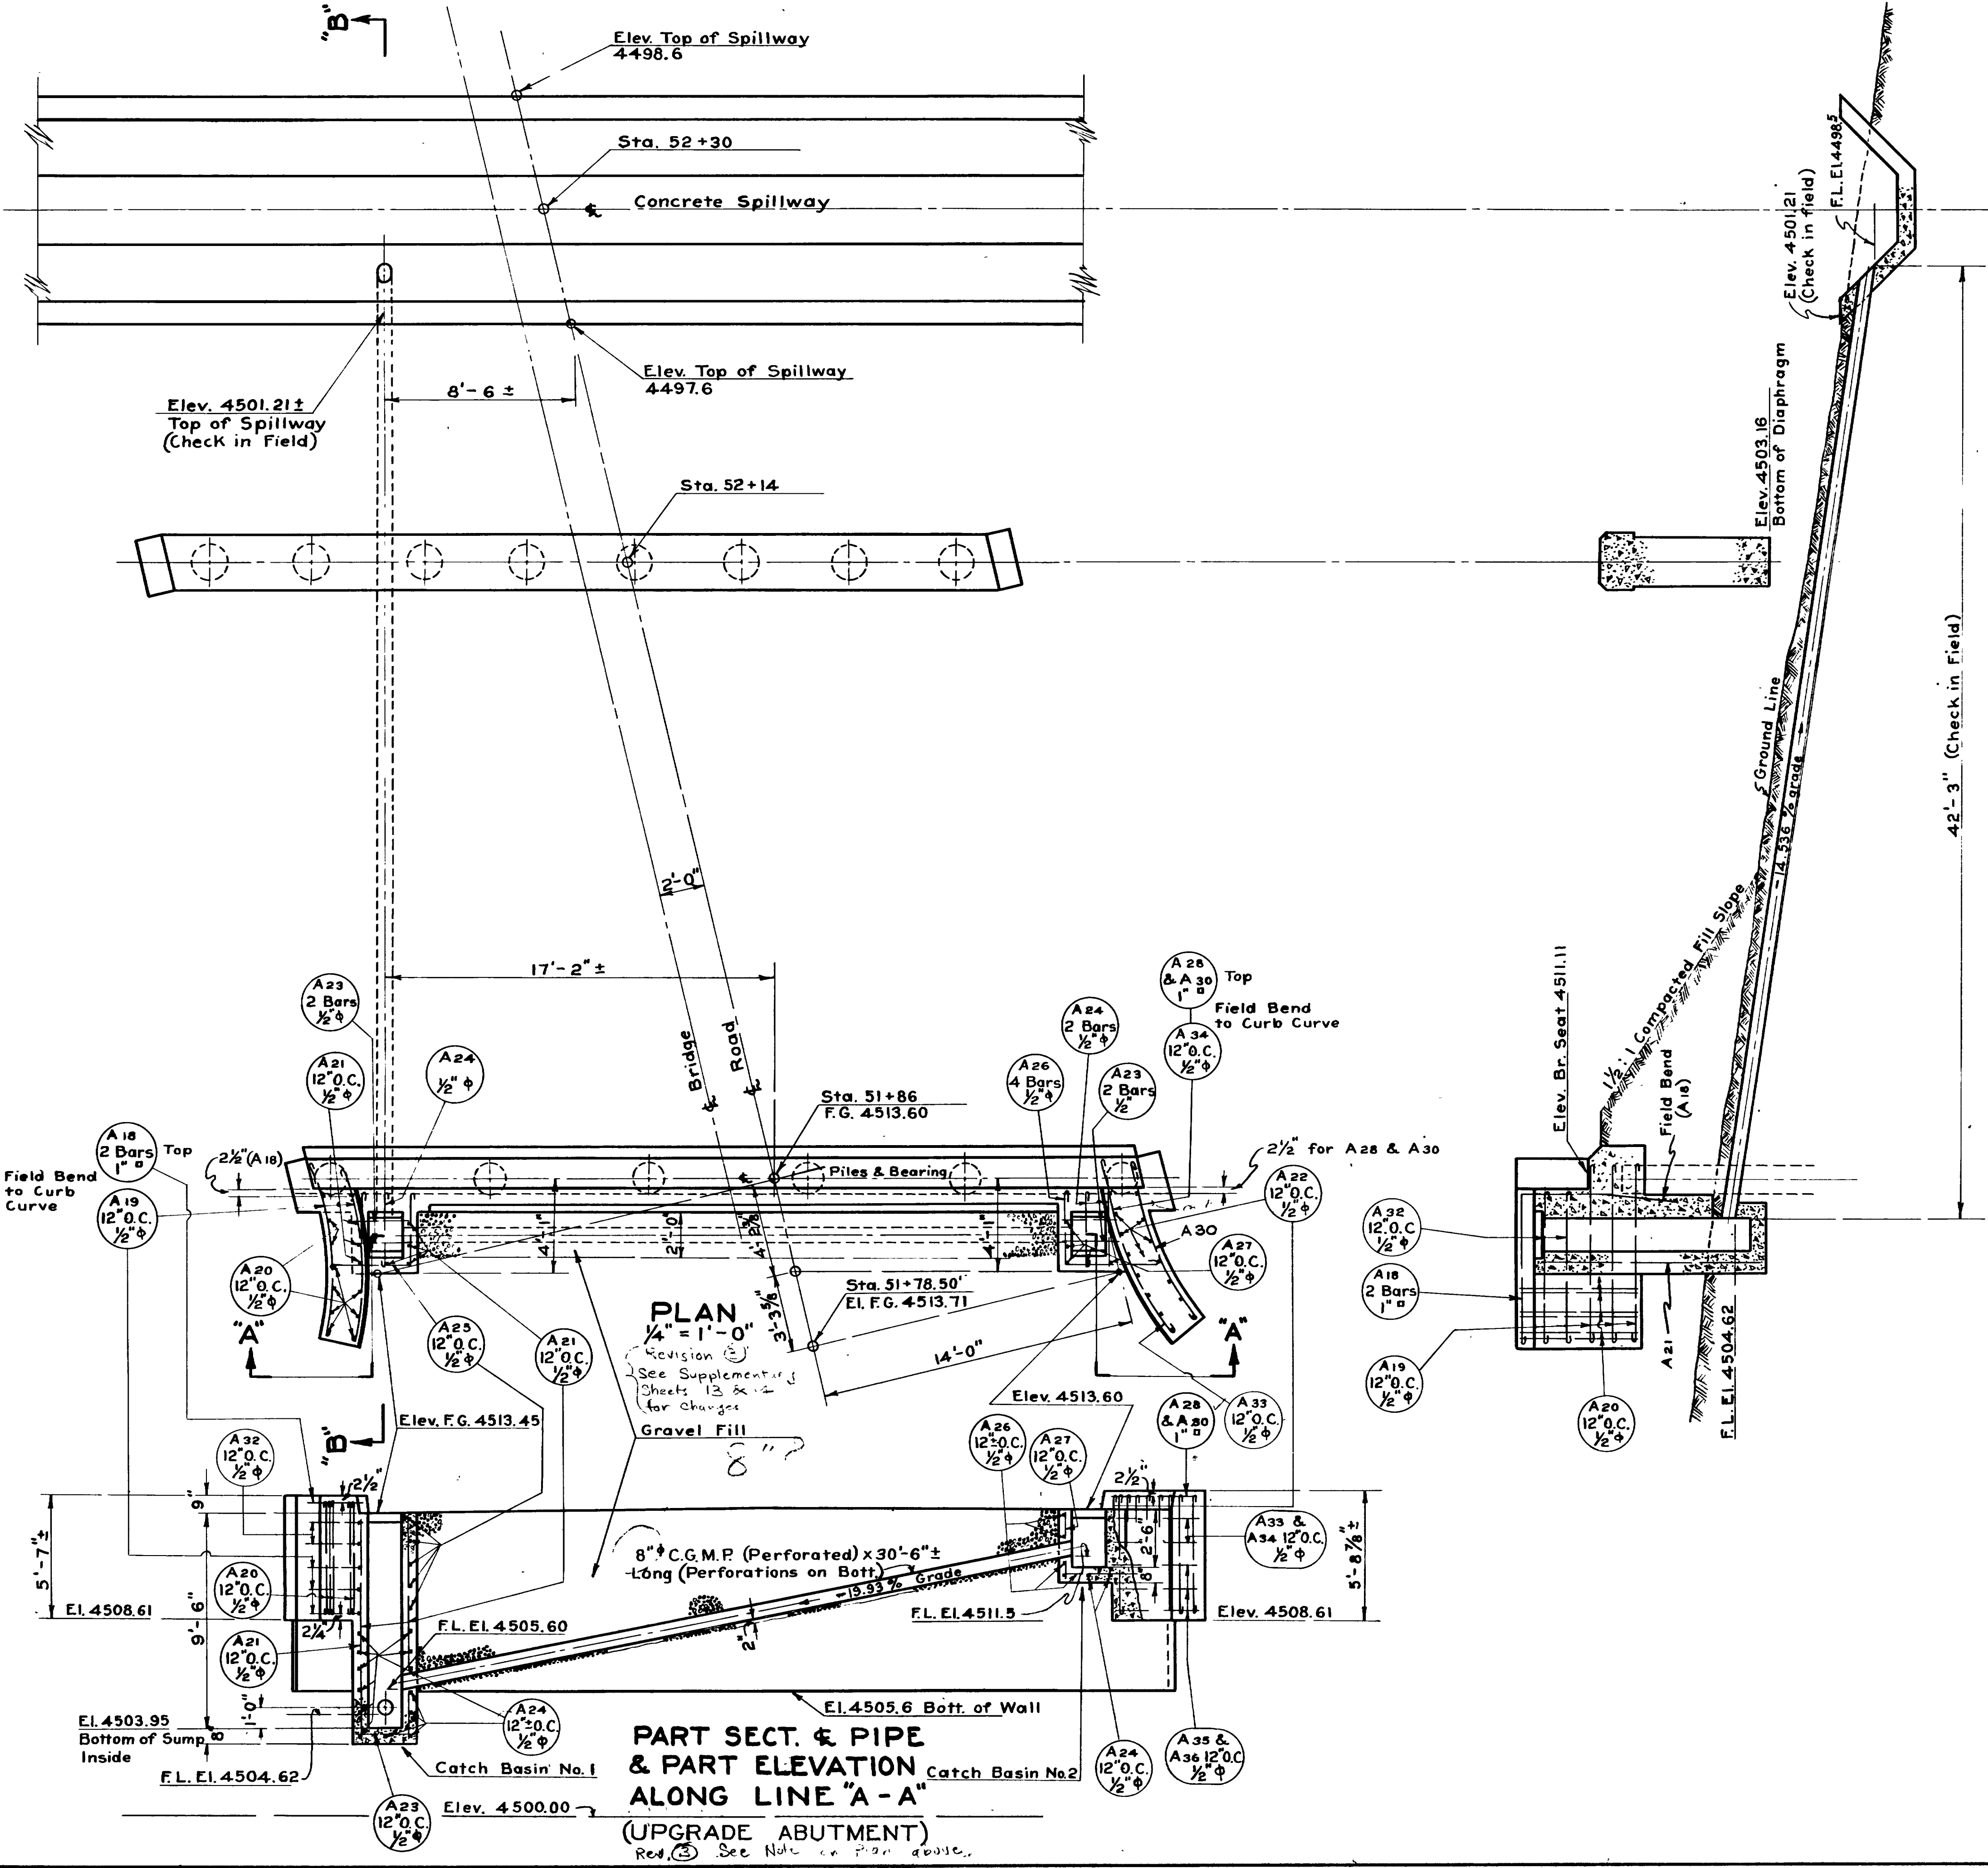

PART SECT. & PIPE & PART ELEVATION ALONG LINE "A-A" (UPGRADE ABUTMENT)
 See Note on page above.

MANHOLES & CURBS

Sheet 8 of 12 sheets
 UTAH STATE ROAD COMMISSION
 SALT LAKE CITY - UTAH
 EZRA C. KNOWLTON, CHIEF ENGINEER

BRIDGE OVER U.P. & L. CO'S PENSTOCKS
 A.W.(P.C.E.) F.A.P. 222-A(0)
 Sta. 52+50 Weber Co.
 Ogden Arsenal - Riverdale

DESIGNED BY: F.M.E. SCALE: As noted
 DRAWN BY: J.H.D. ISSUED: May 27, 1951
 CHECKED BY: APPROVED: [Signature]
 EXAMINED BY: [Signature]


SP: 29-259-1-2 DMC: D-466

REVISIONS


NO.	DATE	BY	DESCRIPTION
1	Jan 27, 1951	J.H.D.	As noted

FED. ROAD DIST. NO.	STATE	FED. AID PROJ. NO.	FISCAL YEAR	SHEET NO.	TOTAL SHEETS
12	UTAH	212-A(1)			

REVISIONS	DATE	BY

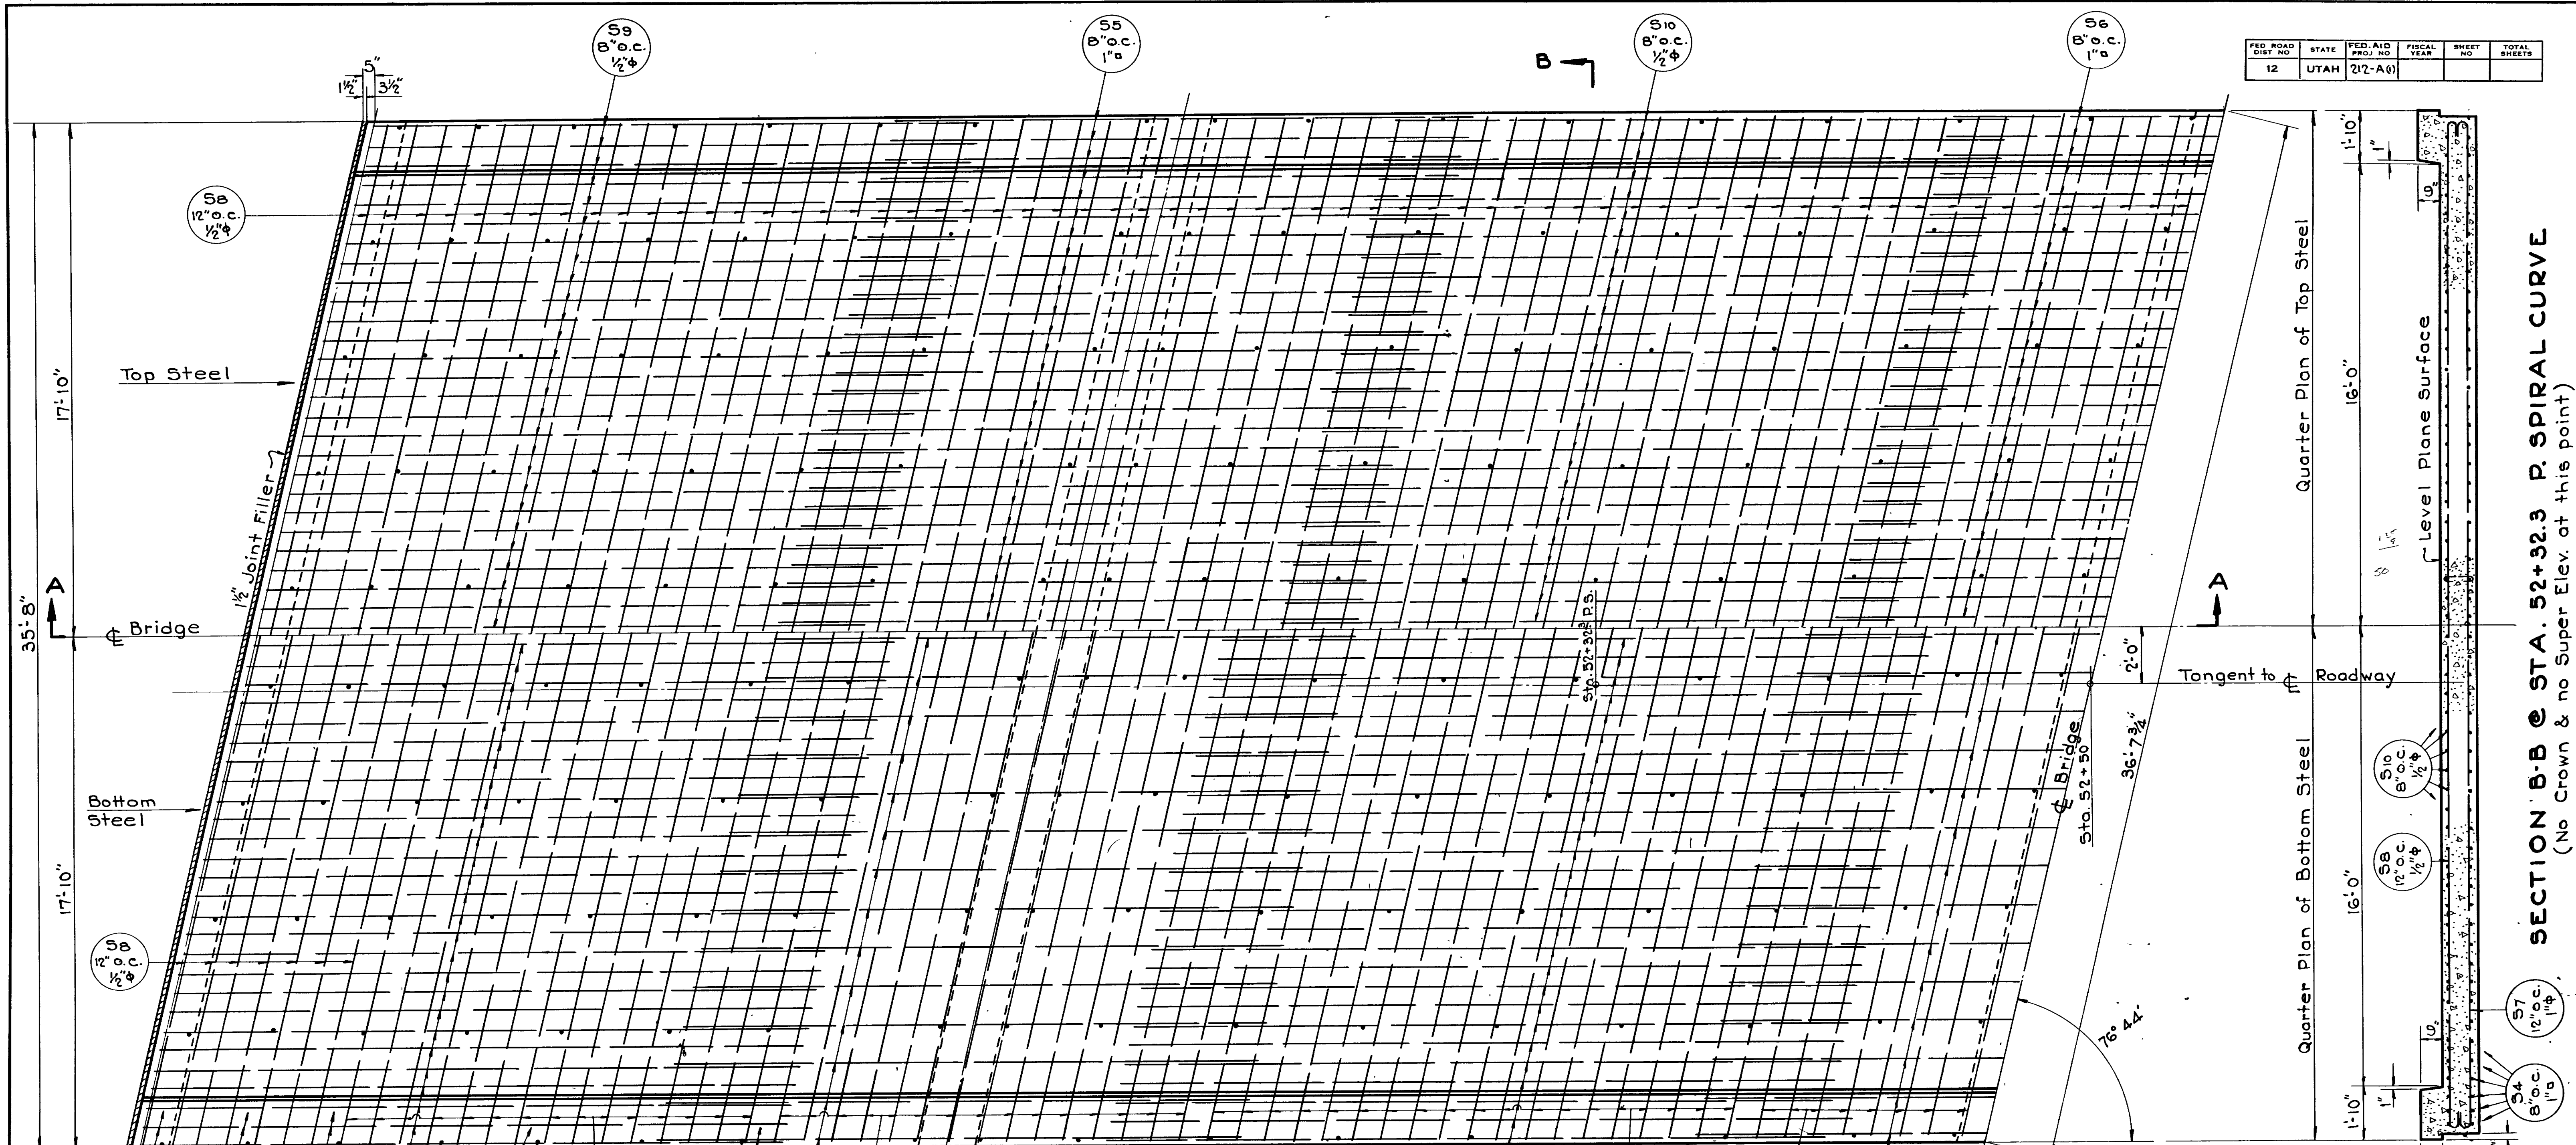

HALF PLAN

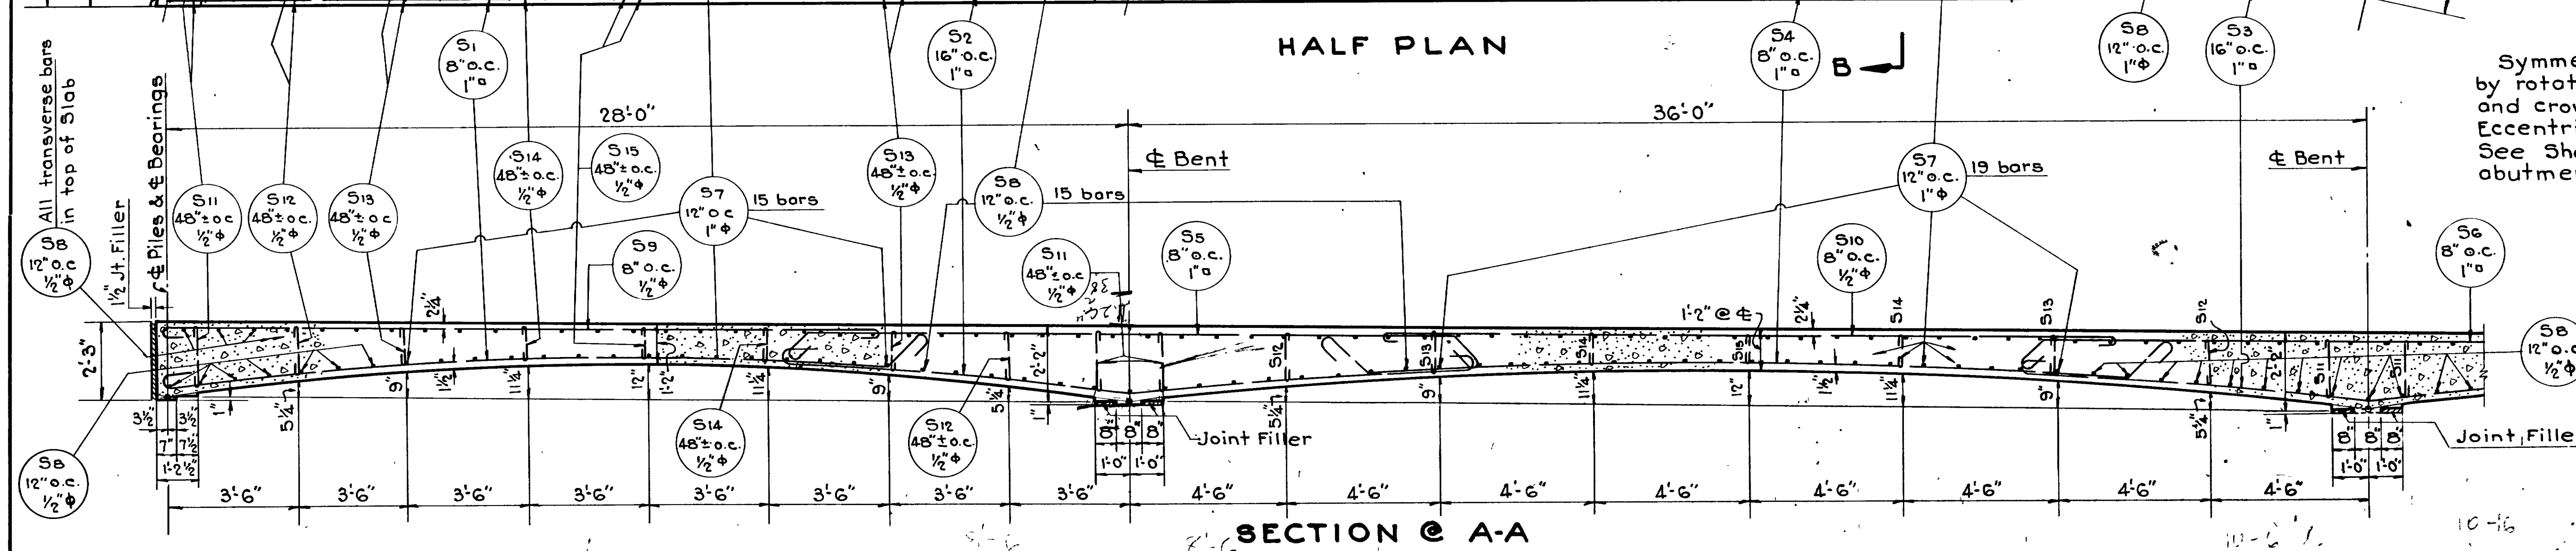


SECTION @ A-A

Symmetrical about Bridge Center Lines by rotation, except for super-elevation and crown, or where shown otherwise. Eccentric with Φ of Road as shown. See Sheet 6 for details of bearings on abutments and interior bents.







DECK STEEL
See A-406

Sheet 9 of 12 sheets
 UTAH STATE ROAD COMMISSION
 SALT LAKE CITY - UTAH
 EZRA C. KNOWLTON, CHIEF ENGINEER
 BRIDGE OVER U.P. & L. CO'S
 PENSTOCKS
 A.W.(P.C.E.) FAR 222-A(1)
 Sta. 52+50 Weber Co.
 Ogden Arsenal - Riverdale
 DRAWN BY F.M.E. SCALE 3/8" = 1'-0"
 CHECKED BY J.H.B. DATE 10-22-1911
 APPROVED BY *Chas. W. Martin*
 No. 29-259-1-2 D.P.D. No. D-466

SECTION B-B @ STA. 52+32.3 P. SPIRAL CURVE
(No Crown & no Super Elev. at this point)

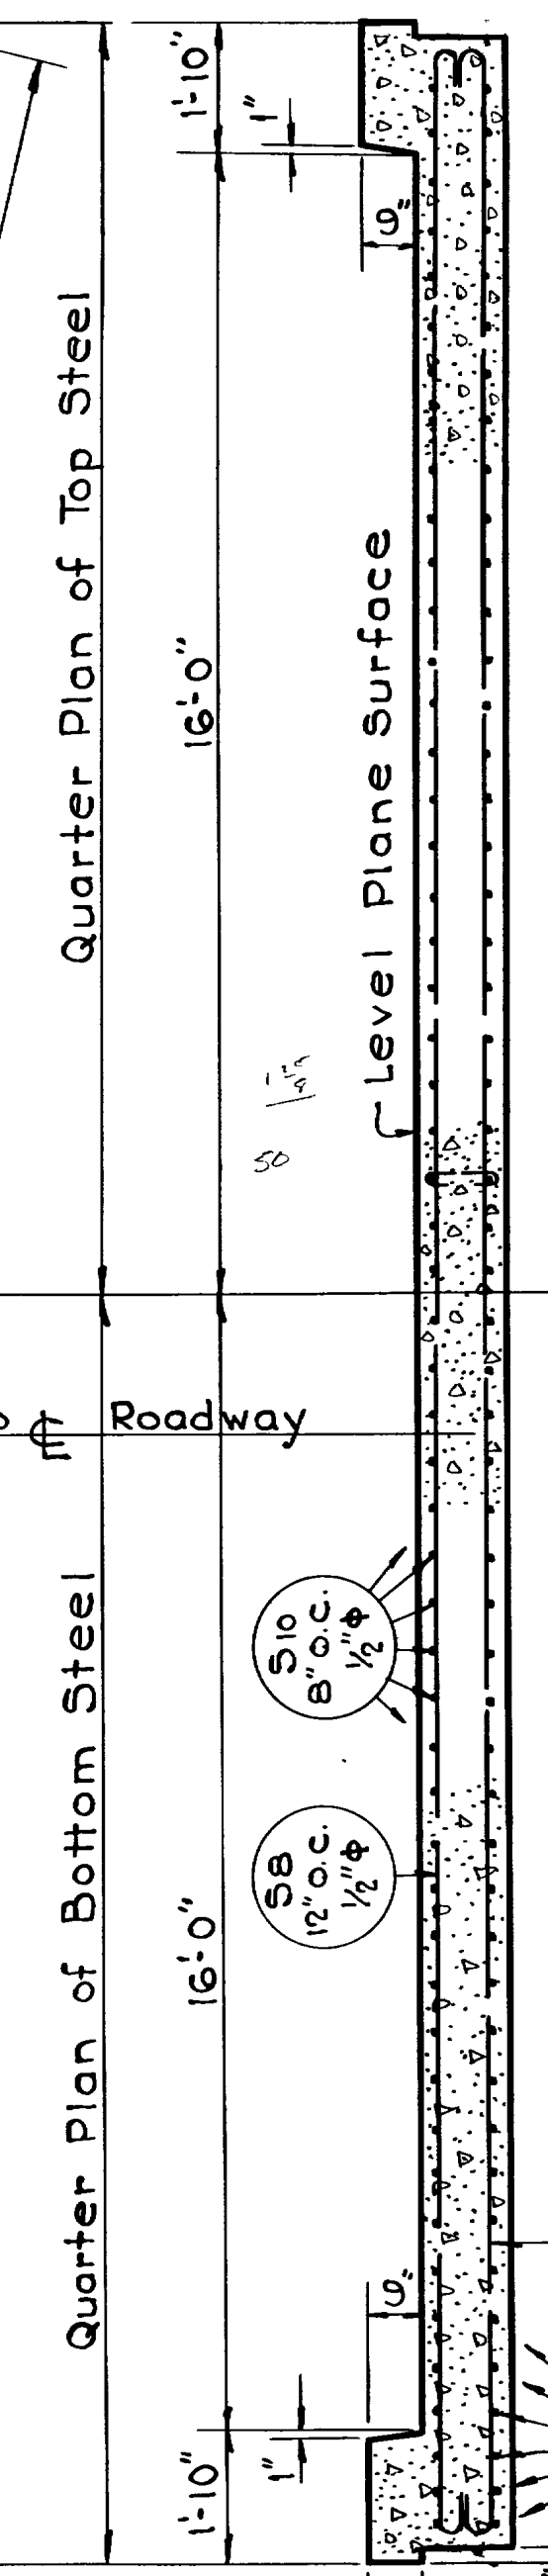

FED. ROAD DIST. NO.	STATE	FED. AID PROJ. NO.	FISCAL YEAR	SHEET NO.	TOTAL SHEETS
12	UTAH	222-A(1)			

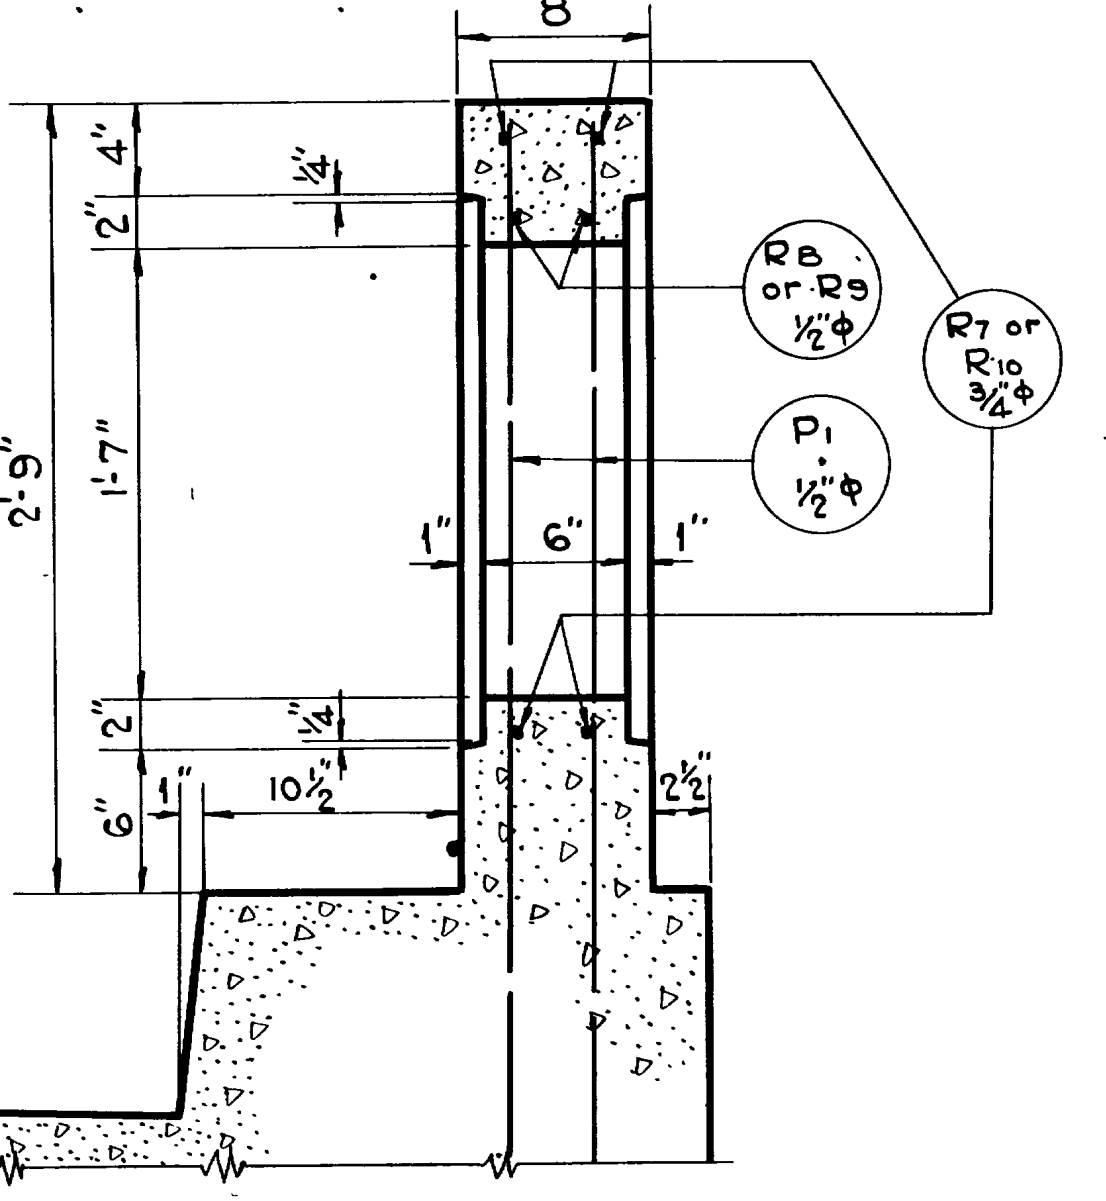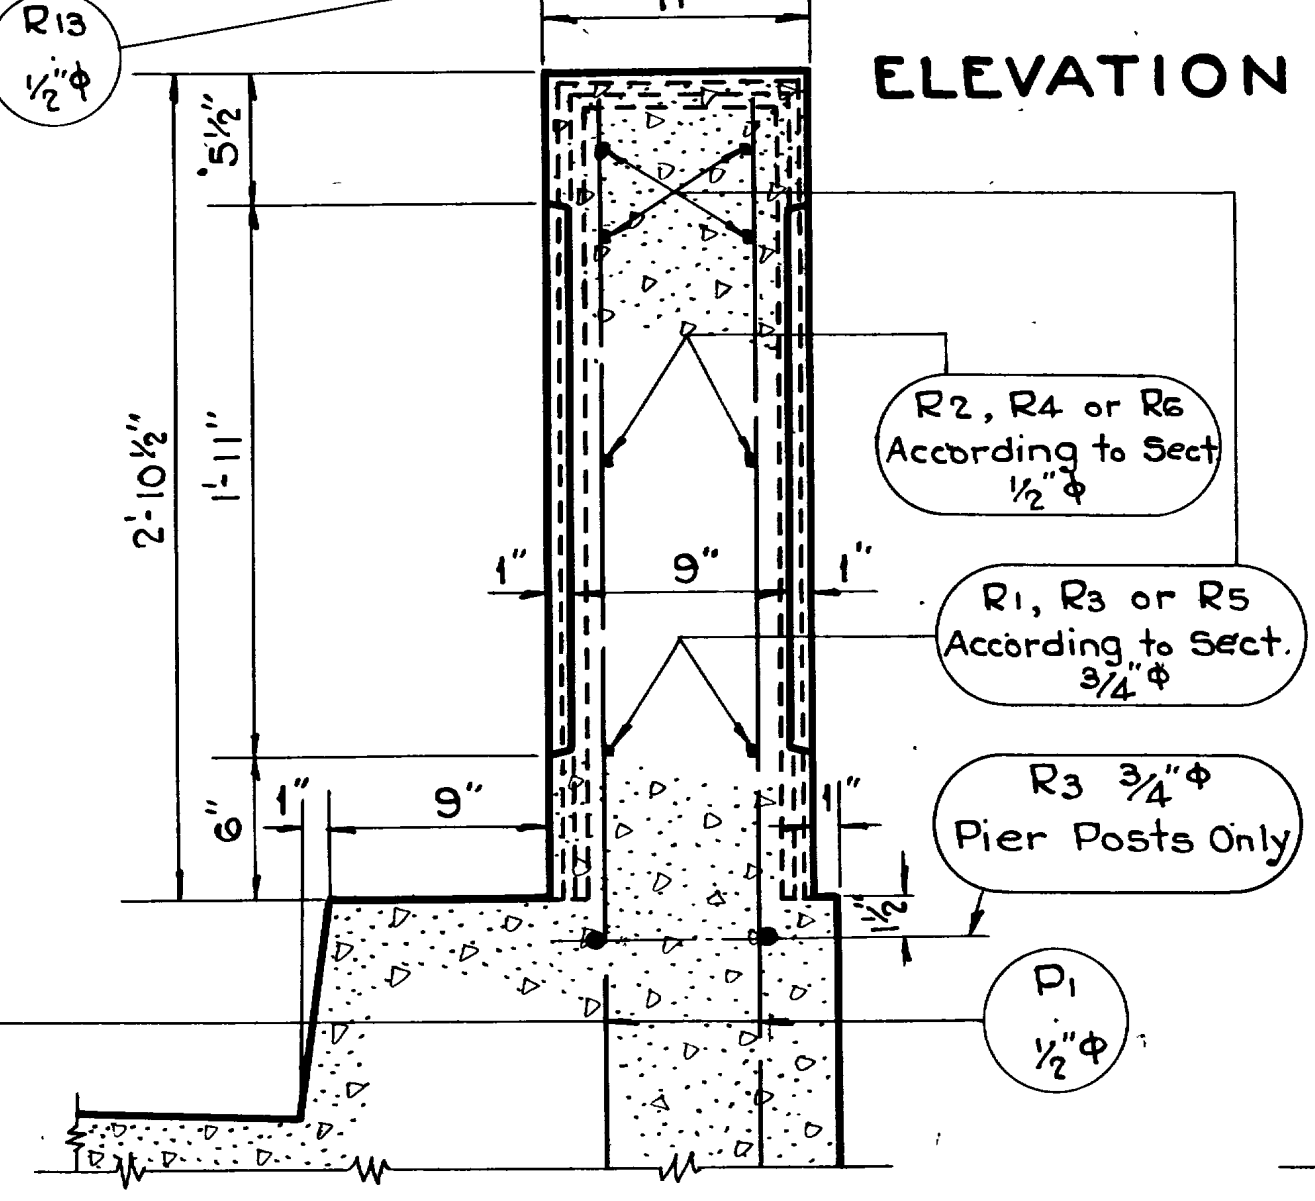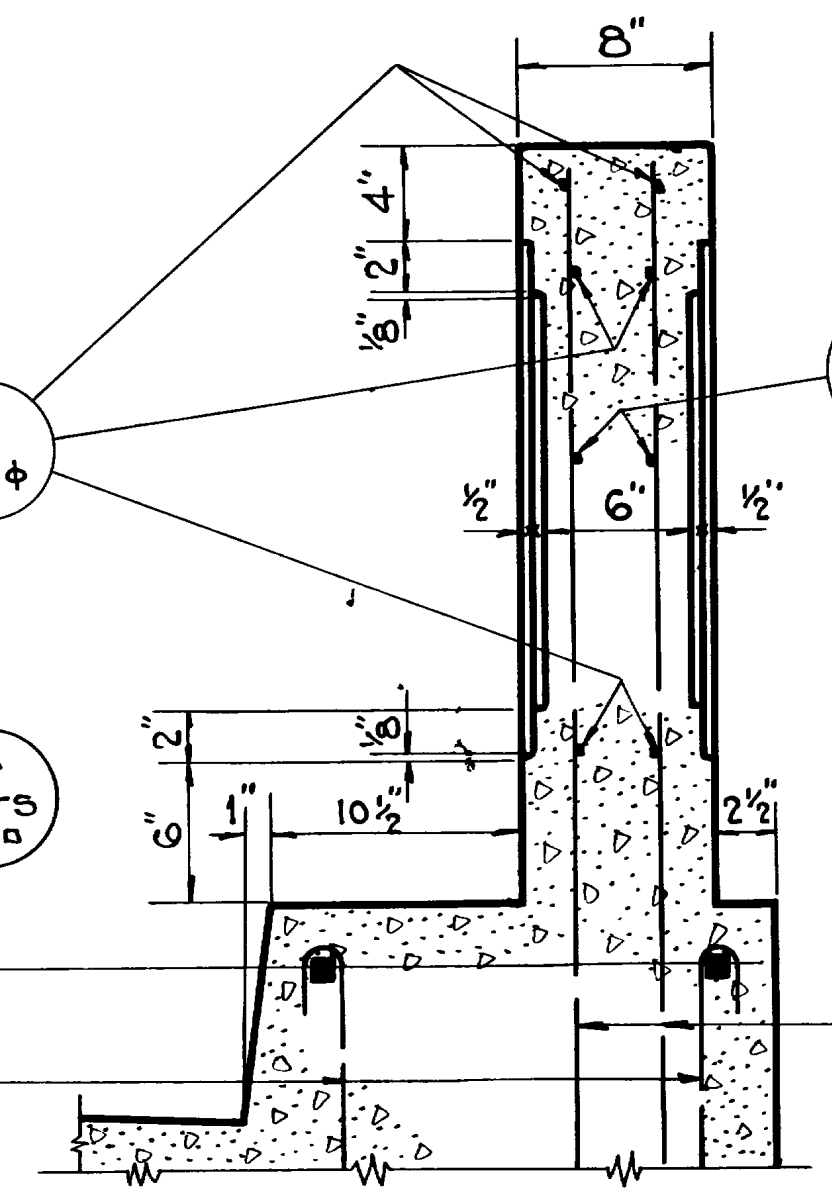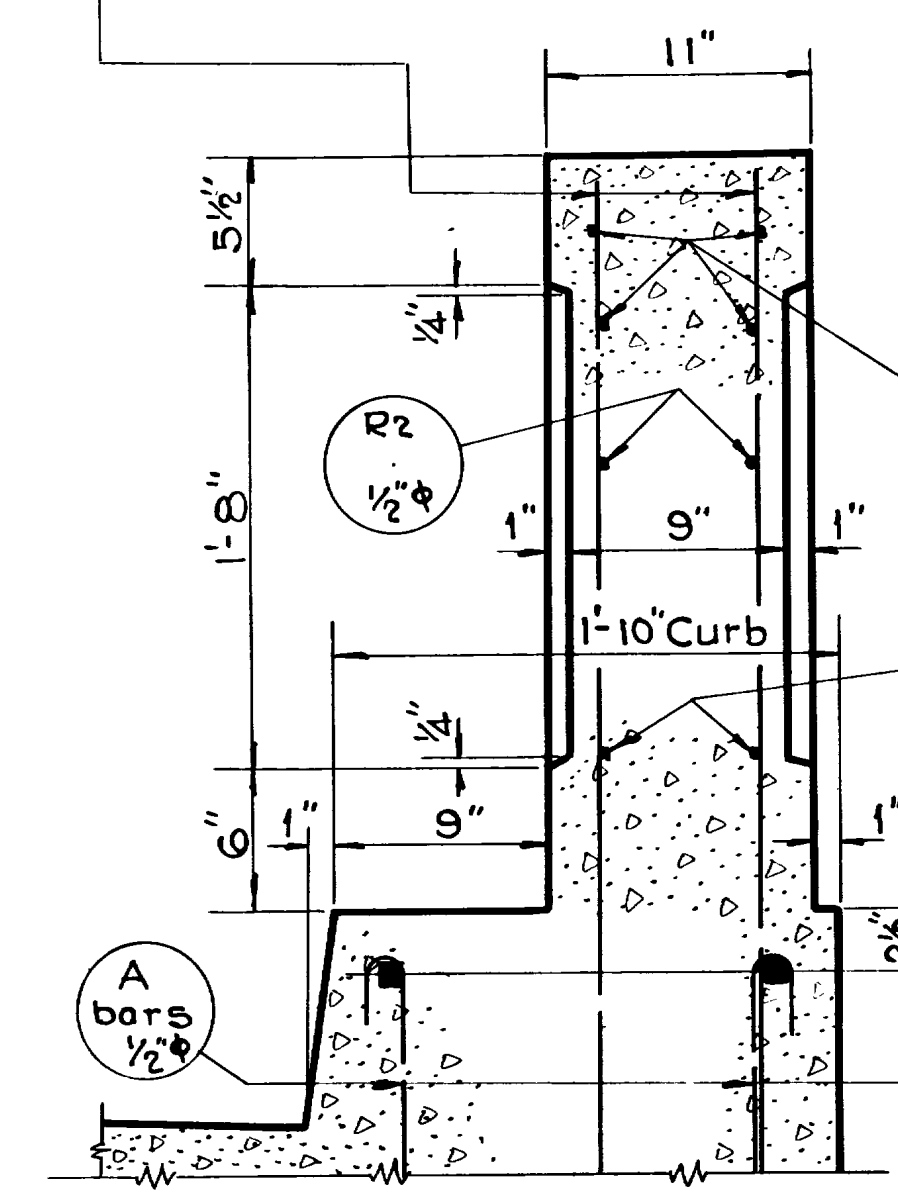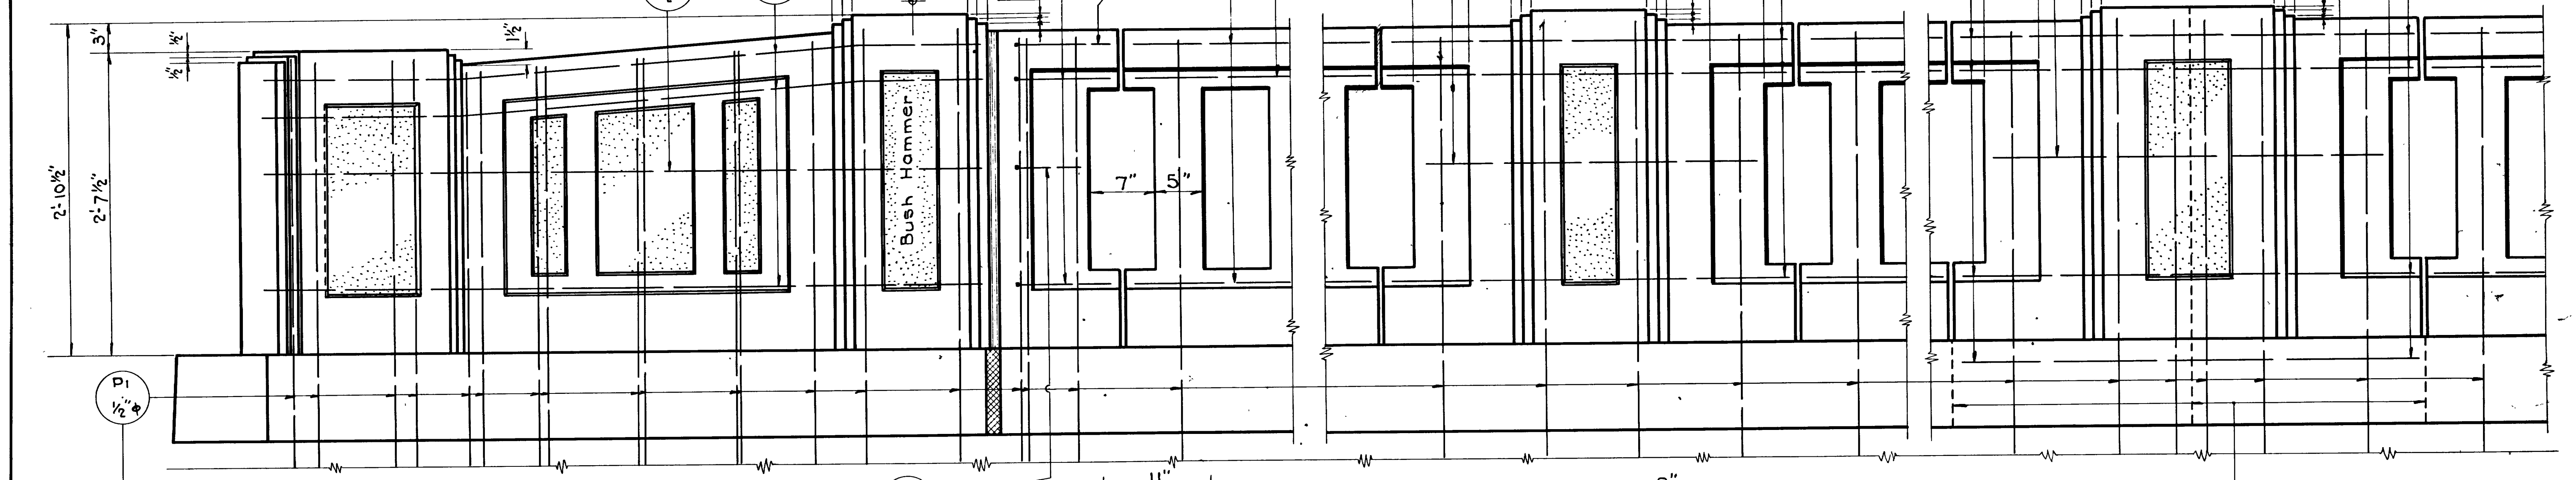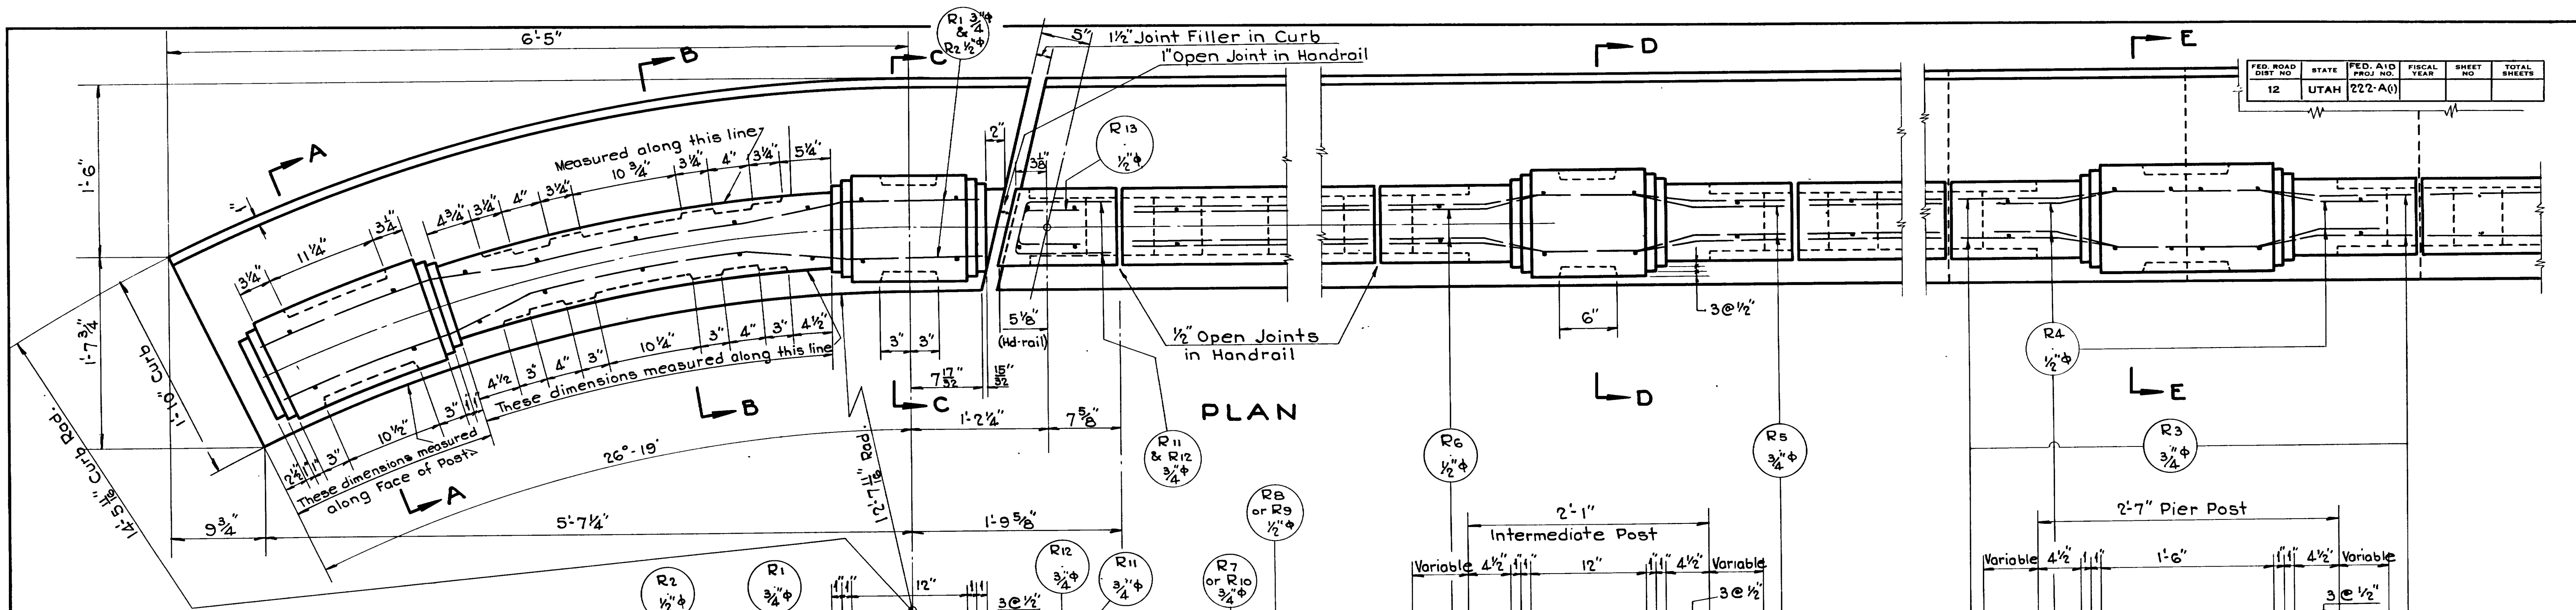

SECTION A-A

SECTION B-B

SECTION C-C, D-D, & E-E

SECTION THRU RAILING

CONCRETE QUANTITIES

One End Post	13.00 Cu. Ft.
One Pier Post	4.69 " "
One Intermediate Post	3.38 " "
Railing per Lin. Ft.	1.19 " "
Variable Portion of Railing per Lin. Ft.	1.51 " "

HAND RAIL

Sheet 10 of 12 sheets
 UTAH STATE ROAD COMMISSION
 SALT LAKE CITY, UTAH
 ERIC C. KNOWLTON, CHIEF ENGINEER
 BRIDGE OVER U.P. & L.C.O.S.
 DENSTOCKS
 A.W. (P.C.E.) F.A.P. 222-A(1)
 Sta. 52+50 Weber Co.
 Ogden Arsenal-Riverdale
 DESIGNED BY: F.M.E. SCALE: 1/4" = 1'-0"
 DRAWN BY: J.H.B. ISSUED: May 20, 1941
 CHECKED BY: APPROVED: [Signature]
 No. 20-252-2 Drg. No. D-466

REVISIONS

NO.	DATE	BY

MARK	LOCATION	SIZE	LGTH	No. BARS	TOTAL LENGTH	SKETCH	0. To 0.
A 8	Abutments	1/2"	10'-6"	74	777'-0"		
A 9	Down-grade Abut.	8'-6"	4	34'-0"			7'-5"
A 10		8'-7"	4	34'-4"			7'-6"
A 11		8'-8"	4	34'-8"			7'-7"
A 12		8'-9"	4	35'-0"			7'-8"
A 13		8'-10"	4	35'-4"			7'-9"
A 14		8'-11"	4	35'-8"			7'-10"
A 15		9'-0"	4	36'-0"			7'-11"
A 16		9'-1"	5	45'-5"			8'-0"
A 17	Down-grade Abut.	1/2"	10'-0"	3	30'-0"		8'-11"
S 1	Deck Slab Bottom (28' Spans)	1"	24'-10"	108	2682'-0"	See Sketch	22'-5"
S 2	Deck Slab Bottom	1"	22'-6"	56	1260'-0"	See Sketch	20'-4"

MARK	LOCATION	SIZE	LGTH	No. BARS	TOTAL LENGTH	SKETCH	0. To 0.
S 3	Deck Slab Bottom (Over Center Bent)	1"	22'-6"	28	630'-0"	See Sketch	20'-4"
S 4	Deck Slab Bottom (36'-0" Spans)	1"	27'-9"	108	2997'-0"	See Sketch	24'-10"
S 5	Deck Slab Top	1"	23'-0"	108	2484'-0"	See Sketch	20'-0 1/2"
S 6	Deck Slab Top	1"	23'-2"	54	1251'-0"	See Sketch	20'-2"
S 7	Deck Slab Bottom (Trans)	1"	38'-2"	68	2595'-4"		36'-0"
S 8	Deck Slab Top & Bottom	1/2"	37'-1"	189	7008'-9"		36'-0"
S 9	Deck Slab Top (28' Spans)	1/2"	22'-0"	108	2376'-0"		20'-11"
S 10	Deck Slab Top (36' Spans)	1/2"	22'-6"	108	2430'-0"		21'-5"

MARK	LOCATION	SIZE	LGTH	No. BARS	TOTAL LENGTH	SKETCH	0. To 0.
S 11	Deck Slab	1/2"	3'-0"	80	240'-0"	Inside Hooks A = 1'-9 1/2"	1'-10 1/2"
S 12		2'-8"		213'-4"		Ditto but A = 1'-5 3/4"	1'-6 3/4"
S 13		2'-4"		186'-8"		A = 1'-2"	1'-3"
S 14		2'-2"		173'-4"		A = 0'-11 3/4"	1'-0 3/4"
S 15	Deck Slab	1/2"	2'-1"	40	86'-8"	Ditto but A = 0'-11"	1'-0"
A 18	Abutment Curb	1"	14'-0"	2	28'-0"	Field Bend A = 6'-4"	6'-7"
A 19		1/2"	9'-3"	12	111'-0"		8'-2"
A 20	Abutment Curb	1/2"	6'-4"	16	101'-4"		5'-3"
A 21	Up-grade Abut.	9'-10"	7	68'-10"			
A 22	Up-grade Abut.	6'-6"	13	84'-6"			5'-5"
A 23	Both Abutments	2'-6"	6	15'-6"			
A 24	Both Abutments	4'-4"	11	47'-8"			3'-3"
A 25	Downgrade Abut.	7'-9"	5	38'-9"			
A 26	Up-grade Abut.	8'-3"	4	33'-0"		Ditto but A = 3'-11"	
A 27	Up-grade Abut.	1/2"	2'-10"	5	15'-0"		

MARK	LOCATION	SIZE	LGTH	No. BARS	TOTAL LENGTH	SKETCH	0. To 0.
A 28	Up-grade Abut.	1"	14'-0"	1	14'-0"	A = 7'-1"	
A 29	Down-grade Abut.	15'-6"	1	15'-6"		7'-1" 7'-4"	
A 30	Up-grade Abut.	13'-0"	1	13'-0"		6'-1" 5'-10"	
A 31	Down-grade Abut.	14'-6"	1	14'-6"		6'-1" 7'-4"	
A 32		1/2"	7'-6"	4	30'-0"		6'-5"
A 33		8'-2"	2	16'-4"			7'-1"
A 34	Downgrade Abut.	7'-2"	2	14'-4"			6'-1"
A 35	Both Abutments	10'-0"	7	70'-0"			8'-11"
A 36	Both Abutments	9'-0"	7	63'-0"			7'-11"
A 37	Down-grade Abut.	1/2"	7'-0"	11	77'-0"		5'-11"
P 1	Hand Rail	1/2"	4'-3"	624	2652'-0"		
R 1	End Posts	3/4"	6'-3"	24	150'-0"		Field Bend
R 2	End Posts	1/2"	6'-3"	8	50'-0"		
R 3	Pier Posts	3/4"	2'-0"	96	192'-0"		
R 4	Pier Posts	1/2"	1'-8"	24	40'-0"		
R 5	Int. Post.	3/4"	3'-6"	96	336'-0"		Field Bend
R 6	Int. Post.	1/2"	3'-0"	32	96'-0"		"
R 7	Railing End Spans	3/4"	5'-8"	48	272'-0"		
R 8		1/2"	5'-8"	24	136'-0"		
R 9		1/2"	7'-8"	24	184'-0"		
R 10	Railing End Spans	3/4"	7'-8"	48	368'-0"		

REVISIONS
DATE BY
1 2/24 J.M.B.
2 3/10 J.M.B.
3 3/10 J.M.B.

MARK	LOCATION	SIZE	LGTH	No. BARS	TOTAL LENGTH	SKETCH	0. To 0.
R 11	End Spans	3/4"	2'-0"	8	16'-0"		
R 12	" "	3/4"	1'-10"	16	29'-4"		
R 13	End Spans	1/2"	1'-4"	8	10'-8"		

TOTAL REINFORCING STEEL
 7437.00 Lin. Ft 1/4" @ 0.167 # = 1242.0
 22705.17 23169.75 " " 1/2" @ 0.668 # = 15477.4 15137.0
 17463.75 " " 1/2" @ 0.850 # = 14844.2
 " " 5/8" @ 1.043 # = 16666.8
 1561.67 " " 3/4" @ 1.502 # = 2345.6
 13200.00 " " 7/8" @ 2.044 # = 1635.2 1471.7
 2595.33 " " 1" @ 2.670 # = 6929.5
 15267.15 15323.00 " " 1" @ 3.400 # = 52098.2 51911.2
 " " 1 1/8" @ 4.303 # = 3521.2
 " " 1 1/4" @ 5.313 # = 2800.0
Total = 82,906.5 Lbs.
 = 79,727.9
 Rev ③ = 79,067.1 lbs ← Total of steel shown on this sheet after deductions of bars necessary to make new revised bars A 40 to A 52 inclusive (shown on sheets 13 x 14)


Note: Bars marked ① changed under Revision ③

REINFORCING STEEL

Sheet 12 of 12 sheets
 UTAH STATE ROAD COMMISSION
 SALT LAKE CITY - UTAH
 EZRA C. KNOWLTON, CHIEF ENGINEER
 BRIDGE OVER U.P. & L. CO'S
 PENSTOCKS
 A.W.(P.C.E.) F.A.P. 222-A(0)
 Sta. 52+50 Weber Co.
 Ogden Arsenal-Riverdale
 DESIGNED BY F.M.E. SCALE None
 DRAWN BY F.M.E. H.H. ISSUED May 27 1941
 CHECKED BY APPROVED [Signature]
 EXAMINED BY [Signature]
 No. 29-259-12 Dwg. No. D-466




STATE OF UTAH STATE ROAD COMMISSION

PLANS OF PROPOSED STATE ROAD FEDERAL AID PROJECT

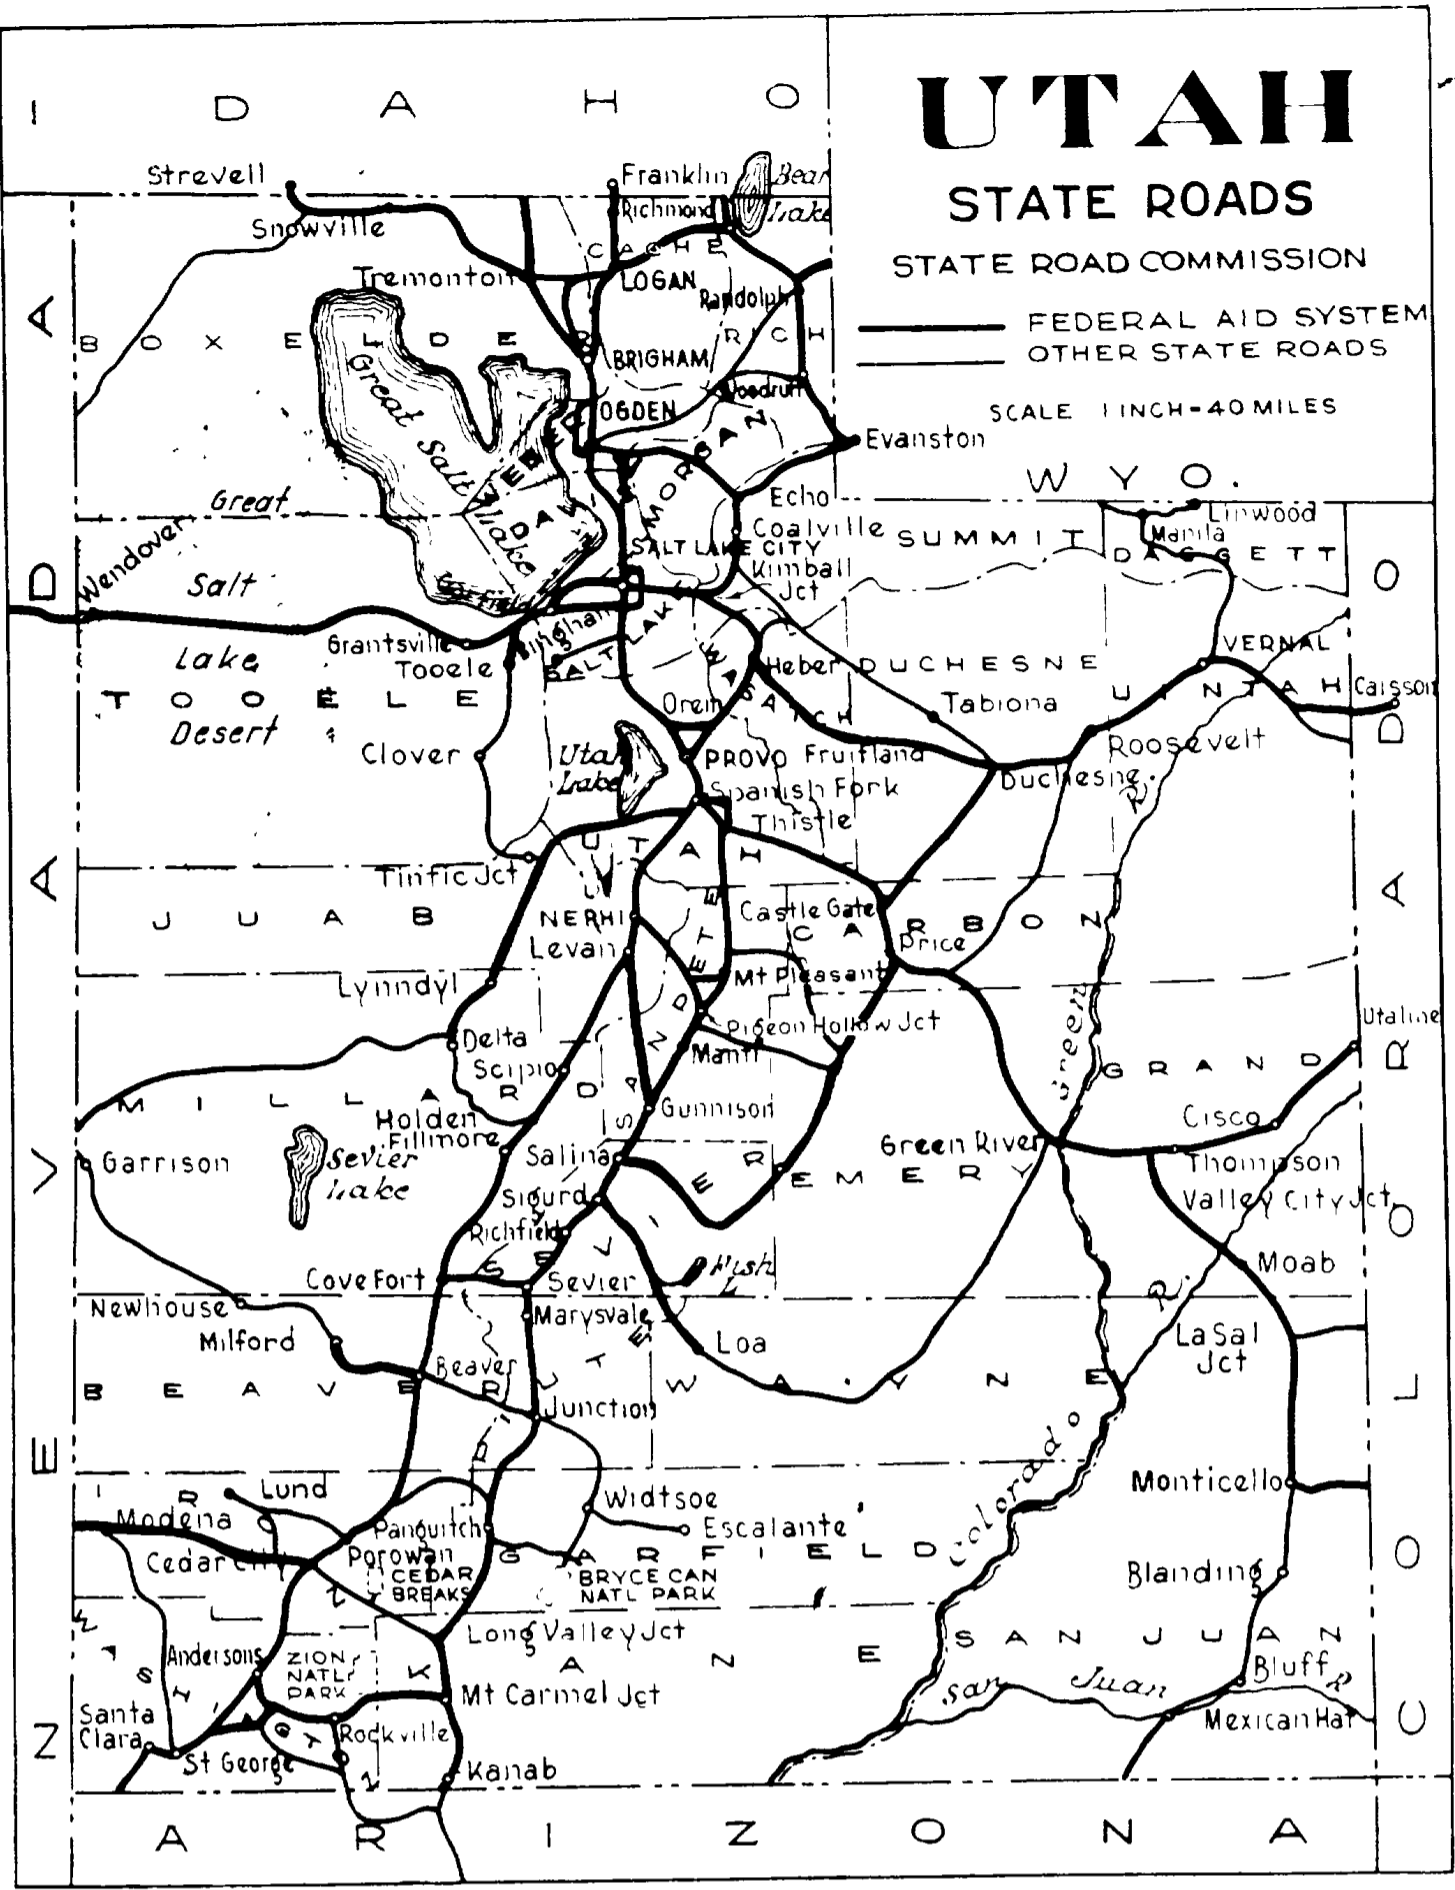

INDEX TO SHEETS F. A. P. No.

SHEET NO.	DESCRIPTION	DRAWING NO.	STATION

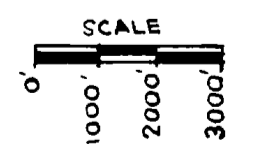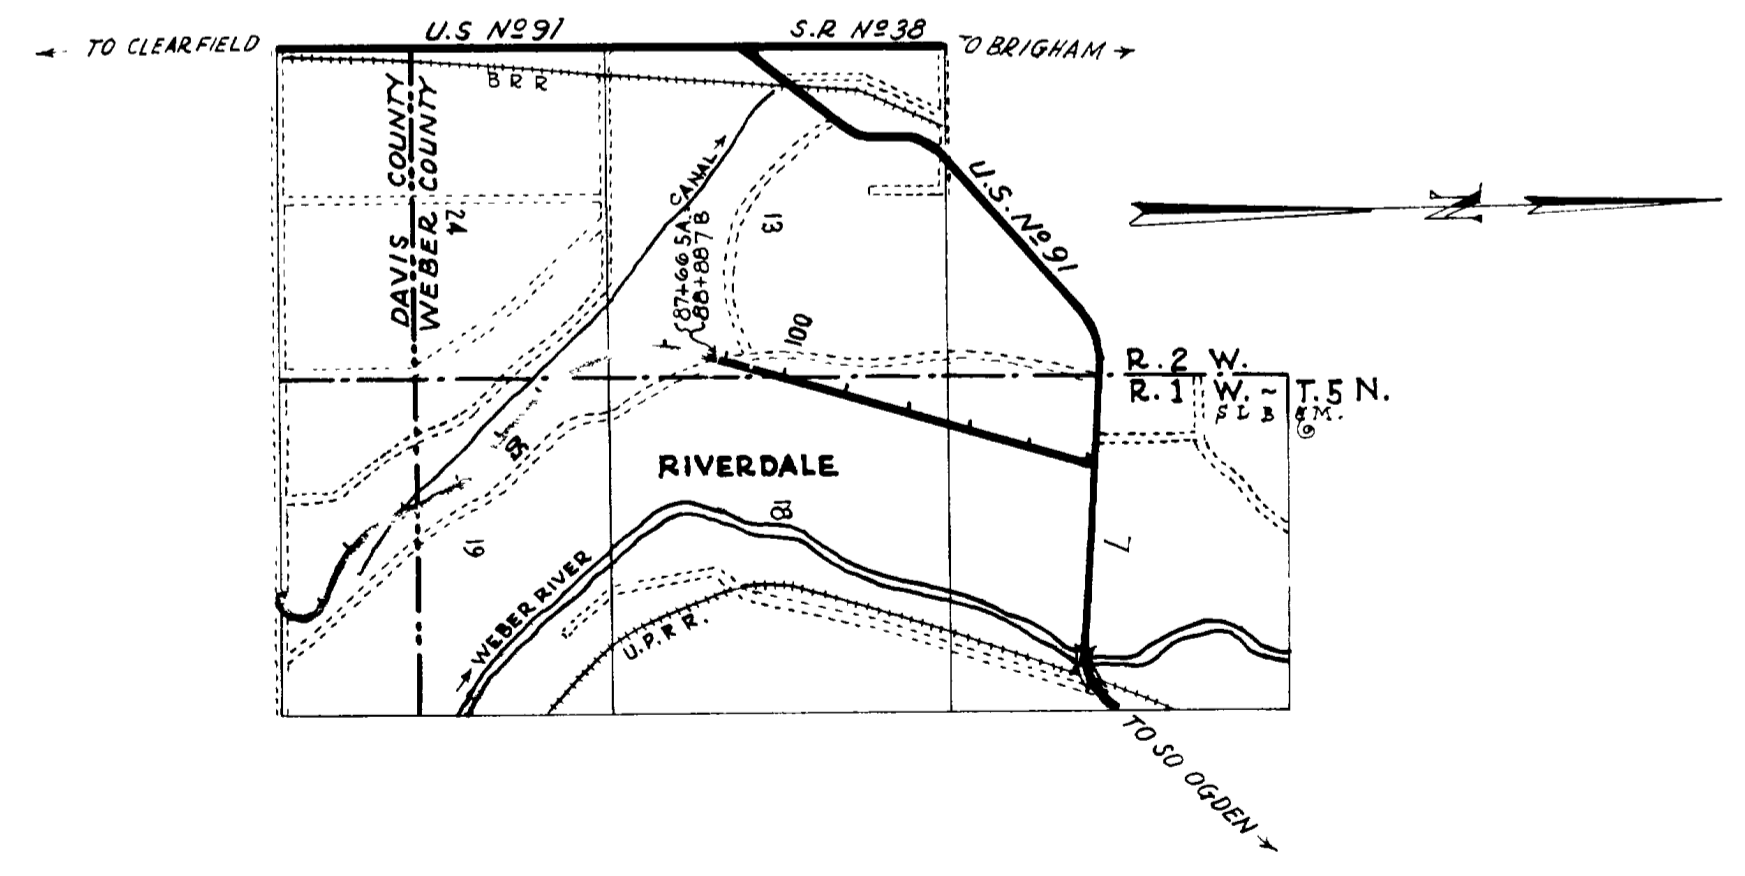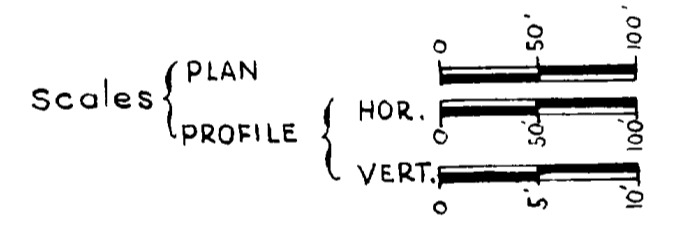


APPROVED MARCH 1941
STATE ROAD COMMISSION OF UTAH

E. L. Thurston
CHIEF ENGR.

RECOMMENDED FOR APPROVAL
DISTRICT ENGINEER
PUBLIC ROADS ADMINISTRATION
FEDERAL WORKS AGENCY

RECOMMENDED FOR APPROVAL
CHIEF WESTERN REGION
PUBLIC ROADS ADMINISTRATION
FEDERAL WORKS AGENCY

APPROVED
COMMISSIONER
PUBLIC ROADS ADMINISTRATION
FEDERAL WORKS AGENCY

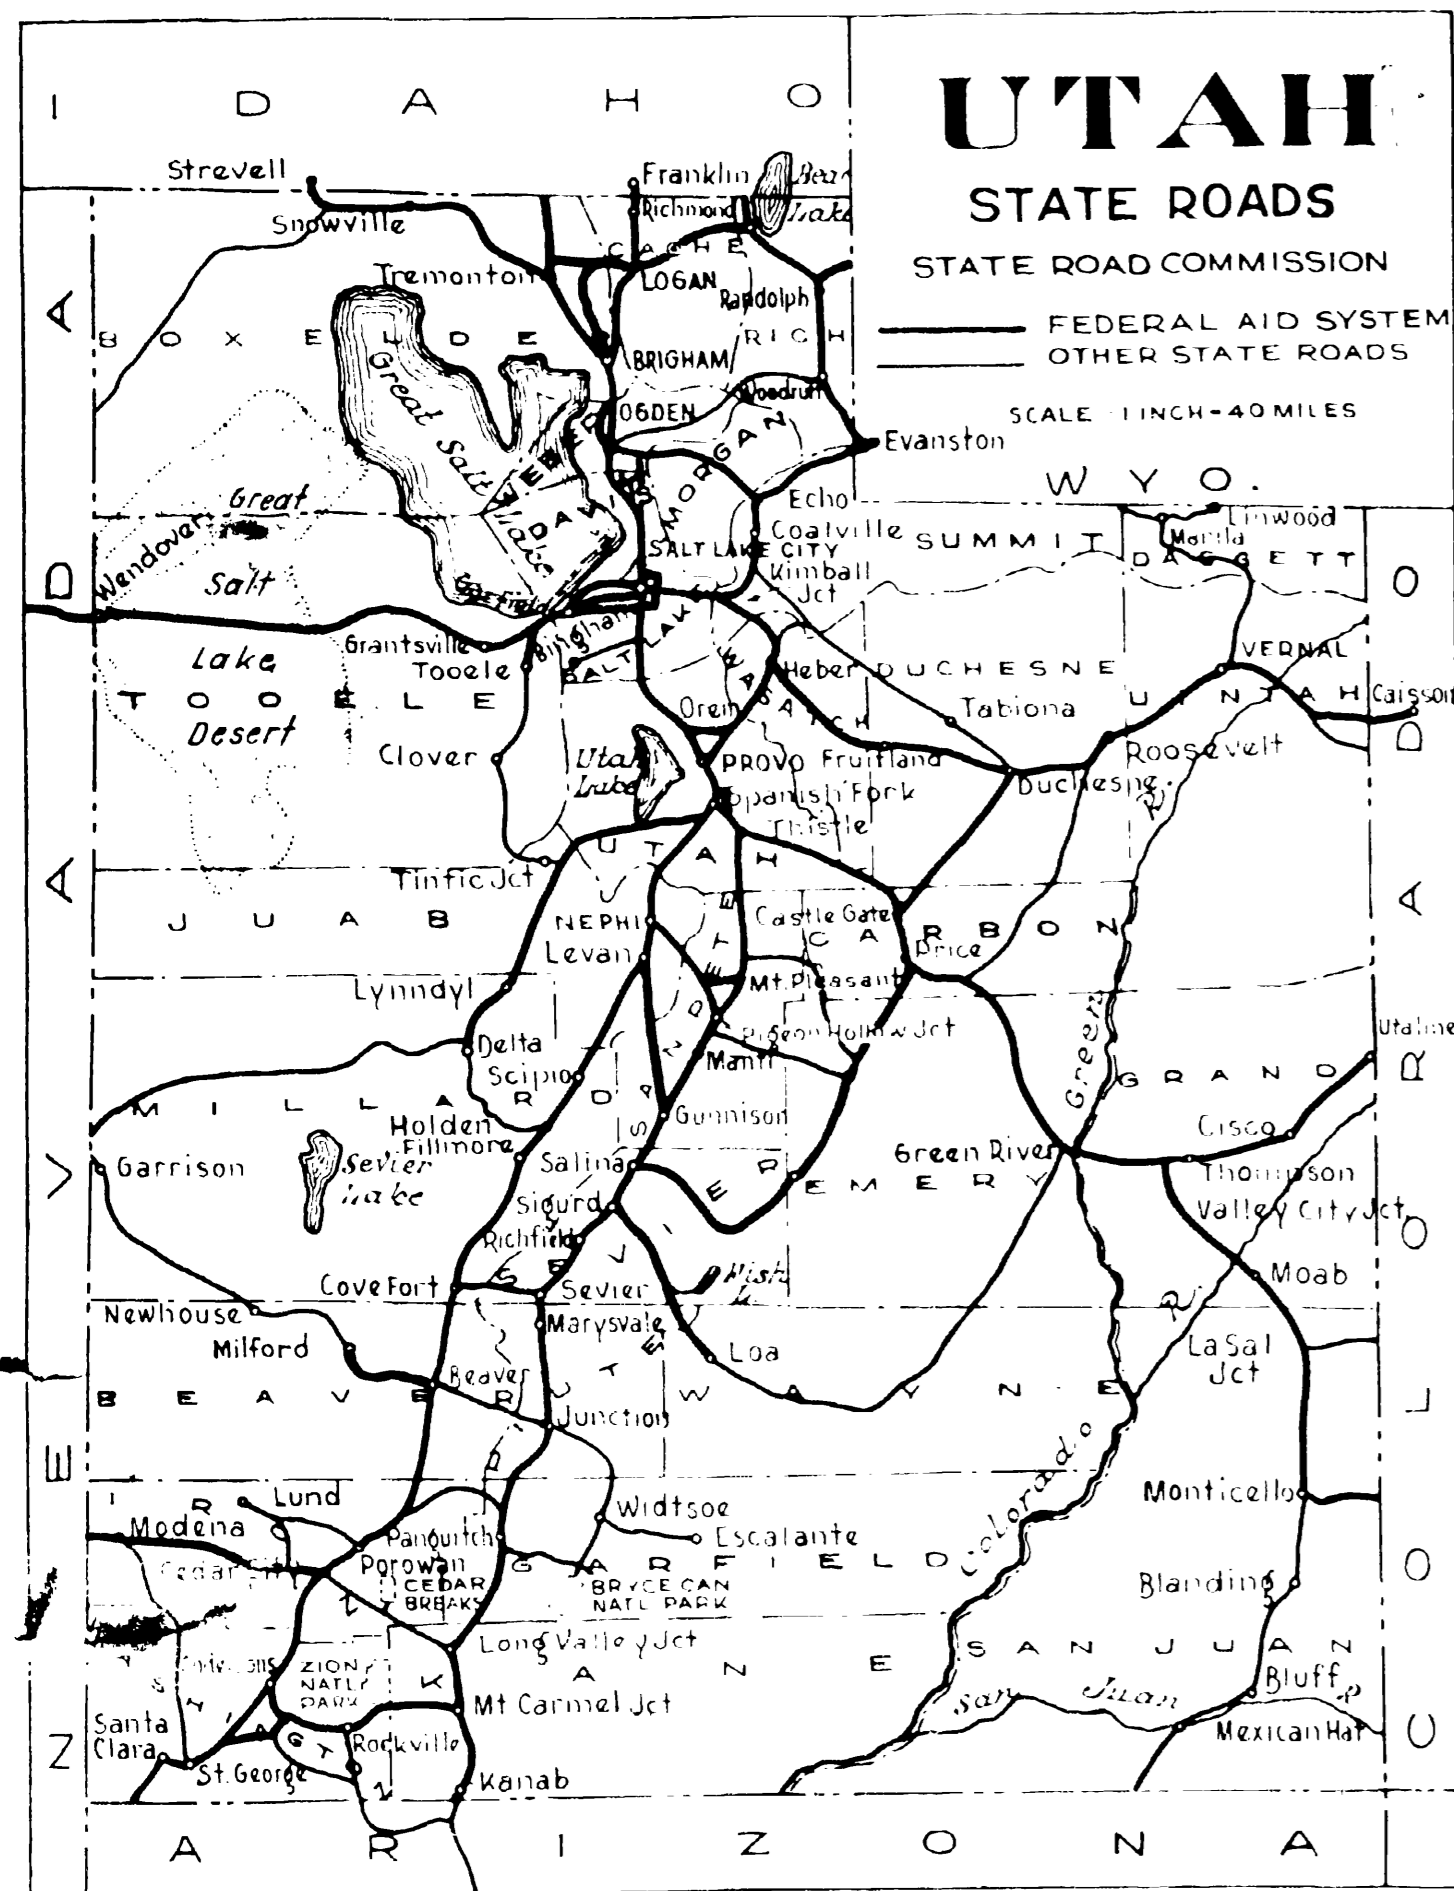

STATE OF UTAH STATE ROAD COMMISSION

PLANS OF PROPOSED STATE ROAD

FEDERAL AID PROJECT

AW (PE) F.A.P. No 222-A(1) ~ LENGTH 1.661 MILES
 AW (PE) F.A.P. No 222-B(1) ~ LENGTH 0.786 MILES
 DA - WR PR. No 12(1) ~ LENGTH 0.786 MILES


FED. ROAD DIST. NO.	STATE	FED. AID PROJ. NO.	FISCAL YEAR	SHEET NO.	TOTAL SHEETS
12	UTAH	222-A(1)	1942	1	39
"	"	222-B(1)	"	1	10
"	"	DA WR 12(1)	"	1	10

INDEX TO SHEETS DA - WR No 12(1)

SHEET	DESCRIPTION	DRAWING NO.	STATION
1	TITLE SHEET		
2	TYPICAL SECTION		
3-5	PLAN AND PROFILE		
6	STD. CATCH BASINS	V-330 E-7	94+4.144
7	" HEADGATE AND OUTLET	V-224 E-7	106+0.8
8-9	8'x3'x51" CONC. BOX	E-740	97+3.4
10	F.A.P. MARKER	M-45	
1-10	X-SECTIONS		

INDEX TO SHEETS AW (PE) F.A.P. 222-A(1)

SHEET NO.	DESCRIPTION	DRAWING NO.	STATION
1	TITLE SHEET		
2	TYPICAL SECTION		
3-5	PLAN AND PROFILE		
6-18	84'-0" CONC. BRIDGE	C-215	27+4.6
21-32	131'-3" CONC. BRIDGE	D-466	52+5.0
33-A	R/W MARKERS	F-391-RS	
33-C	SUPER. AND WIDEN CURVES	M-37	
34	STD. GUARD RAIL	E-40	
35	STD. CATCH BASINS	V-175 E-3	34.8
36	STD. HEADGATE AND OUTLET	V-224 E-7	106+0.8
37-38	8'x3'x51" CONC. BOX	E-740	97+3.4
39	STD. EMBANKMENT PROTECT.	M-35	
1-14	X-SECTIONS		

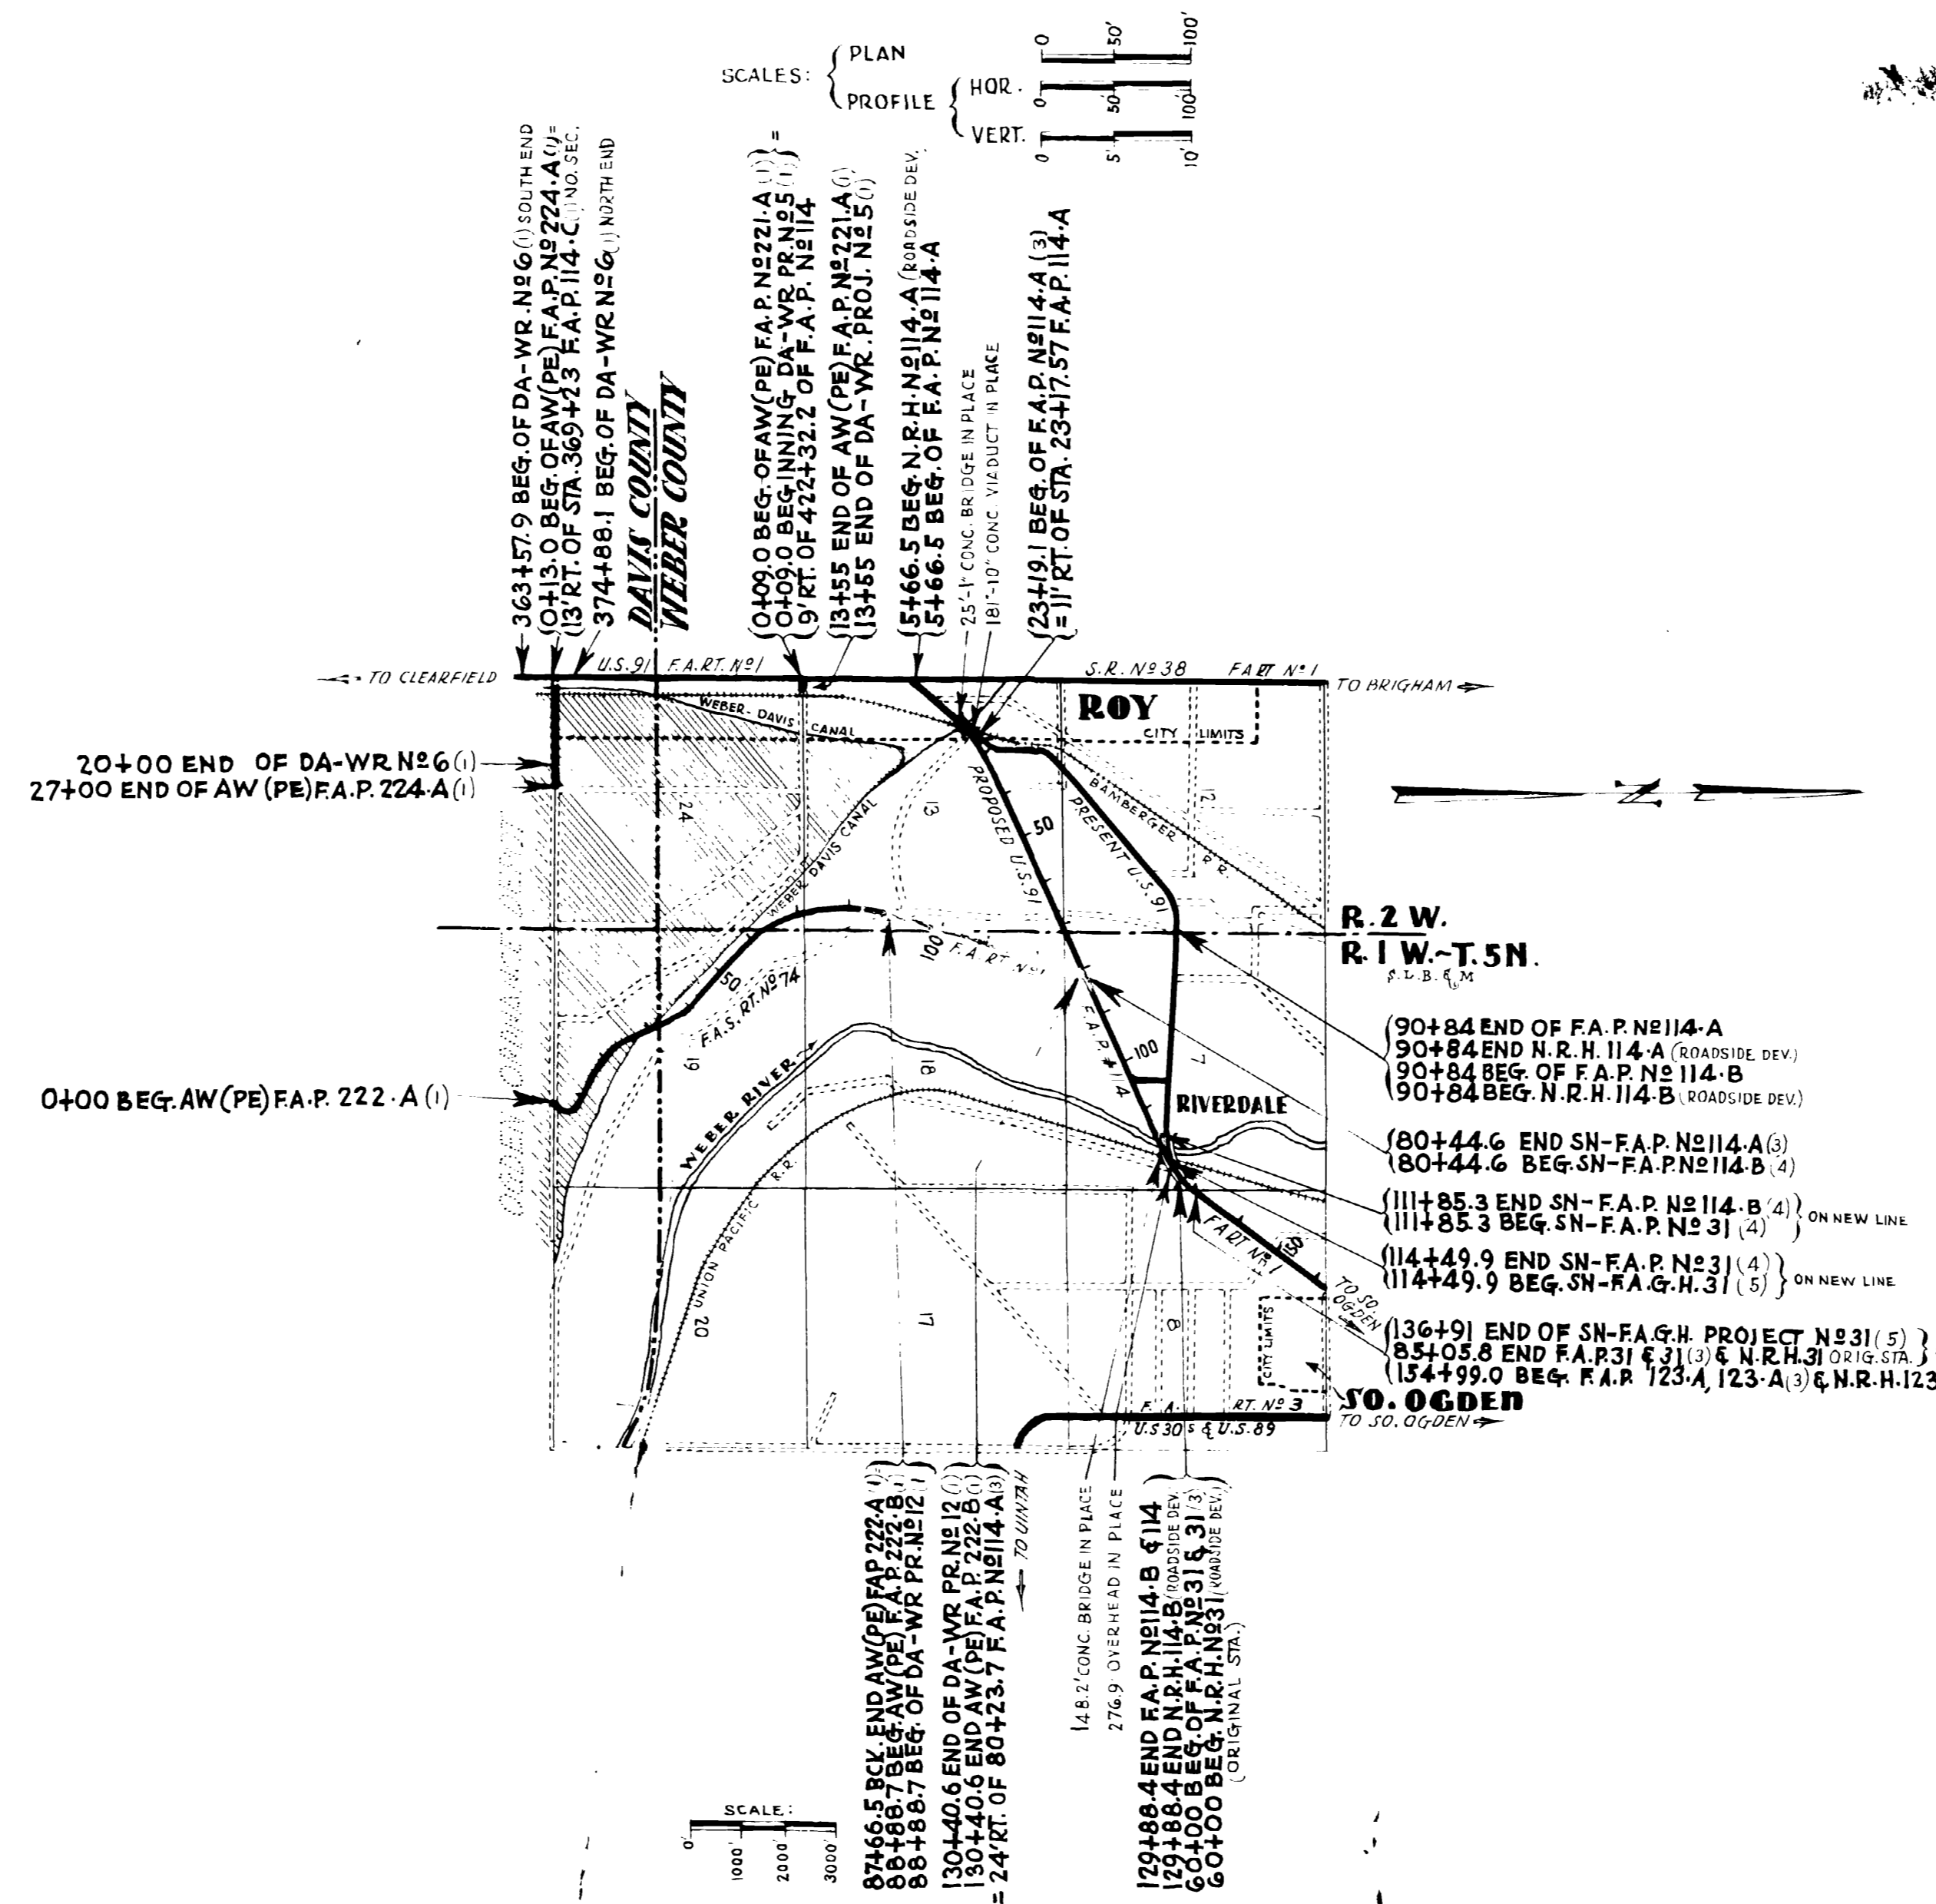

F.A.P. 222-A(1) & B

APPROVED APRIL 1942

STATE ROAD COMMISSION OF UTAH

W. Anderson
DESIGN ENGINEER

RECOMMENDED FOR APPROVAL

DISTRICT ENGINEER
PUBLIC ROADS ADMINISTRATION
FEDERAL WORKS AGENCY

RECOMMENDED FOR APPROVAL


CHIEF, WESTERN REGION
PUBLIC ROADS ADMINISTRATION
FEDERAL WORKS AGENCY

APPROVED

COMMISSIONER
PUBLIC ROADS ADMINISTRATION
FEDERAL WORKS AGENCY

STATE OF UTAH STATE ROAD COMMISSION

FED. ROAD DIST. NO.	STATE	FED. AID PROJ. NO.	FISCAL YEAR	SHEET NO.	TOTAL SHEETS
12	UTAH	222-A(1)	1942	1-A	39
"	"	222-B(1)	"	1	10
"	"	DA-WR 12(1)	"	1	10
UT.	UTAH	UI-123(4)	POSTWAR	1	18

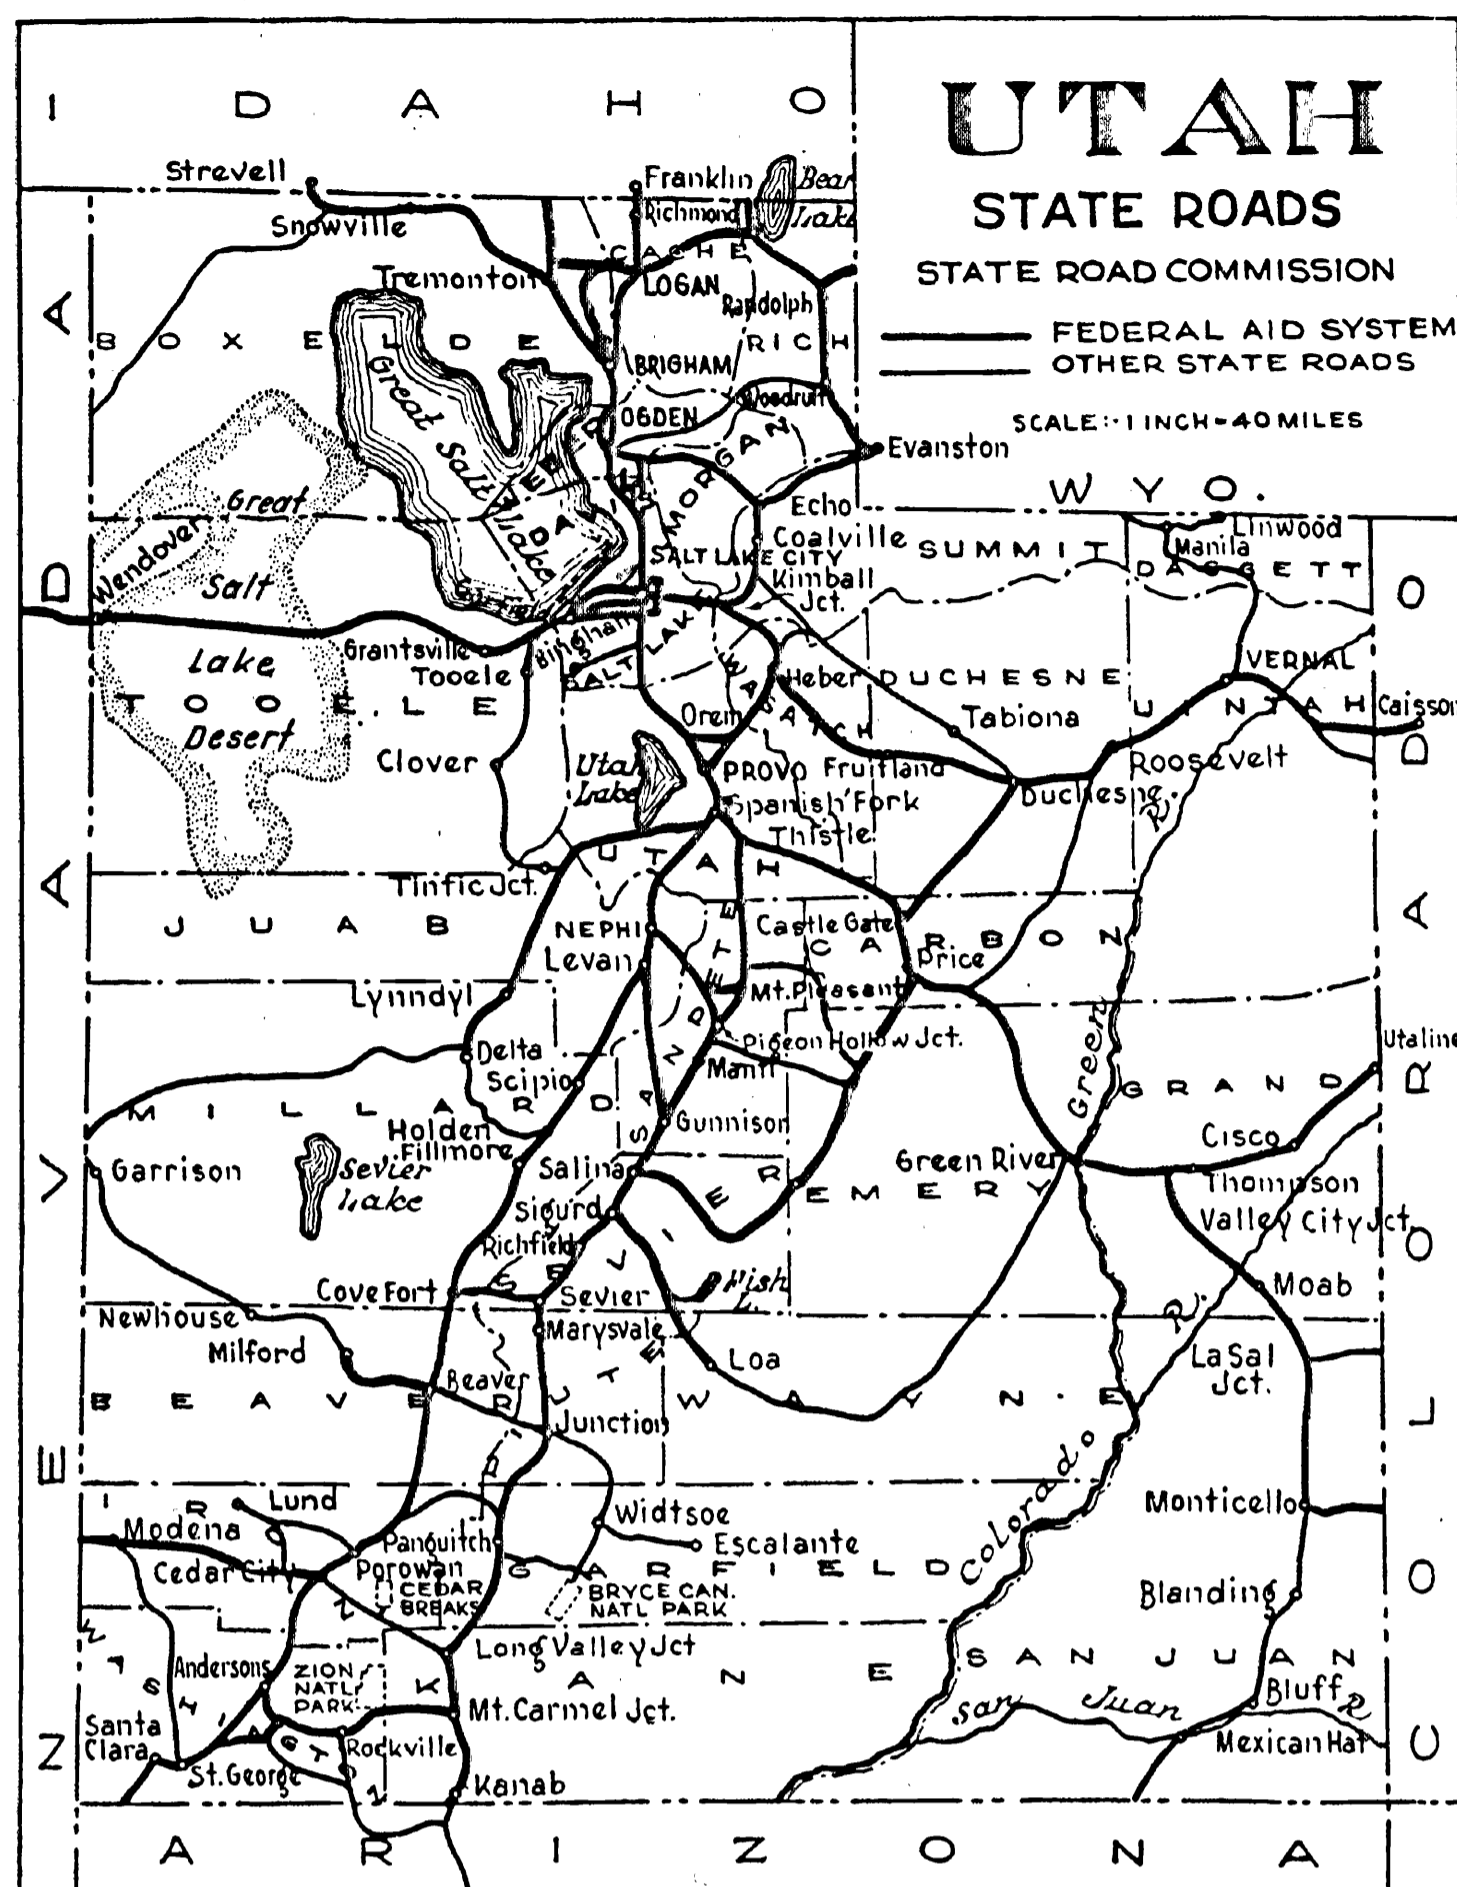

PLANS OF PROPOSED STATE ROAD

FEDERAL AID PROJECT

AW (PE) F.A.P. NO 222-A(1) ~ LENGTH 1.661 MILES
 AW (PE) F.A.P. NO 222-B(1) ~ LENGTH 0.786 MILES
 DA-WR PR. NO 12(1) ~ LENGTH 0.786 MILES

WEBER COUNTY

UI-123(4) ~ LENGTH 1.091 MILES

INDEX TO SHEETS DA-WR. NO 12(1)

SHEET	DESCRIPTION	DRAWING NO.	STATION
1	TITLE SHEET		
2	TYPICAL SECTION		
3-5	PLAN AND PROFILE		
6	STD. CATCH BASINS	V-330 1:2	94±-114±
7	HEADGATE AND OUTLET	V-224 1:8	106±-108
8-9	8'x3'x51" CONC. BOX	E-740	97±-102
10	F.A.P. MARKER	M-45	
1-10	X-SECTIONS		

INDEX TO SHEETS AW (PE) F.A.P. 222-A(1)

SHEET NO.	DESCRIPTION	DRAWING NO.	STATION
1	TITLE SHEET		
2	TYPICAL SECTION		
3-5	PLAN AND PROFILE		
6-18	84'-6 3/8" CONC. BRIDGE	C-215	27±-46
21-32	131'-3" CONC. BRIDGE	D-466	52±-50
33-A	R/W MARKERS	J-391-RS	
33-C	SUPER. AND WIDEN CURVES	M-37	
34	STD. GUARD RAIL	E-40	
35	STD. CATCH BASINS	V-175 1:8	172±
36	STD. HEADGATE AND OUTLET	V-224 1:8	106±-108
37-38	8'x3'x51" CONC. BOX	E-740	97±-102
39	STD. EMBANKMENT PROTECTOR	M-35	
1-44	X-SECTIONS		

INDEX TO SHEETS UI-123(4)

SHEET	DESCRIPTION	DRAWING	STATION
1	TITLE SHEET		
2-2A	TYPICAL SECTION, REINF. & JOINT DET.	B-120	
3-6	PLAN AND PROFILE		
7-8	2'x1'x16" BOX EXT. AND WELLS	E-918	175±-175
9	DIV. BOX	V-440	177±-25
10-11	8'x2'x22.17" BOX EXT. AND WELLS	E-919	182±-76
12	STD. CATCH BASINS	V-175(4)	
13-14	RETAINING WALL	V-438	
15	STD. CLEANOUT BOXES	V-202-2	
16	STD. HEADWALL AND GRATING	V-450	156±-00
17-18	" HIGHWAY SIGNS	B-95,162	
1-9	X-SECTIONS		

APPROVED - AUGUST 1951

STATE ROAD COMMISSION OF UTAH

W. Anderson
ASST. CHIEF ENGINEER


**DEPARTMENT OF COMMERCE
BUREAU OF PUBLIC ROADS**

RECOMMENDED FOR APPROVAL:

DISTRICT ENGINEER DATE

APPROVED:




DIVISION ENGINEER DATE

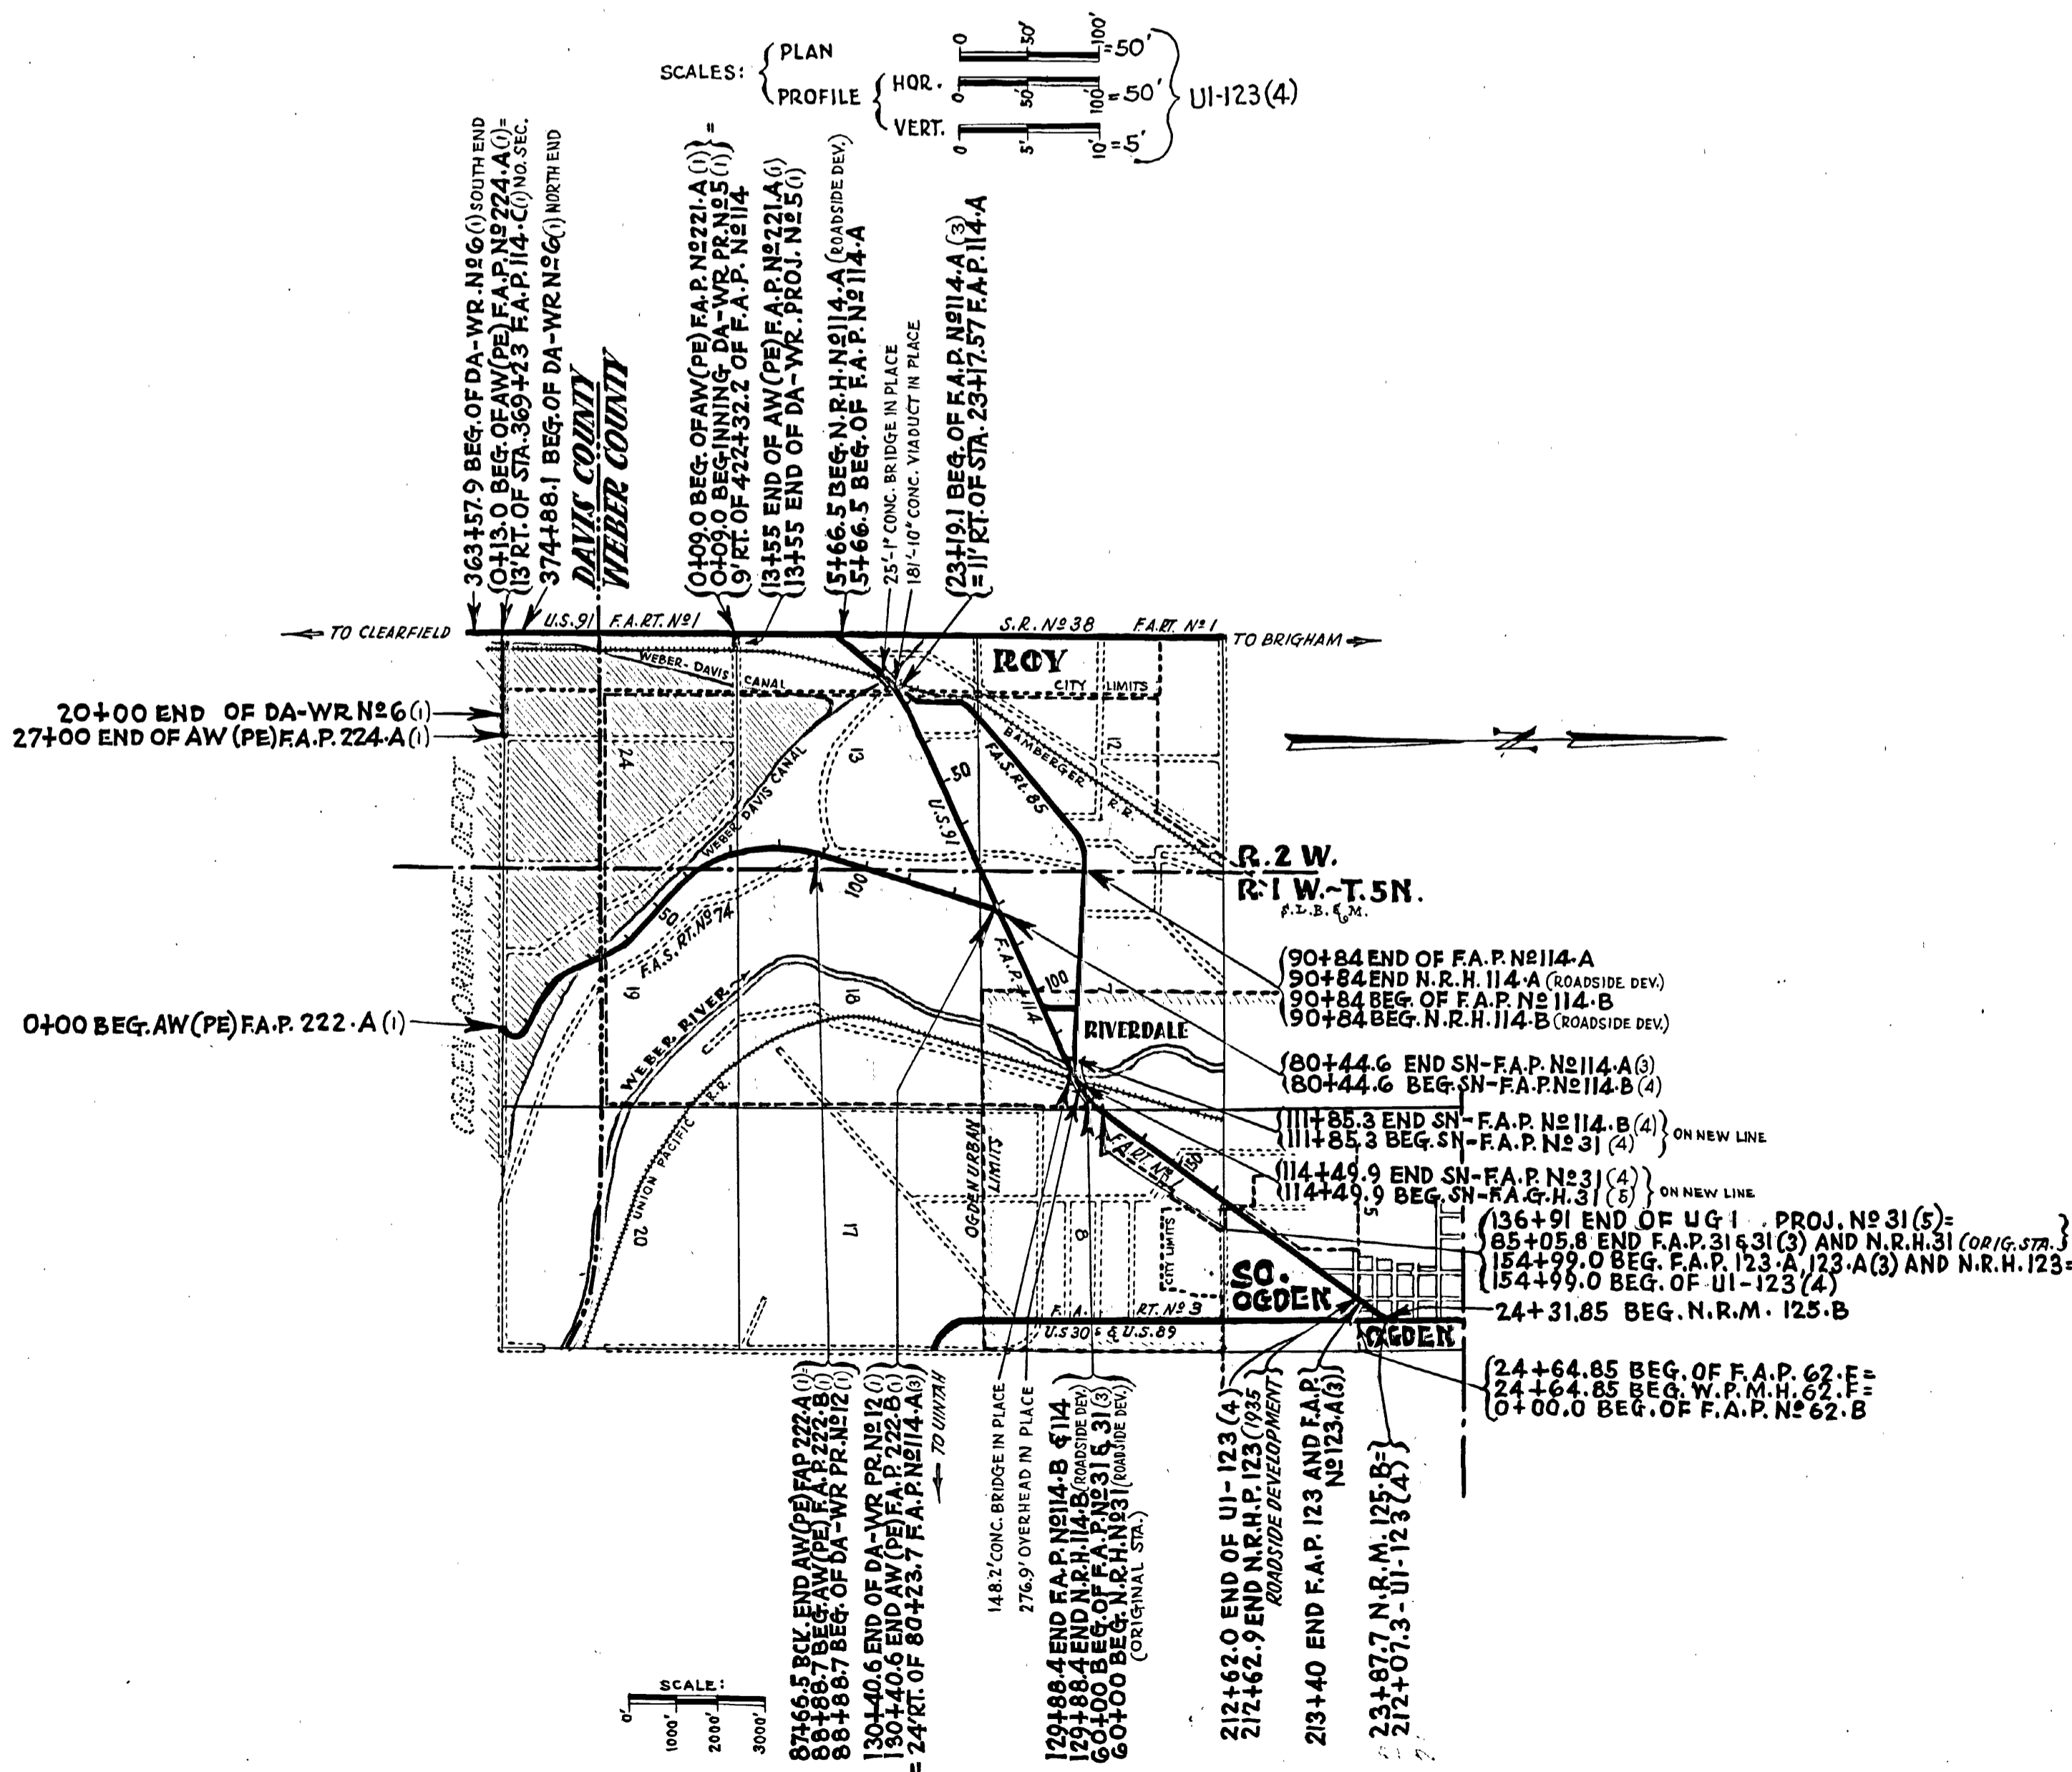

UI-123(4)

F.A.P. 222-A - DA-WR-12

TYPICAL CROSS SECTION

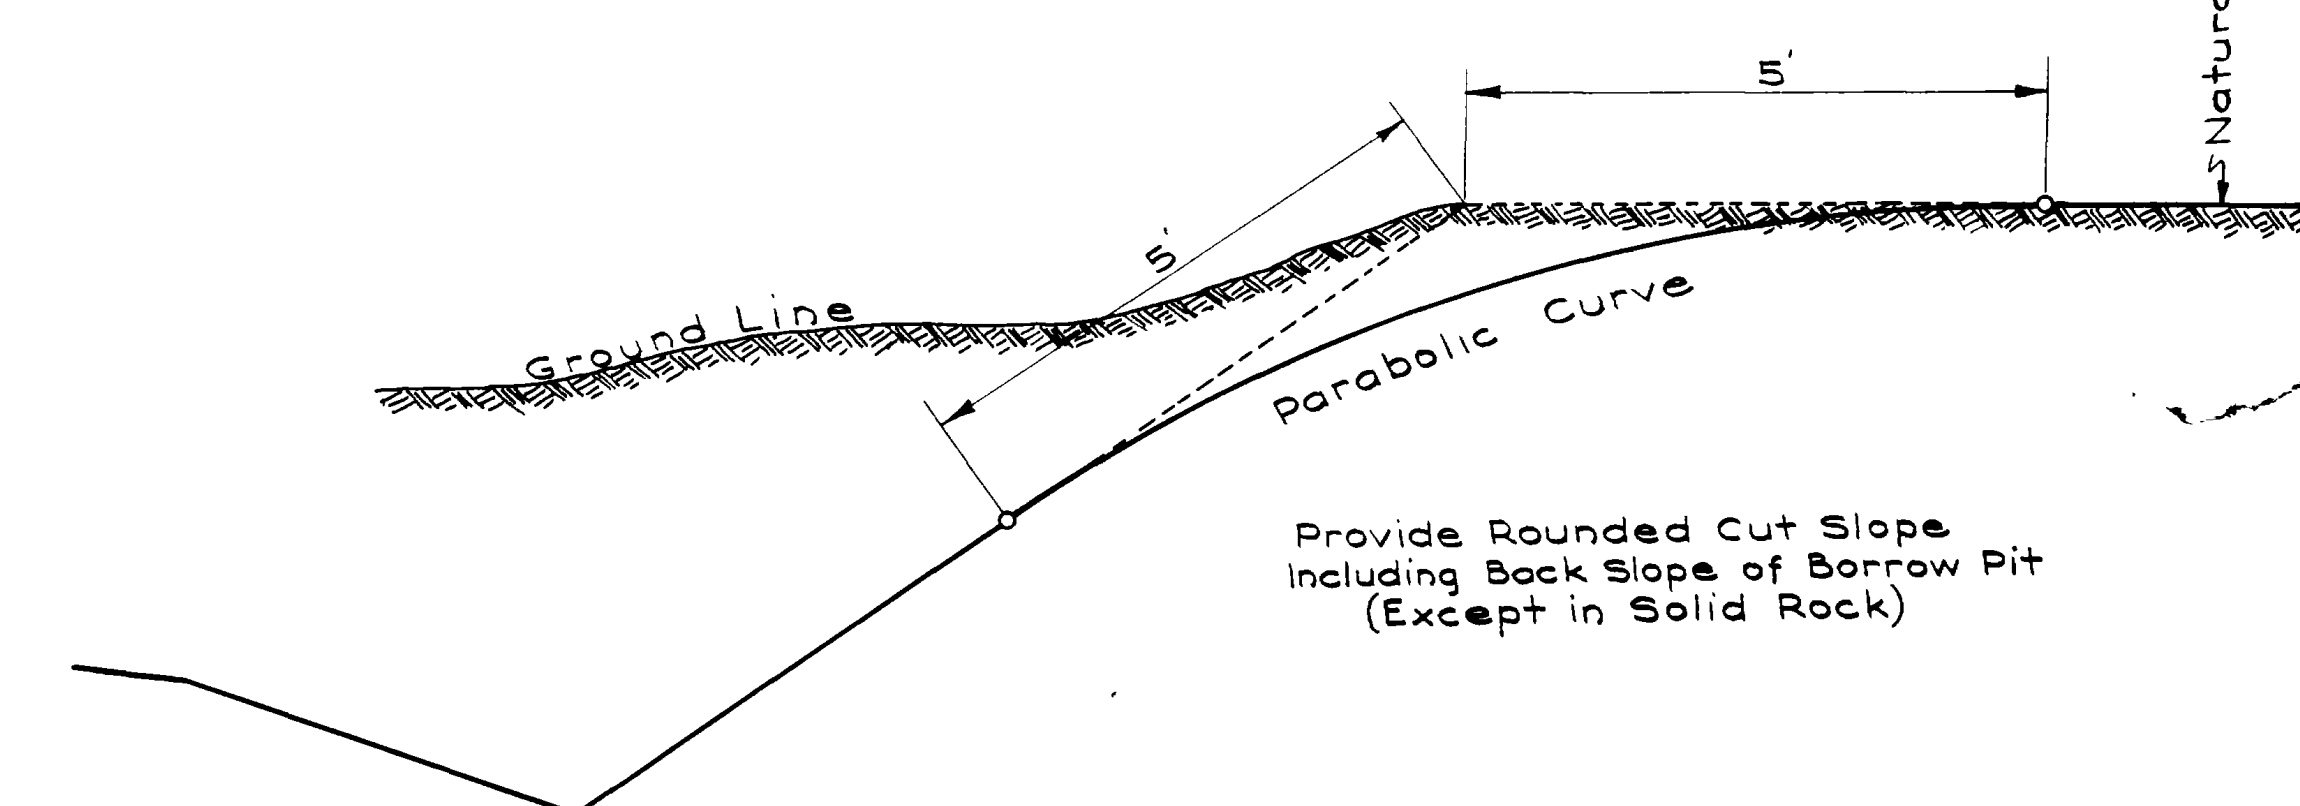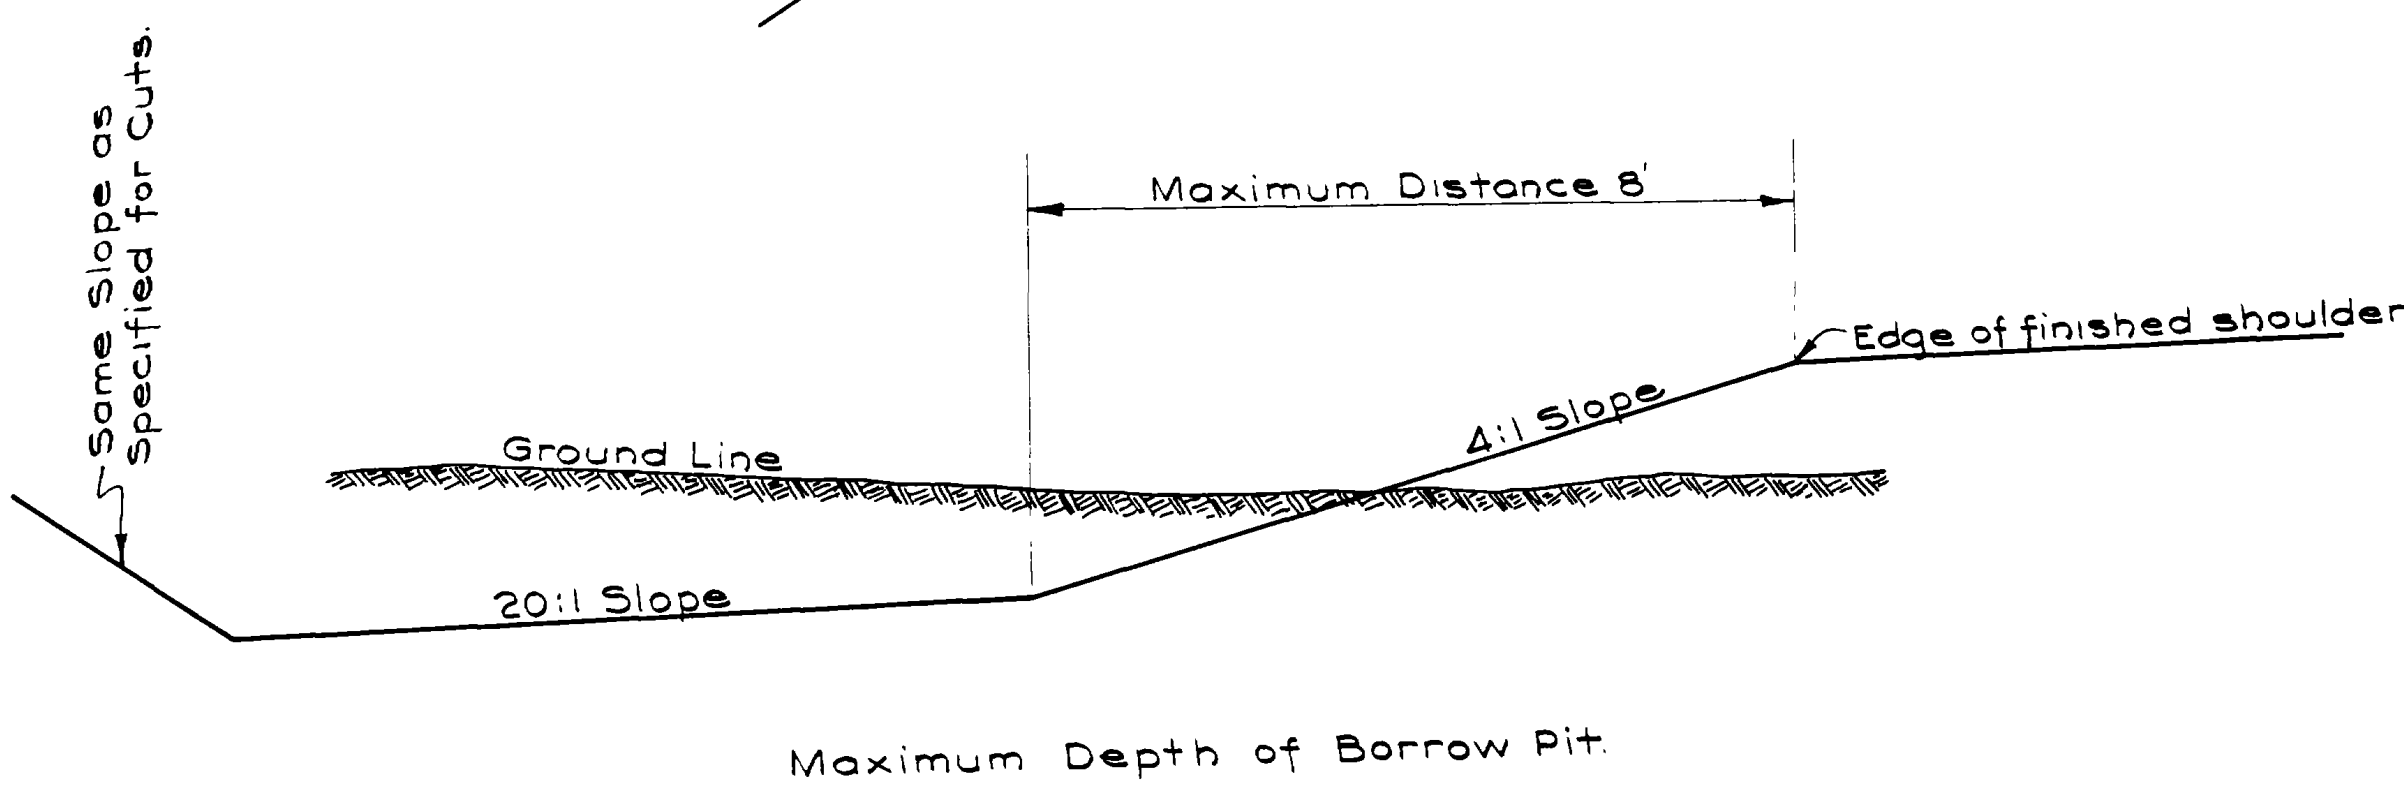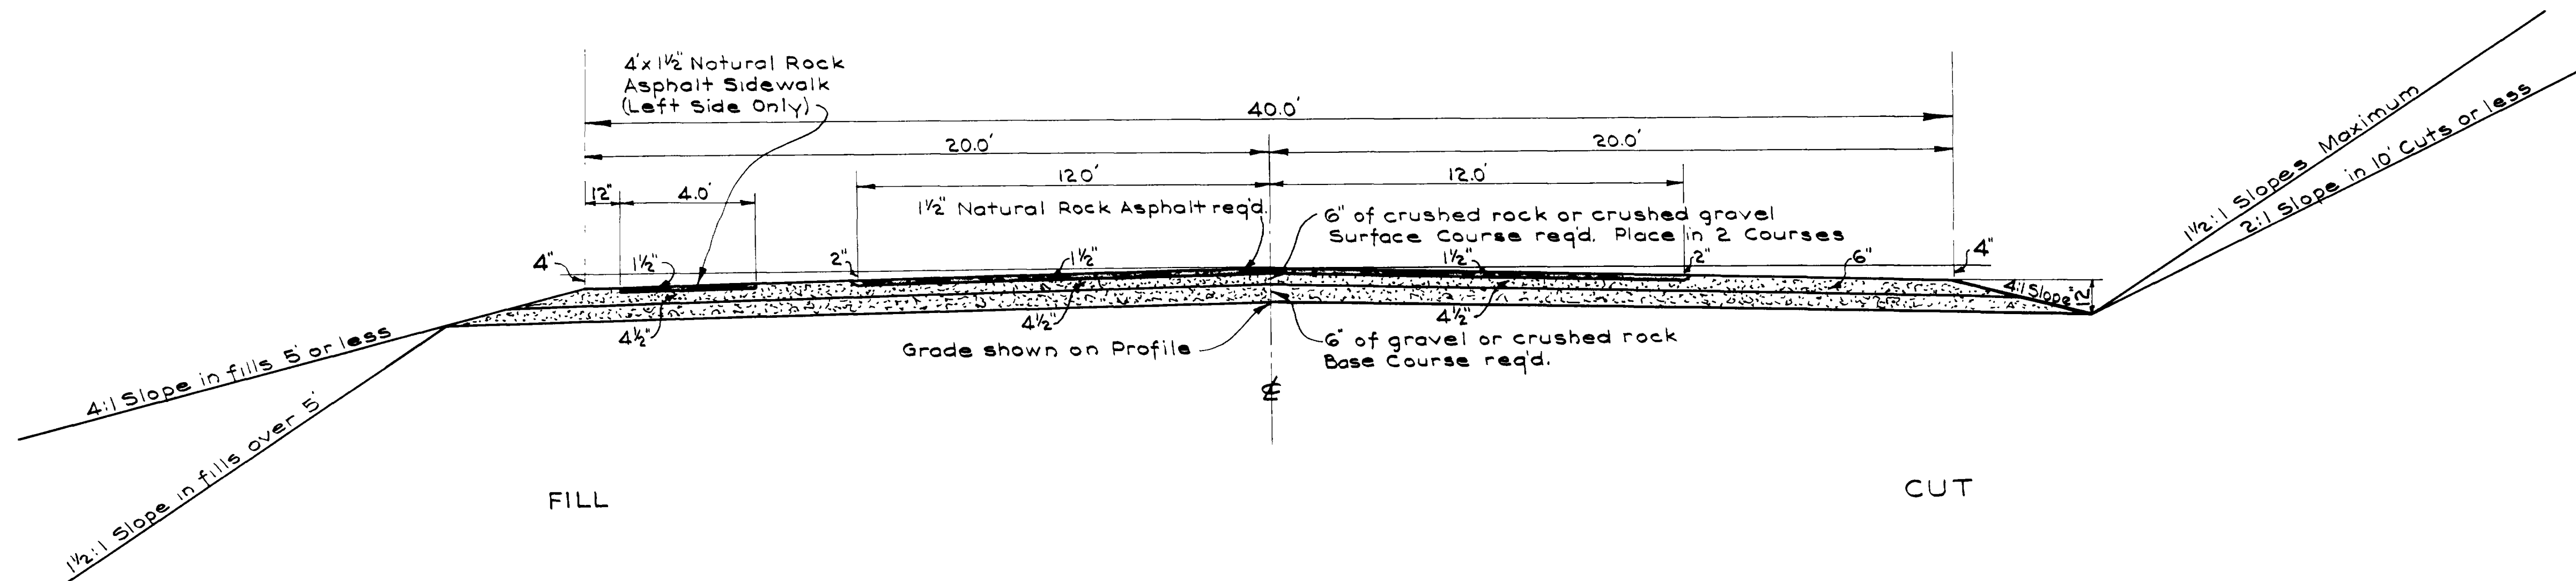

REVISIONS
DATE BY
DATE BY




UTAH STATE ROAD COMMISSION
SALT LAKE CITY - UTAH
EZRA C. KNOWLTON, CHIEF ENGINEER

- TYPE -

24' NATURAL ROCK ASPHALT ROADWAY

Widen and Superelevate Curves According to Drwg. No. J-479

TYPICAL CROSS SECTION

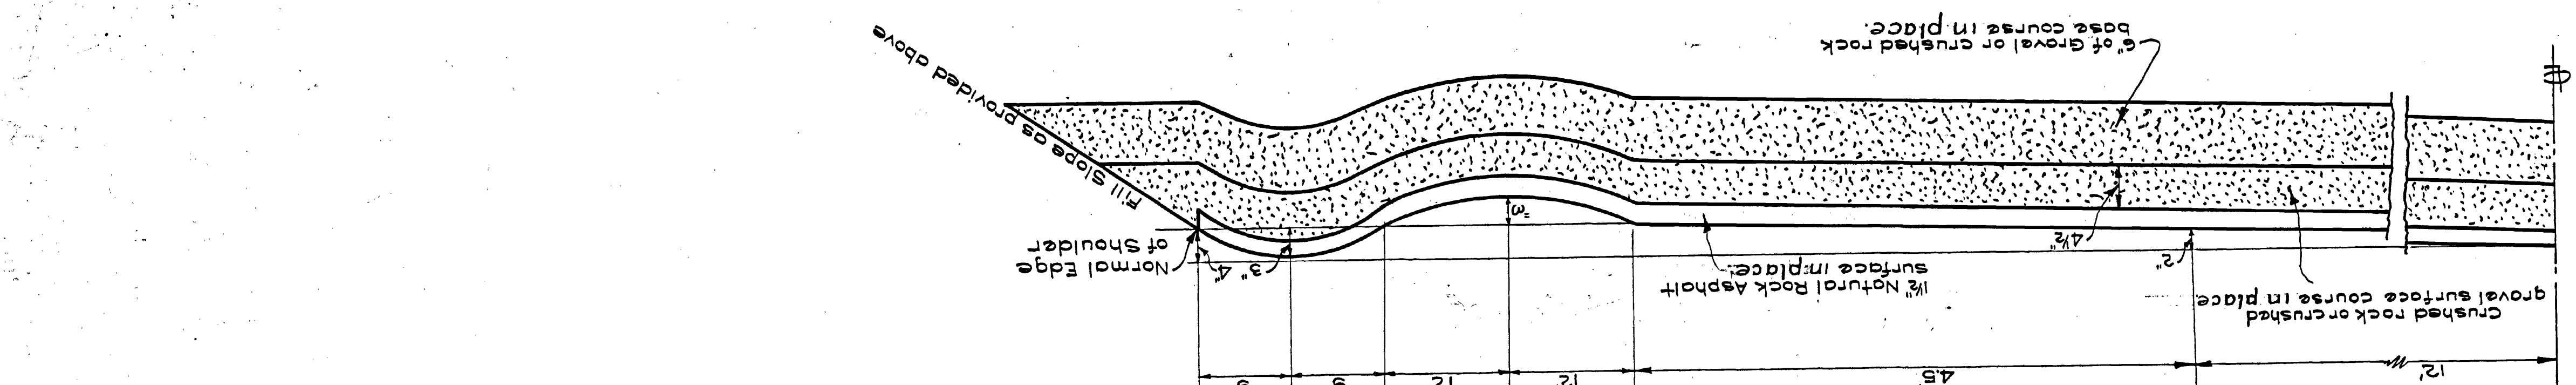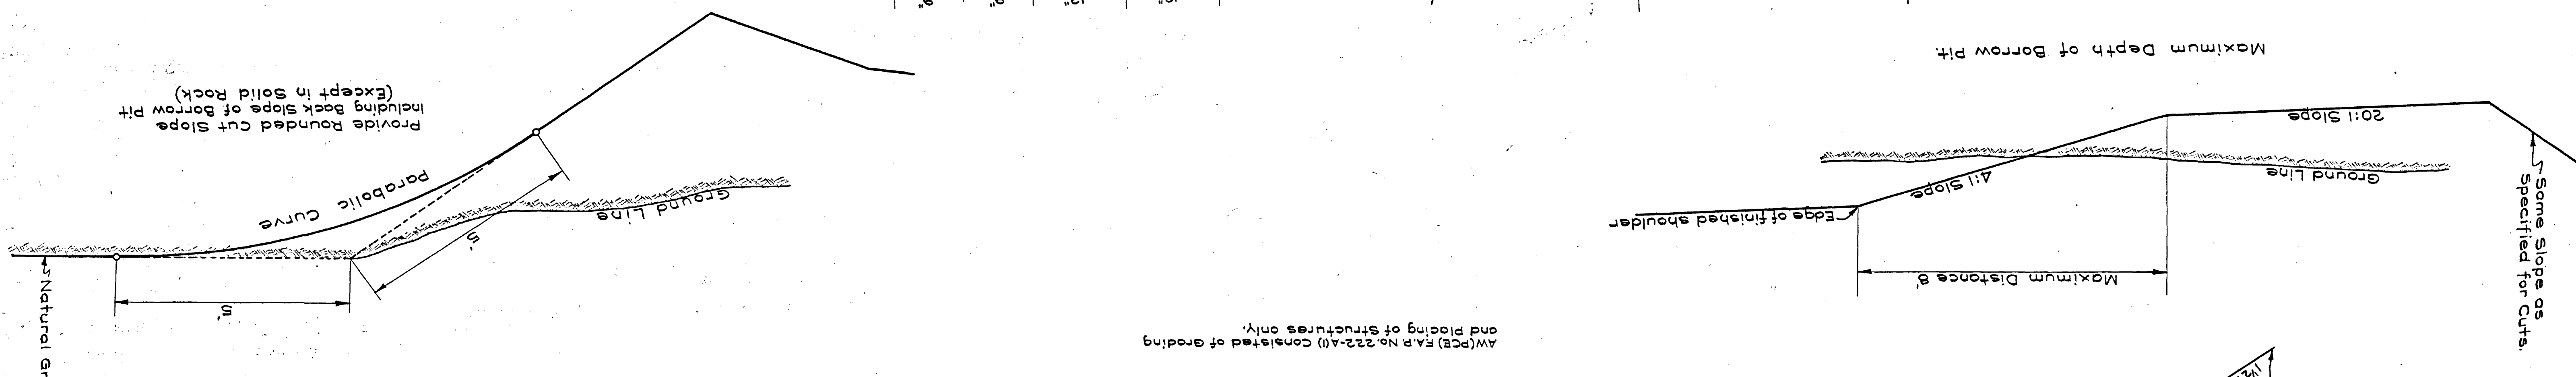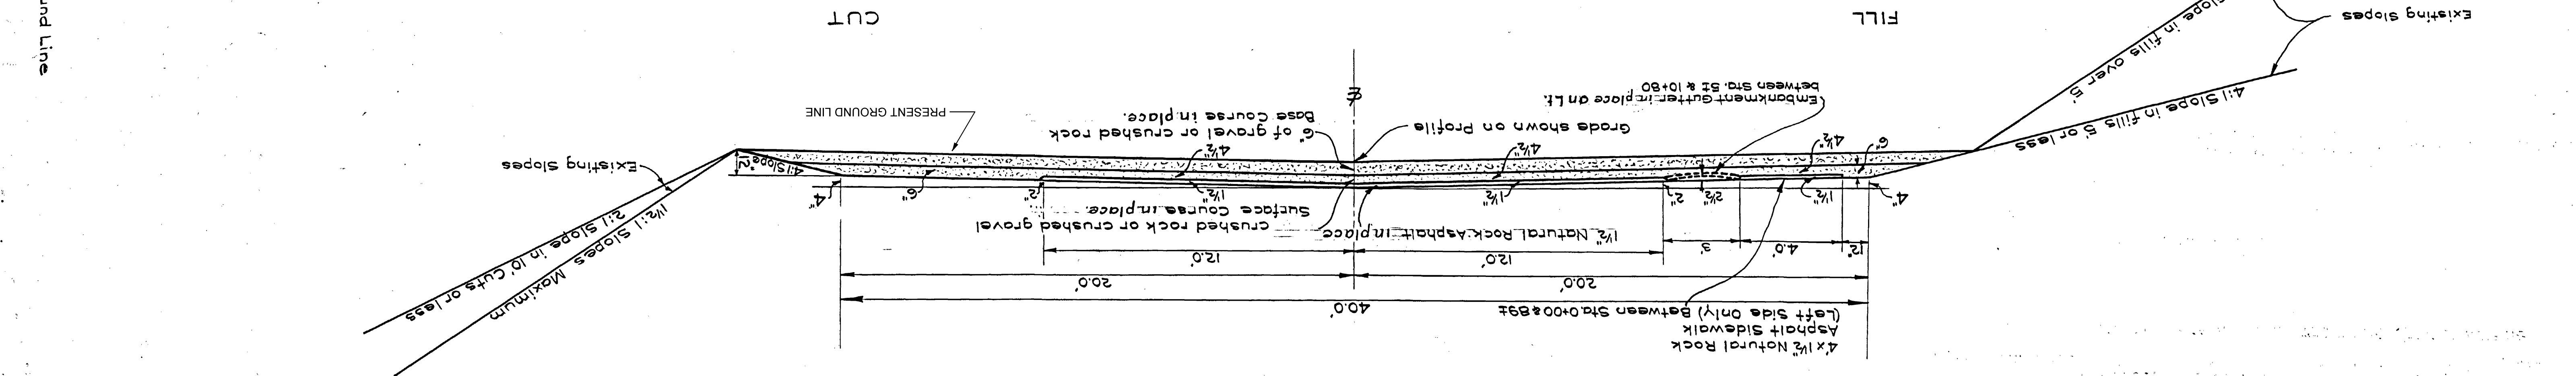

UTAH STATE ROAD COMMISSION
 SALT LAKE CITY - UTAH
 - TYPE -
 24' NATURAL ROCK ASPHALT ROADWAY


Widen and Super-elevate Curves According to Drwg. No. M-37

PAVED EMBANKMENT CUTTER & SHOULDER

REVISIONS	
DATE	BY


DATE	1947
SURVEYED BY	J.B. BURTON
PLOTTED BY	J.S. BURTON
NOTE BOOK NO.	4799
BY WHOM CHECKED	H.S. WRIGHT
DATE CHECKED	
REVISIONS	
NO.	
BY	
DATE	
REASON	
DATE	
BY	

DATE	1947
SURVEYED BY	J.B. BURTON
PLOTTED BY	J.S. BURTON
NOTE BOOK NO.	4793
BY WHOM CHECKED	F. SCHMEL
DATE CHECKED	
REVISIONS	
NO.	
BY	
DATE	
REASON	
DATE	
BY	

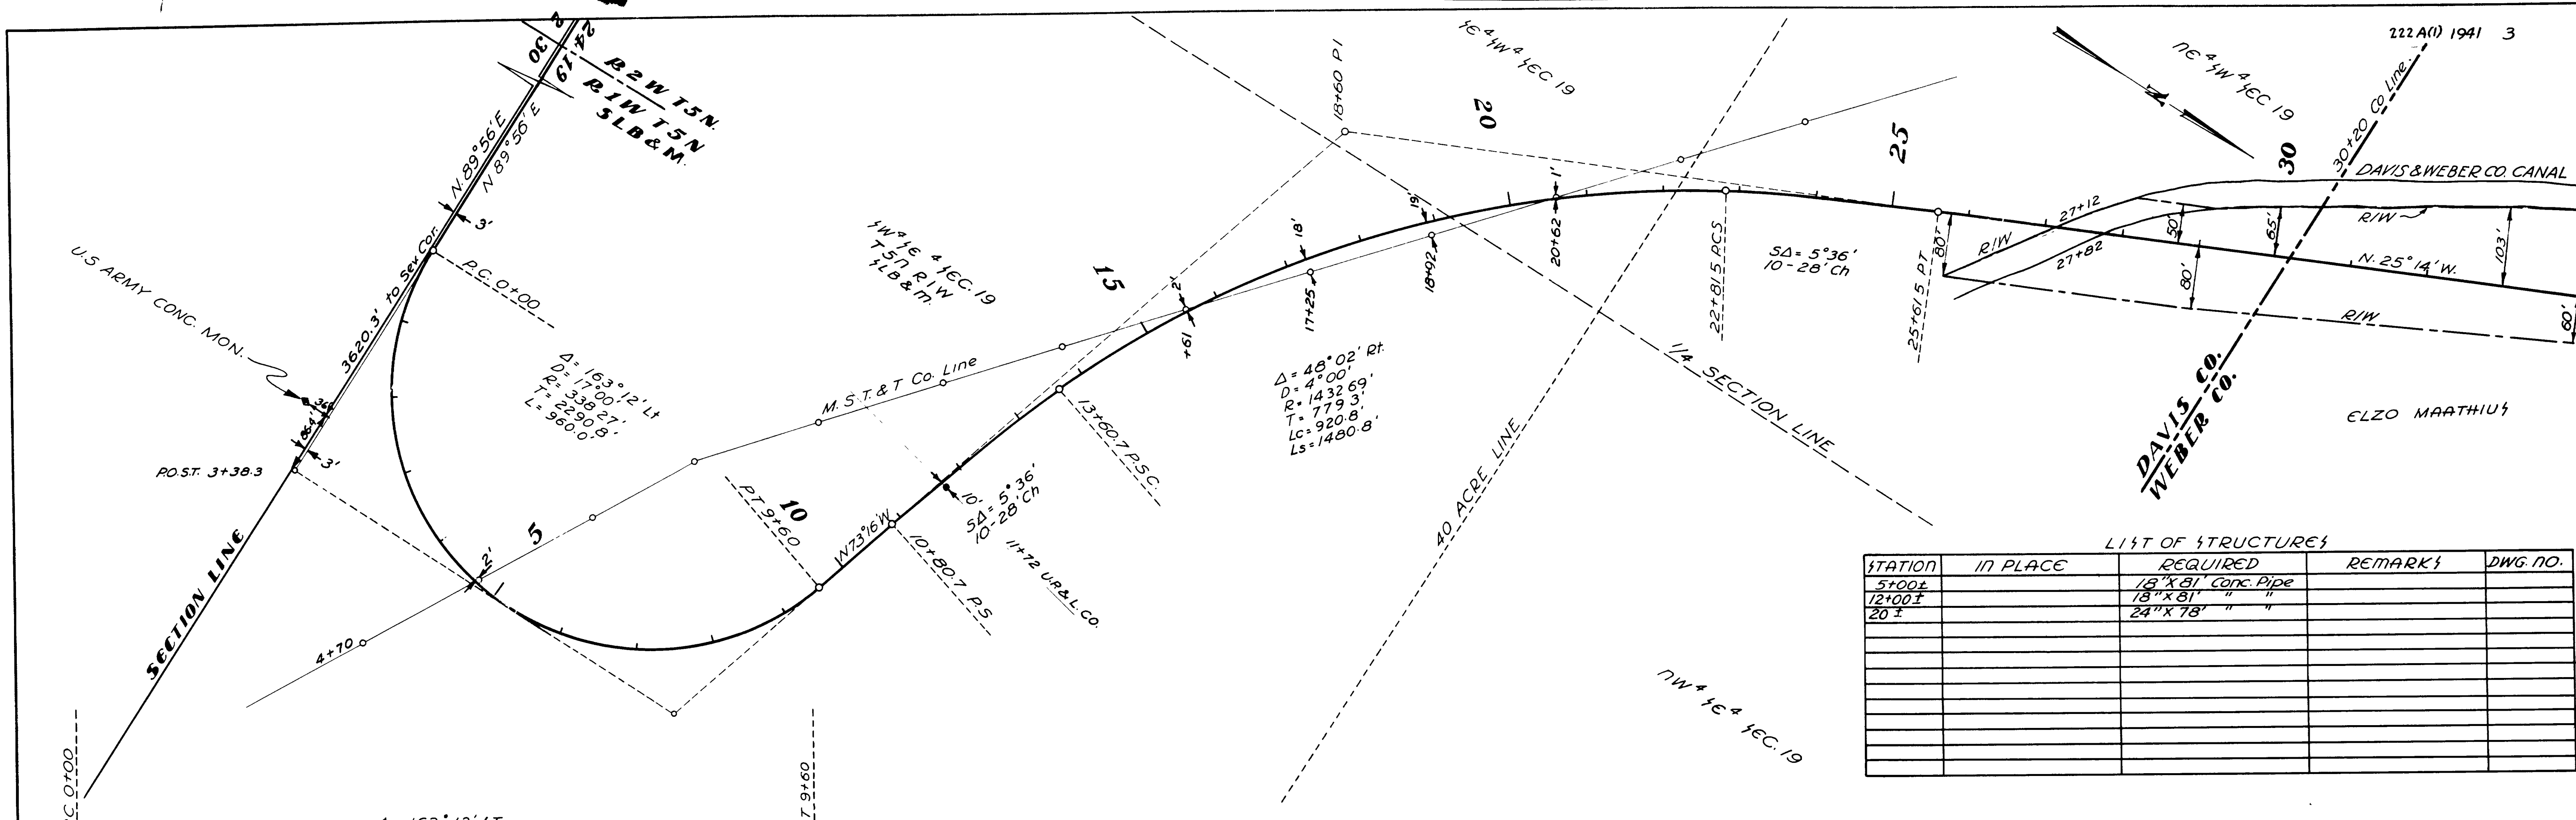


LIST OF STRUCTURES

STATION	IN PLACE	REQUIRED	REMARKS	DWG. NO.
5+00±		18" X 81" CONC. PIPE		
12+00±		18" X 81" "		
20±		24" X 78" "		

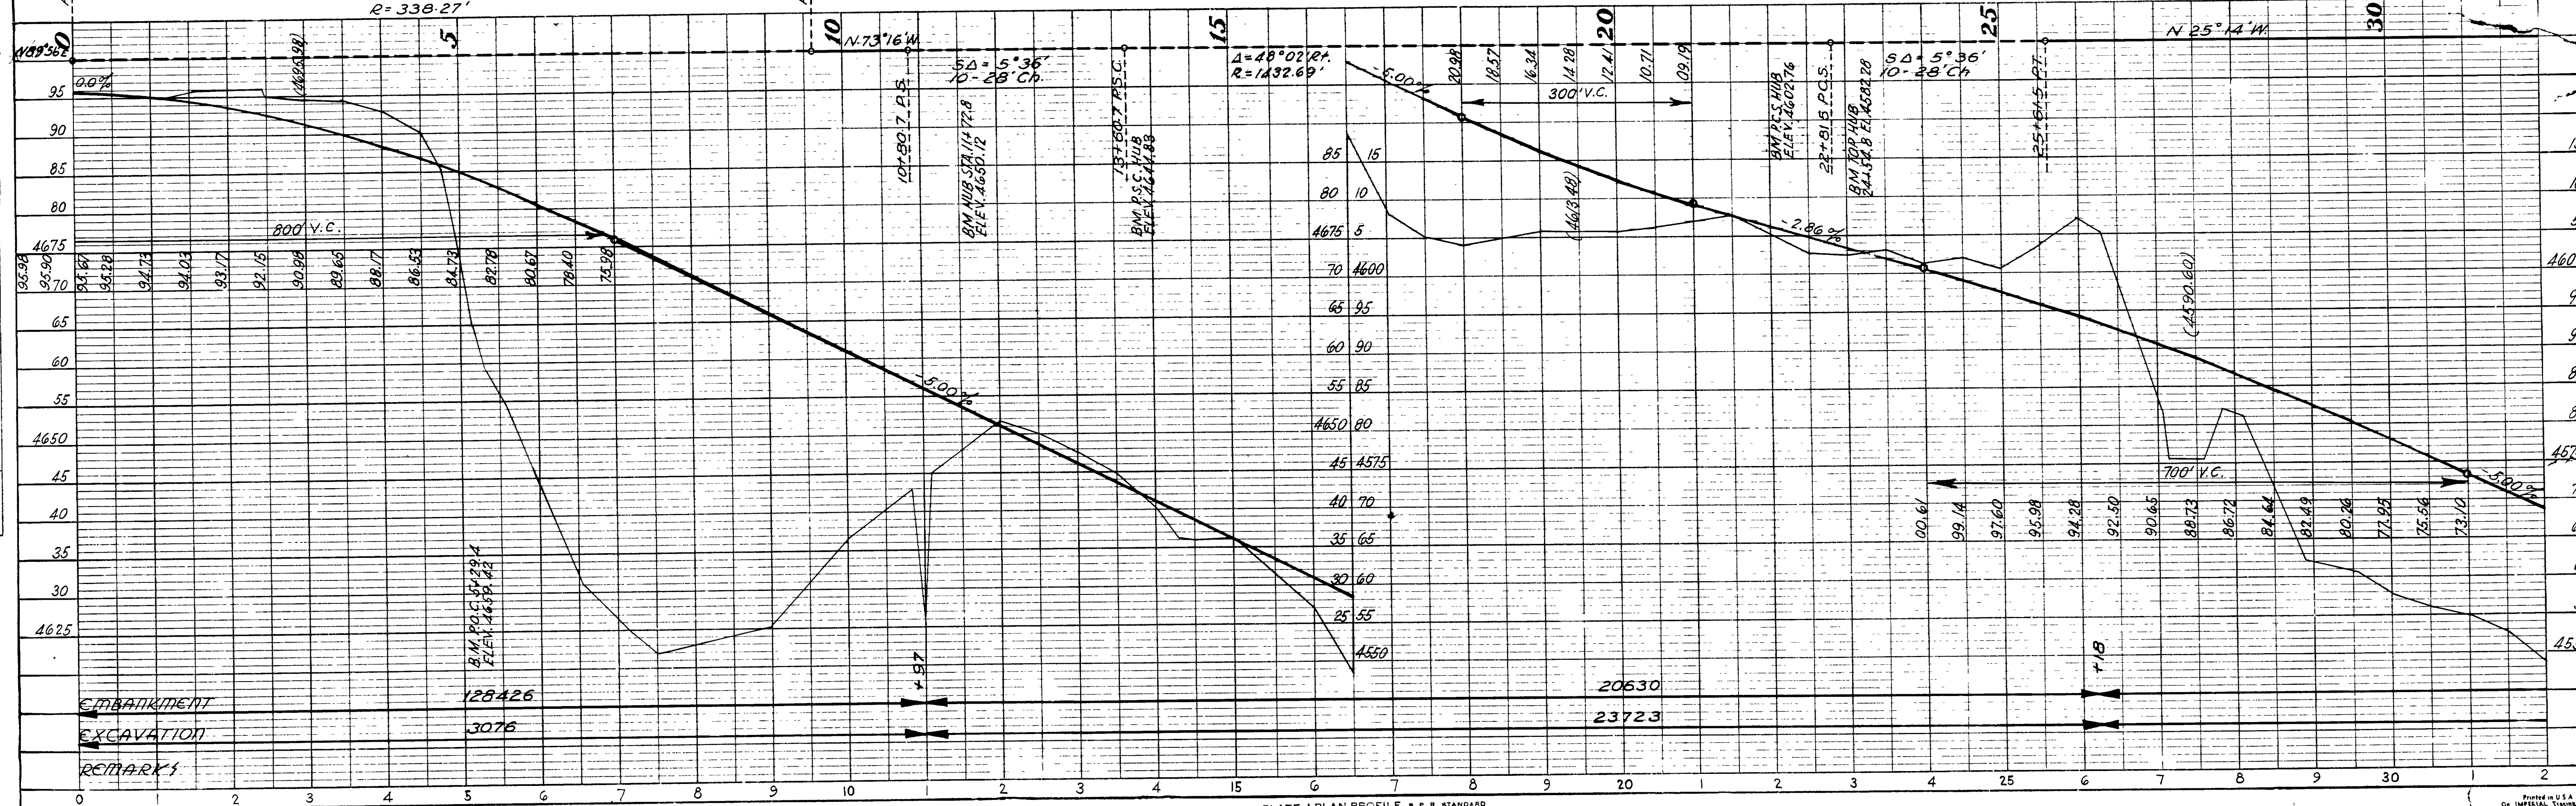

1941
J.B. BURNS
J.B. BURNS
H.S. MCGILL
R.H. LOGGIE
4799 TRACED

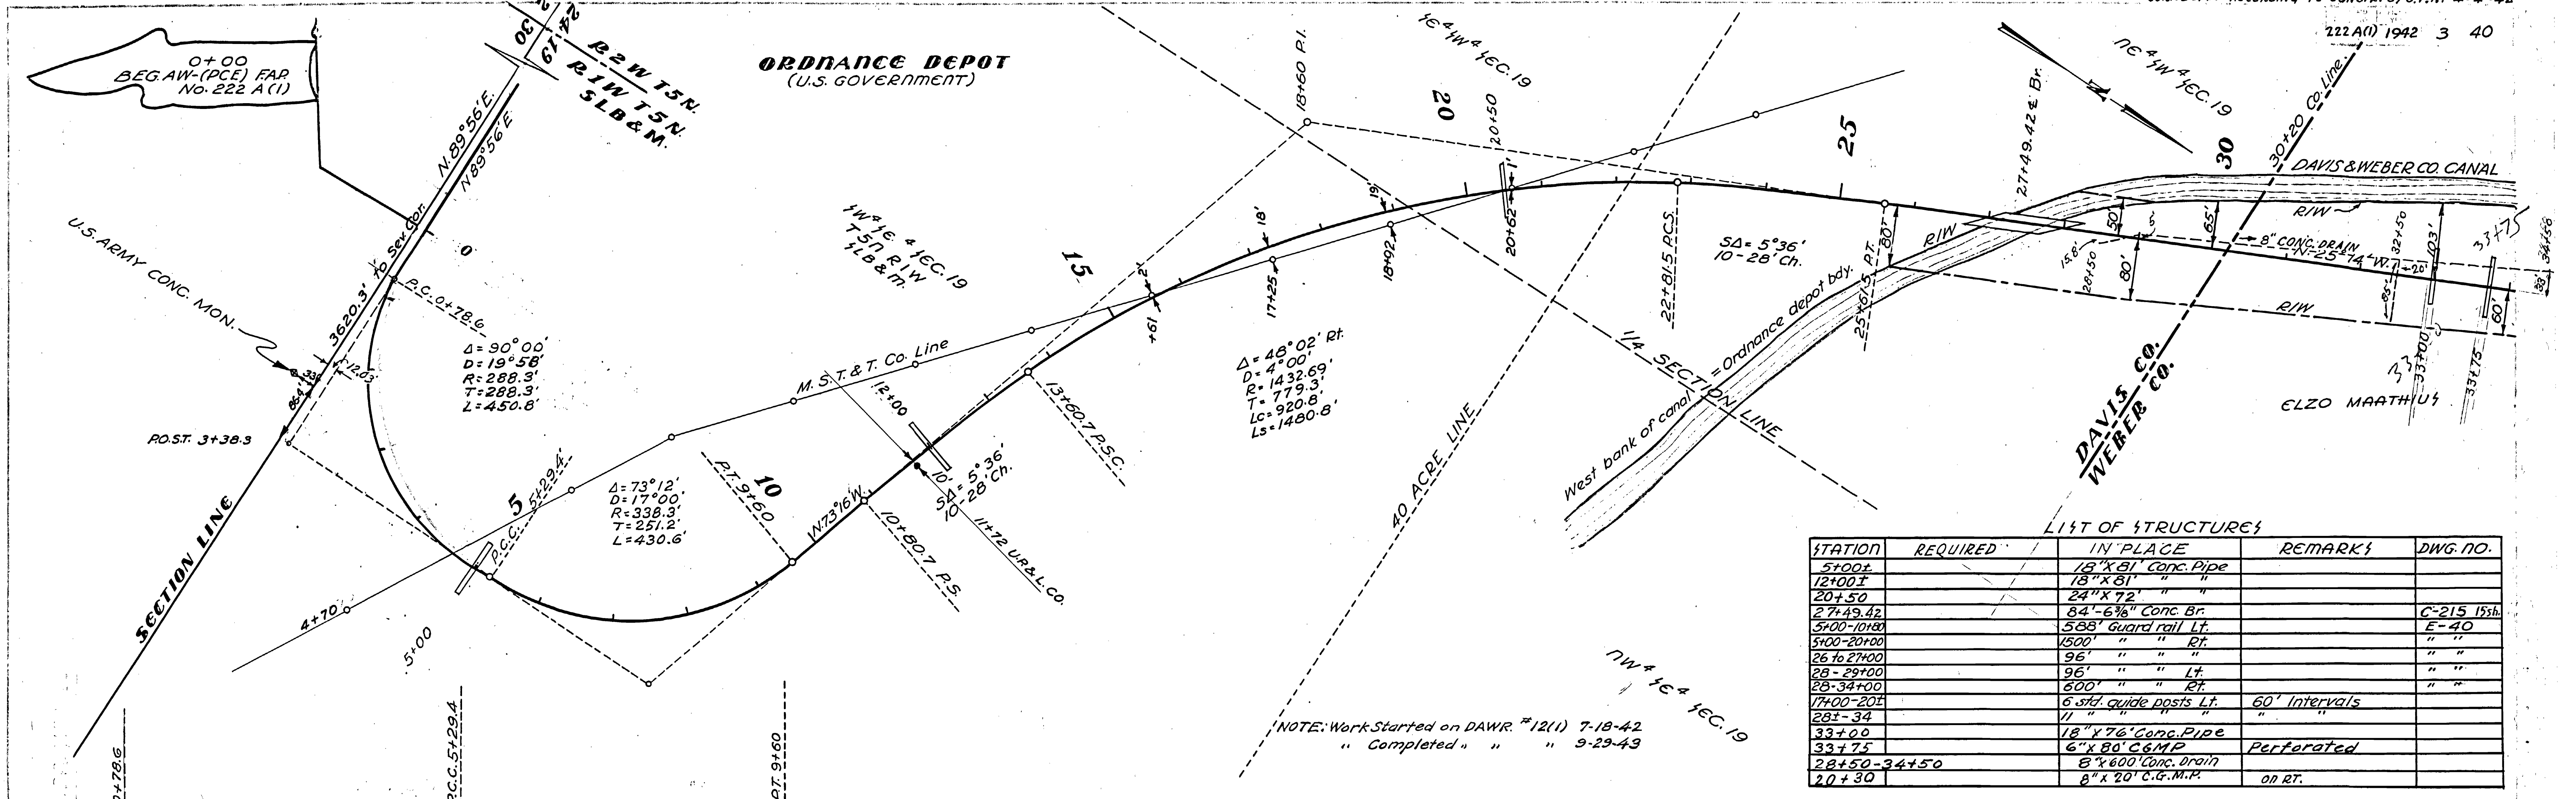


LIST OF STRUCTURES

STATION	REQUIRED	IN PLACE	REMARKS	DWG. NO.
5+00±		18" X 81" Conc. Pipe		
12+00±		18" X 81" " "		
20+50		24" X 72" " "		
27+49.42		84"-6 3/8" Conc. Br.	C-215 15sh	
5+00-10+00		588' Guard rail Lt.	E-40	
5+00-20+00		1500' " " Rt.	" "	
26 to 27+00		96' " " " "	" "	
28-29+00		96' " " Lt.	" "	
28-34+00		600' " " Rt.	" "	
17+00-20±		6 std. guide posts Lt.	60' Intervals	
28±-34		" " " "	" "	
33+00		18" X 76" Conc. Pipe		
33+75		6" X 80" C.G.M.P.	Perforated	
28+50-34+50		8" X 600' Conc. Drain		
20+30		8" X 20' C.G.M.P.	on RT.	

NOTE: Work Started on DAWR #12(1) 7-18-42
" Completed " " " 3-29-43

1941
J.B. BURNS
J.B. BURNS
H.S. MCGILL
R.H. LOGGIE
4793

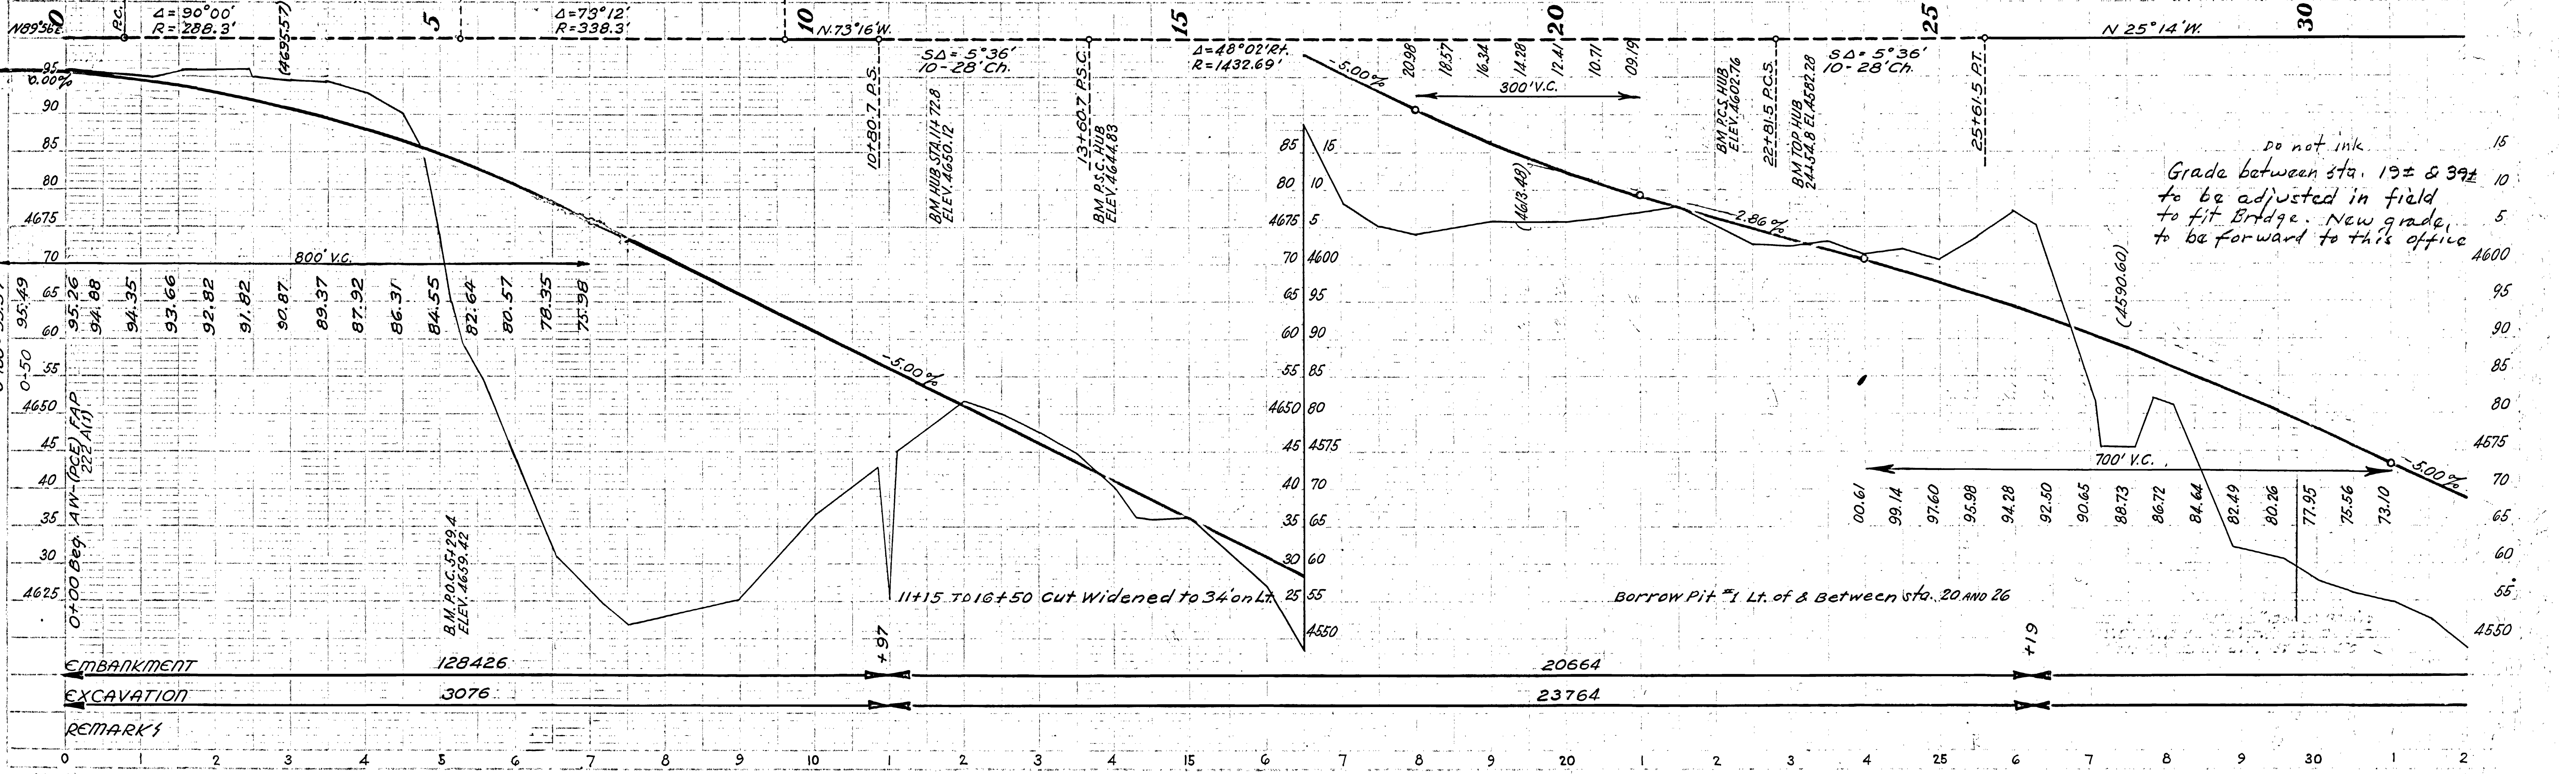


Do not ink.
Grade between sta. 19± & 39±
to be adjusted in field
to fit Bridge. New grade
to be forward to this office

EMBANKMENT 128426 20664
EXCAVATION 3076 23764
REMARKS


DATE: 7/27/1991
 BY: J.B. BURNS
 CHECKED: J.S. MASON
 REVISION: H.S. WELCH
 TRACED: H.S. WELCH
 PLAN: SURVEYED, PLOTTED, GRADES CHECKED, REVISIONS CHECKED, NO. 2793

DATE: 7/27/1991
 BY: J.B. BURNS
 CHECKED: J.S. MASON
 REVISION: H.S. WELCH
 TRACED: H.S. WELCH
 PROFILE: SURVEYED, PLOTTED, GRADES CHECKED, REVISIONS CHECKED, NO. 2793

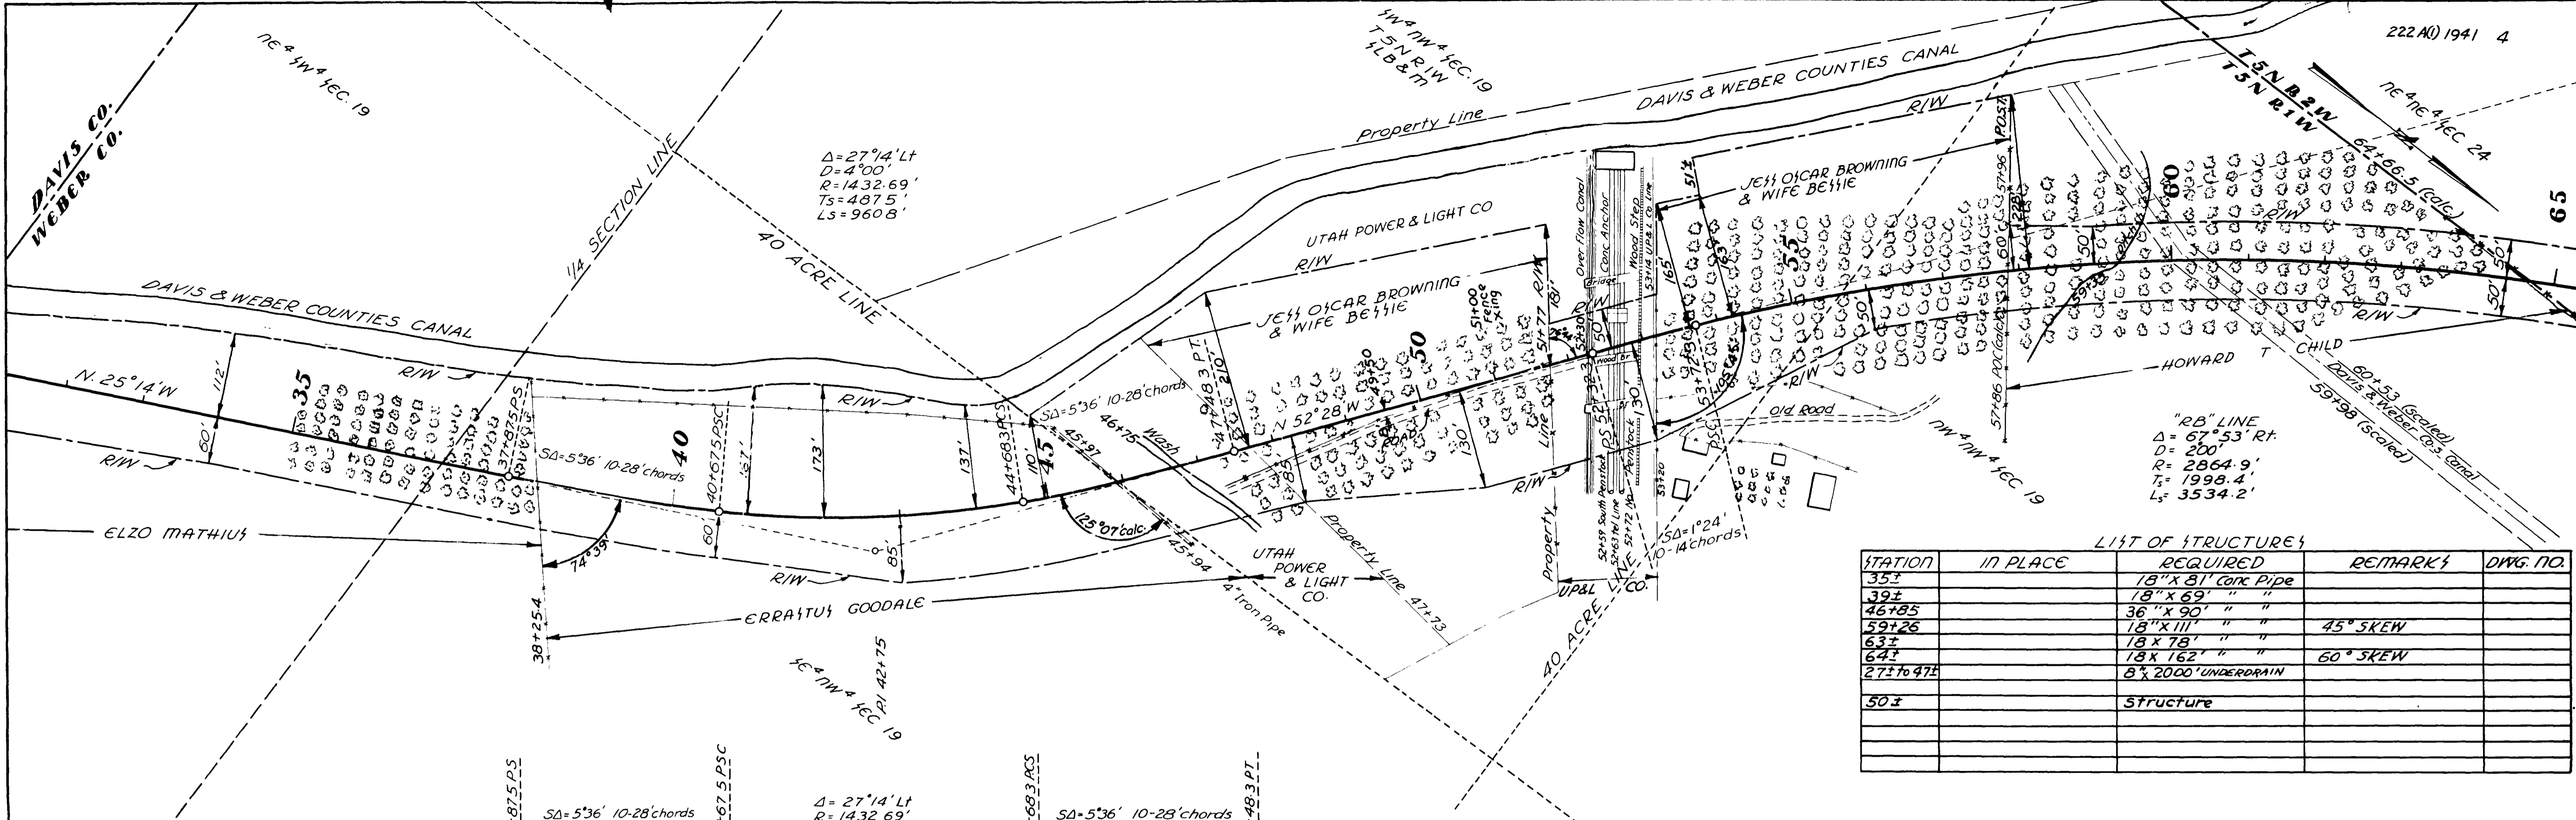


LIST OF STRUCTURES

STATION	IN PLACE	REQUIRED	REMARKS	DWG. NO.
35±		18" X 81" Corc Pipe		
39±		18" X 69" "		
46+85		36" X 90" "		
59+25		18" X 111" "	45° SKEW	
63±		18" X 78" "		
64±		18" X 162" "	60° SKEW	
27± to 47±		8" X 2000' UNDERDRAIN		
50±		Structure		

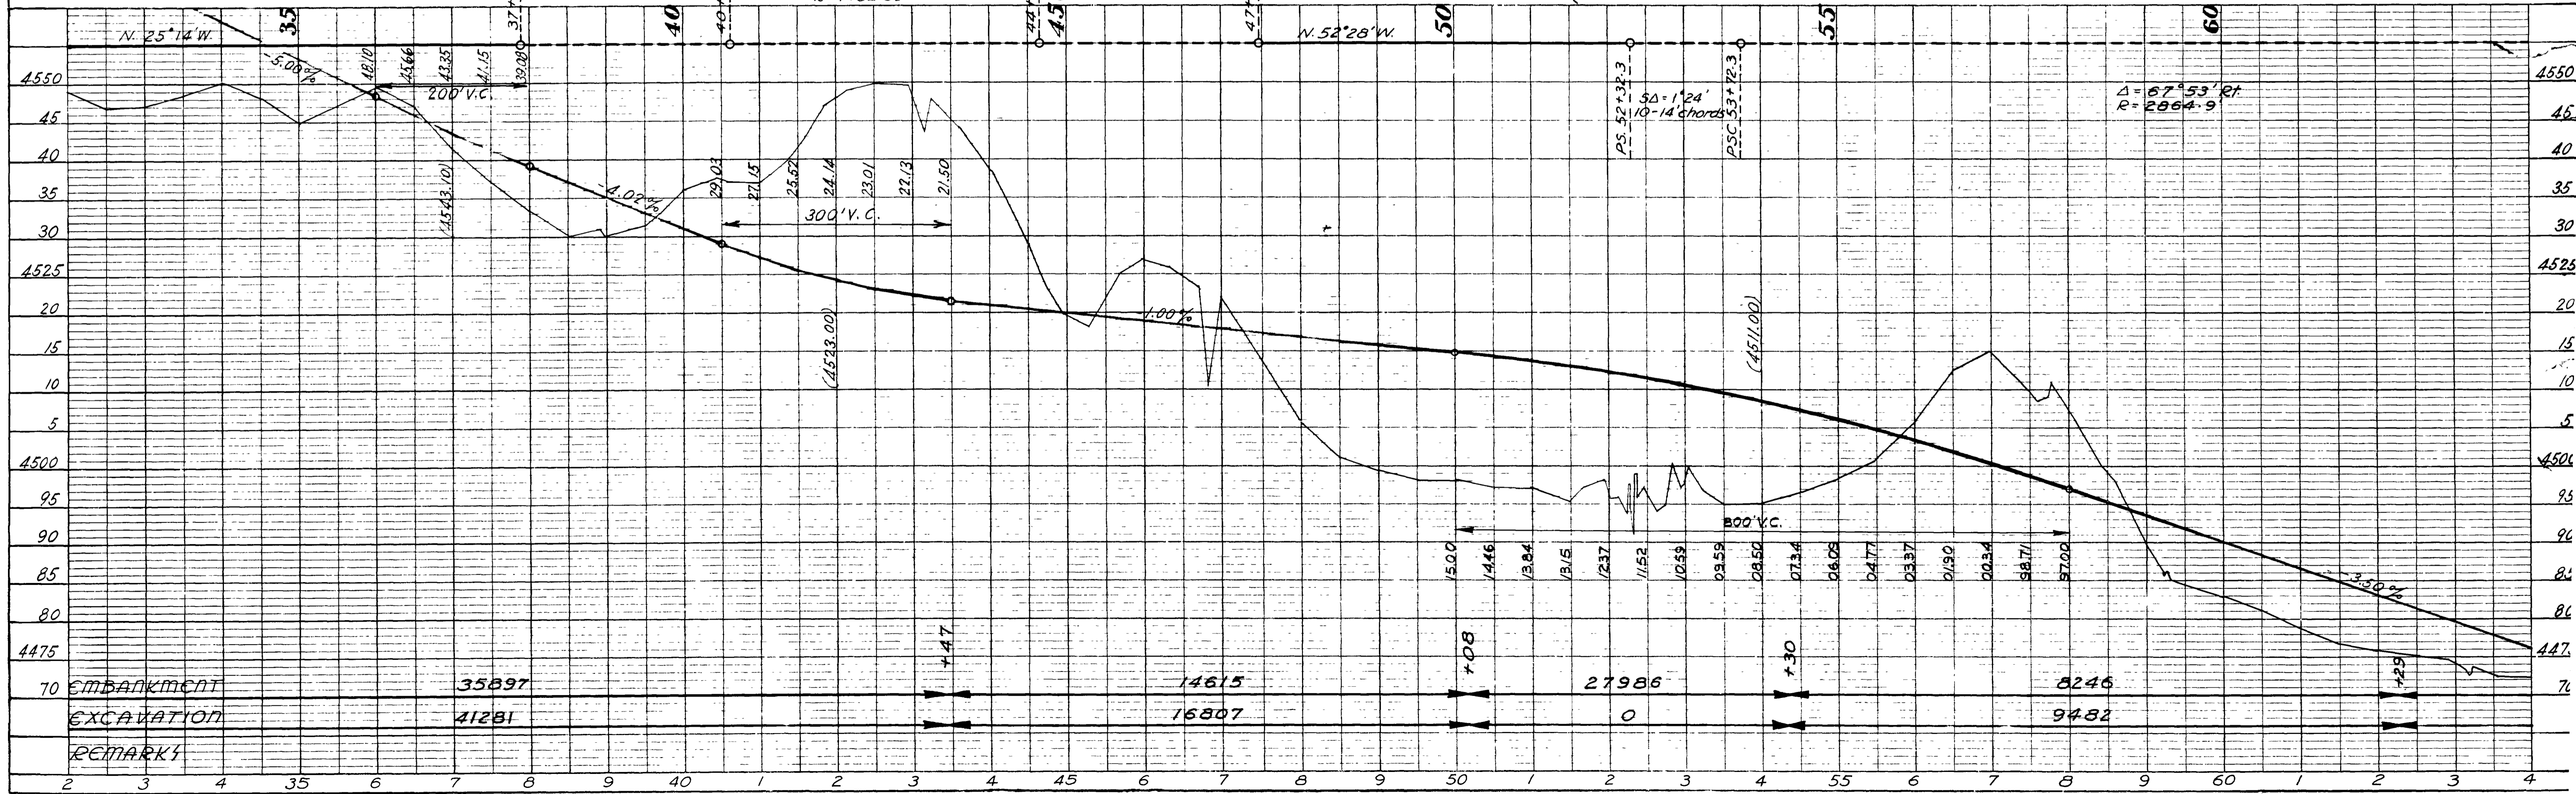


1941
J.B. BUEBENS
H.S. MOORE
H.S. MOORE
4799 TRACED

1941
J.B. BUEBENS
H.S. MOORE
H.S. MOORE
4793

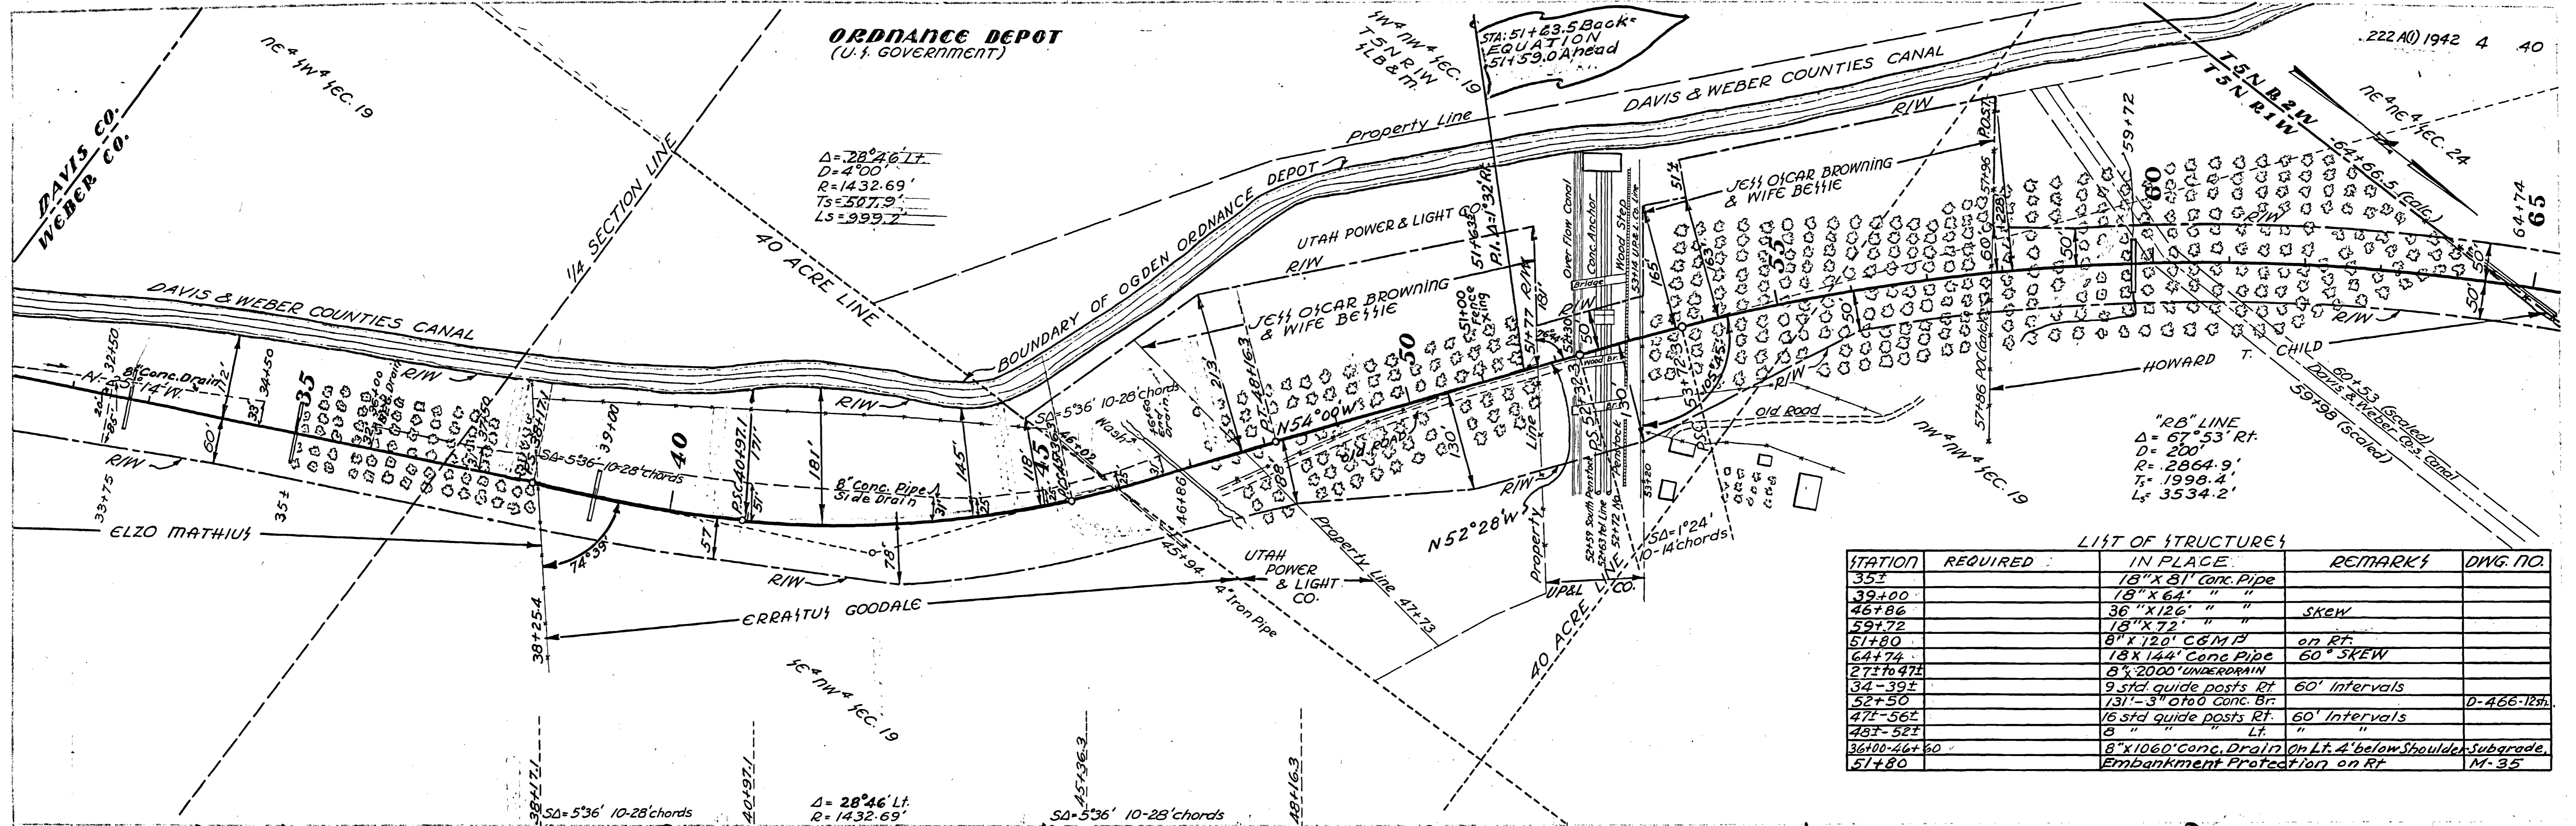


LIST OF STRUCTURES

STATION	REQUIRED	IN PLACE	REMARKS	DWG. NO.
35±		18" x 81" Conc. Pipe		
39+00		18" x 64" " "		
46+86		36" x 126" " "	skew	
59+72		18" x 72" " "		
51+80		8" x 120' C&G P	on Rt.	
64+74		18 x 144' Conc Pipe	60° SKEW	
27± to 47±		8" x 2000' UNDERDRAIN		
34-39±		9 std guide posts Rt	60' Intervals	
52+50		131'-3" o to o Conc. Br		D-466-12th
47±-56±		16 std guide posts Rt	60' Intervals	
48±-52±		8 " " Lt.	"	
36+00-46+60		8" x 1060' Conc. Drain	On Lt. 4' below Shoulder Subgrade.	
51+80		Embankment Protection on Rt.	M-35	

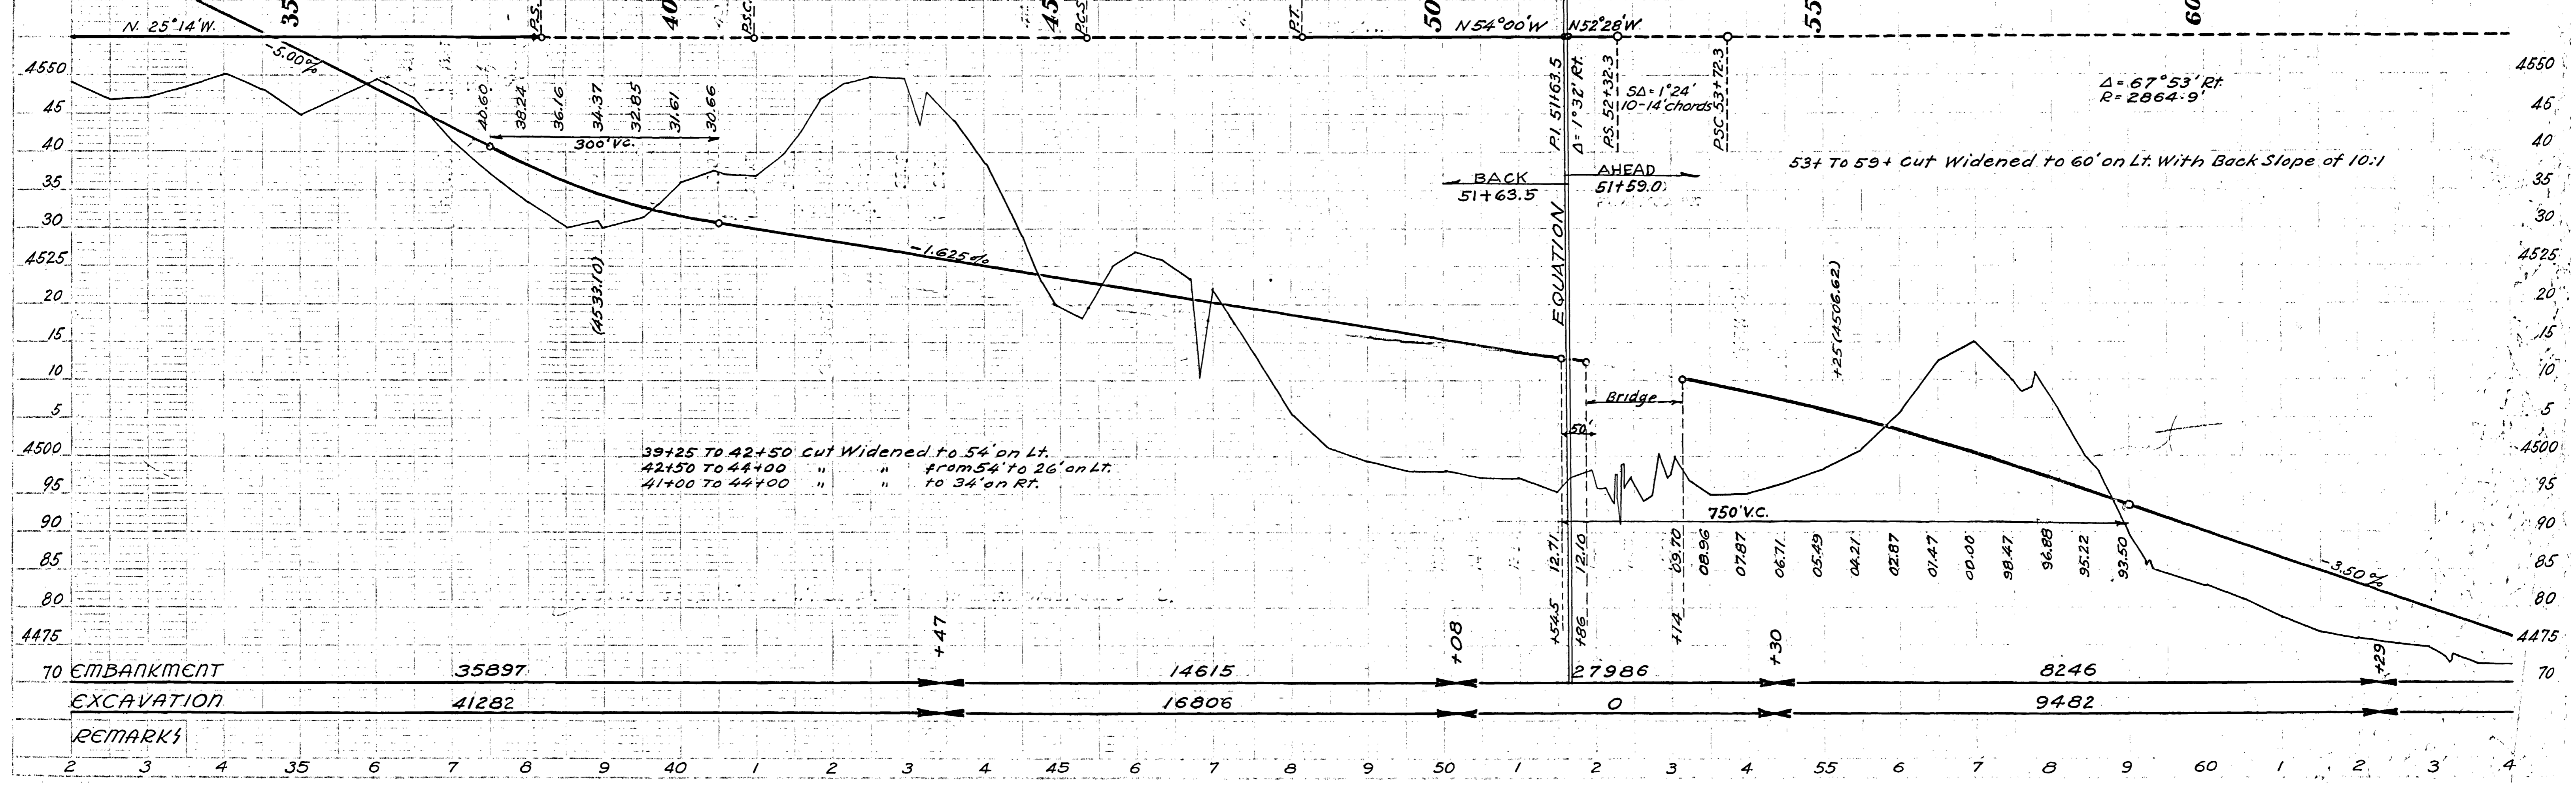


DATE	BY	REVISIONS
7/27/41	J.B. BURNS	
	H.S. WRIGHT	
	H.S. WRIGHT	
	H.S. WRIGHT	
	H.S. WRIGHT	

DATE	BY	REVISIONS
7/27/41	J.B. BURNS	
	H.S. WRIGHT	
	H.S. WRIGHT	
	H.S. WRIGHT	
	H.S. WRIGHT	

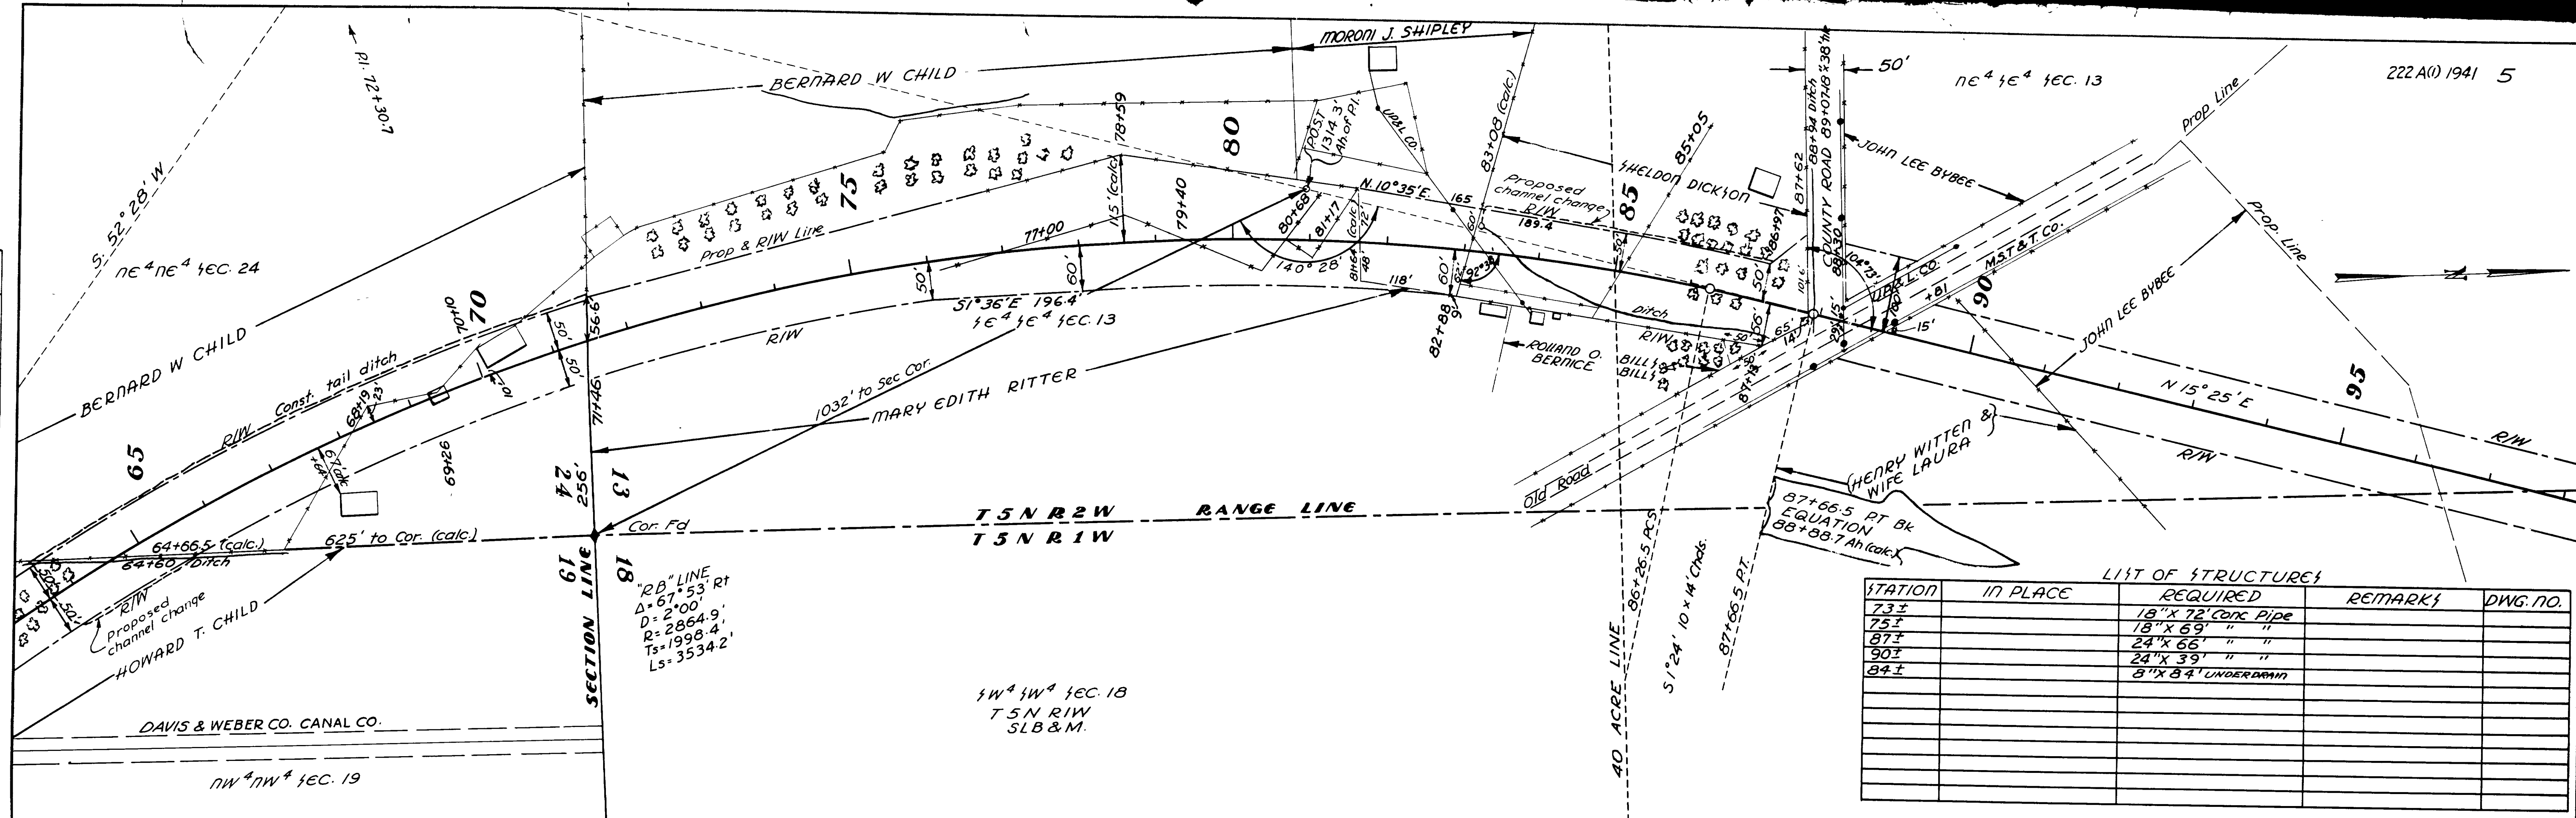


LIST OF STRUCTURES

STATION	IN PLACE	REQUIRED	REMARKS	DWG. NO.
73±		18" x 72" CONC PIPE		
75±		18" x 69" " "		
87±		24" x 66" " "		
90±		24" x 39" " "		
84±		8" x 84" UNDERDRAIN		

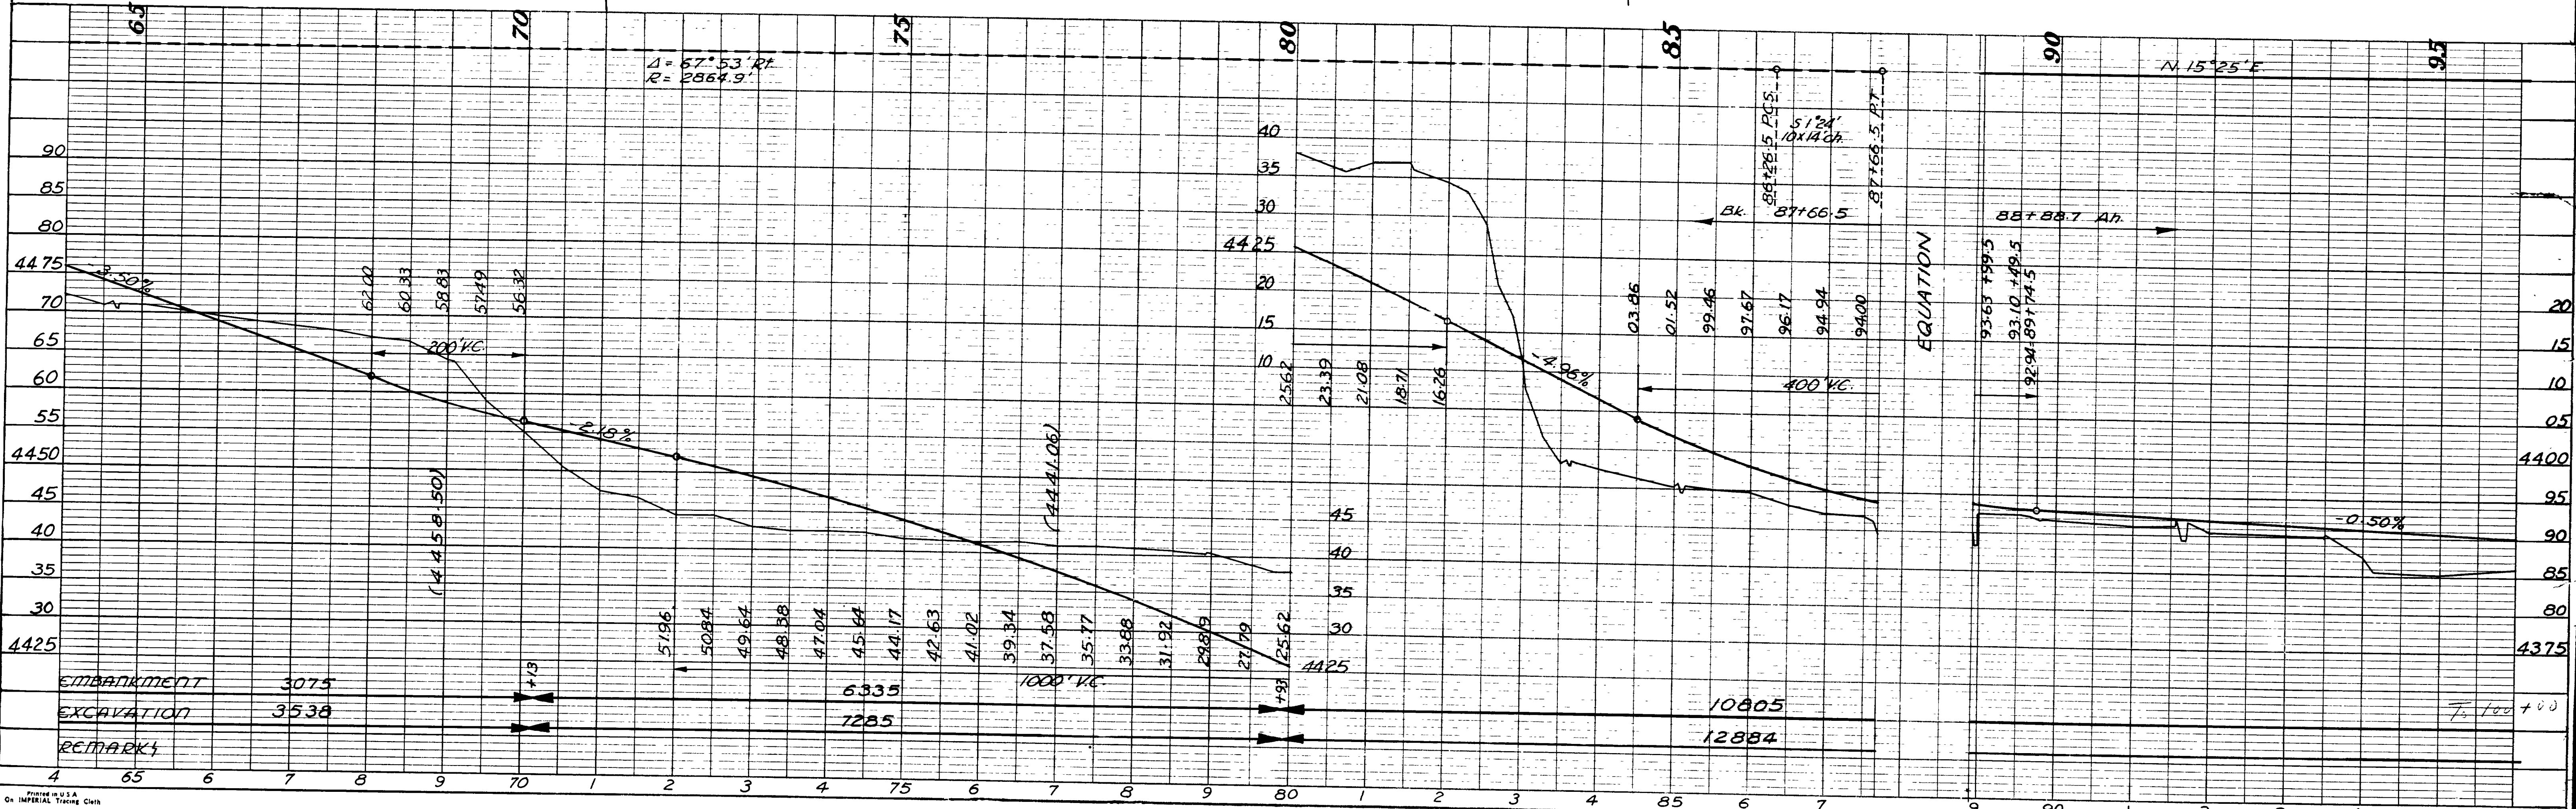

FED. ROAD DIST. NO.	STATE	PROJECT	FISCAL YEAR	SHEET NO.	TOTAL SHEETS
12	UTAH	222-A(1)	1942	5	39
		222-B(1)	"	3	10
		DA-WR. #12(1)	"	3	10


1941
J.B. BURNS
C.E.
H.S. MCGHEE
R.H. MOORE
TRACED
4799


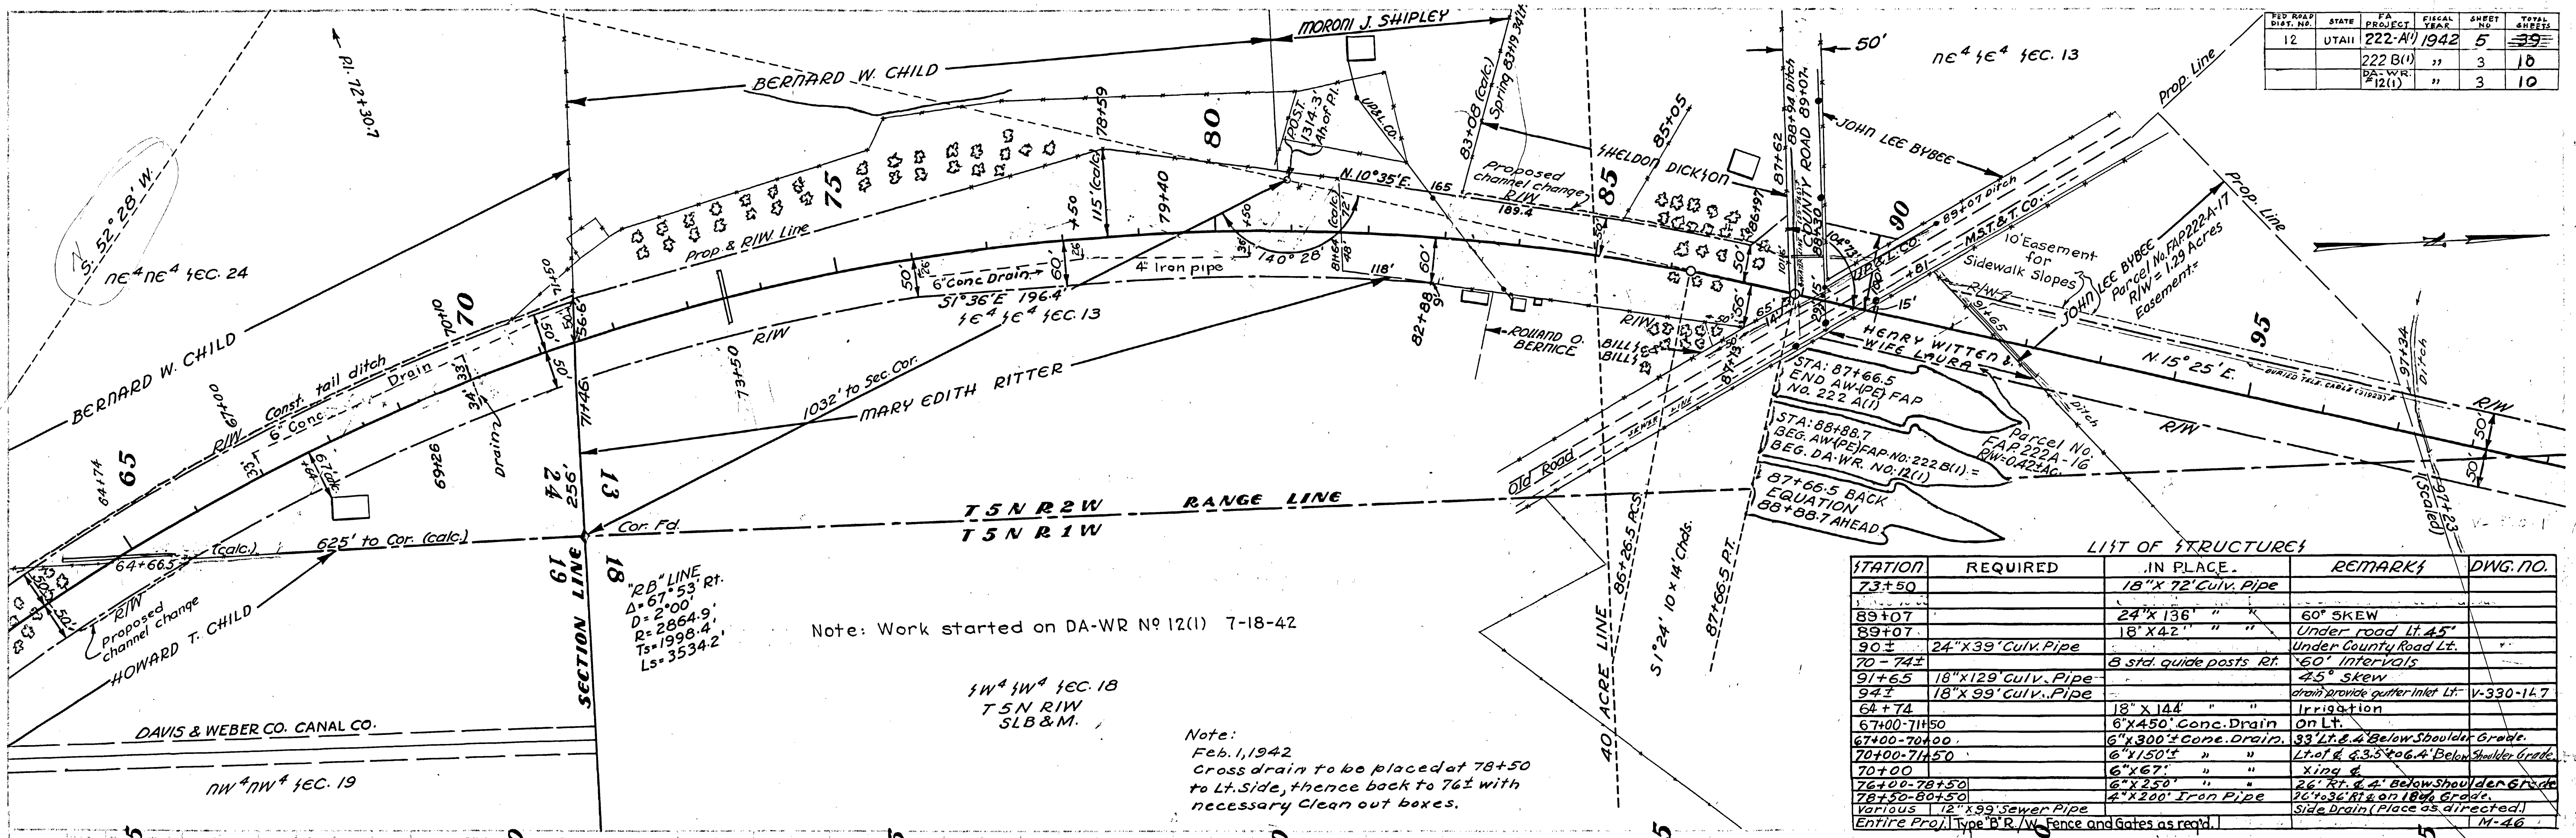


LIST OF STRUCTURES


STATION	REQUIRED	IN PLACE	REMARKS	DWG. NO.
73+50		18" x 72" Culv. Pipe		
89+07		24" x 136" "	60° SKEW	
89+07		18" x 42" "	Under road Lt. 45'	
90±	24" x 39' Culv. Pipe		Under County Road Lt.	
70-74±		3 std. guide posts Rt.	60' Intervals	
91+65	18" x 129' Culv. Pipe		45° skew	
94±	18" x 99' Culv. Pipe		drain provide gutter Inlet Lt. V-330-147	
64+74		18" x 144" "	Irrigation	
67+00-71+50	6" x 450' Conc. Drain		on Lt.	
67+00-70+00	6" x 300' Conc. Drain		33' Lt. & 4' Below Shoulder Grade	
70+00-71+50	6" x 150' "		Lt. of 4.35' to 6.4' Below Shoulder Grade	
70+00	6" x 67' "		Xing. &	
76+00-78+50	6" x 250' "		24' Rt. & 4' Below Shoulder Grade	
78+50-80+50	4" x 200' Iron Pipe		20' to 36' Rt. on 18" Grd.	
Various	12" x 99' Sewer Pipe		Side Drain (Place as directed)	
Entire Proj. Type "B" R/W Fence and Gates as reqd.				

1941
J.B. BURNS
C.E.
H.S. MCGHEE
R.H. MOORE
4793

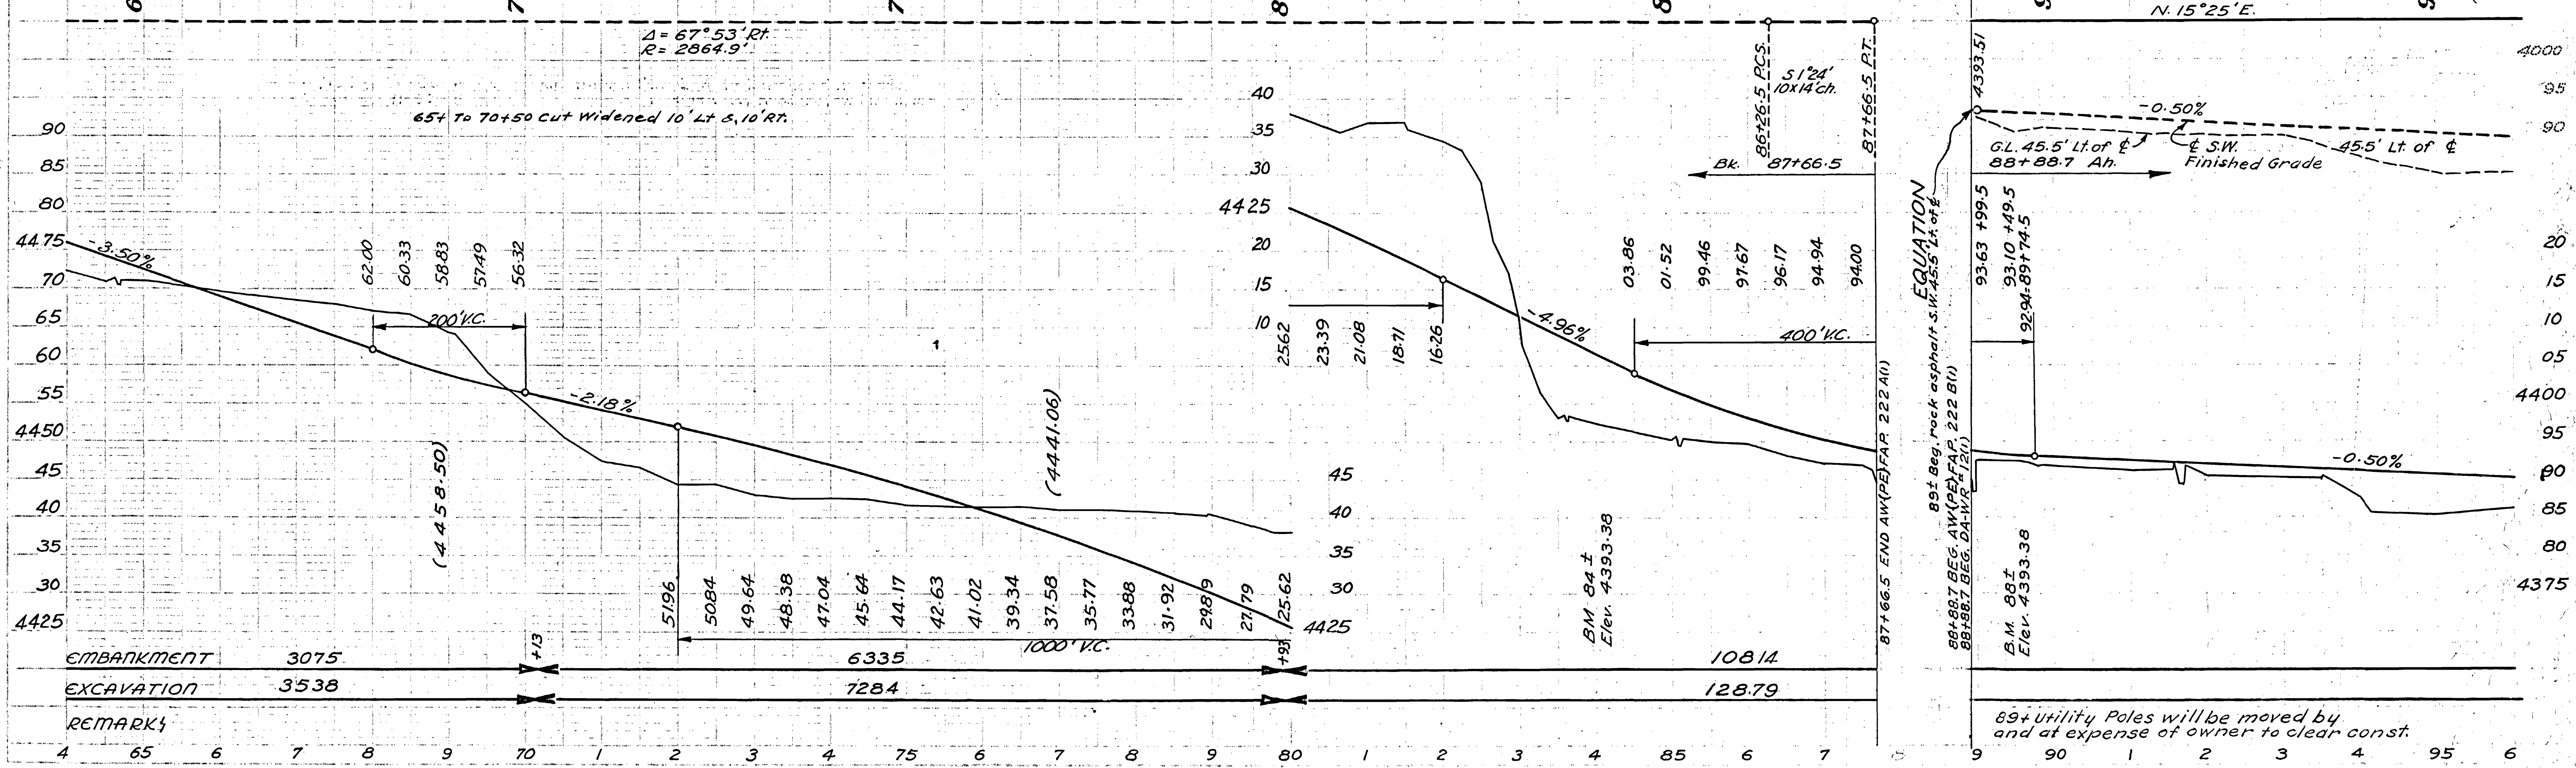


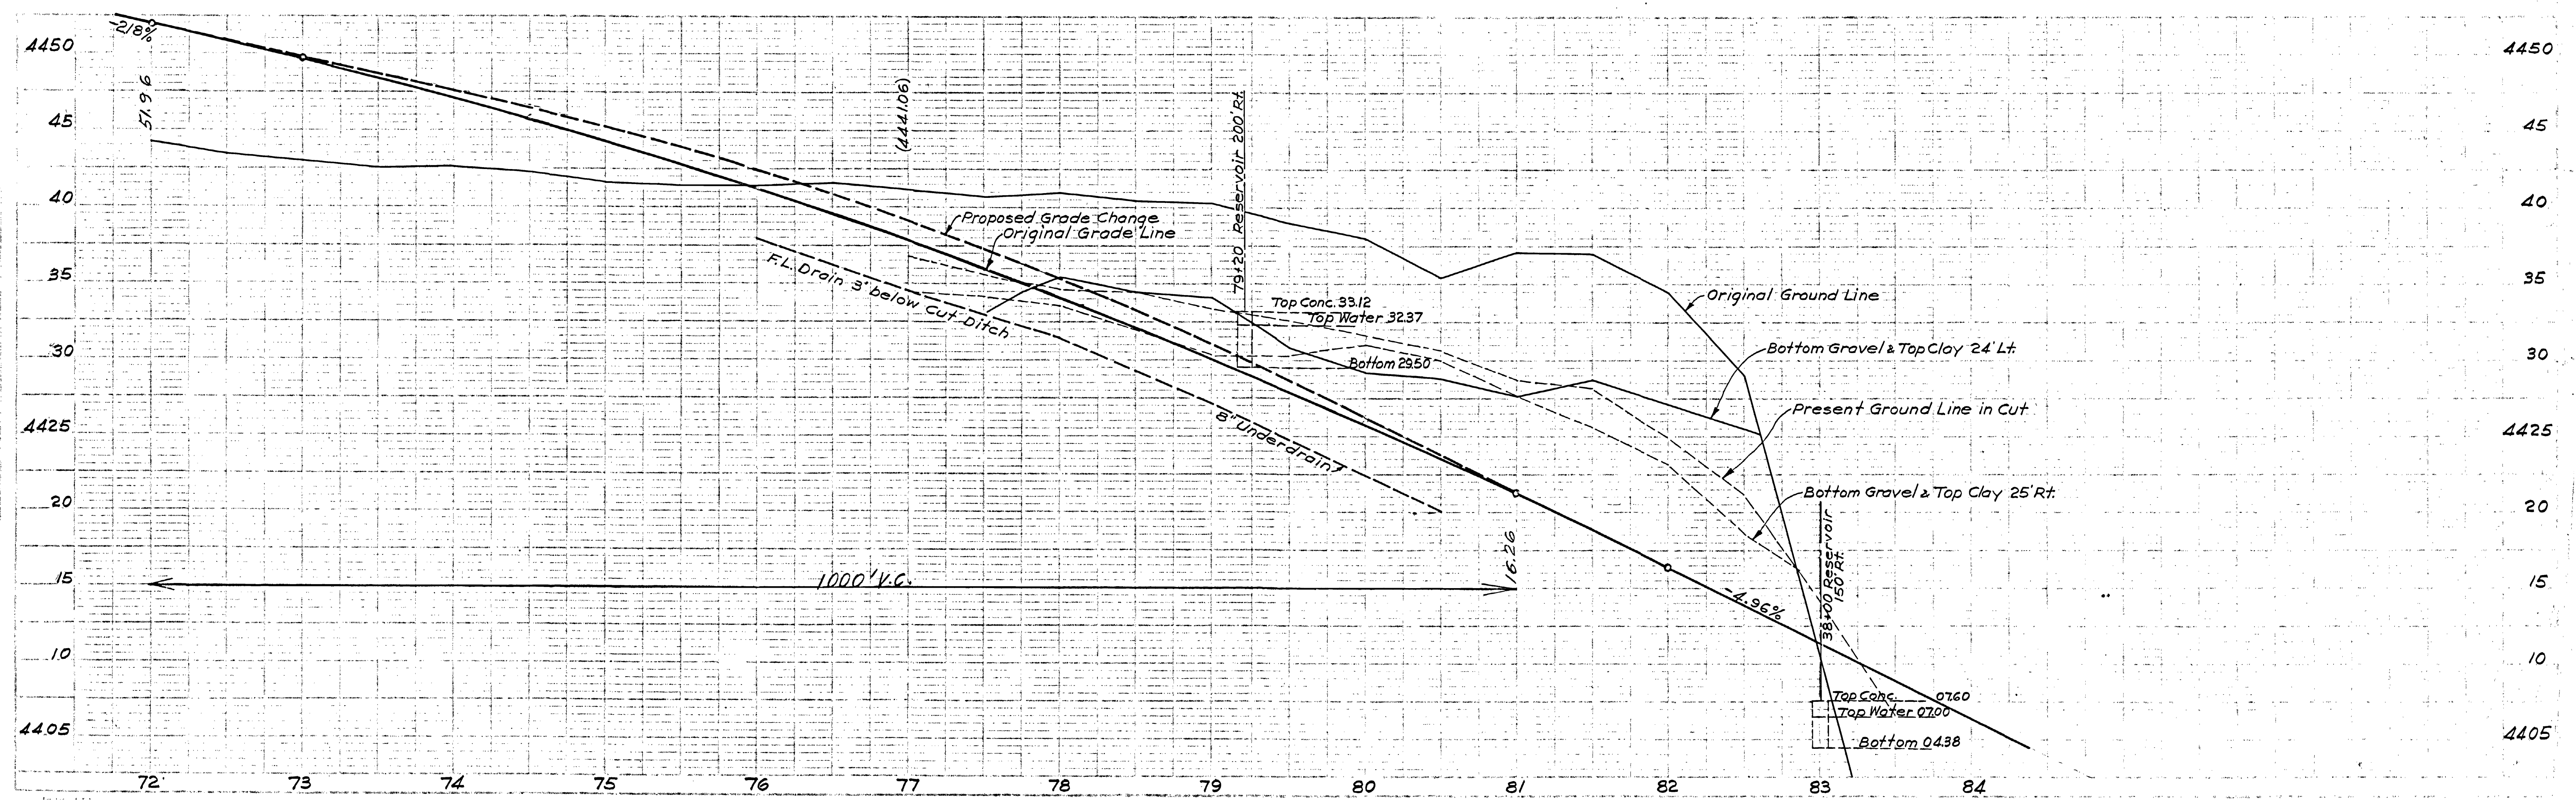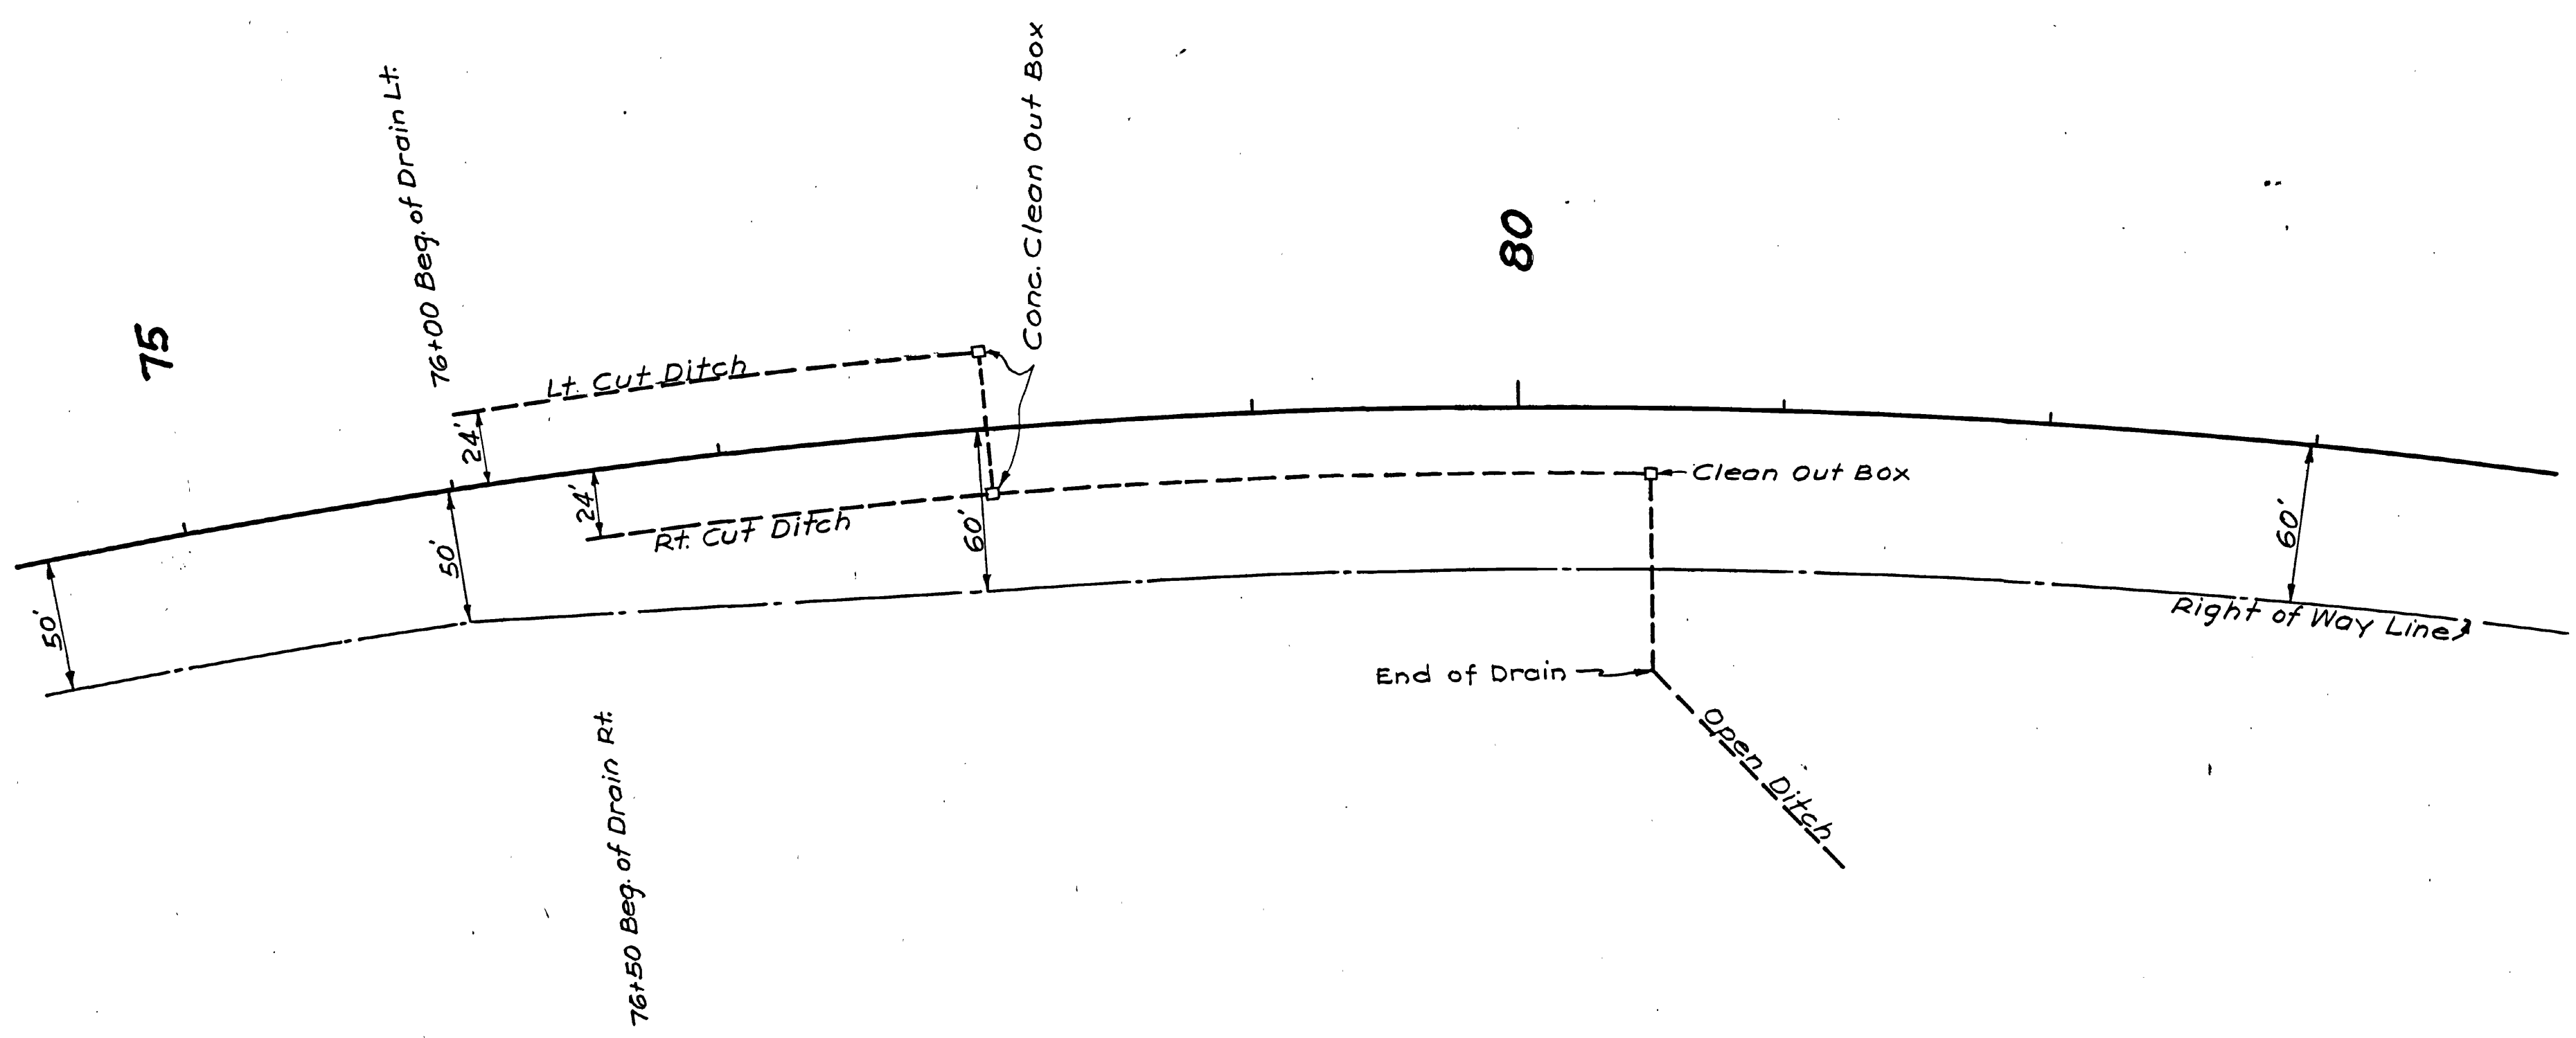


PLAN	SURVEYED	DATE
NOTE BOOK NO.	ALIGNMENT CHECKED	
	RT. OF WAY CHECKED	

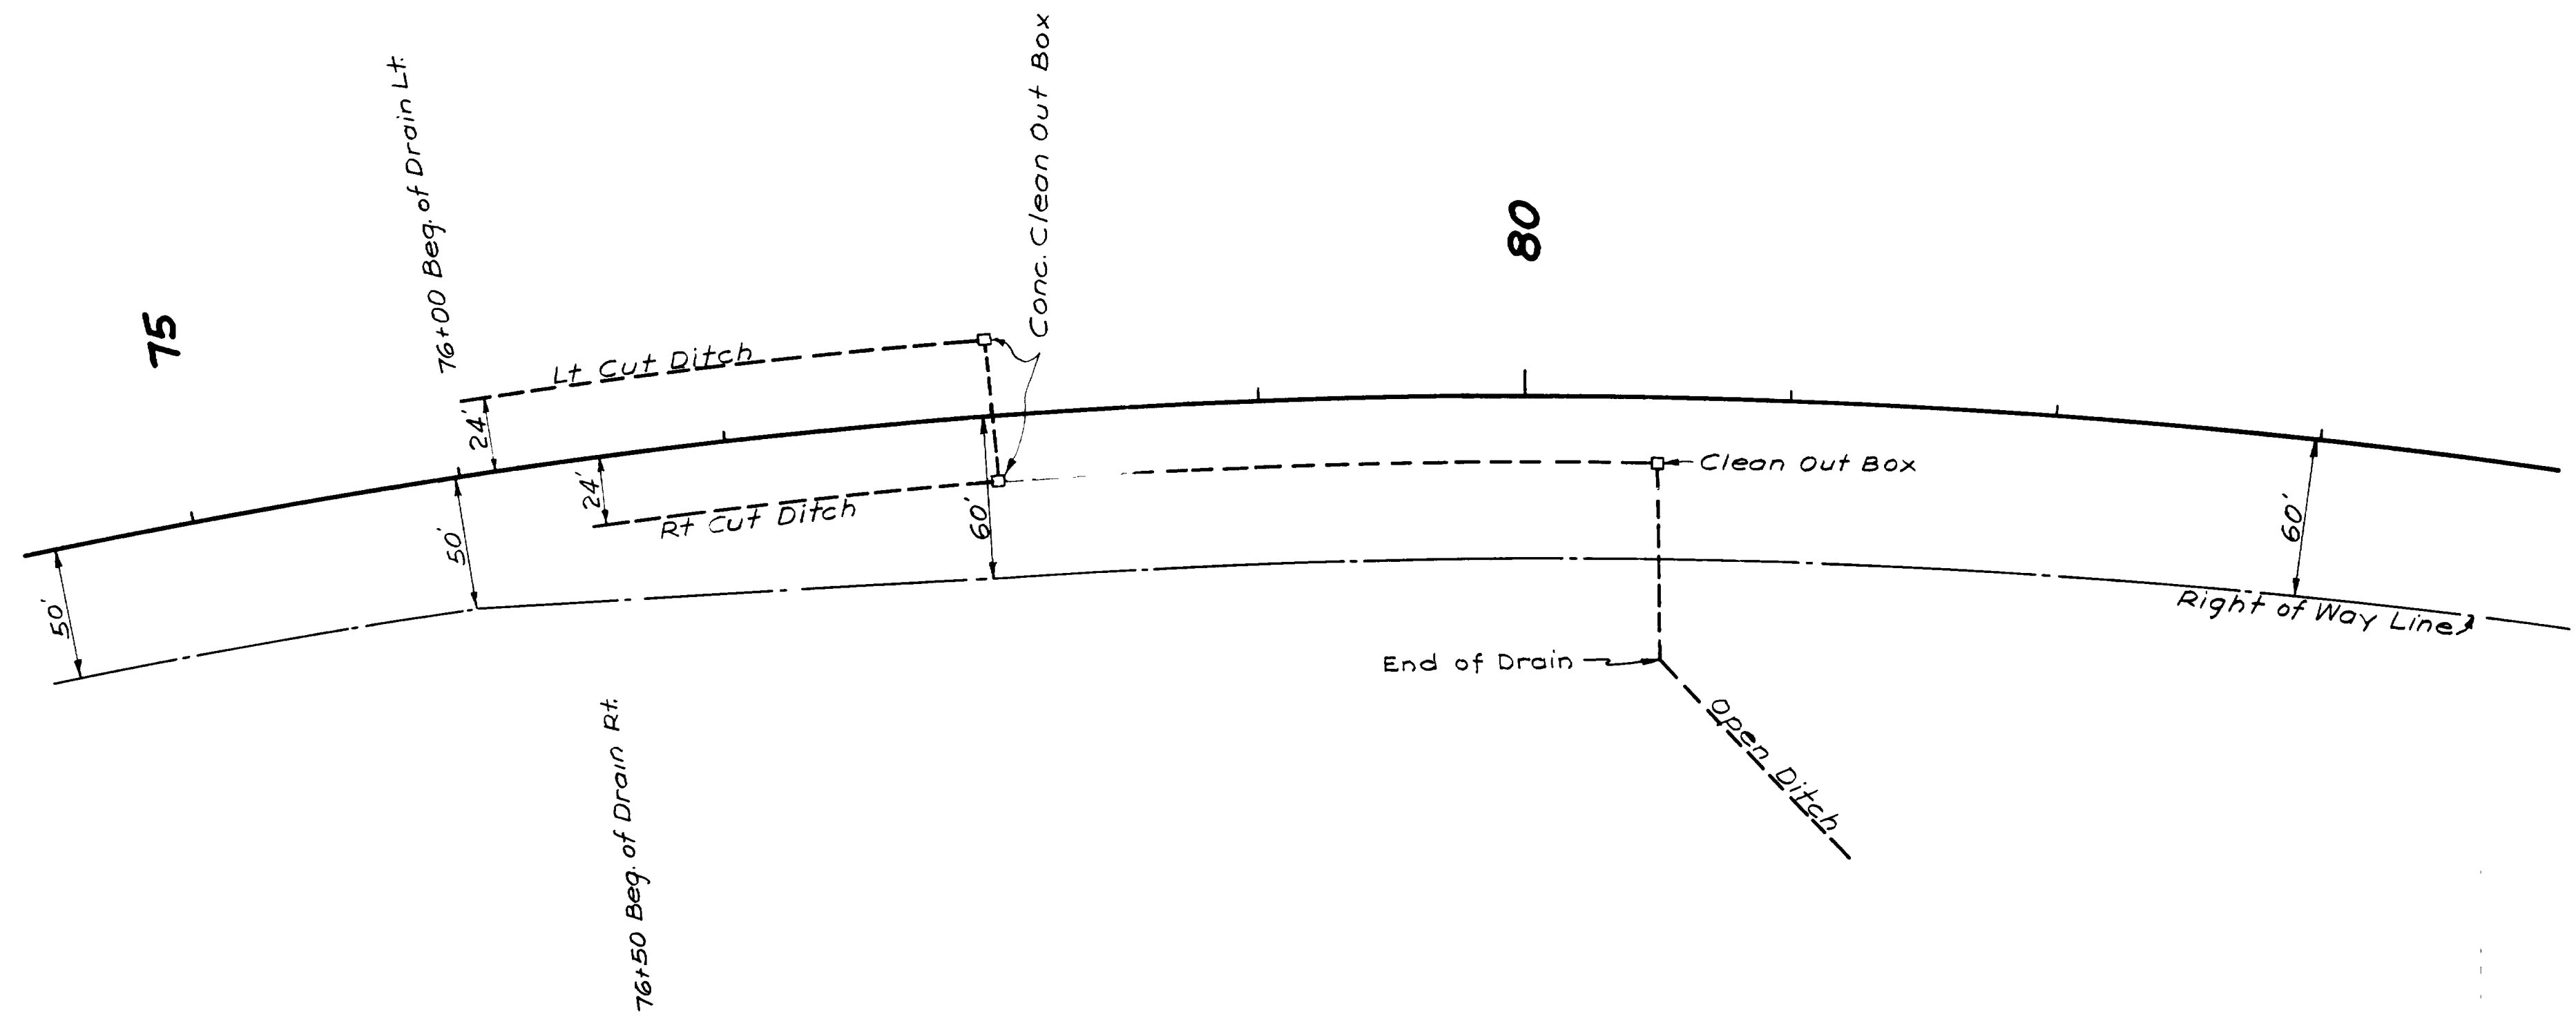

PROFILE	SURVEYED	DATE
NOTE BOOK NO.	GRADES CHECKED	
	B. M. S. NOTED	
	STRUCTURE NOTATION CHECKED	

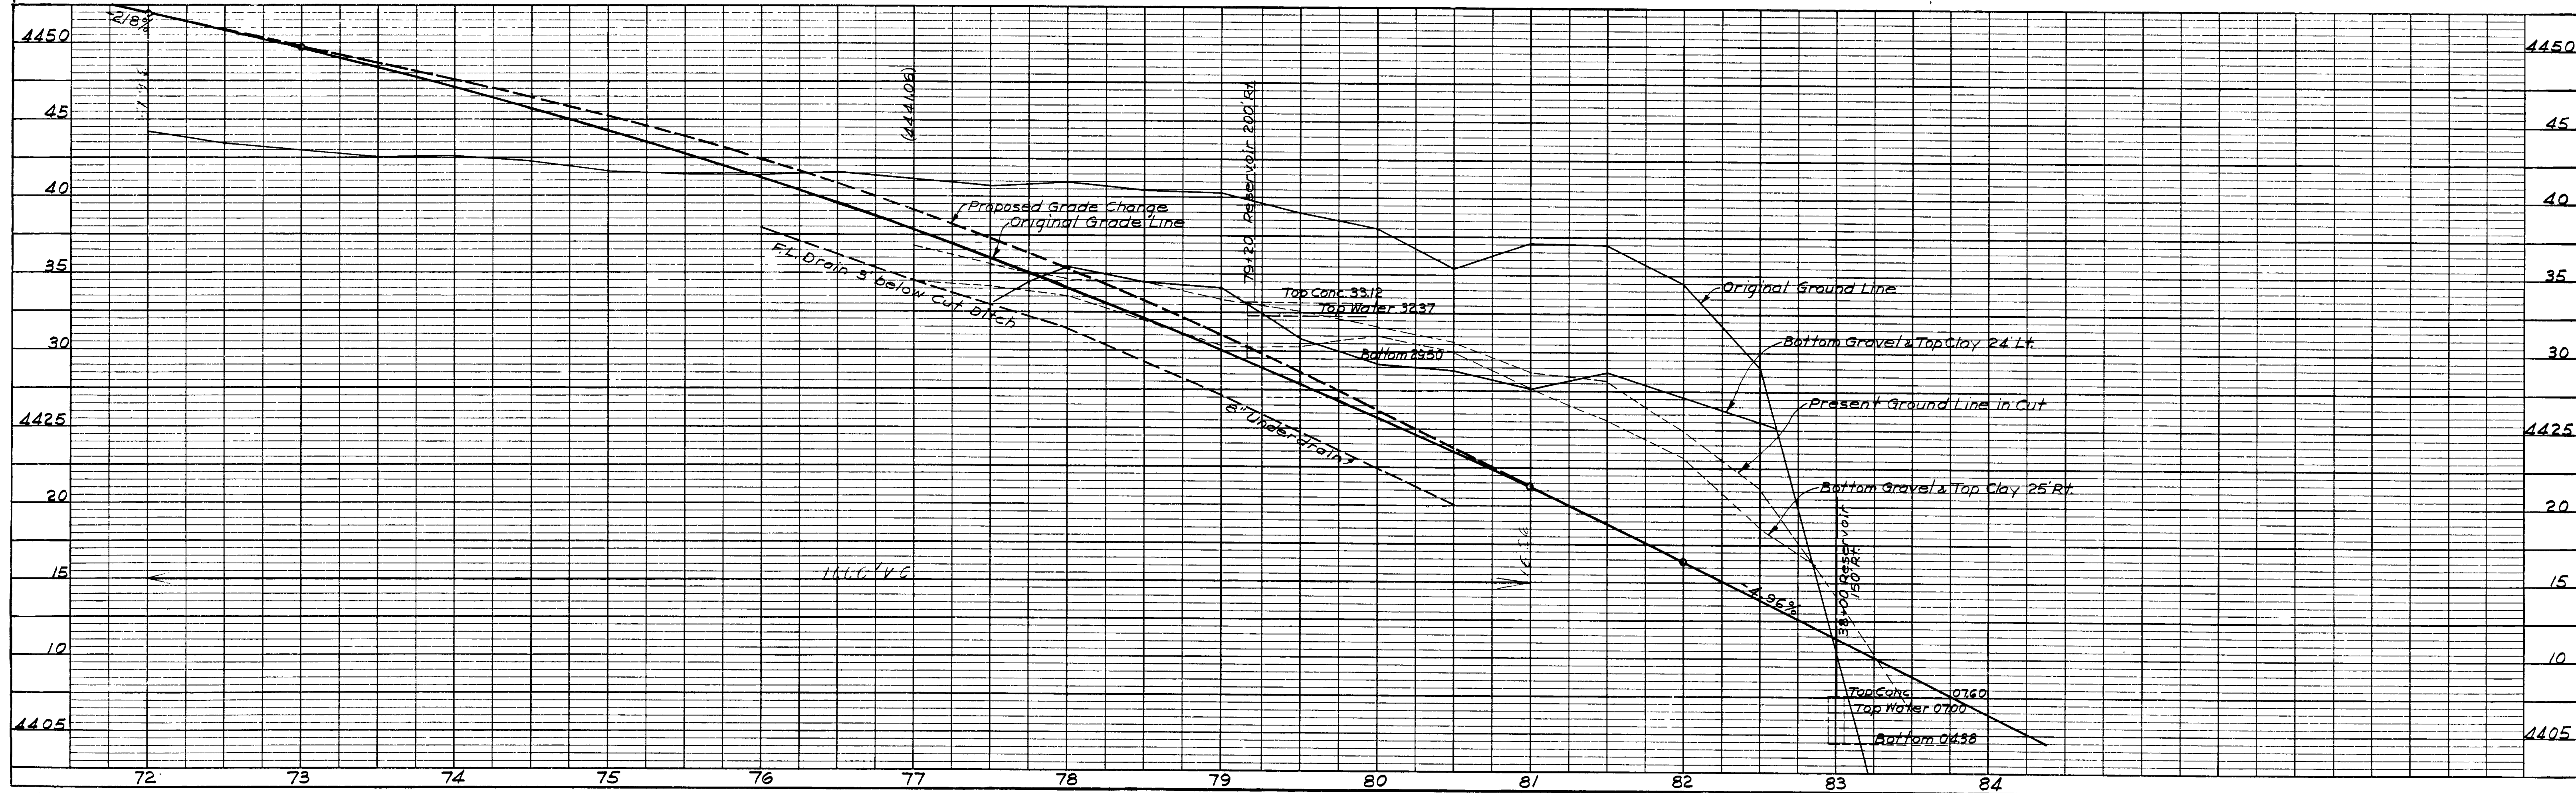

FED. ROAD DIST. NO.	STATE	A.W.F.A. PROJ. NO.	FISCAL YEAR	SHEET NO.	TOTAL SHEETS
12	UTAH	222 A(0)			

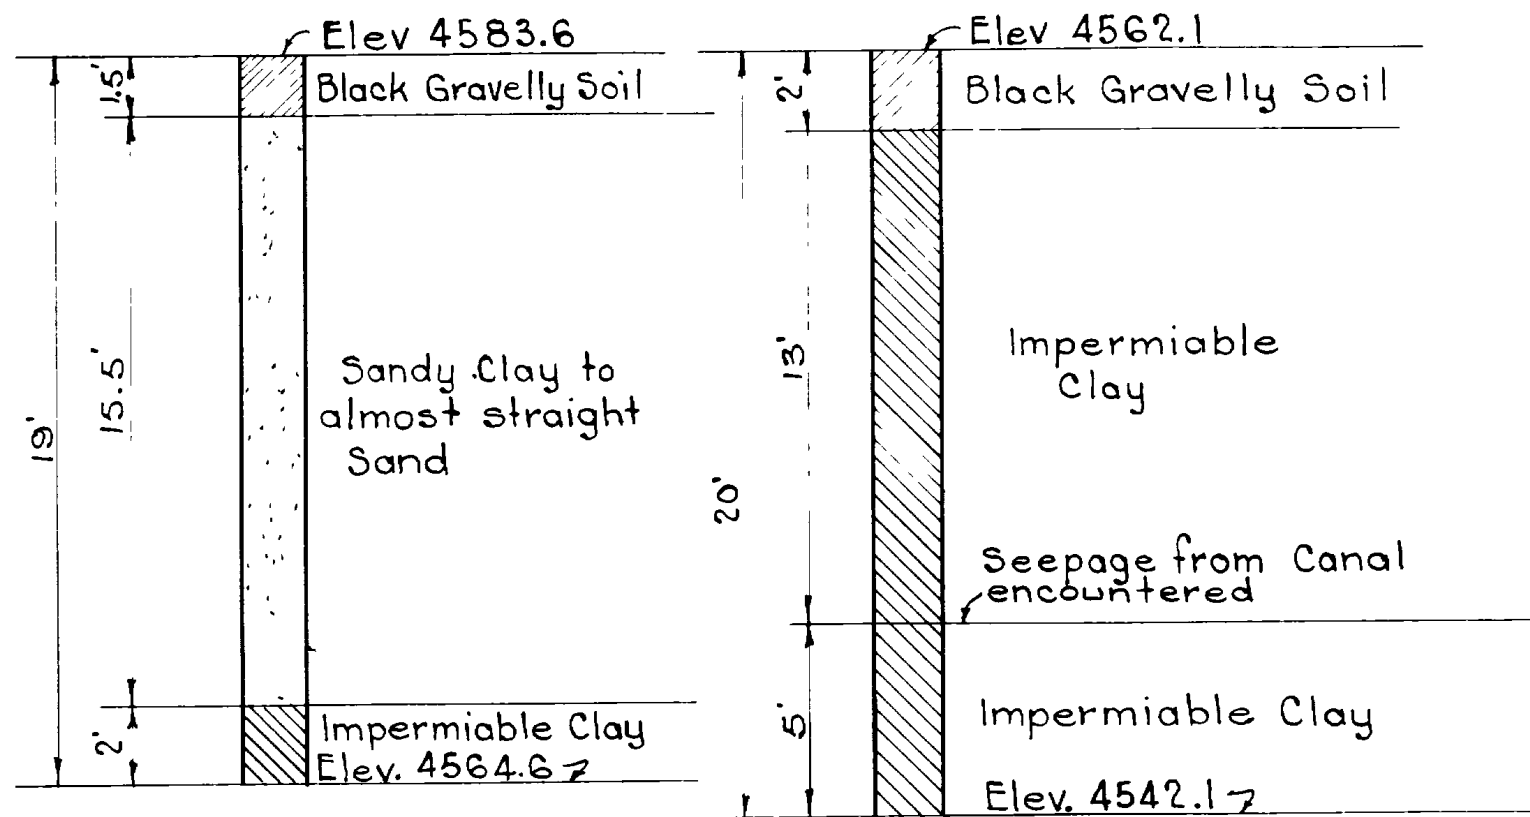


TEST HOLE No.1 TEST HOLE No.2

TEST HOLE DATA


GENERAL NOTES
 Materials, construction and workmanship shall be in accordance with State Standard Specifications, for Road and Bridge Construction, edition of 1939.
 Bearing Plates and Rollers to be set in place before pouring concrete.

DESIGN DATA
 A.A.S.H.O. Specifications of 1935, - H-15 Loading with impact, 3/4" wearing surface and 15" future wearing surface.
 Dead Load - Concrete 150# per Cu. Ft.
 Stresses:- f_c 900#/sq" f_s 16,000#/sq"
 for Structural Steel 18,000#/sq"

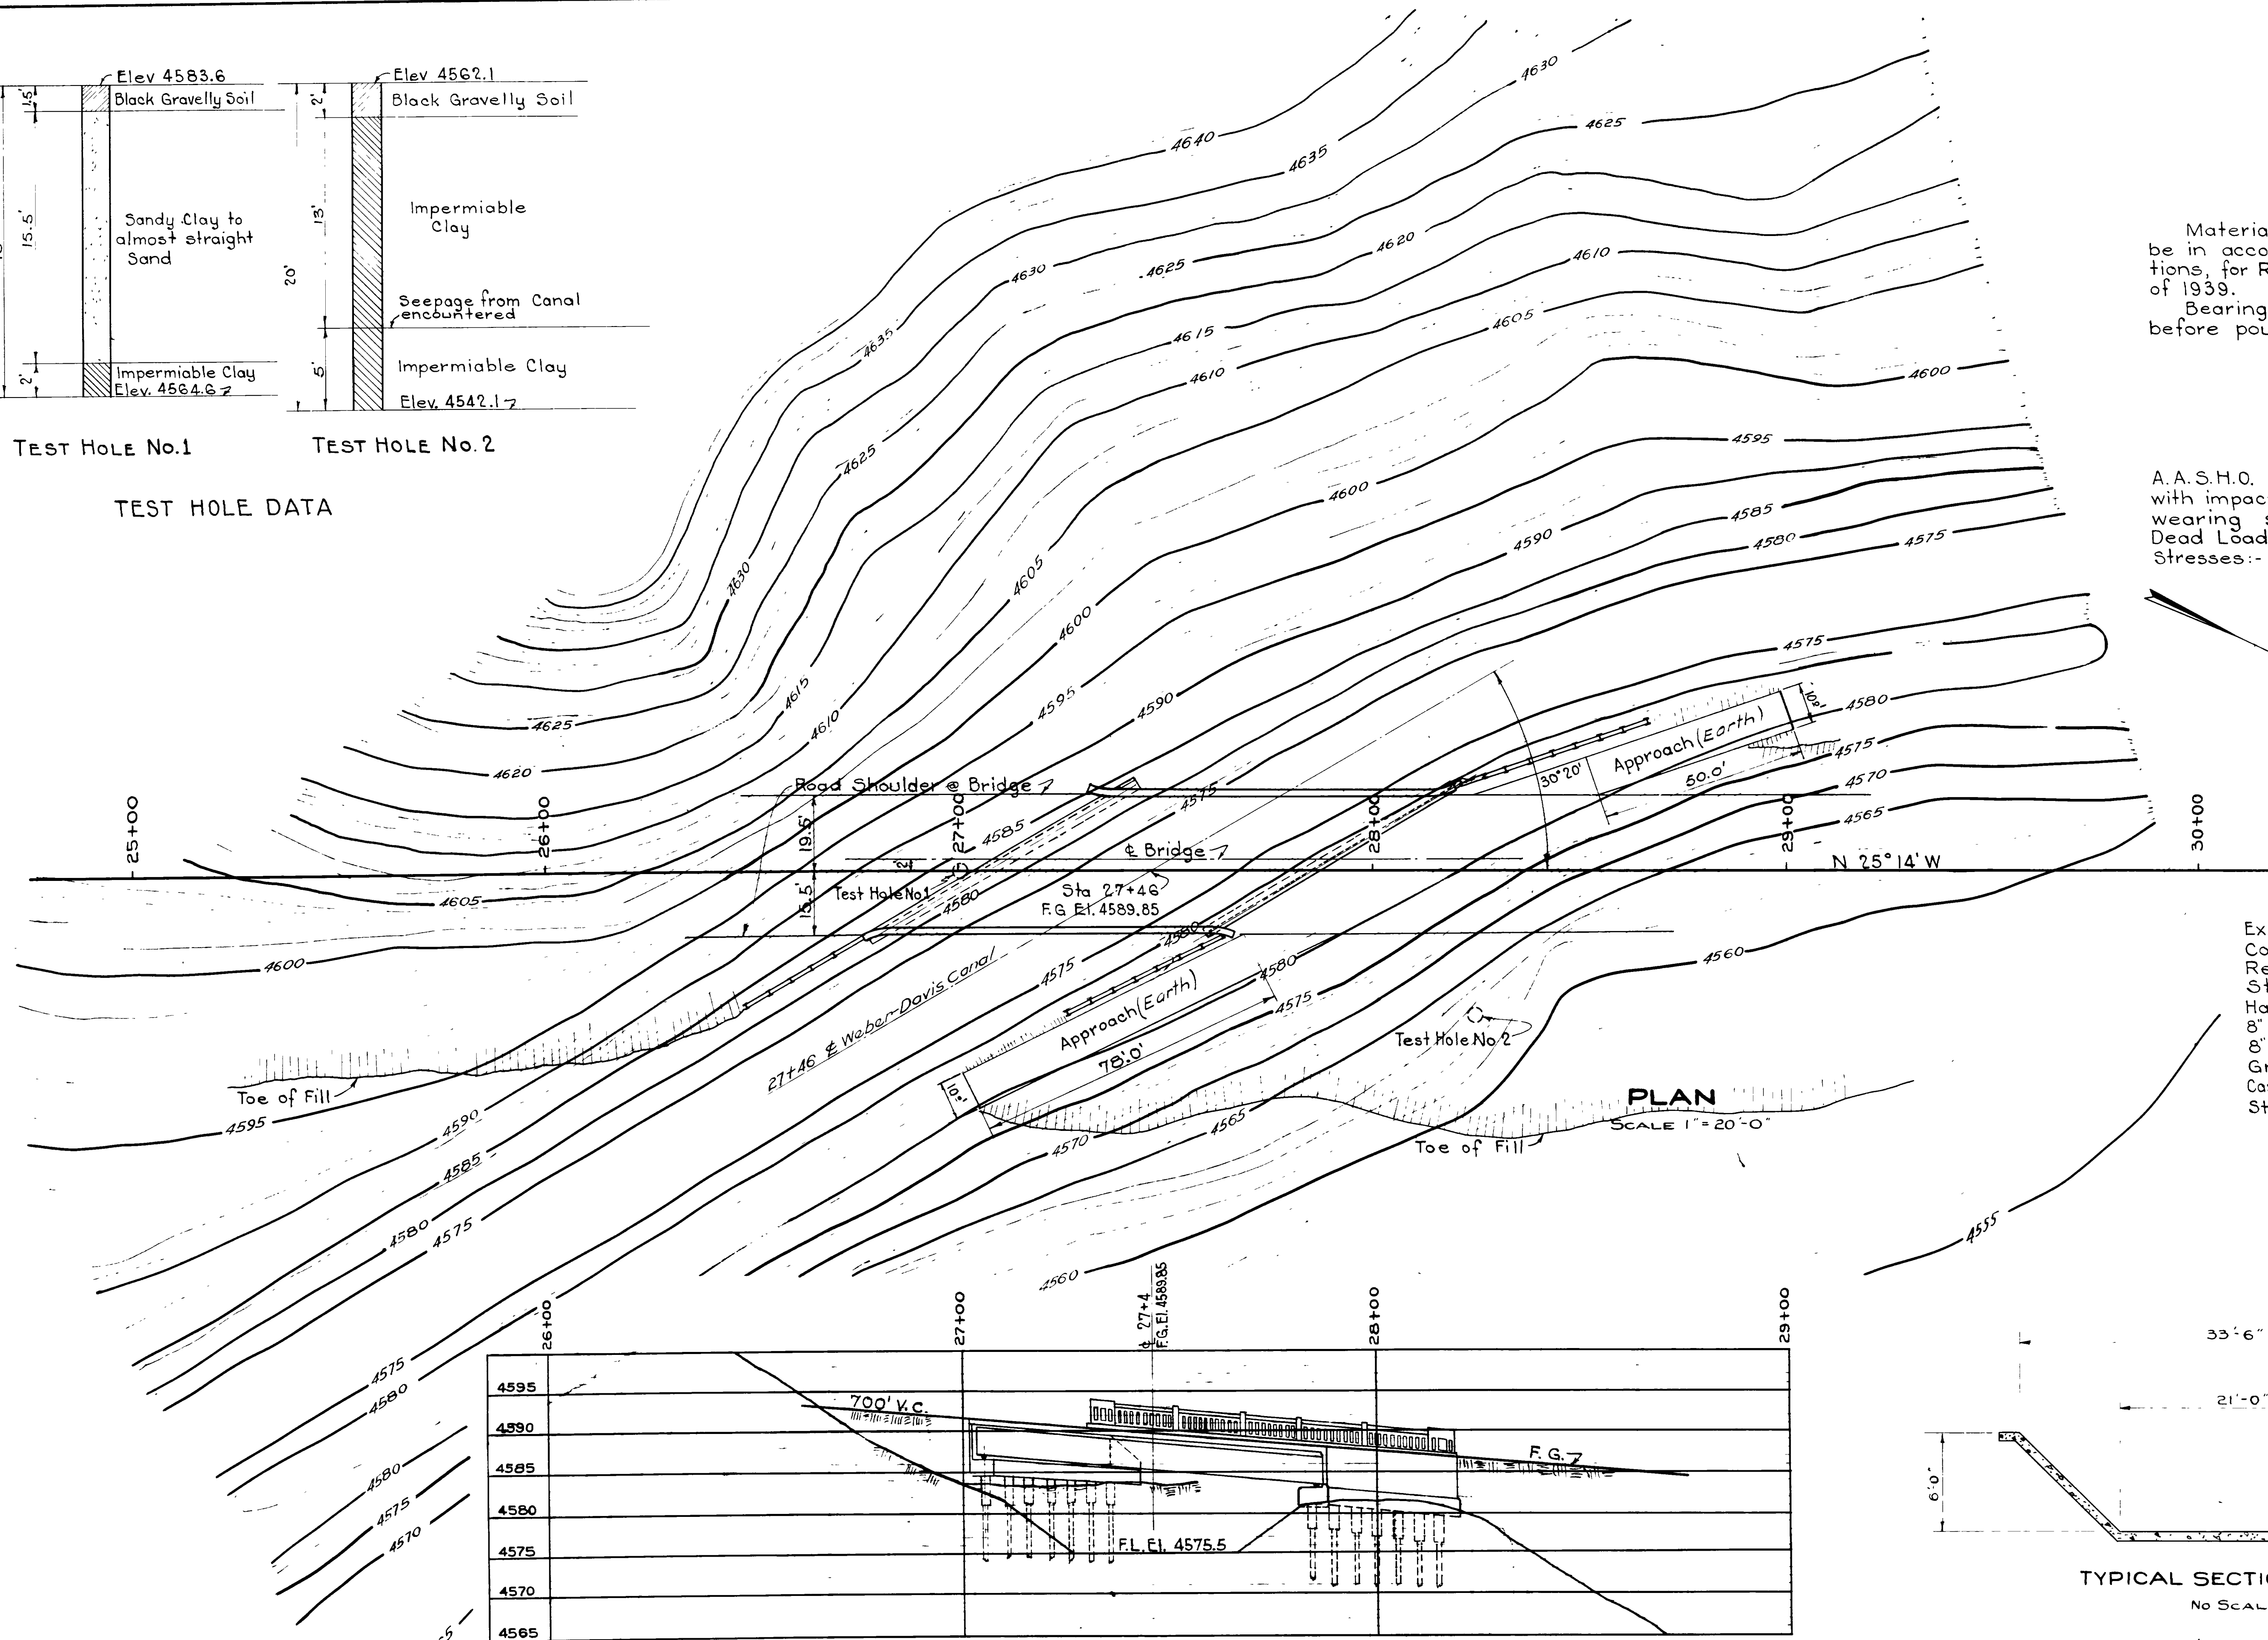


QUANTITIES

Excavation for Structures	35 Cu. Yd.
Concrete Class "A"	189 Cu. Yd.
Reinforcing Steel	38,103 Lbs.
Structural Steel	129,000 Lbs.
Handrail (Concrete)	181 Lin. Ft.
8" Perforated C.G.M. Pipe Underdrain	122 Lin. Ft.
8" C.G.M.P.	20 Lin. Ft.
Gravel Backfill	15 Cu. Yd.
Cast in place Concrete Piles 16" Butt	650 Lin. Ft.
Steel Piles (8"H @ 36#)	440 Lin. Ft.

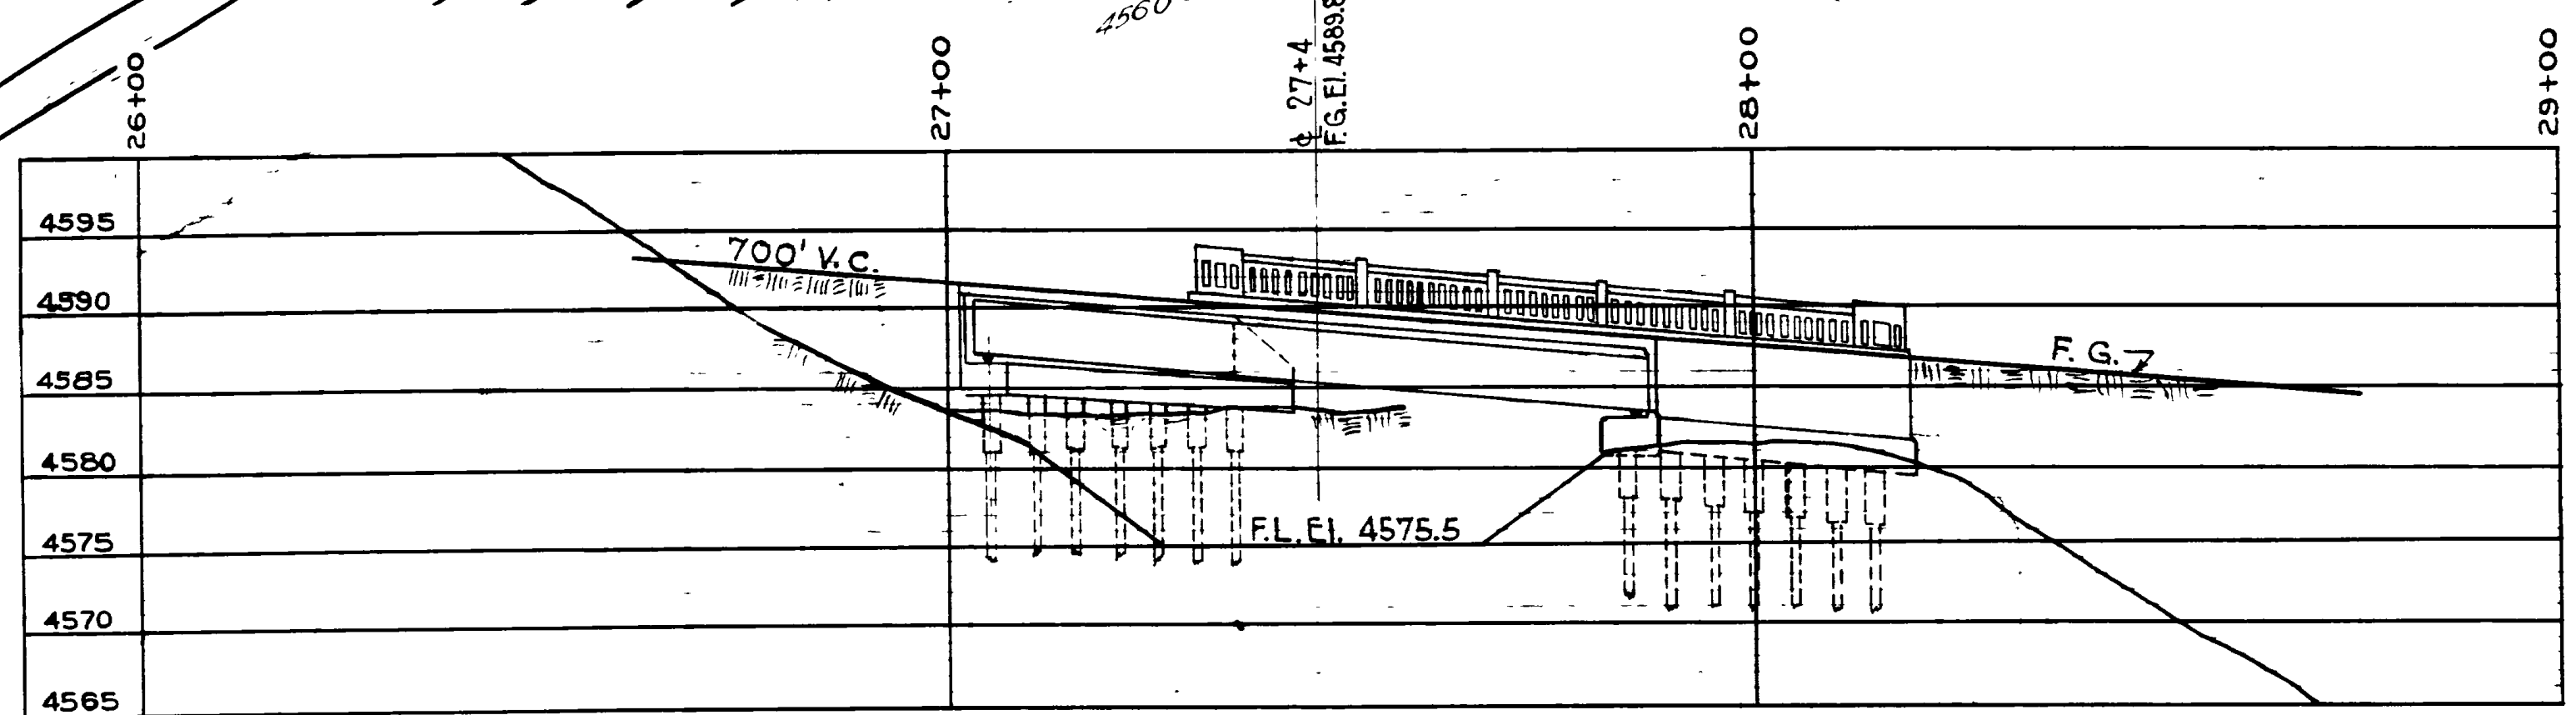


PROFILE
 HOR SCALE 1" = 20'-0"
 VER SCALE 1" = 10'-0"

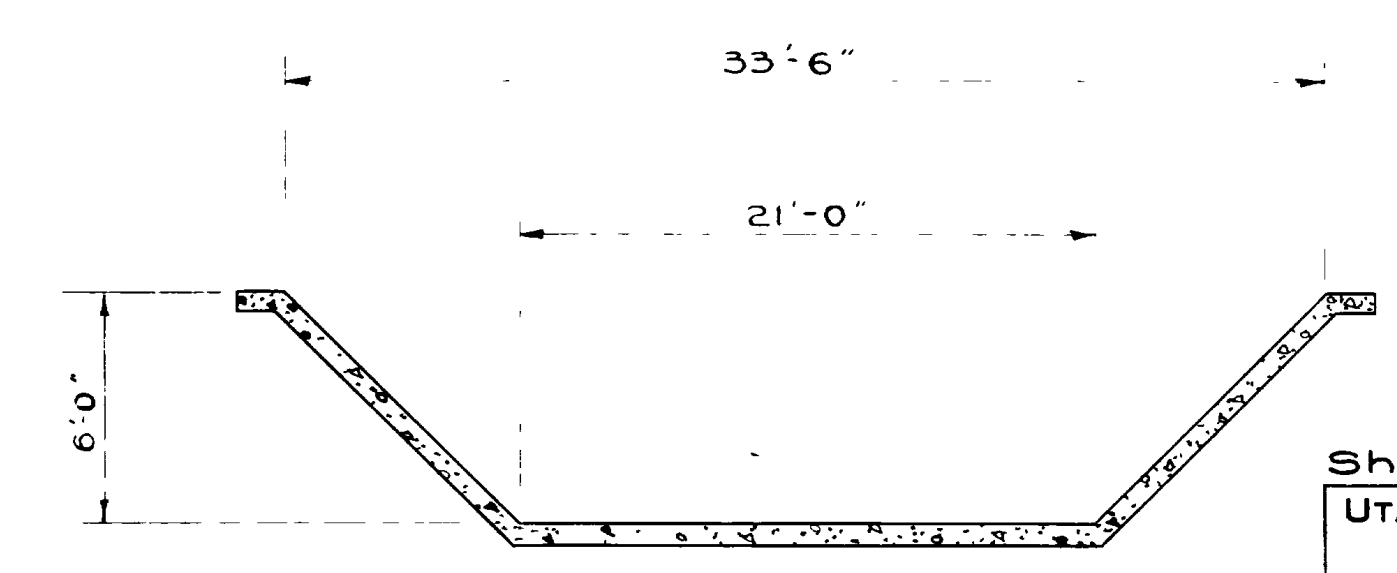


Sheet # 1 of 15 Sheets
 UTAH STATE ROAD COMMISSION
 SALT LAKE CITY - UTAH
 EZRA C. KNOWLTON, CHIEF ENGINEER
STEEL DECK GIRDER BRIDGE
 84'-6" x 0 to 0 149'-40" X-ING ANGLE
 WEBER DAVIS CANAL
 Sta. 27+46 A.W.F.A.P. 222 A(0)
 Riverdale Arsenal-Davis Co.
 DESIGNED BY: K.W.T. SCALE: AS NOTED
 DRAWN BY: K.W.T. ISSUED: 11/11/34
 CHECKED BY: APPROVED: [Signature]
 PROVIDED BY:
 SR No. 6-253-1-1 DRG No. C-215

FED. ROAD DIST. NO.	STATE	AW/F.A. PROJ. NO.	FISCAL YEAR	SHEET NO.	TOTAL SHEETS
12	UTAH	222-A(1)			

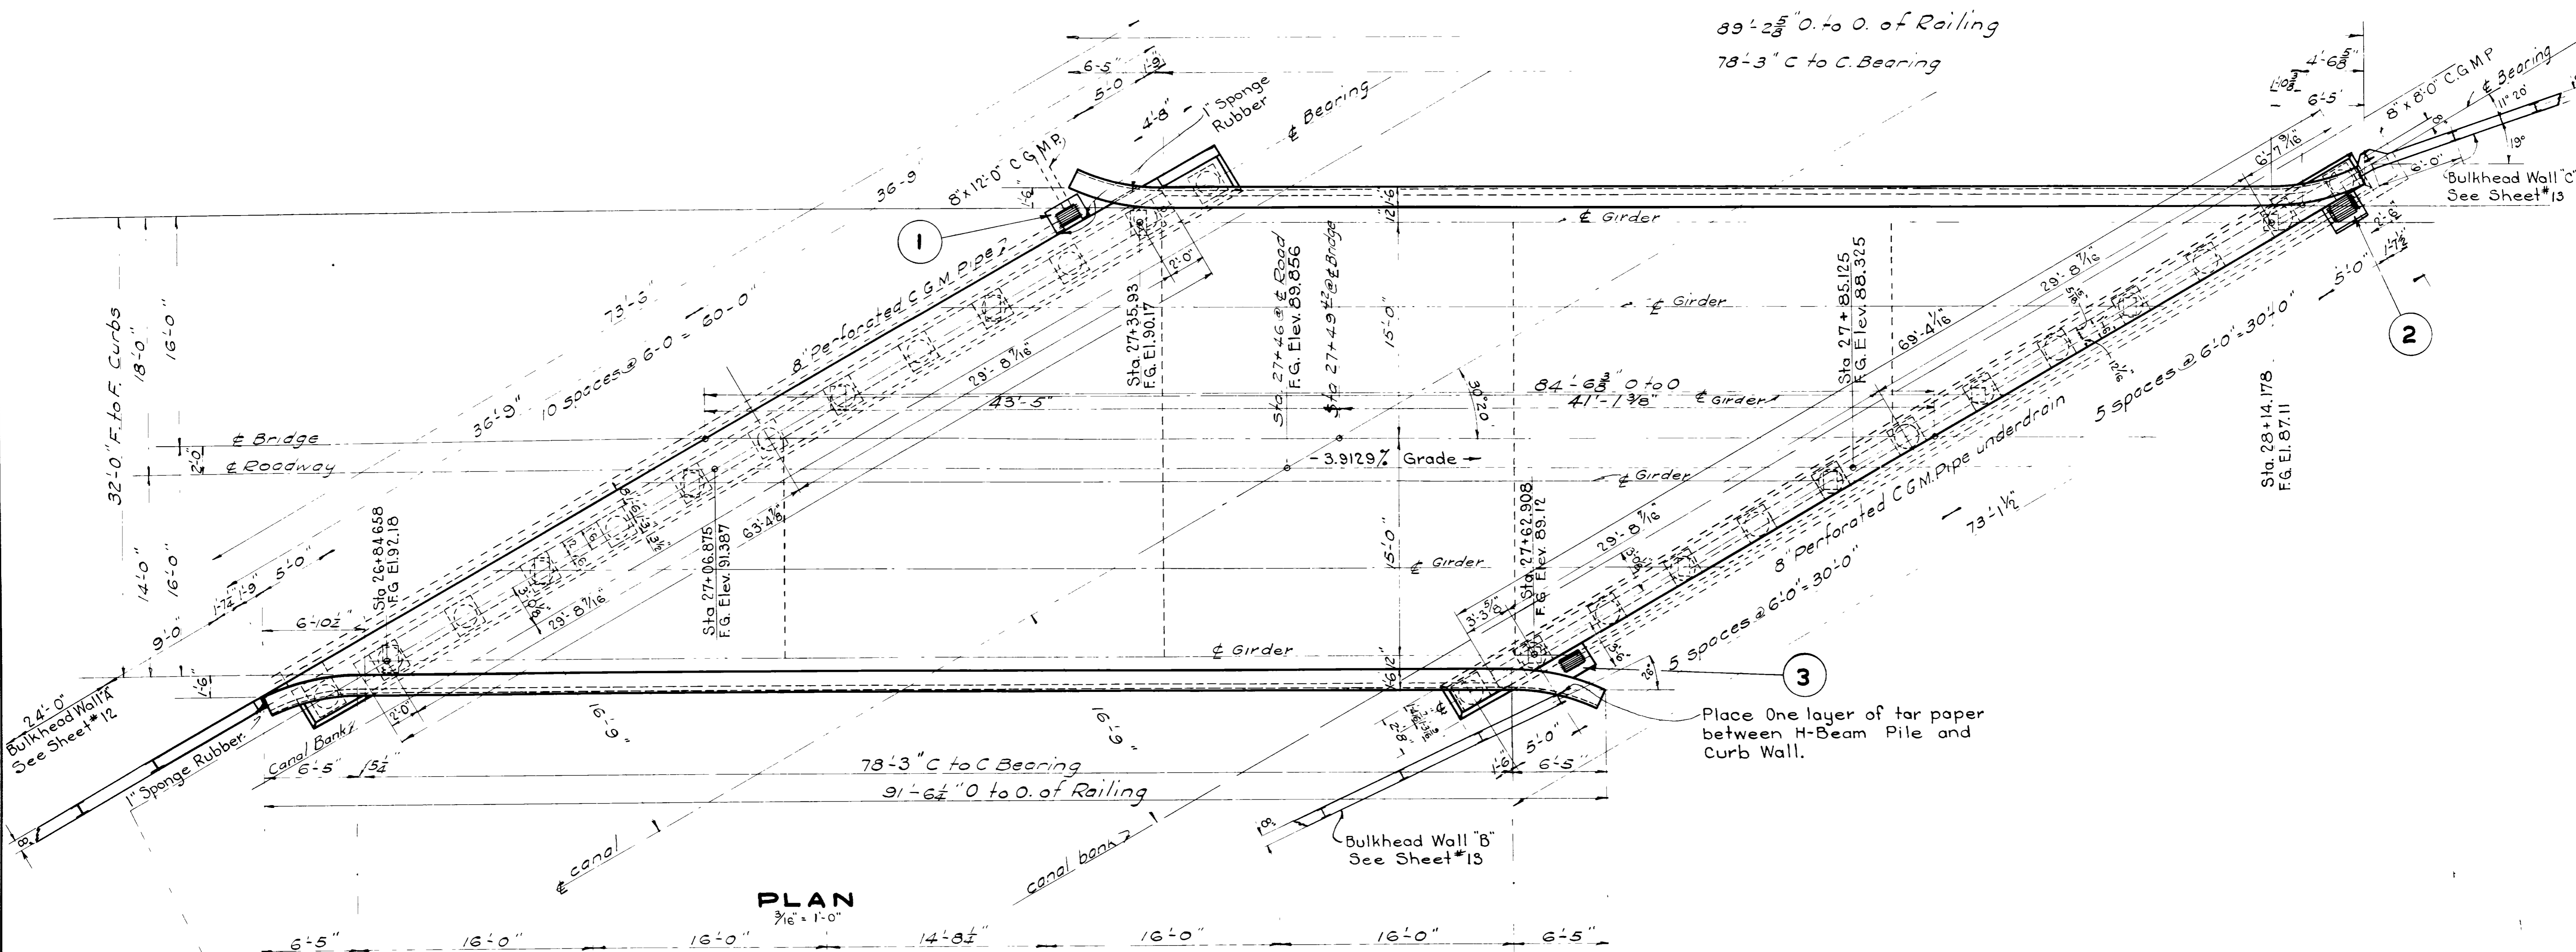

PLAN
3/16" = 1'-0"

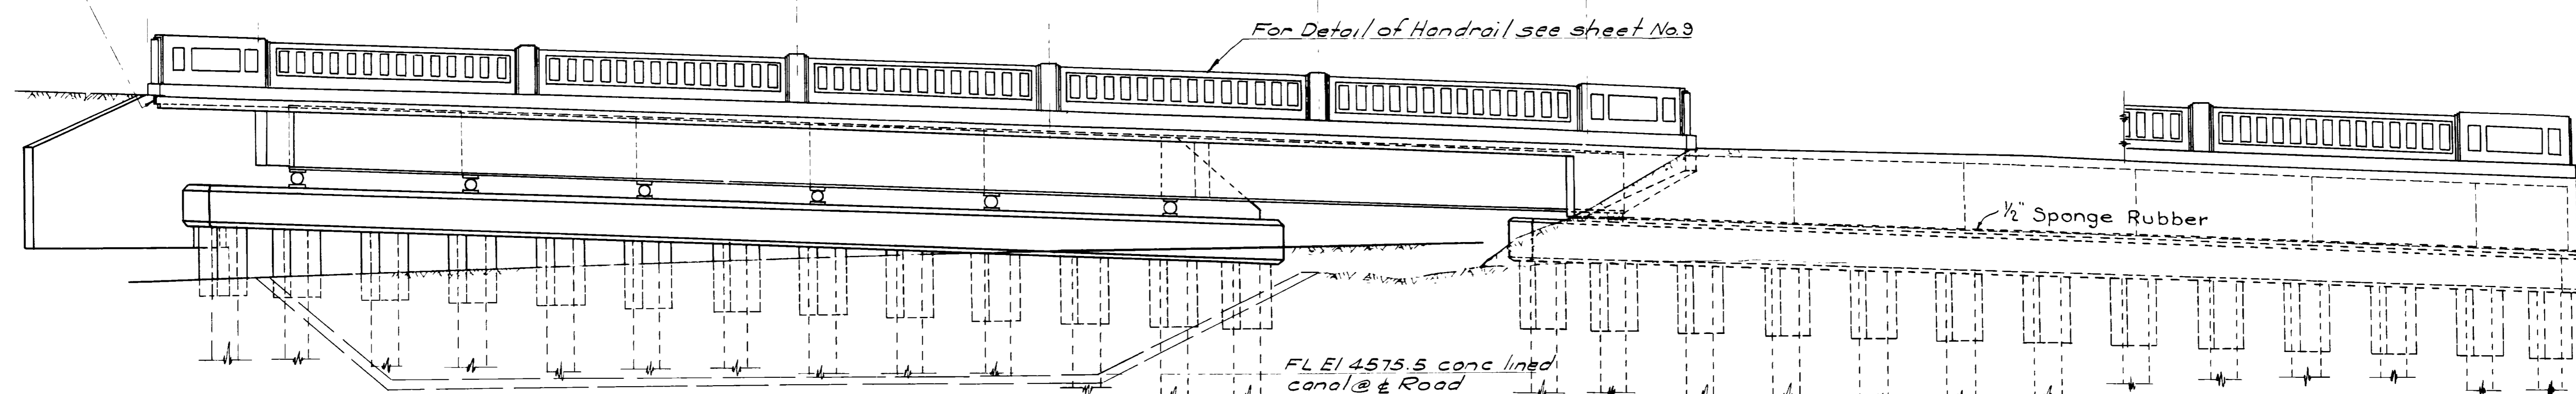

ELEVATION

Abutment Piles shall be Class "A" concrete cast in place, in Metal Shells. Shells to be of 7 Gage Metal with 16" Butt and 8" Tip, and for estimating purposes to be 25'-0" Long. 26 Reqd.

Bulkhead Piles to be 8" H-Pile @ 36" x 20'-0" (min) and are to be Hammer driven. 22 Required.


Sheet #2 of 15 Sheets
 UTAH STATE ROAD COMMISSION
 SALT LAKE CITY, UTAH
 EZRA C. KNOWLTON, CHIEF ENGINEER

STEEL DECK GIRDER BRIDGE
 84'-6 3/8" O to O - 149'-40" X-ING ANGLE
 WEBER-DAVIS CANAL
 Sta. 27+46 AWFAP 222 A(1)
 Riverdale Arsenal Davis Co.


DESIGNED BY: K.W.T. SCALE: 3/16" = 1'-0"
 DRAWN BY: D.M.S. CHECKED BY: [Signature] APPROVED BY: [Signature]
 EXAM. BY: [Signature]

No. G-259-1-1 DRS. NO. C-215

FED. ROAD DIST. NO.	STATE	AW. F.A. PROJ. NO.	FISCAL YEAR	SHEET NO.	TOTAL SHEETS
12	UTAH	222A(1)			

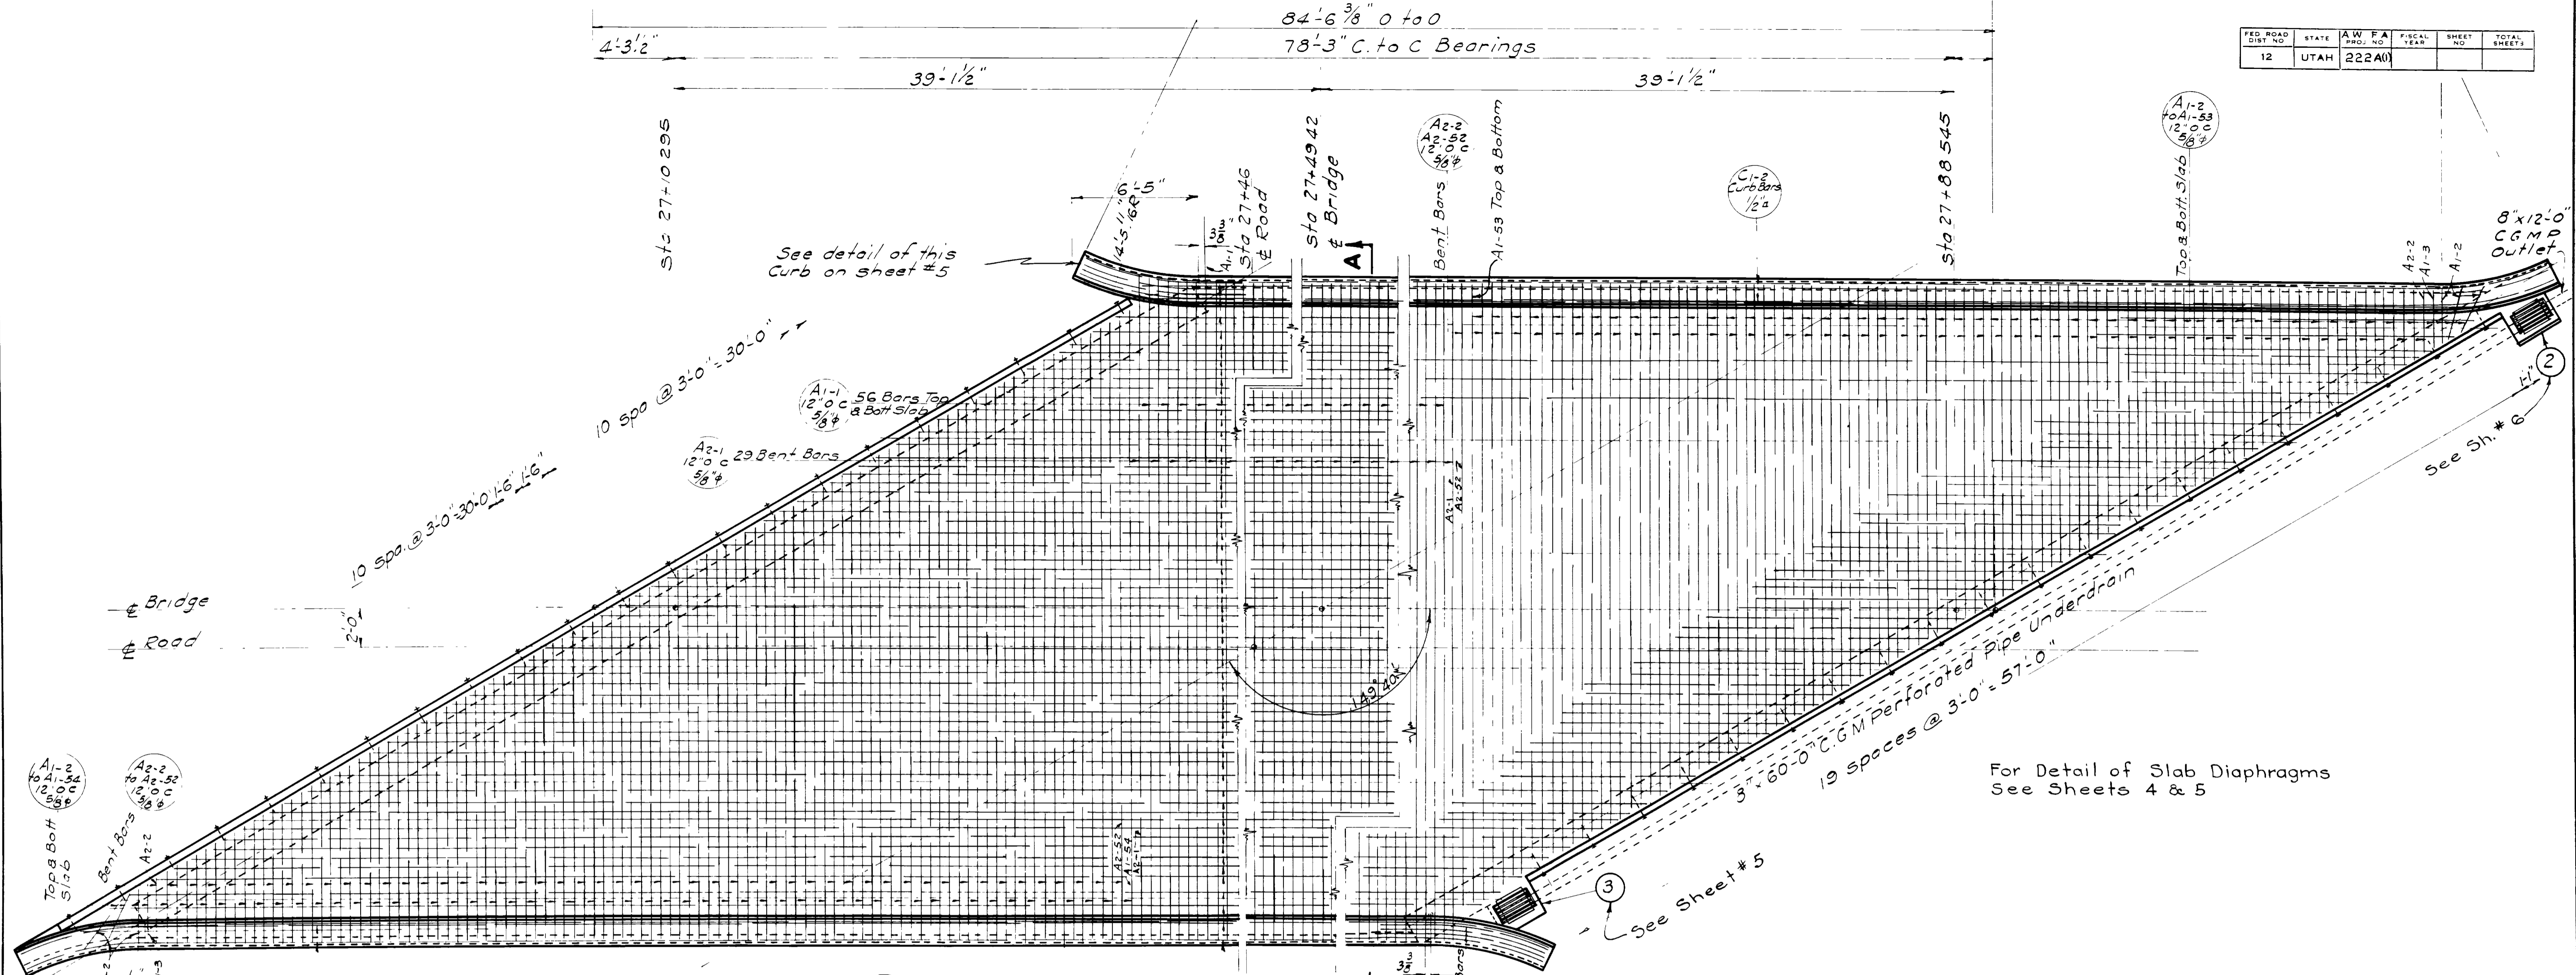

PLAN
1/4" = 1'-0"

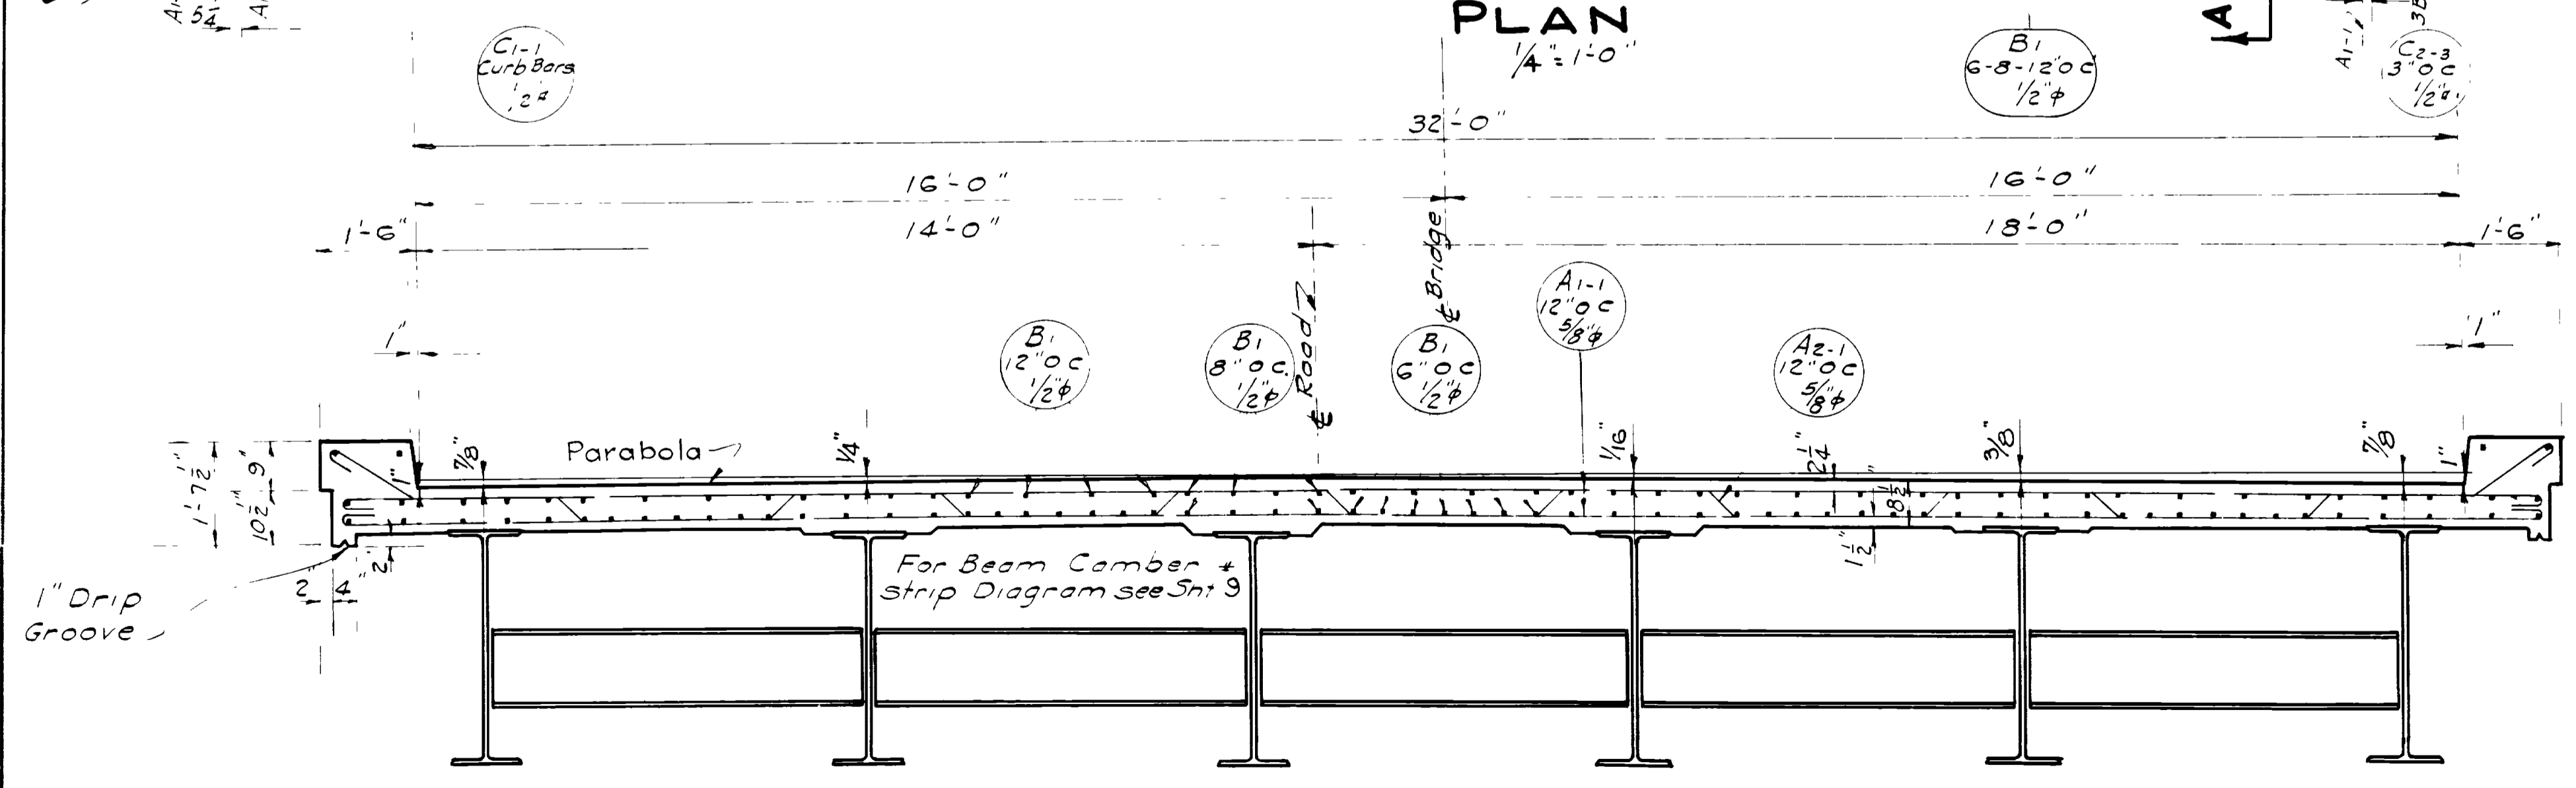

SECTION A-A
1/2" = 1'-0"

For Detail of Slab Diaphragms
See Sheets 4 & 5

See Sheet # 5

See Sh. # 6

See detail of this
Curb on sheet #5

Sheet # 3 of 15 Sheets

UTAH STATE ROAD COMMISSION
SALT LAKE CITY, UTAH
EZRA C. KNOWLTON, CHIEF ENGINEER


STEEL DECK GIRDER BRIDGE
84'-6 3/8" O. to 0. 149° 40' XING ANGLE
WEBER-DAVIS CANAL
Sta. 27+46 A.W. F.A.P. 222A(1)
Riverdale-Arsenal Davis Co.

DESIGNED BY: K.W.T. AS SHOWN
CHECKED BY: D.M.S. DATE: July 24, 1961
EXAMINE BY: Paul M. Masten

BB No. 6-259-1-1 | Des No. C-215

FED. ROAD DIST. NO.	STATE	A.W.F.A. DIST. NO.	FISCAL YEAR	SHEET NO.	TOTAL SHEETS
12	UTAH	222A(1)			

NOTE:
For Sections thru Diaphragms
See Sheet No 5





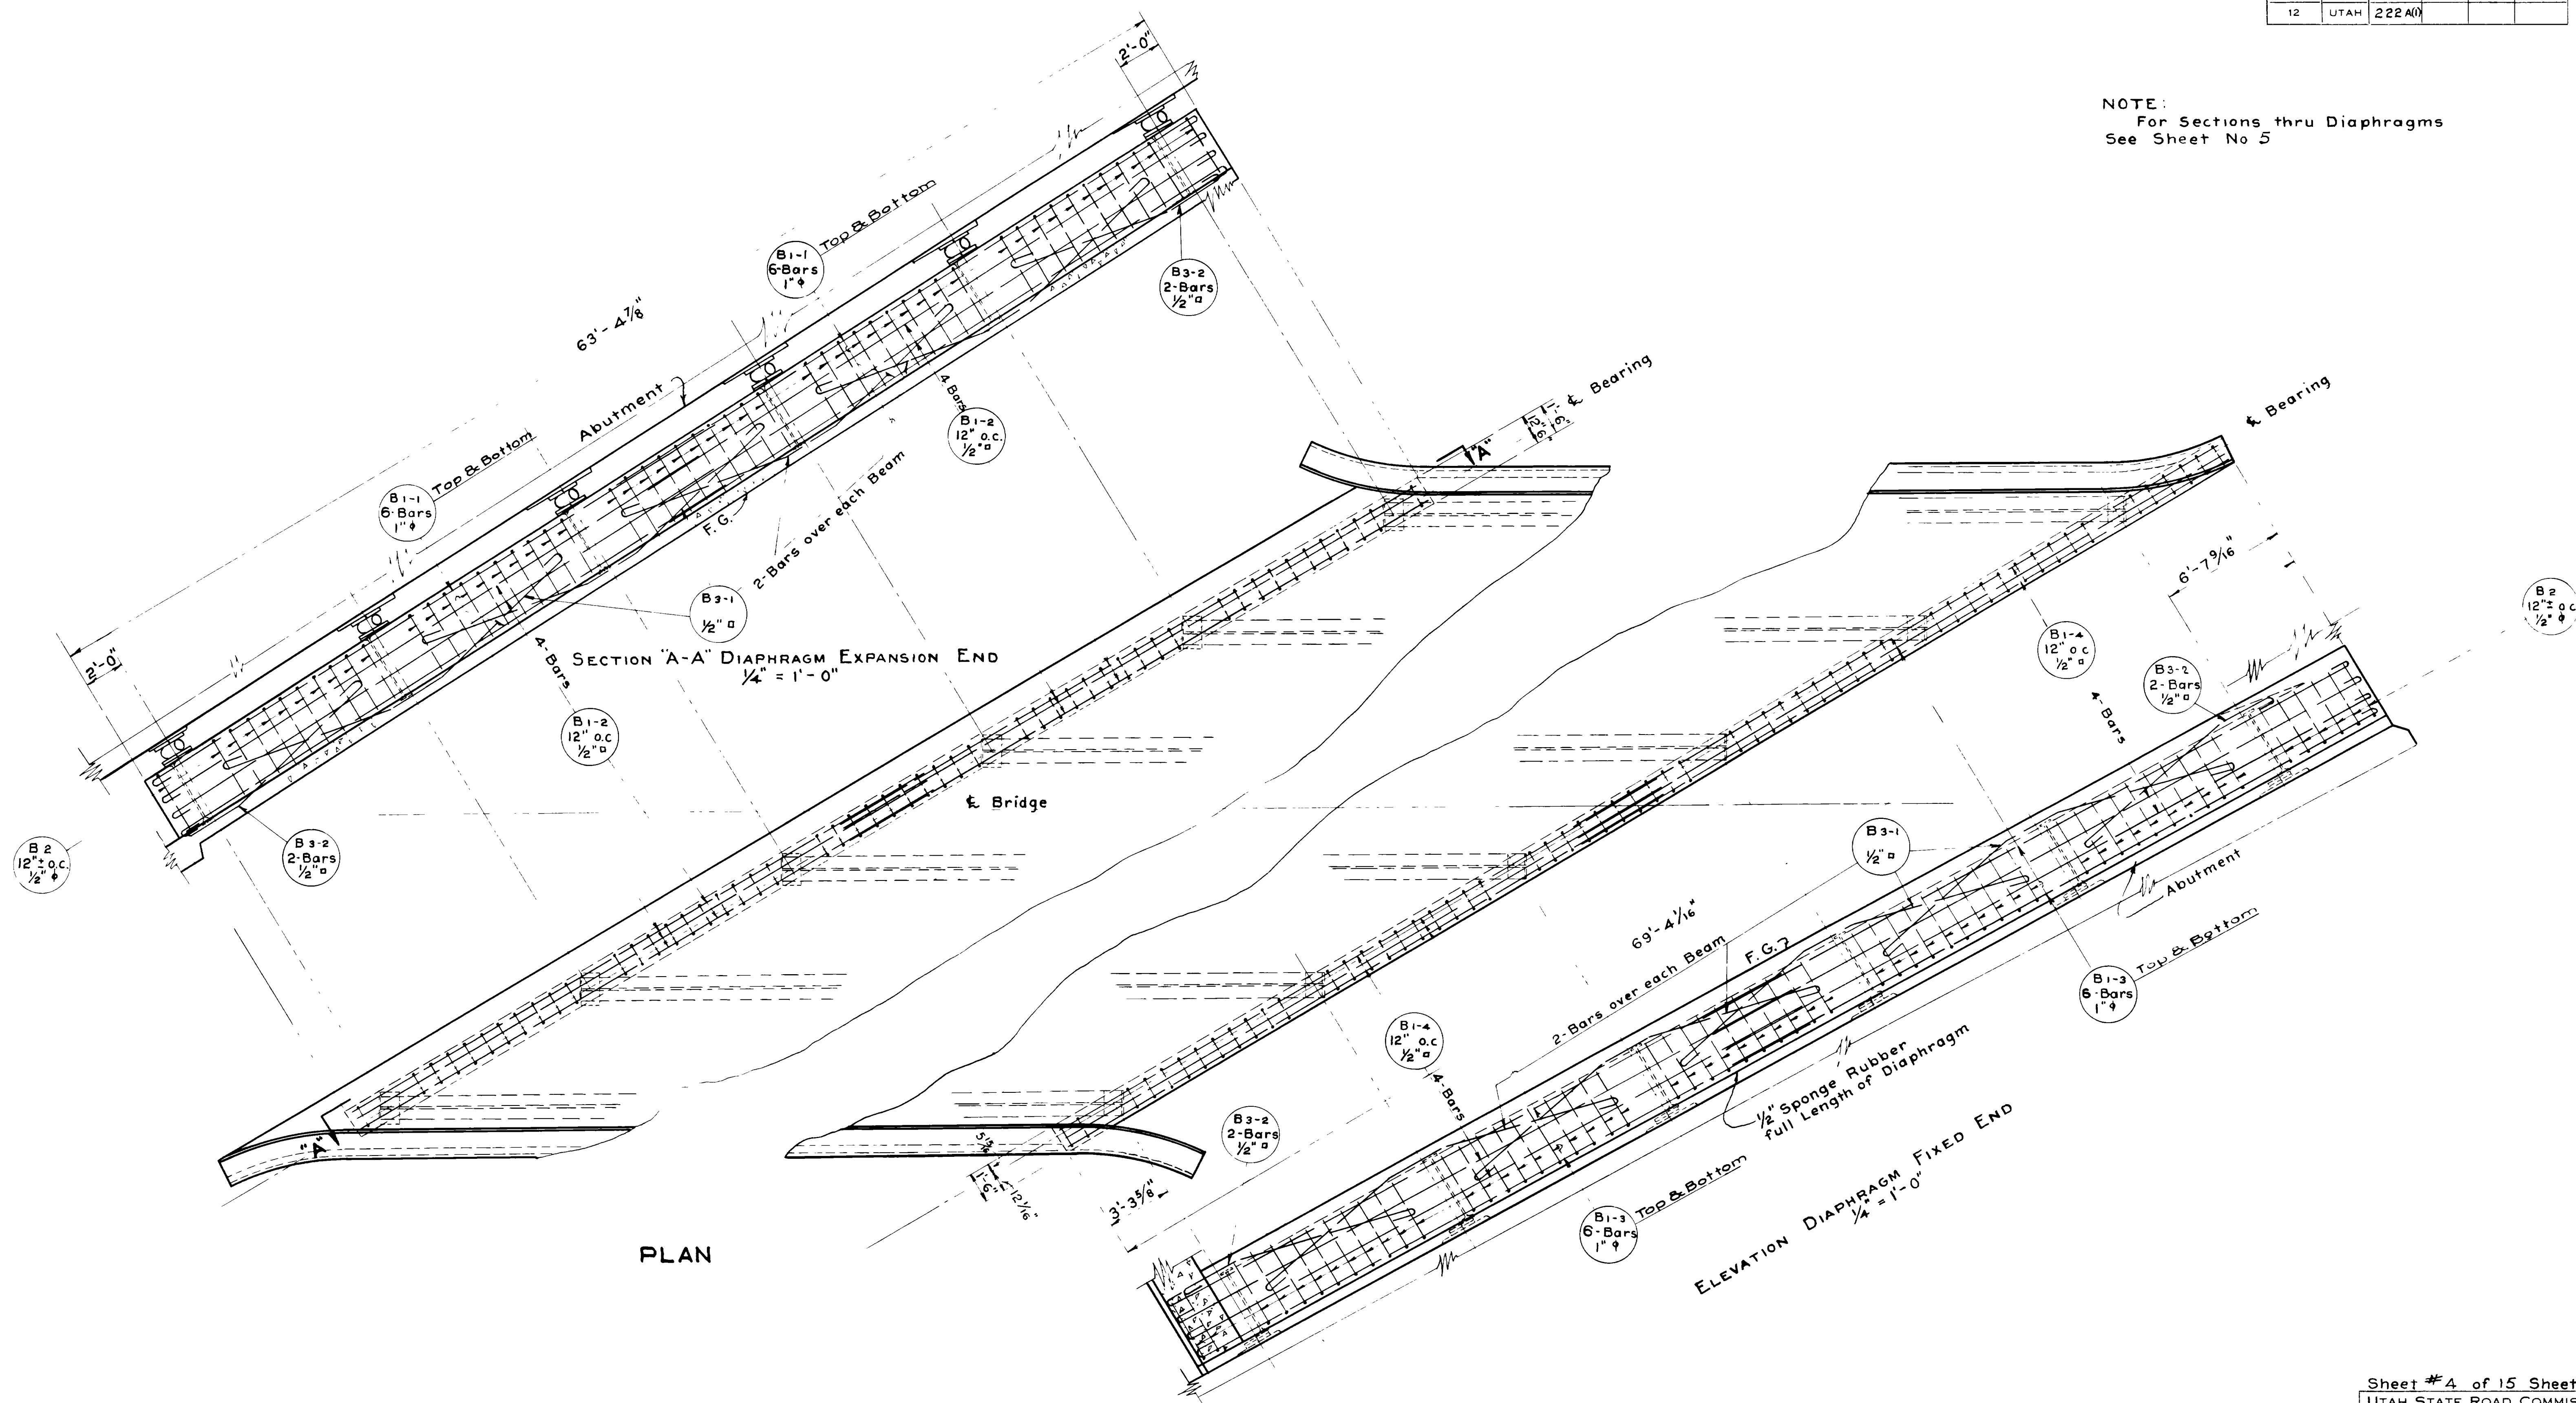


PLAN

ELEVATION DIAPHRAGM FIXED END
1/4" = 1'-0"


REVISIONS	DATE	BY	CHKD

Sheet #4 of 15 Sheets
 UTAH STATE ROAD COMMISSION
 SALT LAKE CITY, UTAH
 EZRA C. KNOWLTON, CHIEF ENGINEER
STEEL DECK GIRDER BRIDGE
 84'-6 3/8" O to O, 149° 40' XING ANGLE
 WEBER-DAVIS CANAL
 Sta. 27+46 A.W.F.A.P. 222 A(1)
 Riverdale Arsenal, Davis Co.
 K.W.T. 1/4" = 1'-0"
 D.M.S. ISSUED July 24, 1941
 DESIGNED BY Paul M. ...
 BR. 6-259-1-1 DES. NO. C-215

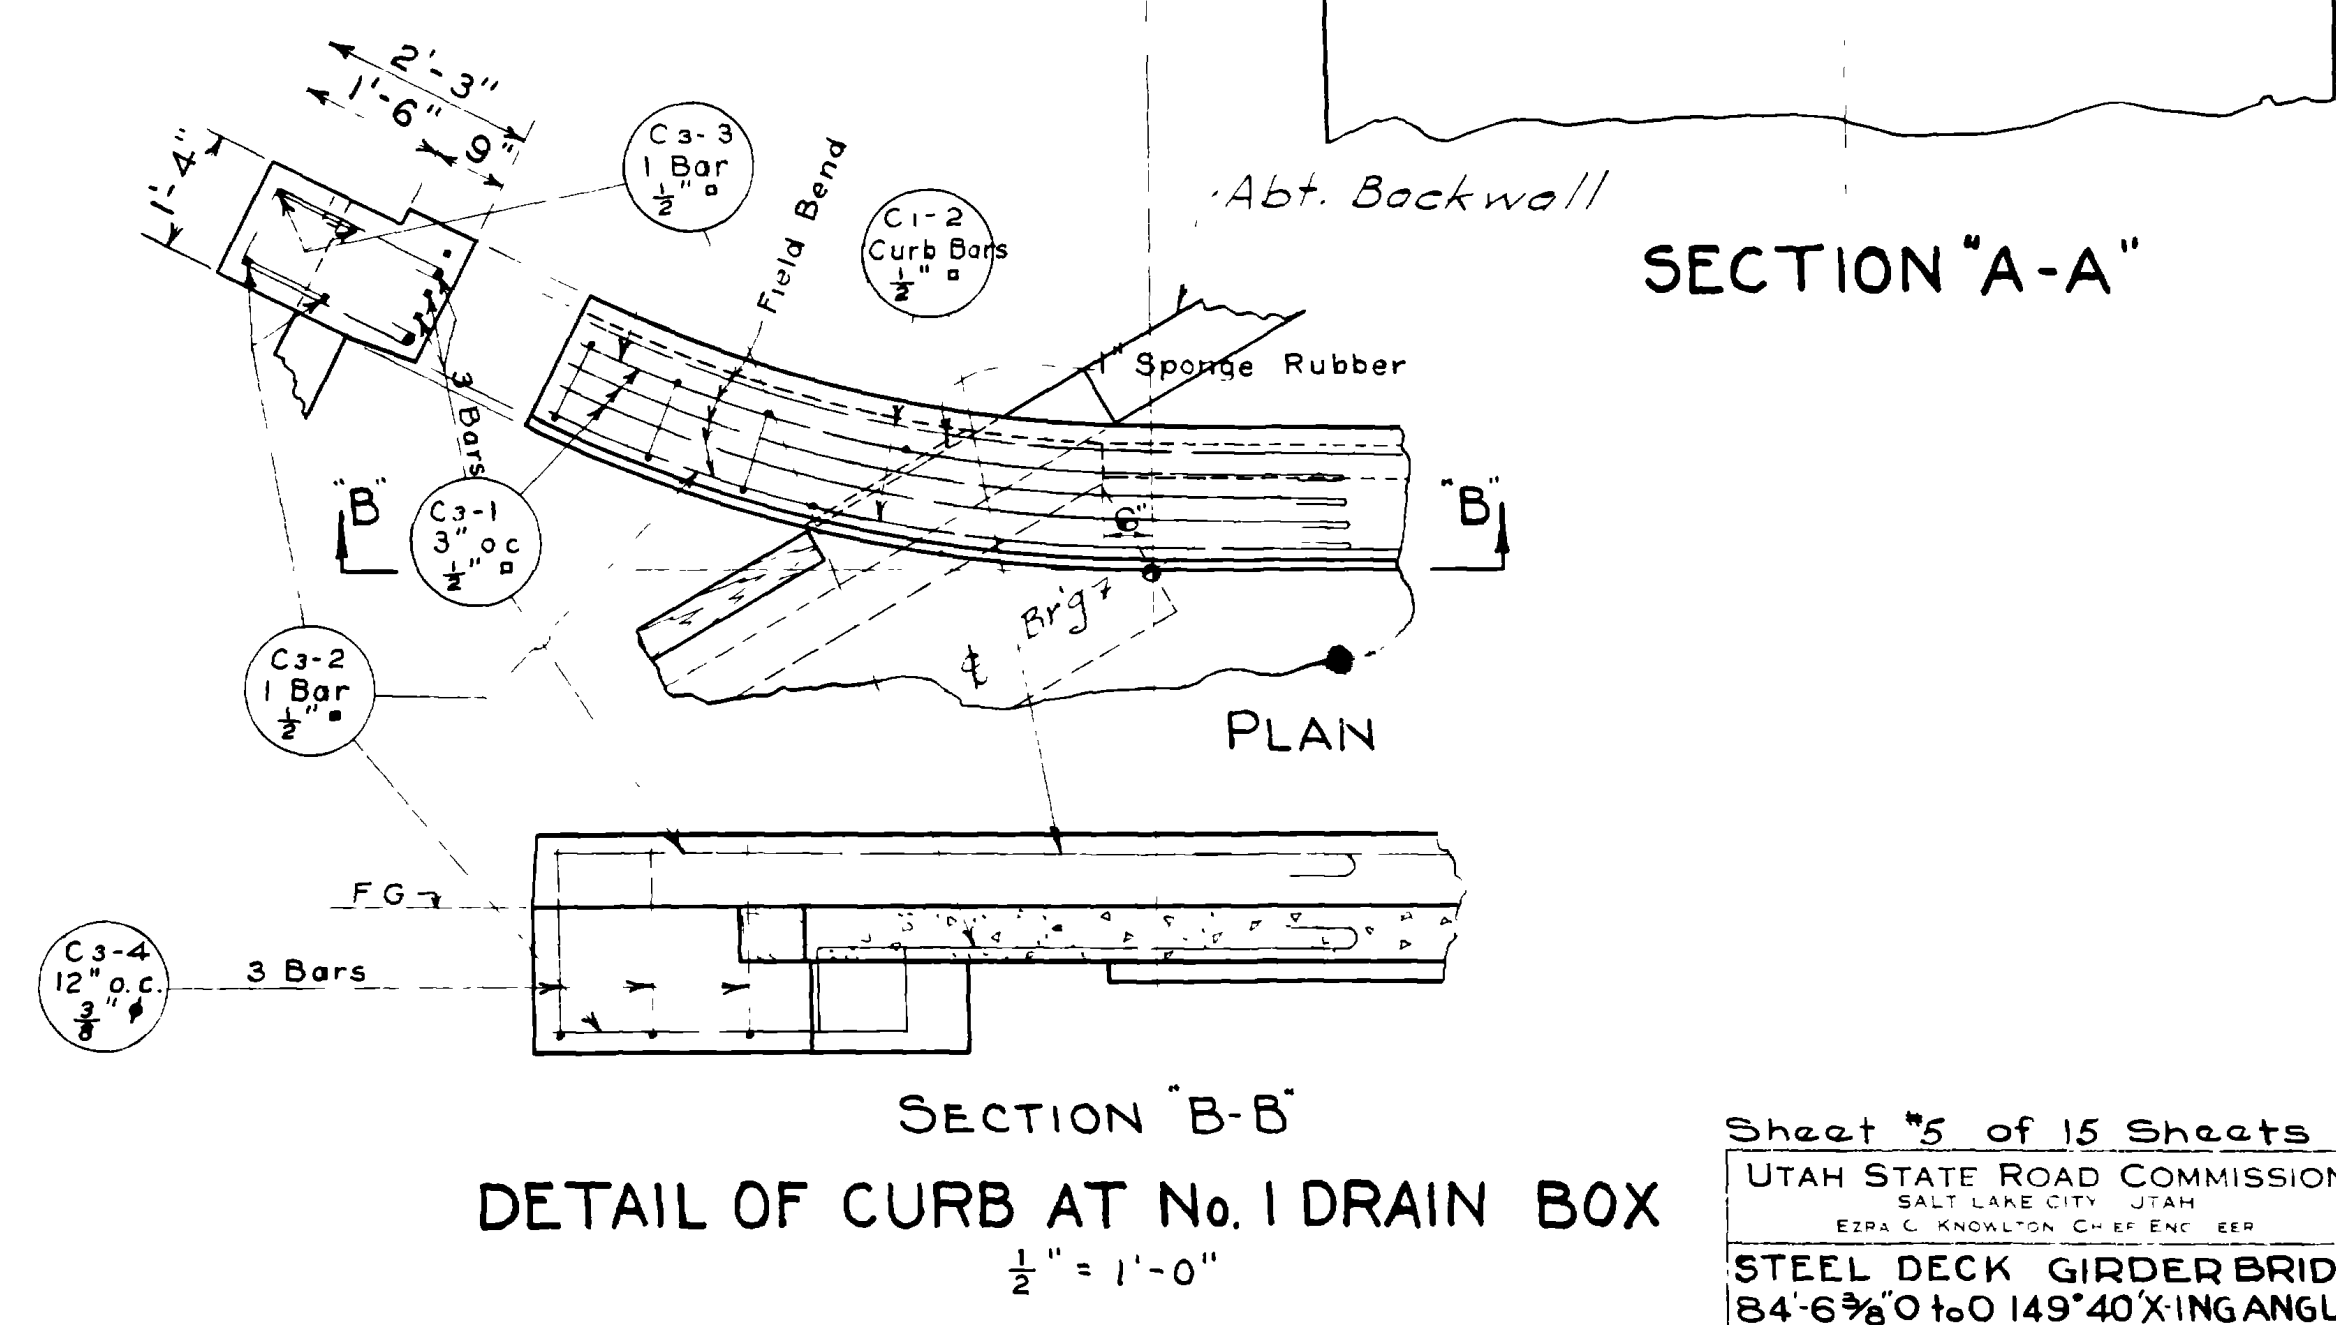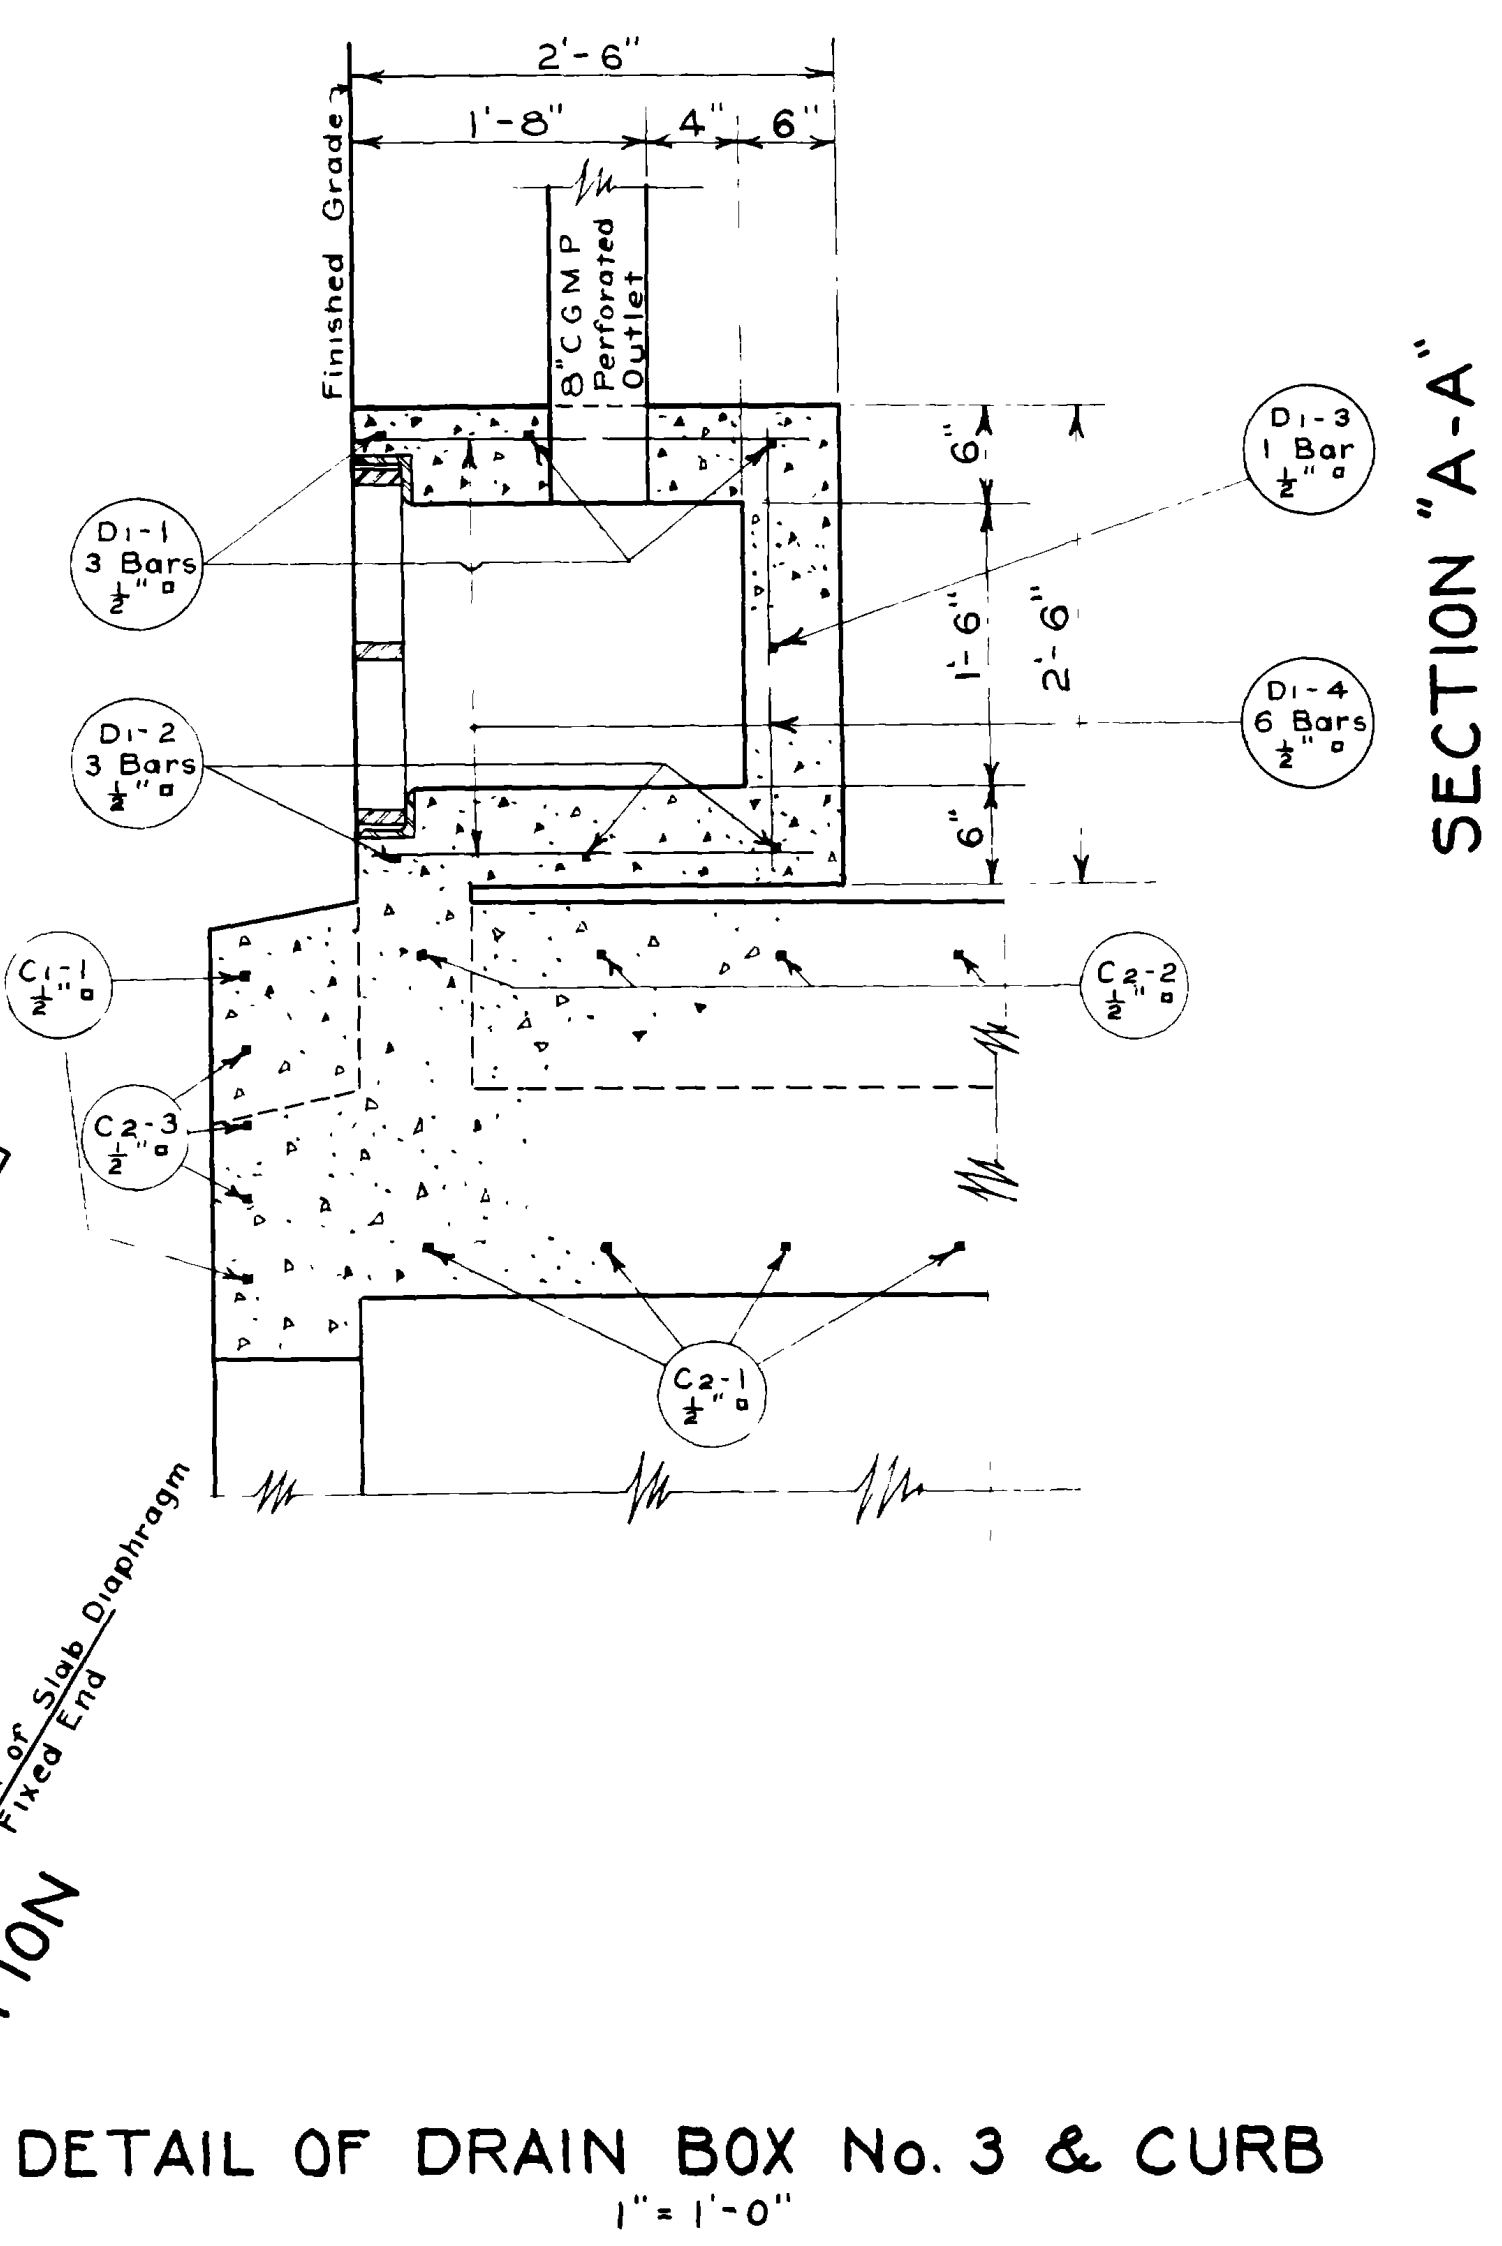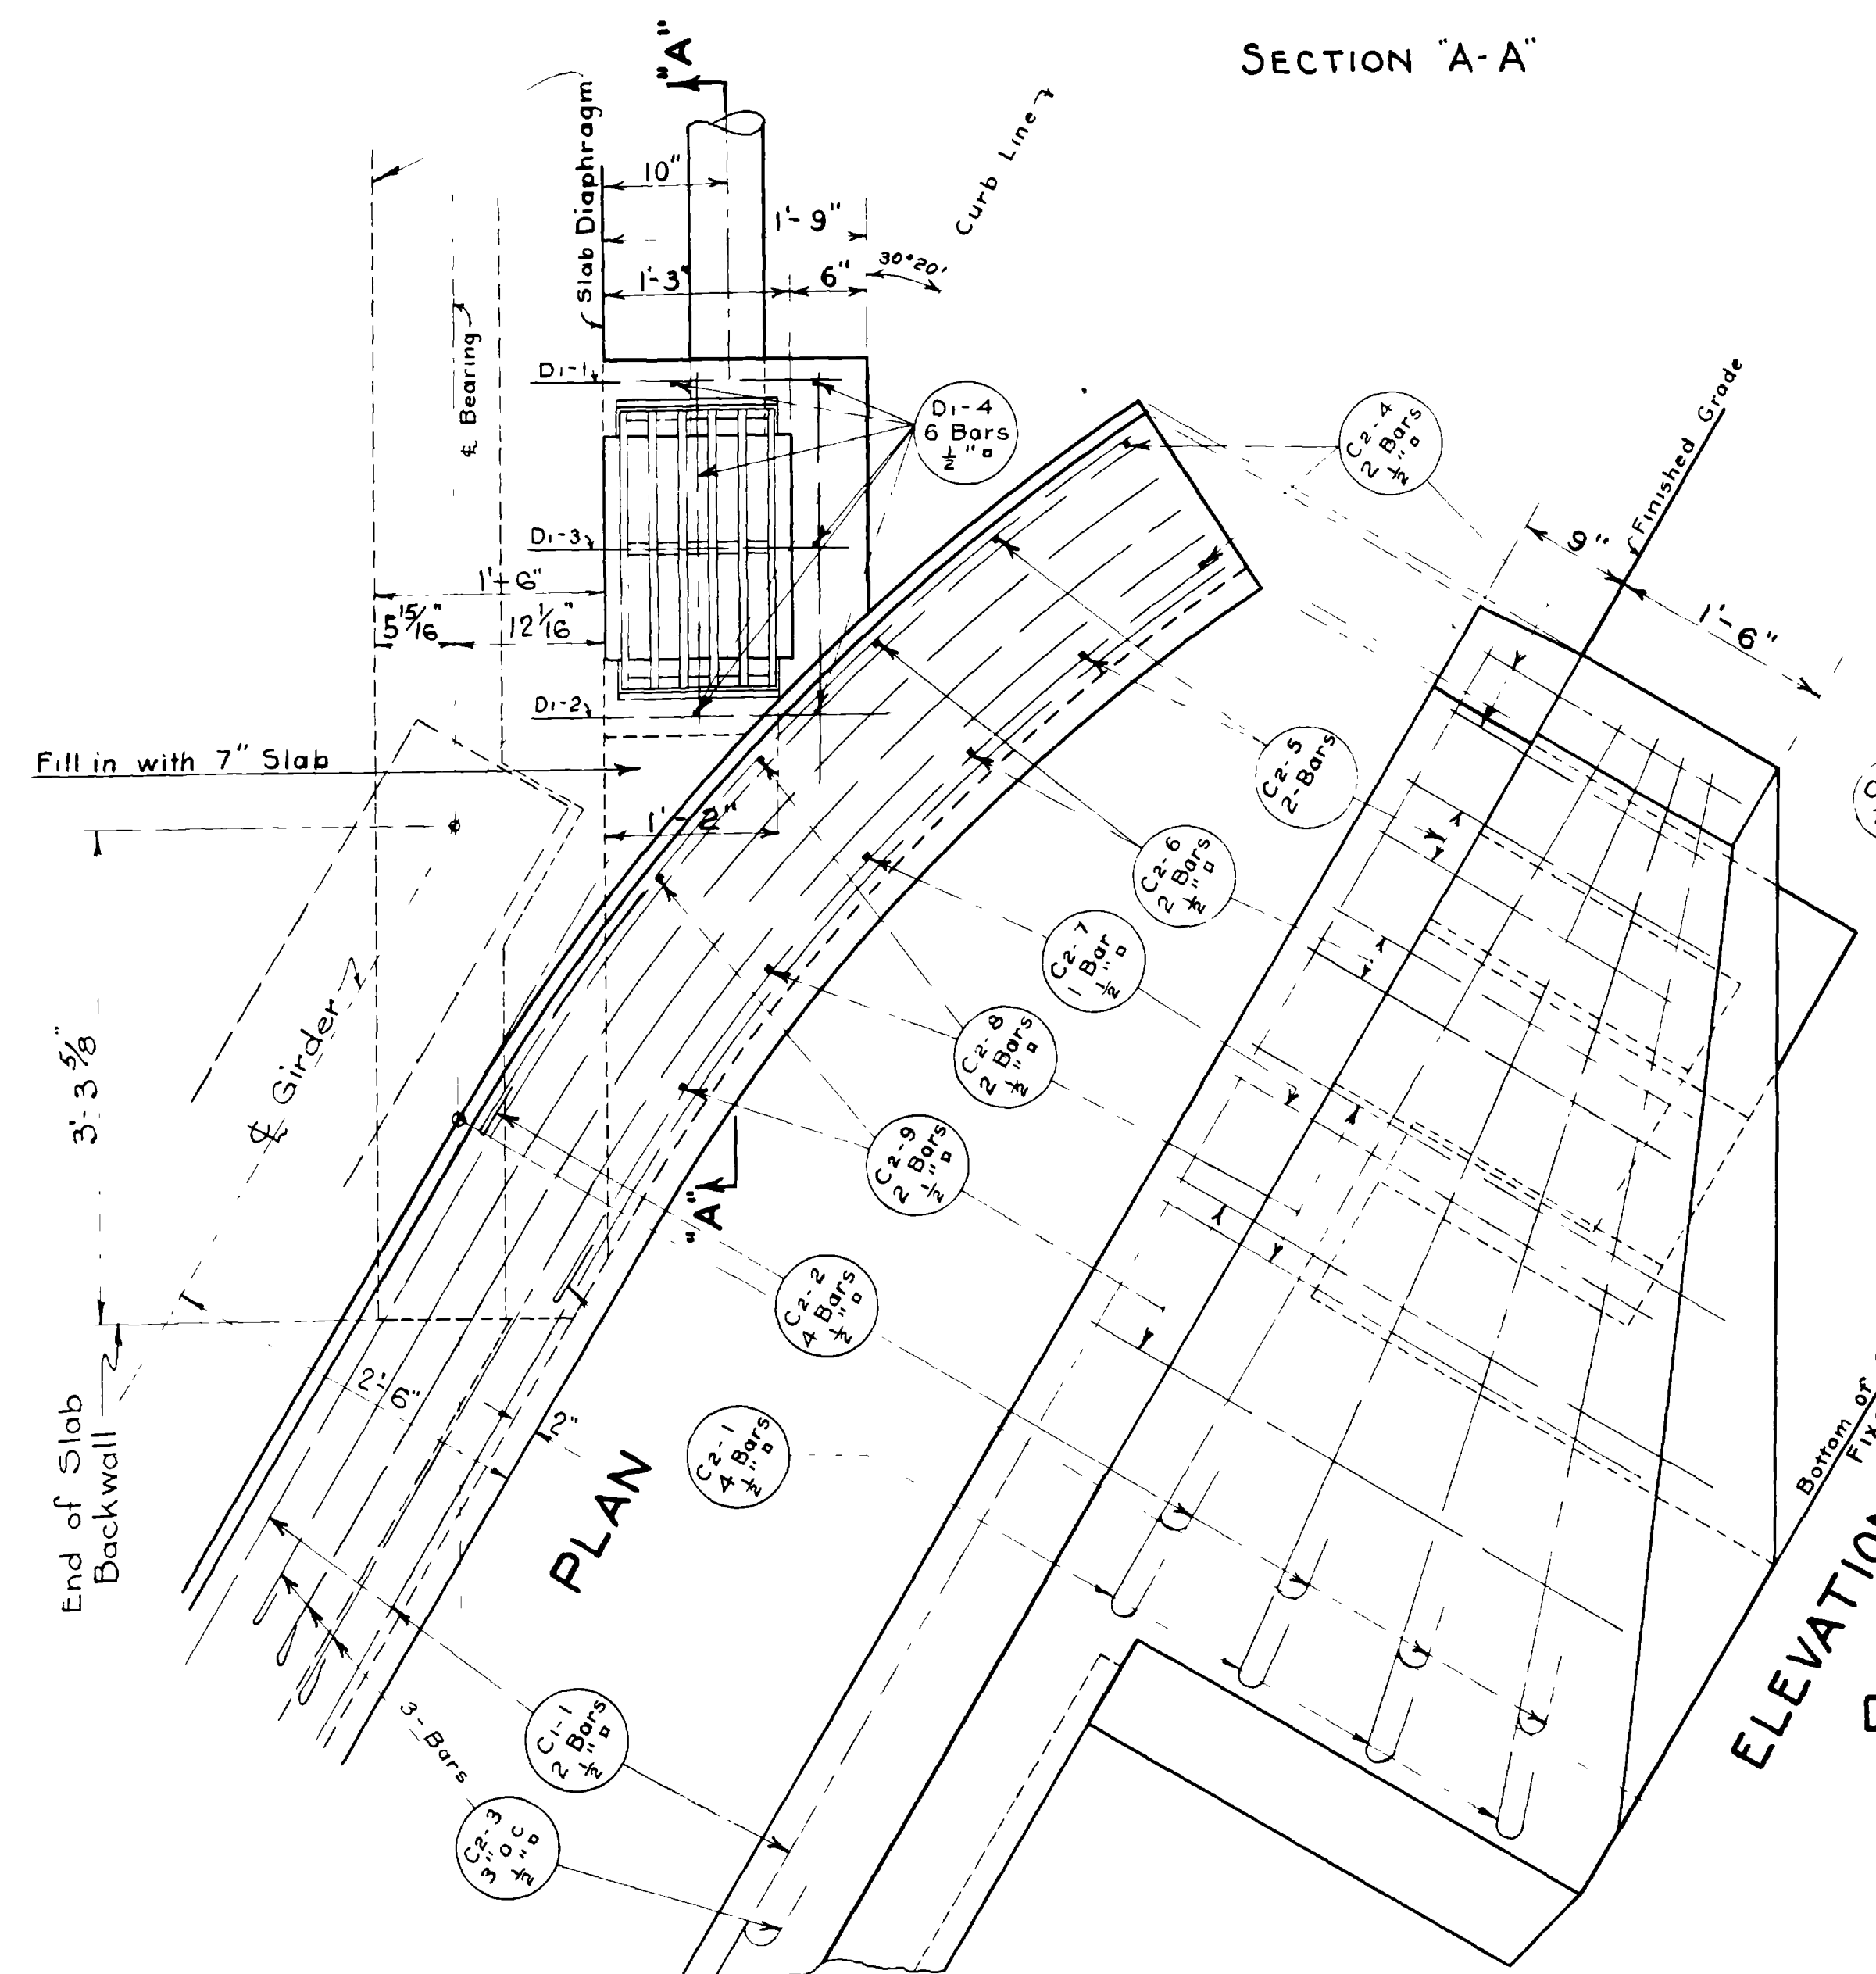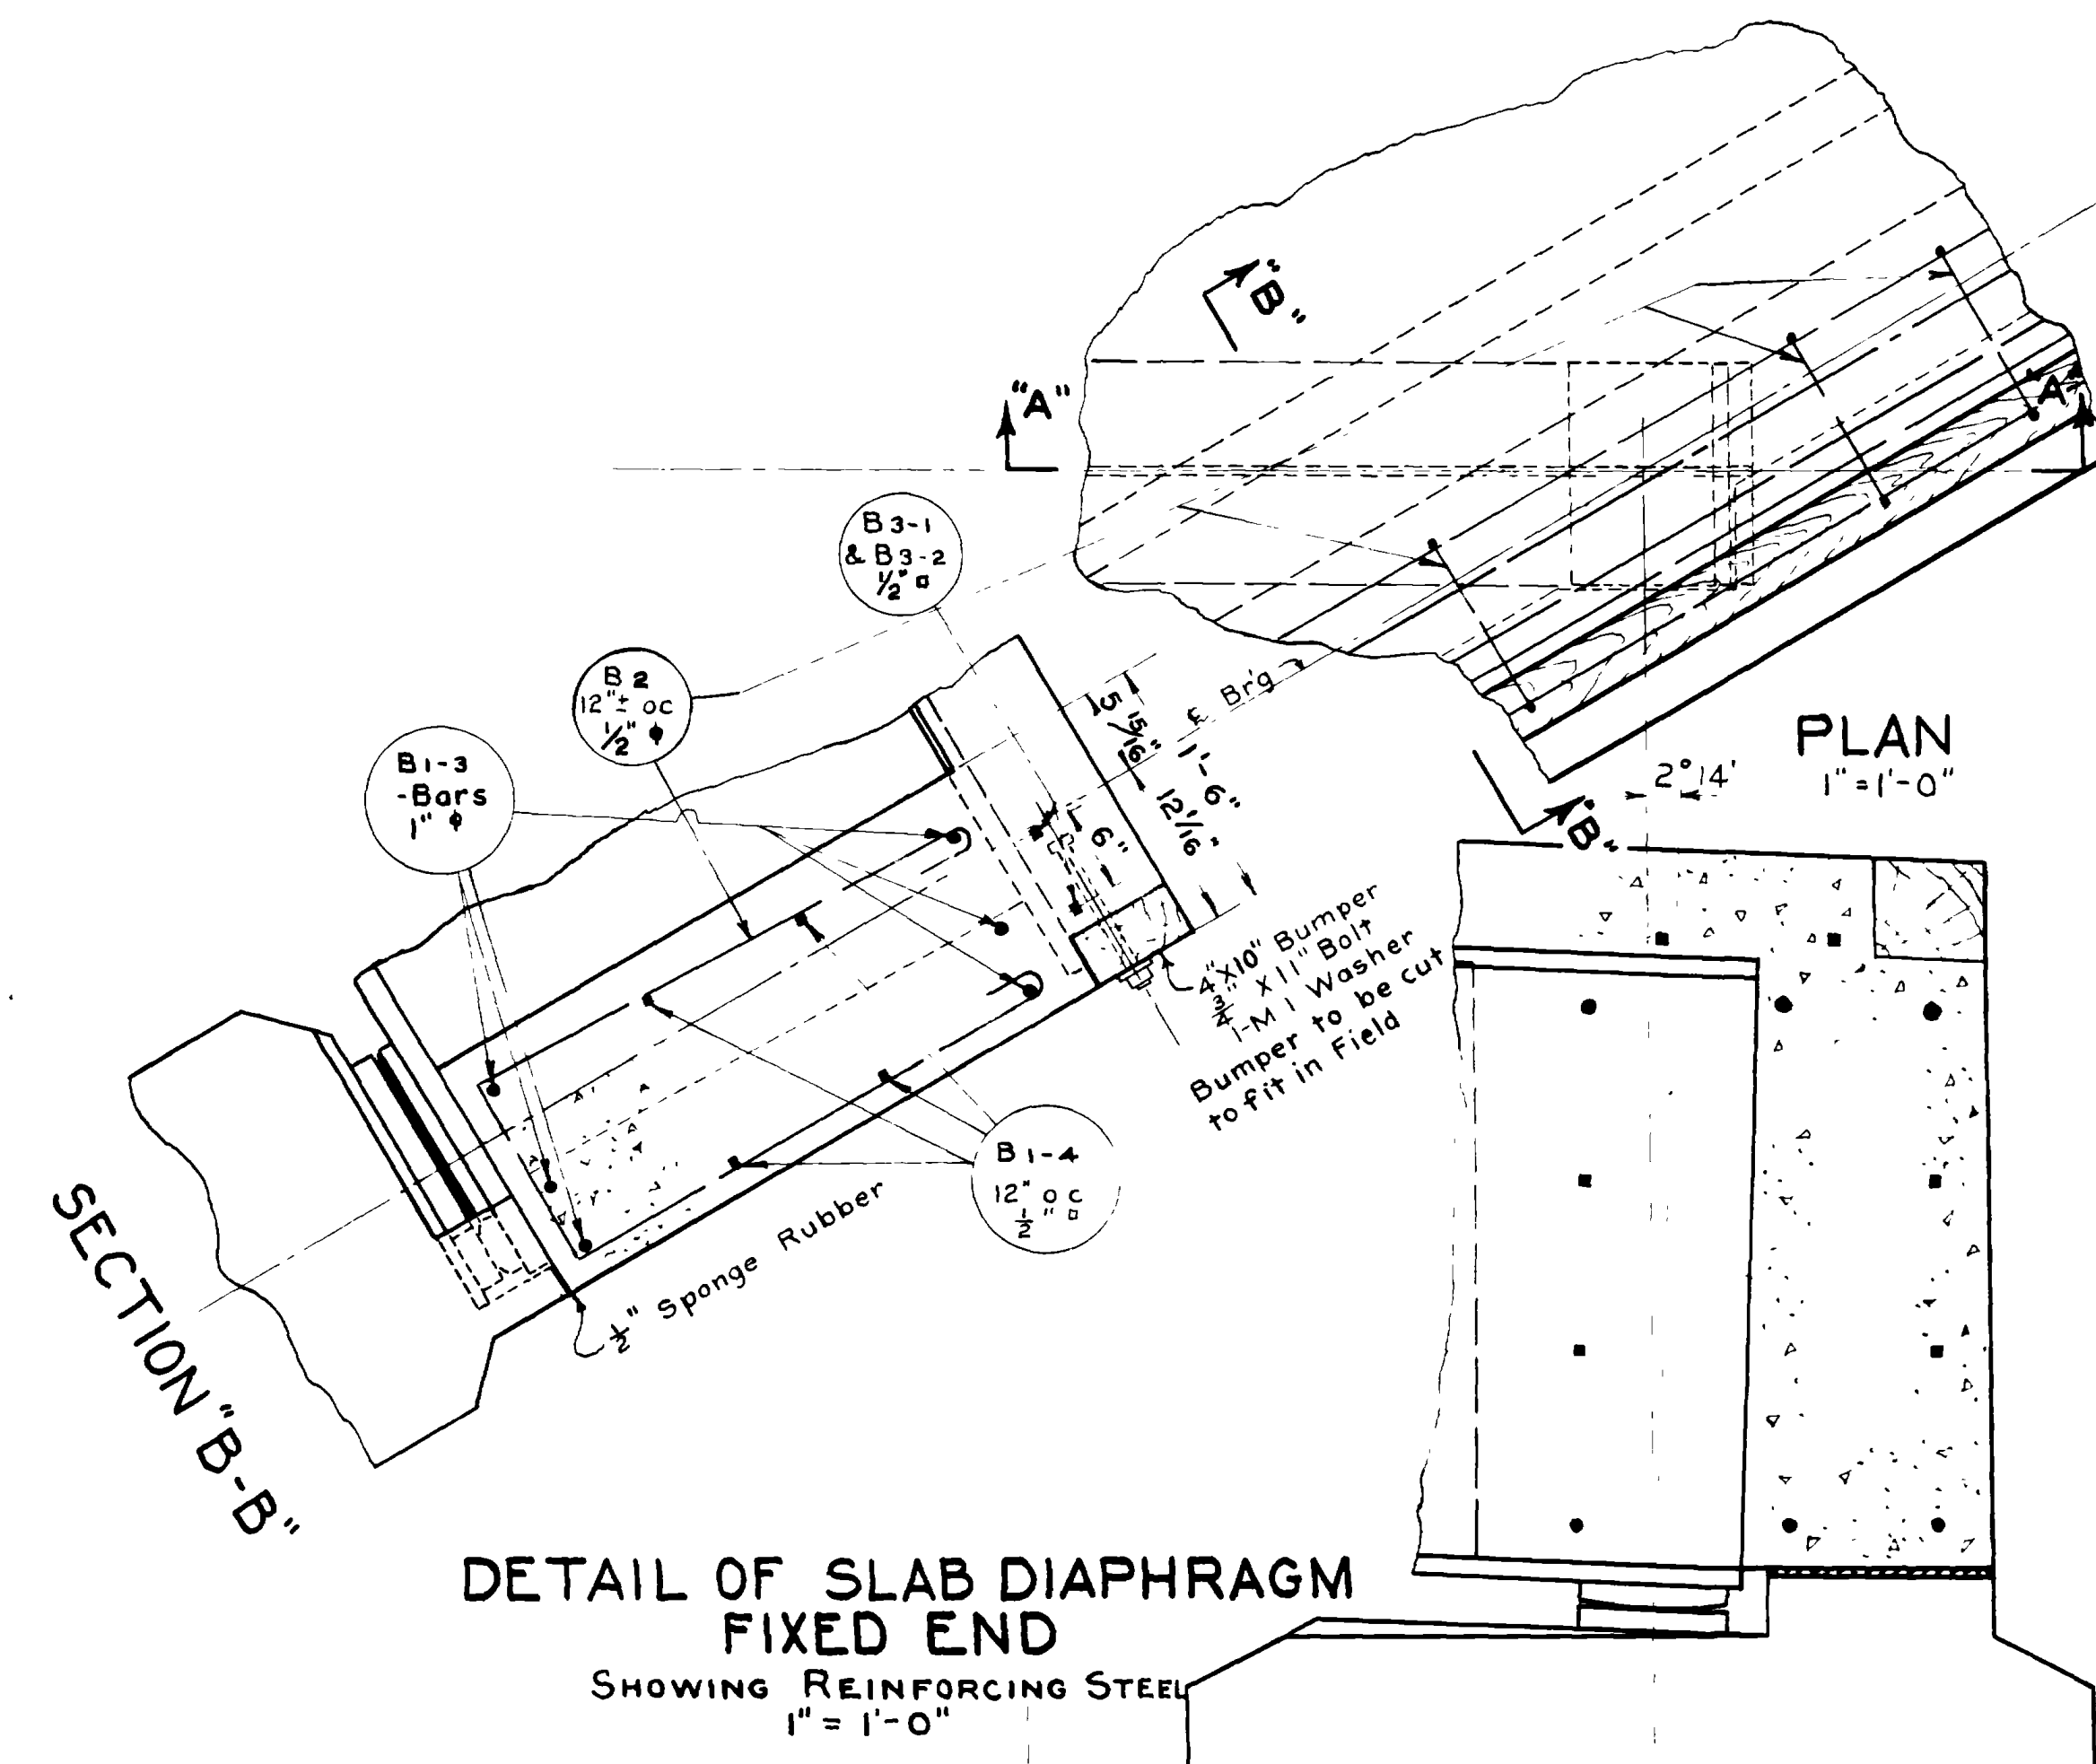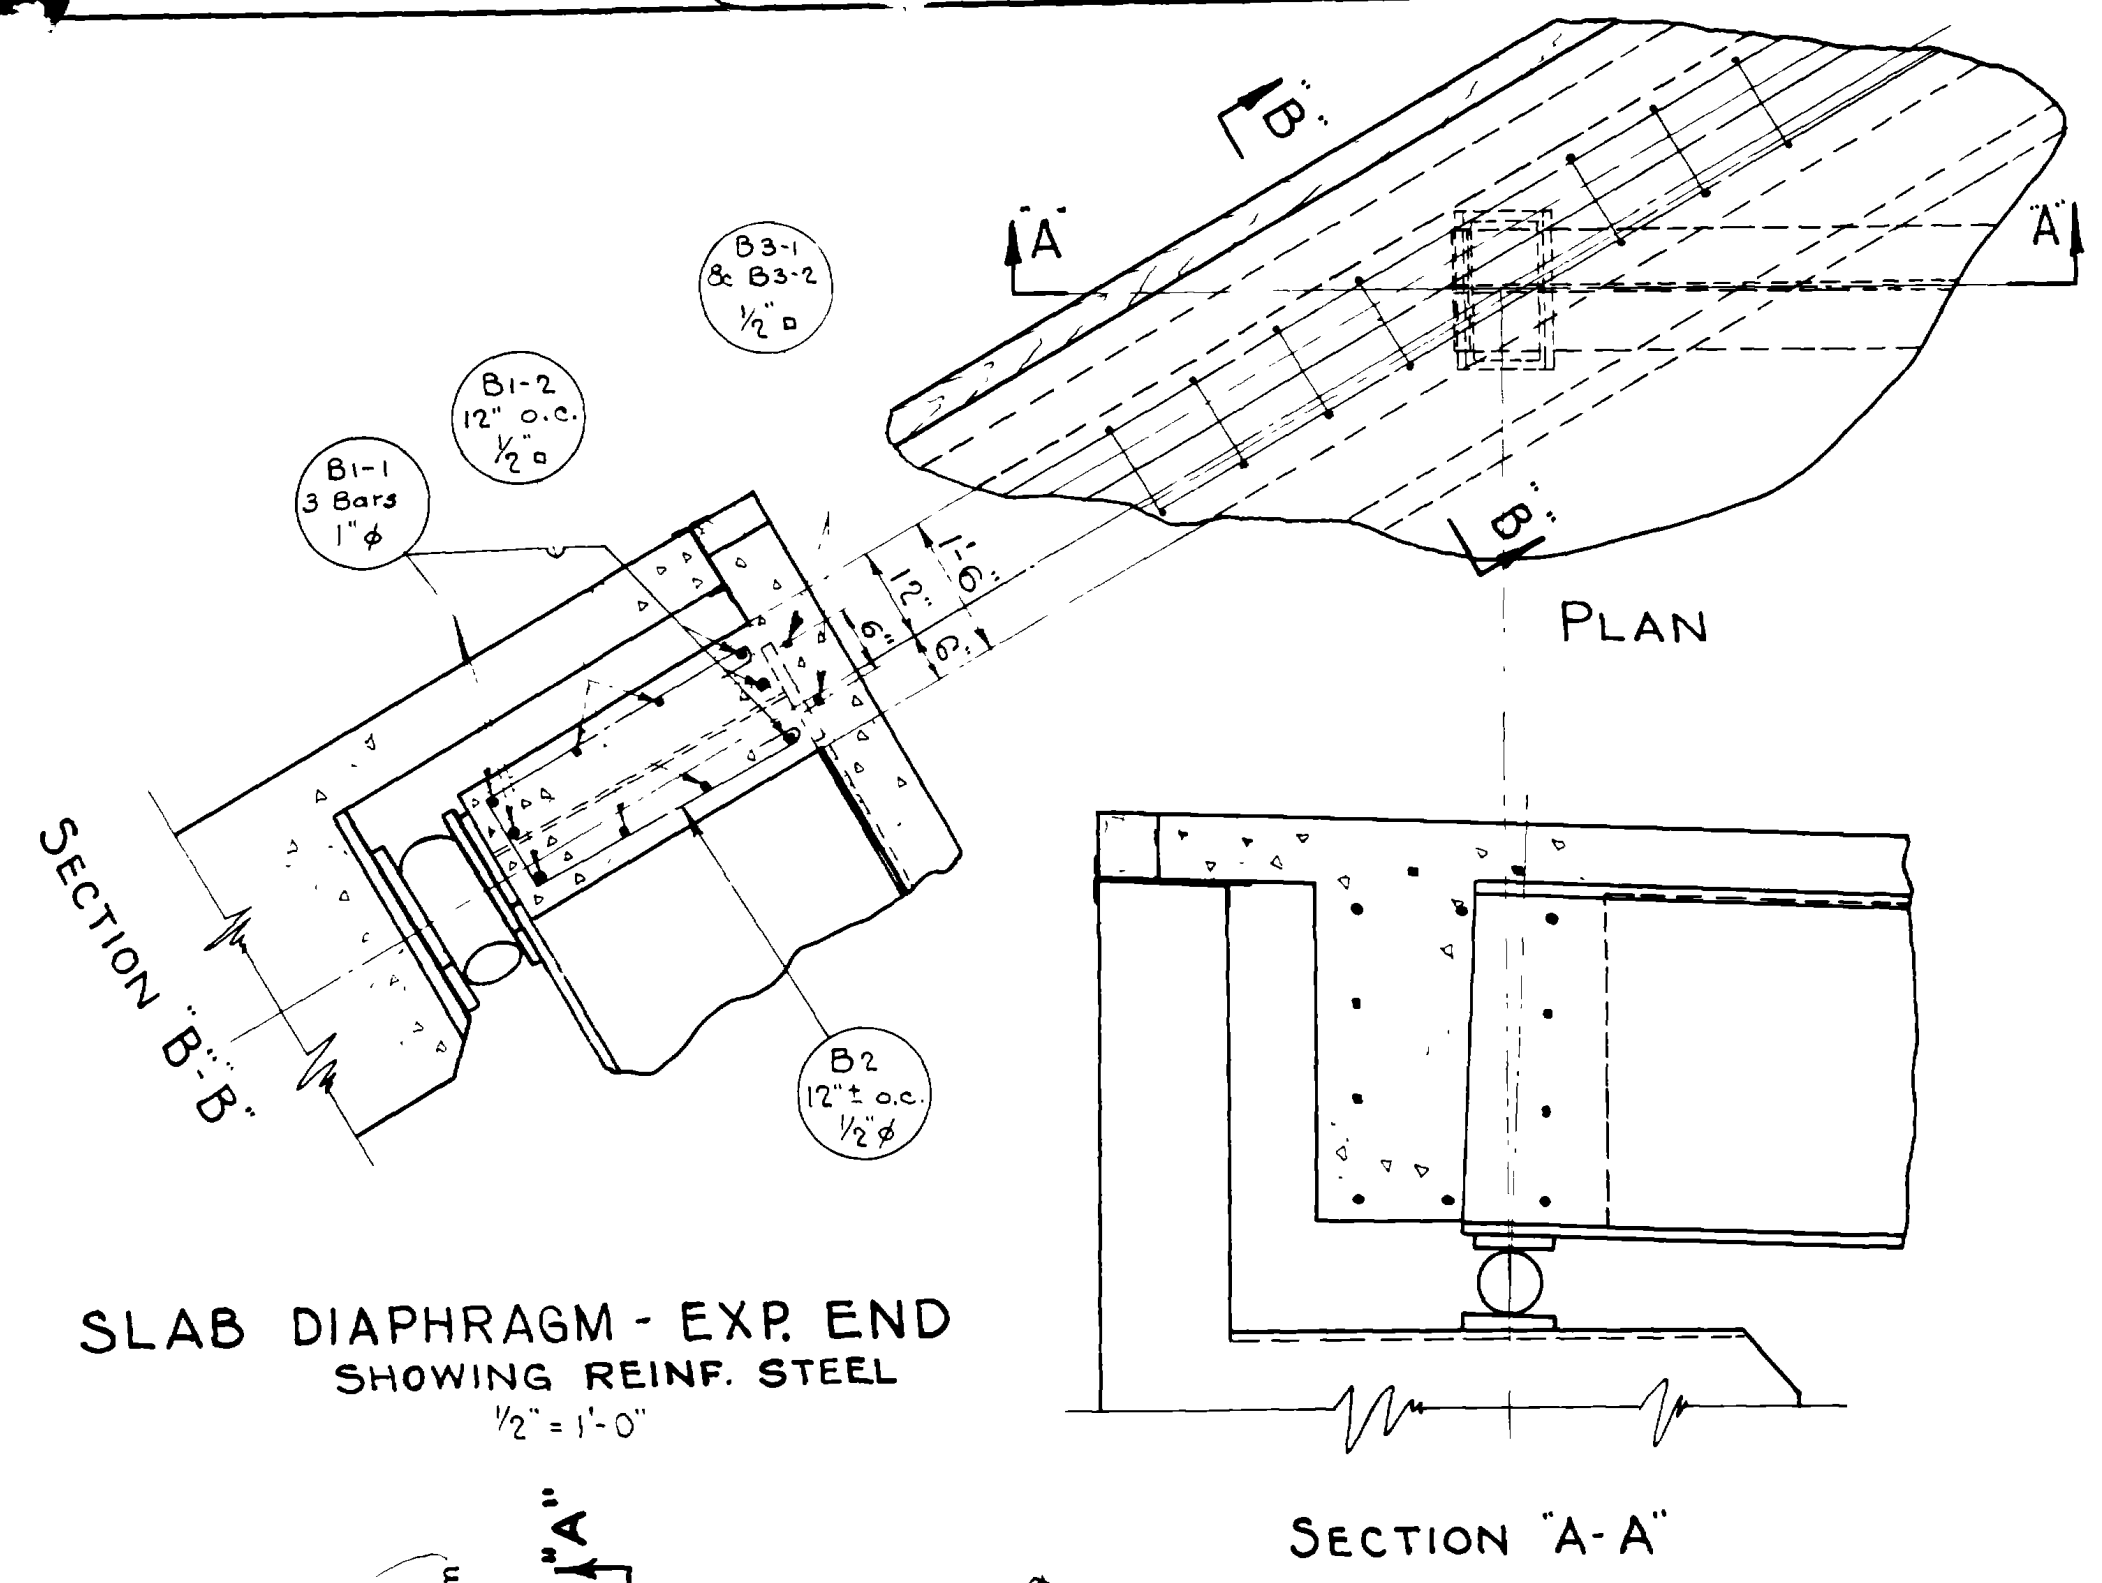


REVISIONS	DATE	BY



FED. ROAD DIST. NO.	STATE	AW-FA PROJ. NO.	FISCAL YEAR	SHEET NO.	TOTAL SHEETS
12	UTAH	222-A(1)			

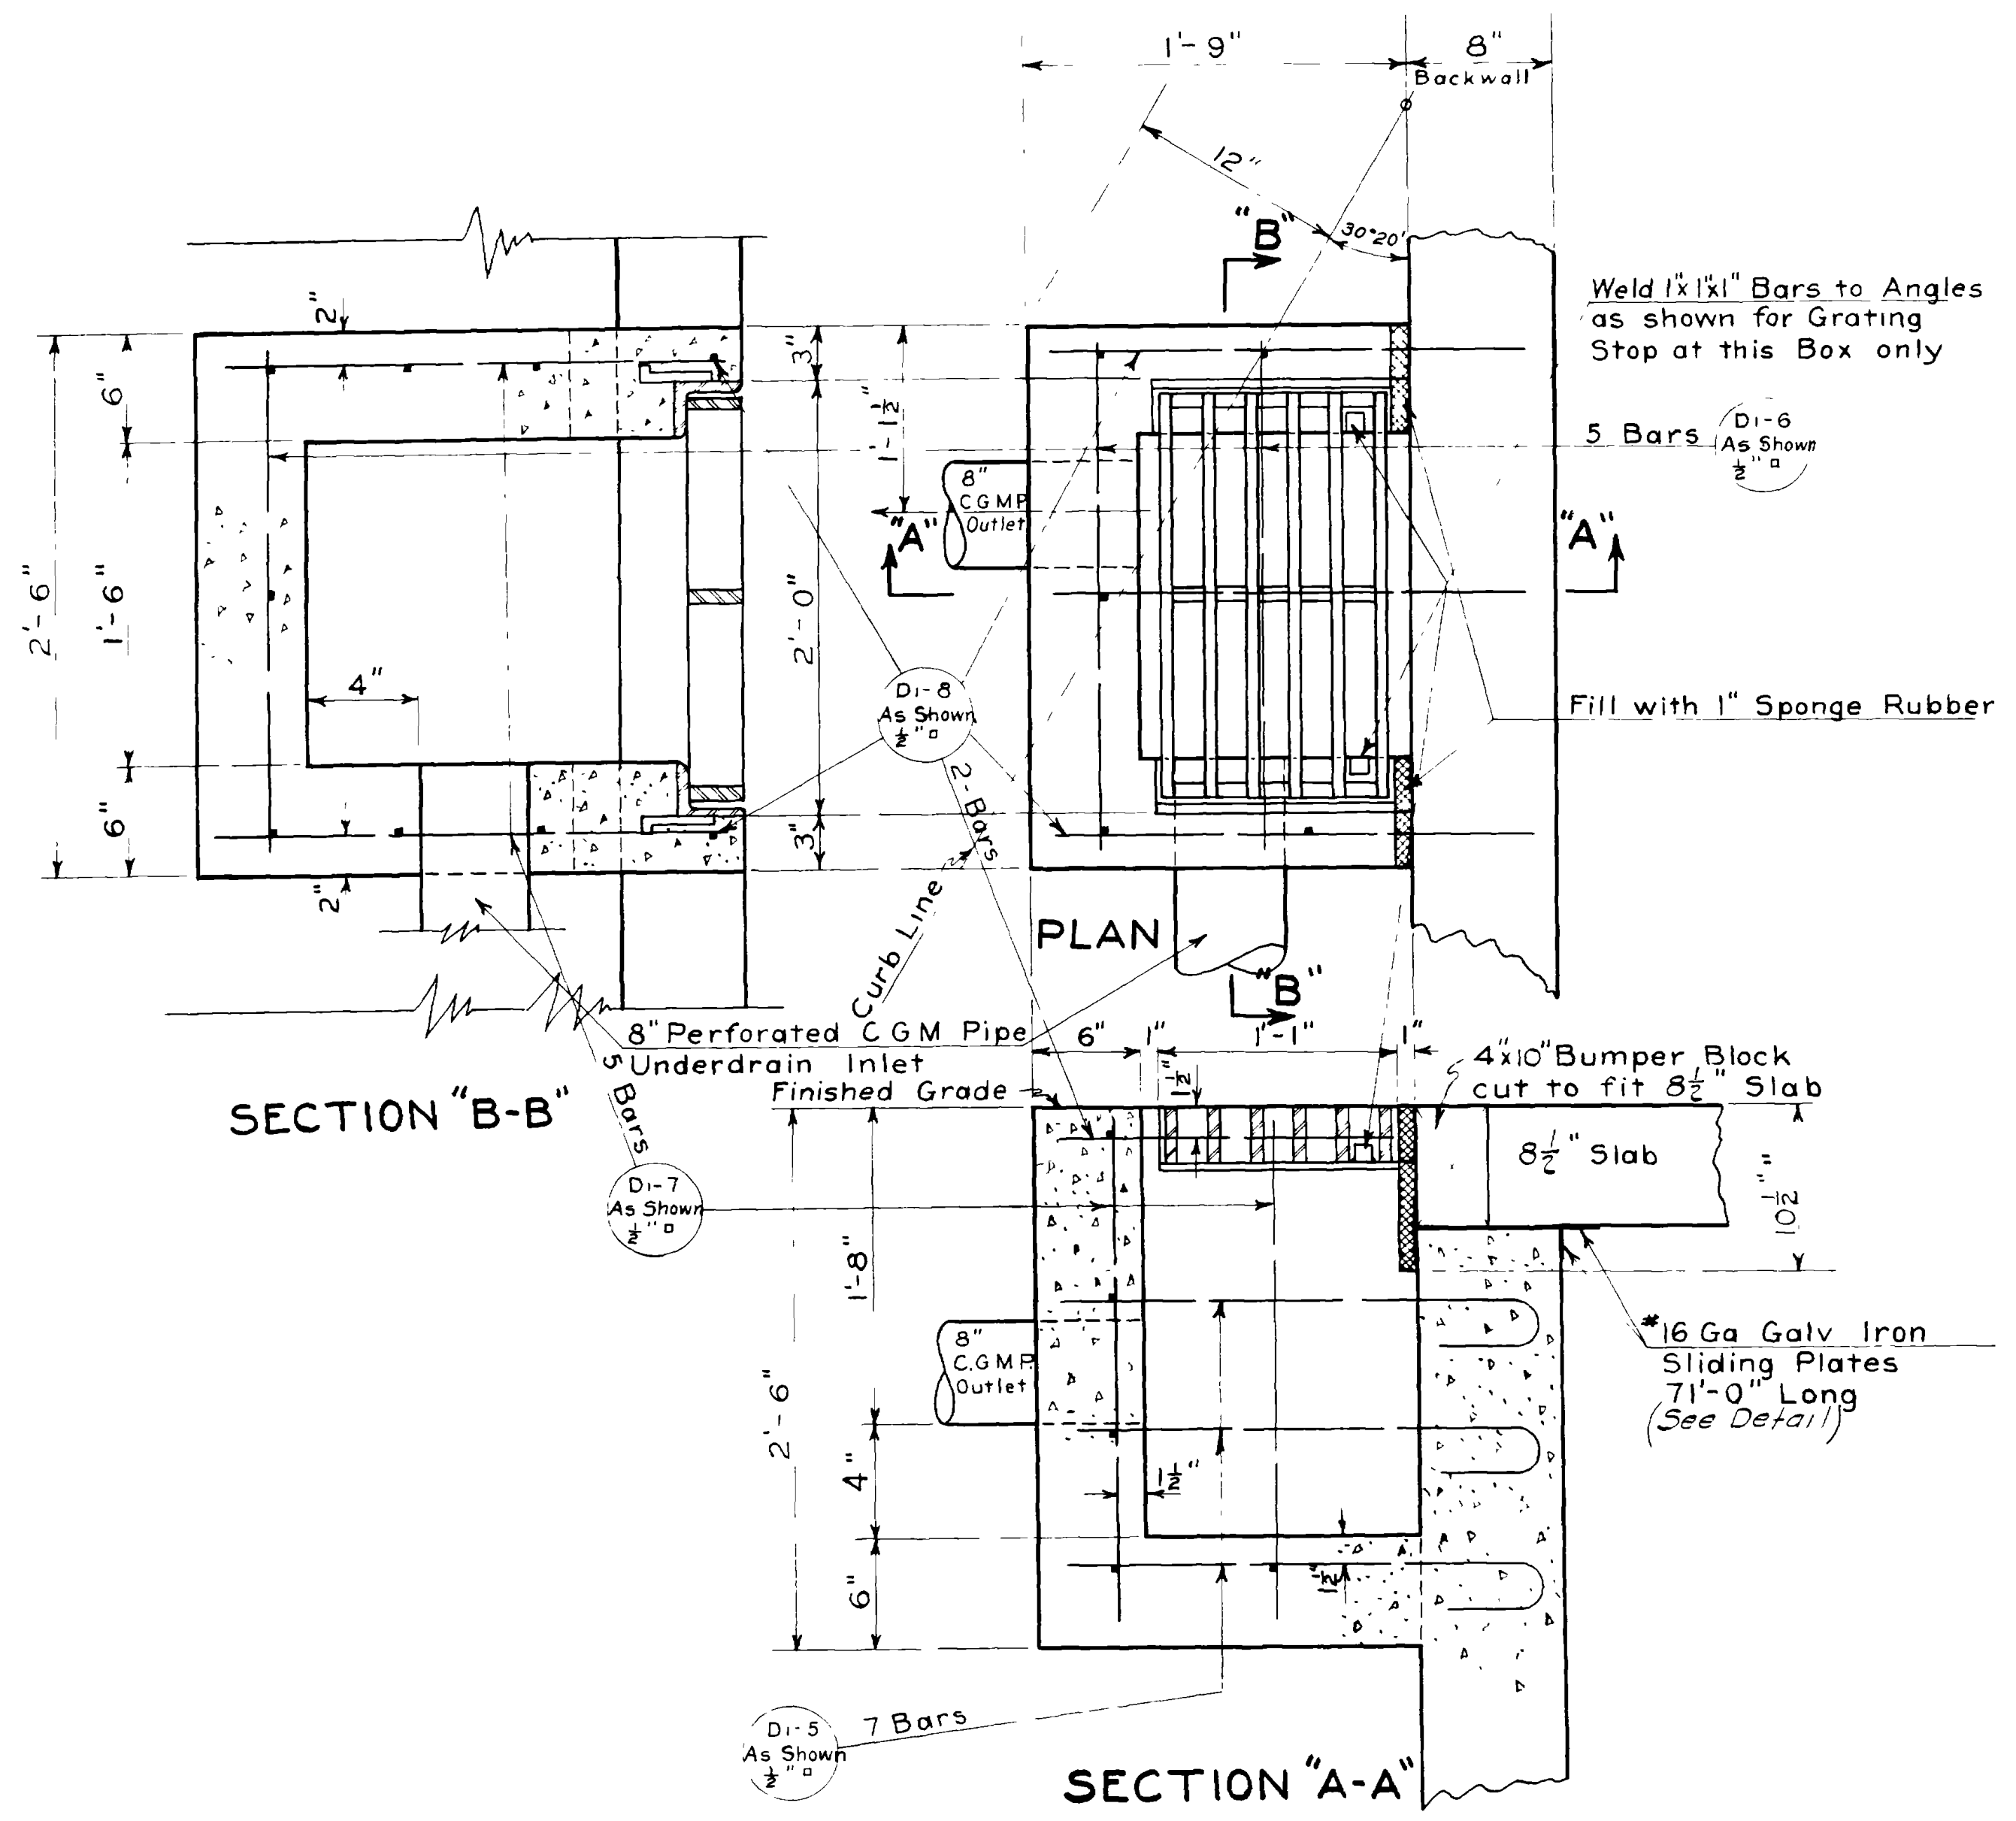


DETAIL OF DRAIN BOX No. 1 AT ABUTMENT BACKWALL
1/2" = 1'-0"

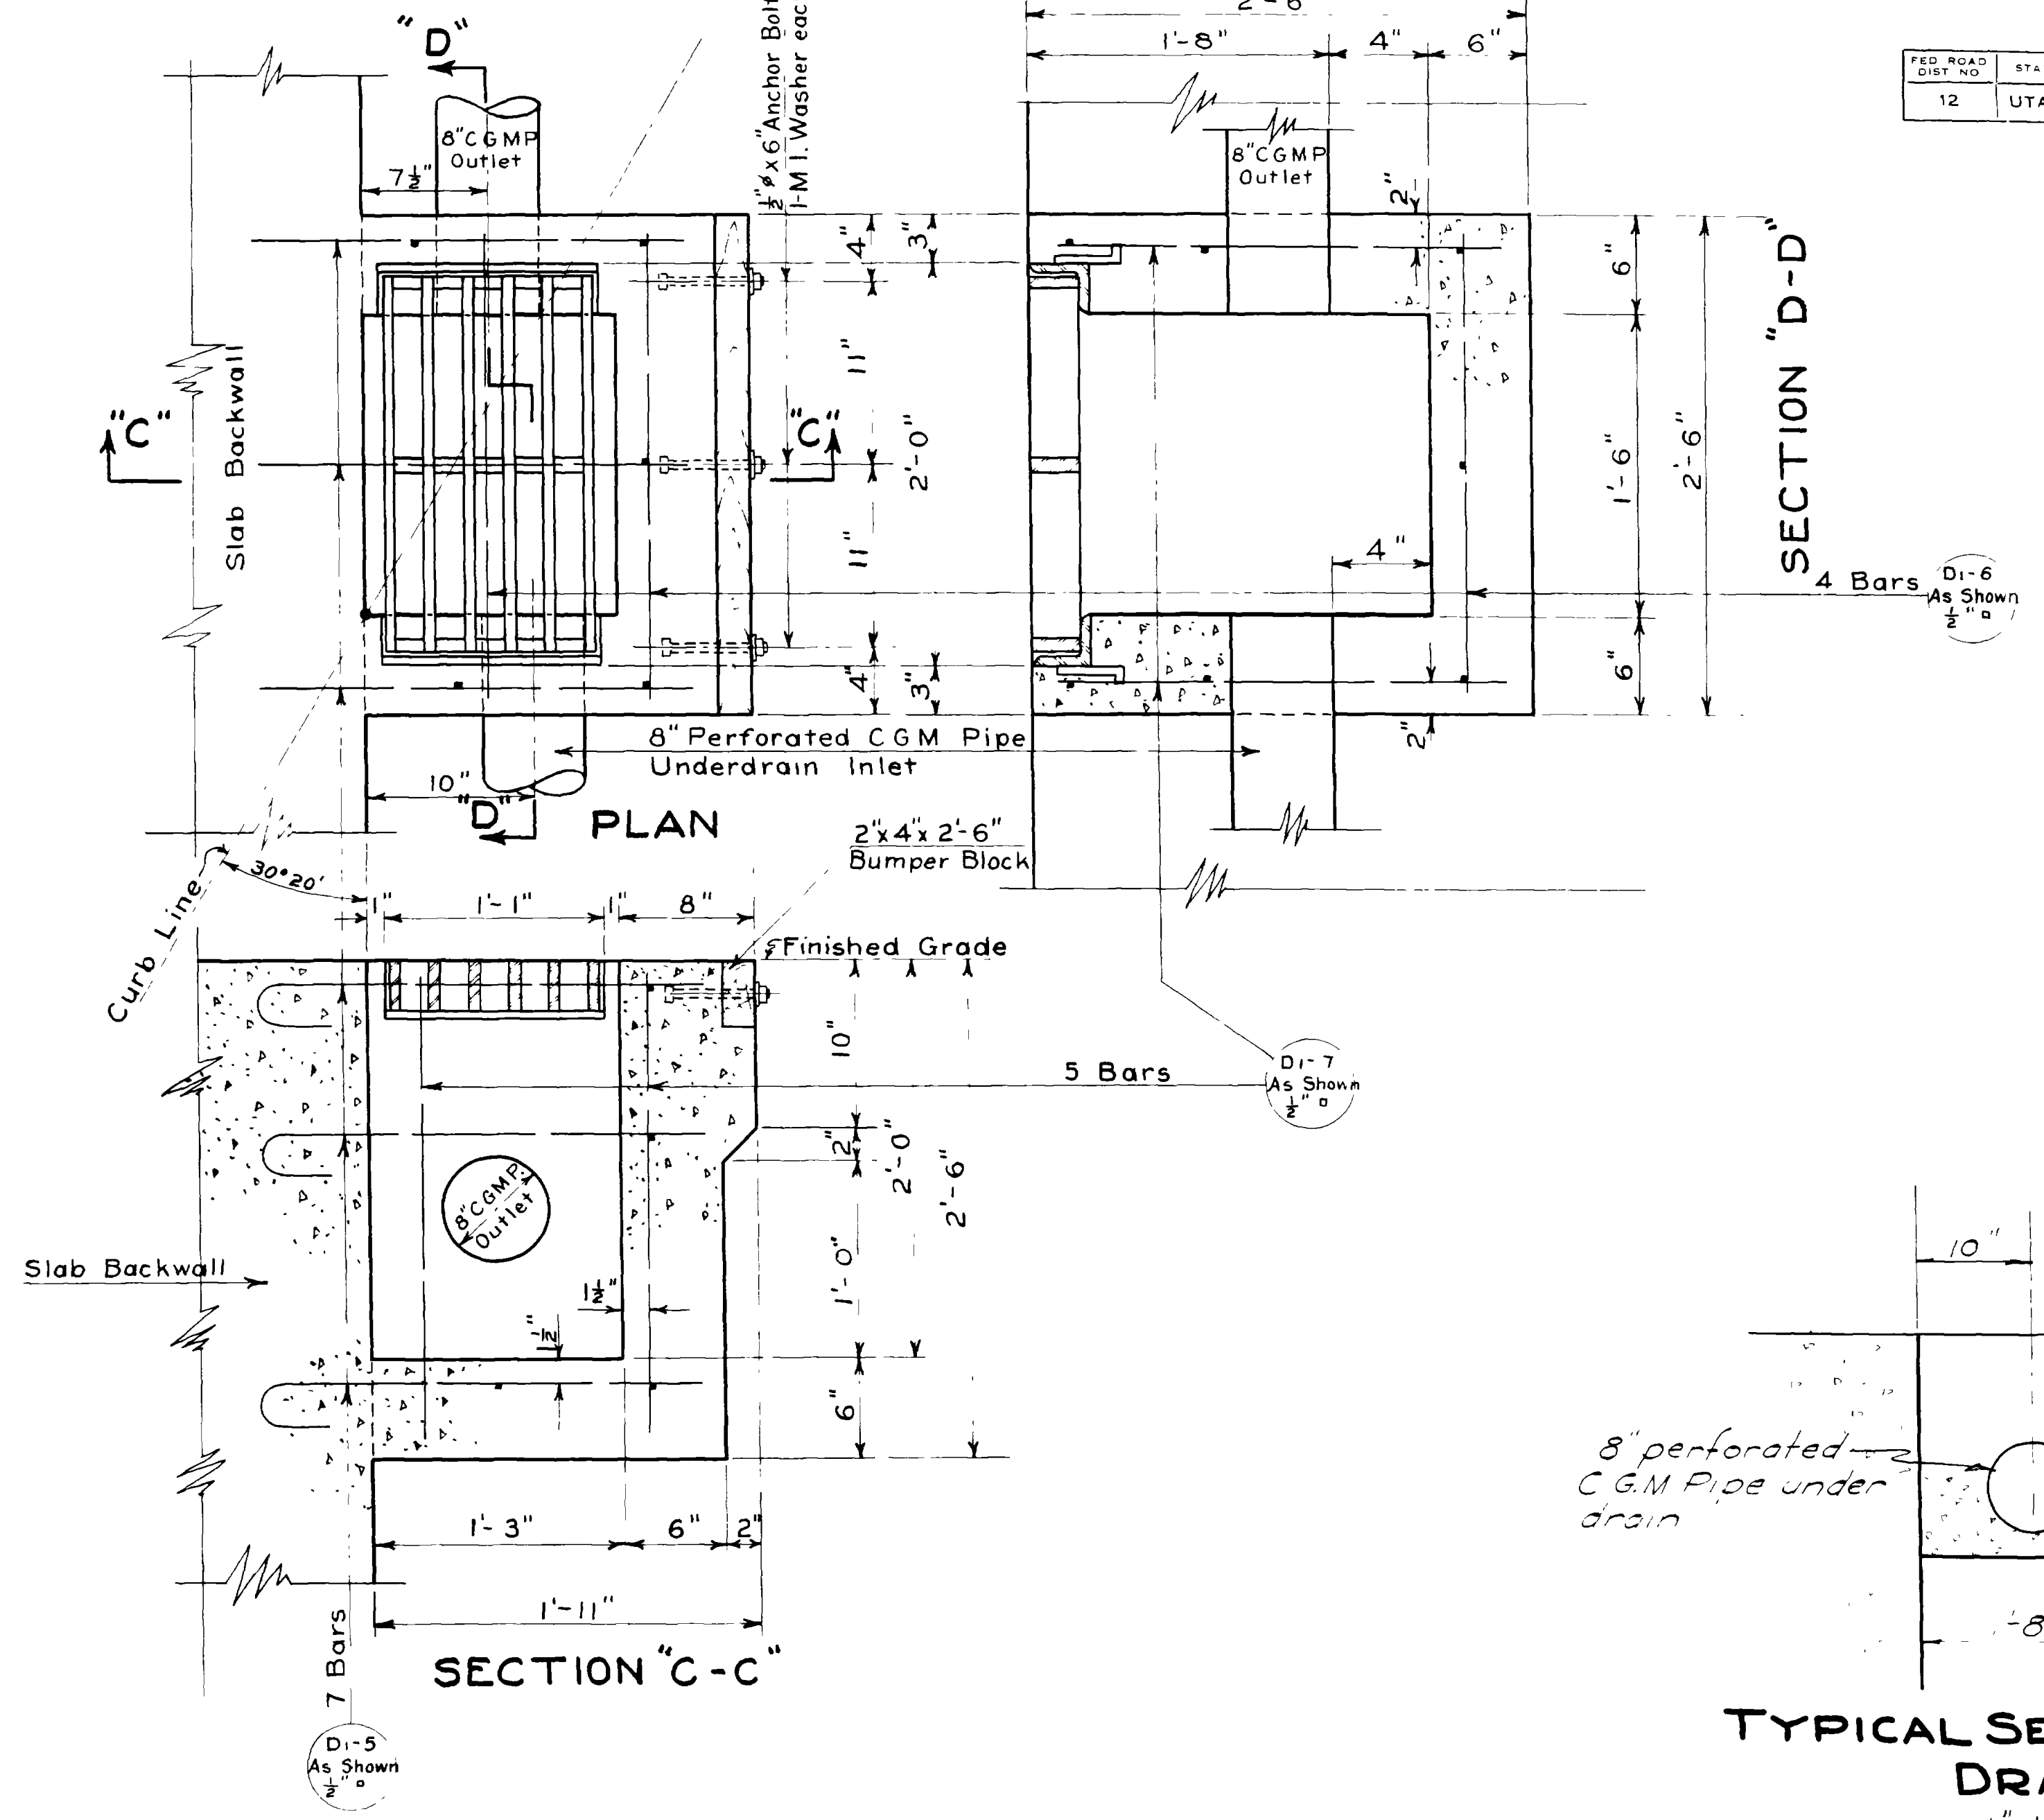

DETAIL OF DRAIN BOX No. 2 AT SLAB BACKWALL
1/2" = 1'-0"

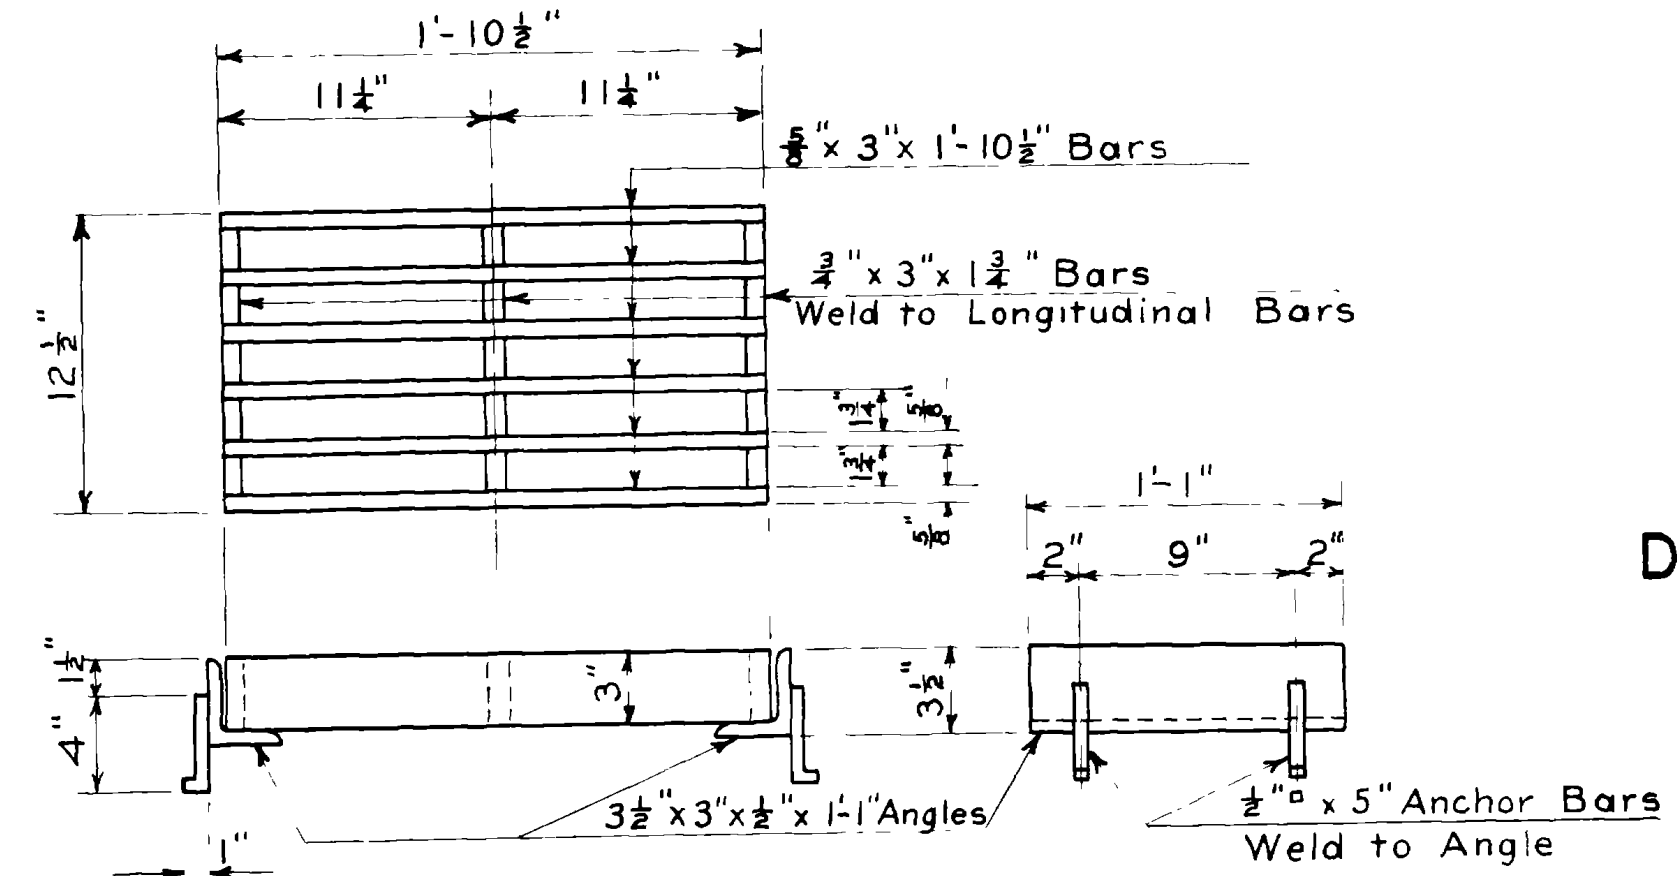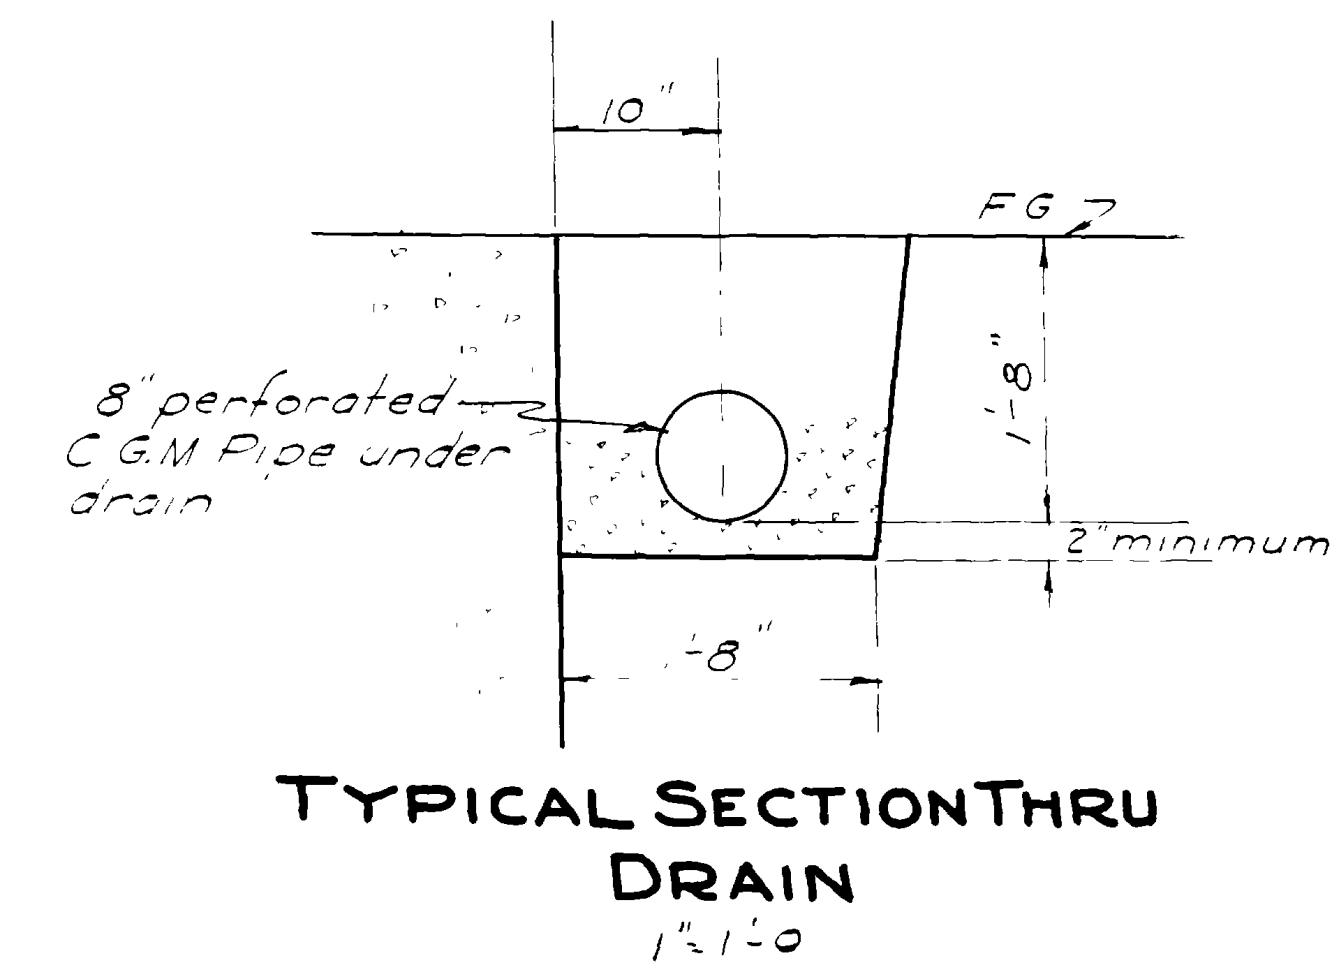

DETAIL OF GRATING & SHELF ANGLES FOR DRAIN BOXES
Weight Complete = 112 Lbs
1/2" = 1'-0" 3 Required

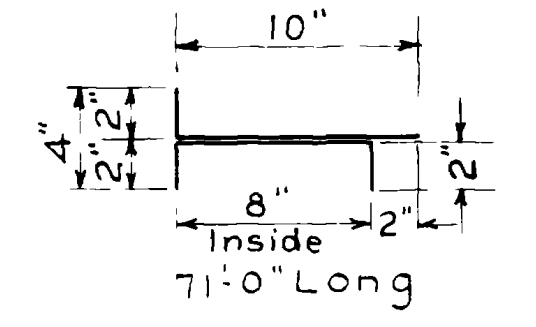

DETAIL OF 16 Ga. GALV. IRON SLIDING PLATES
1/2" = 1'-0"

Sheet # 6 of 15 Sheets




UTAH STATE ROAD COMMISSION
SALT LAKE CITY, UTAH
E. C. KNOWLTON, CHIEF ENGINEER

STEEL DECK GIRDER BRIDGE
84-6 3/8" O to O-149'40" X-ING ANGLE
WEBER-DAVIS CANAL
Sta. 27+46 AWFAP 222 A(1)
Rivardale Arsenal Davis Co.

K.W.T. 1/2" = 1'-0"
D.M.S.

6-259-1-1 DFC C-215




FED. ROAD DIST. NO.	STATE	AWFA PROJ. NO.	FISCAL YEAR	SHEET NO.	TOTAL SHEETS
12	UTAH	222-A(1)			

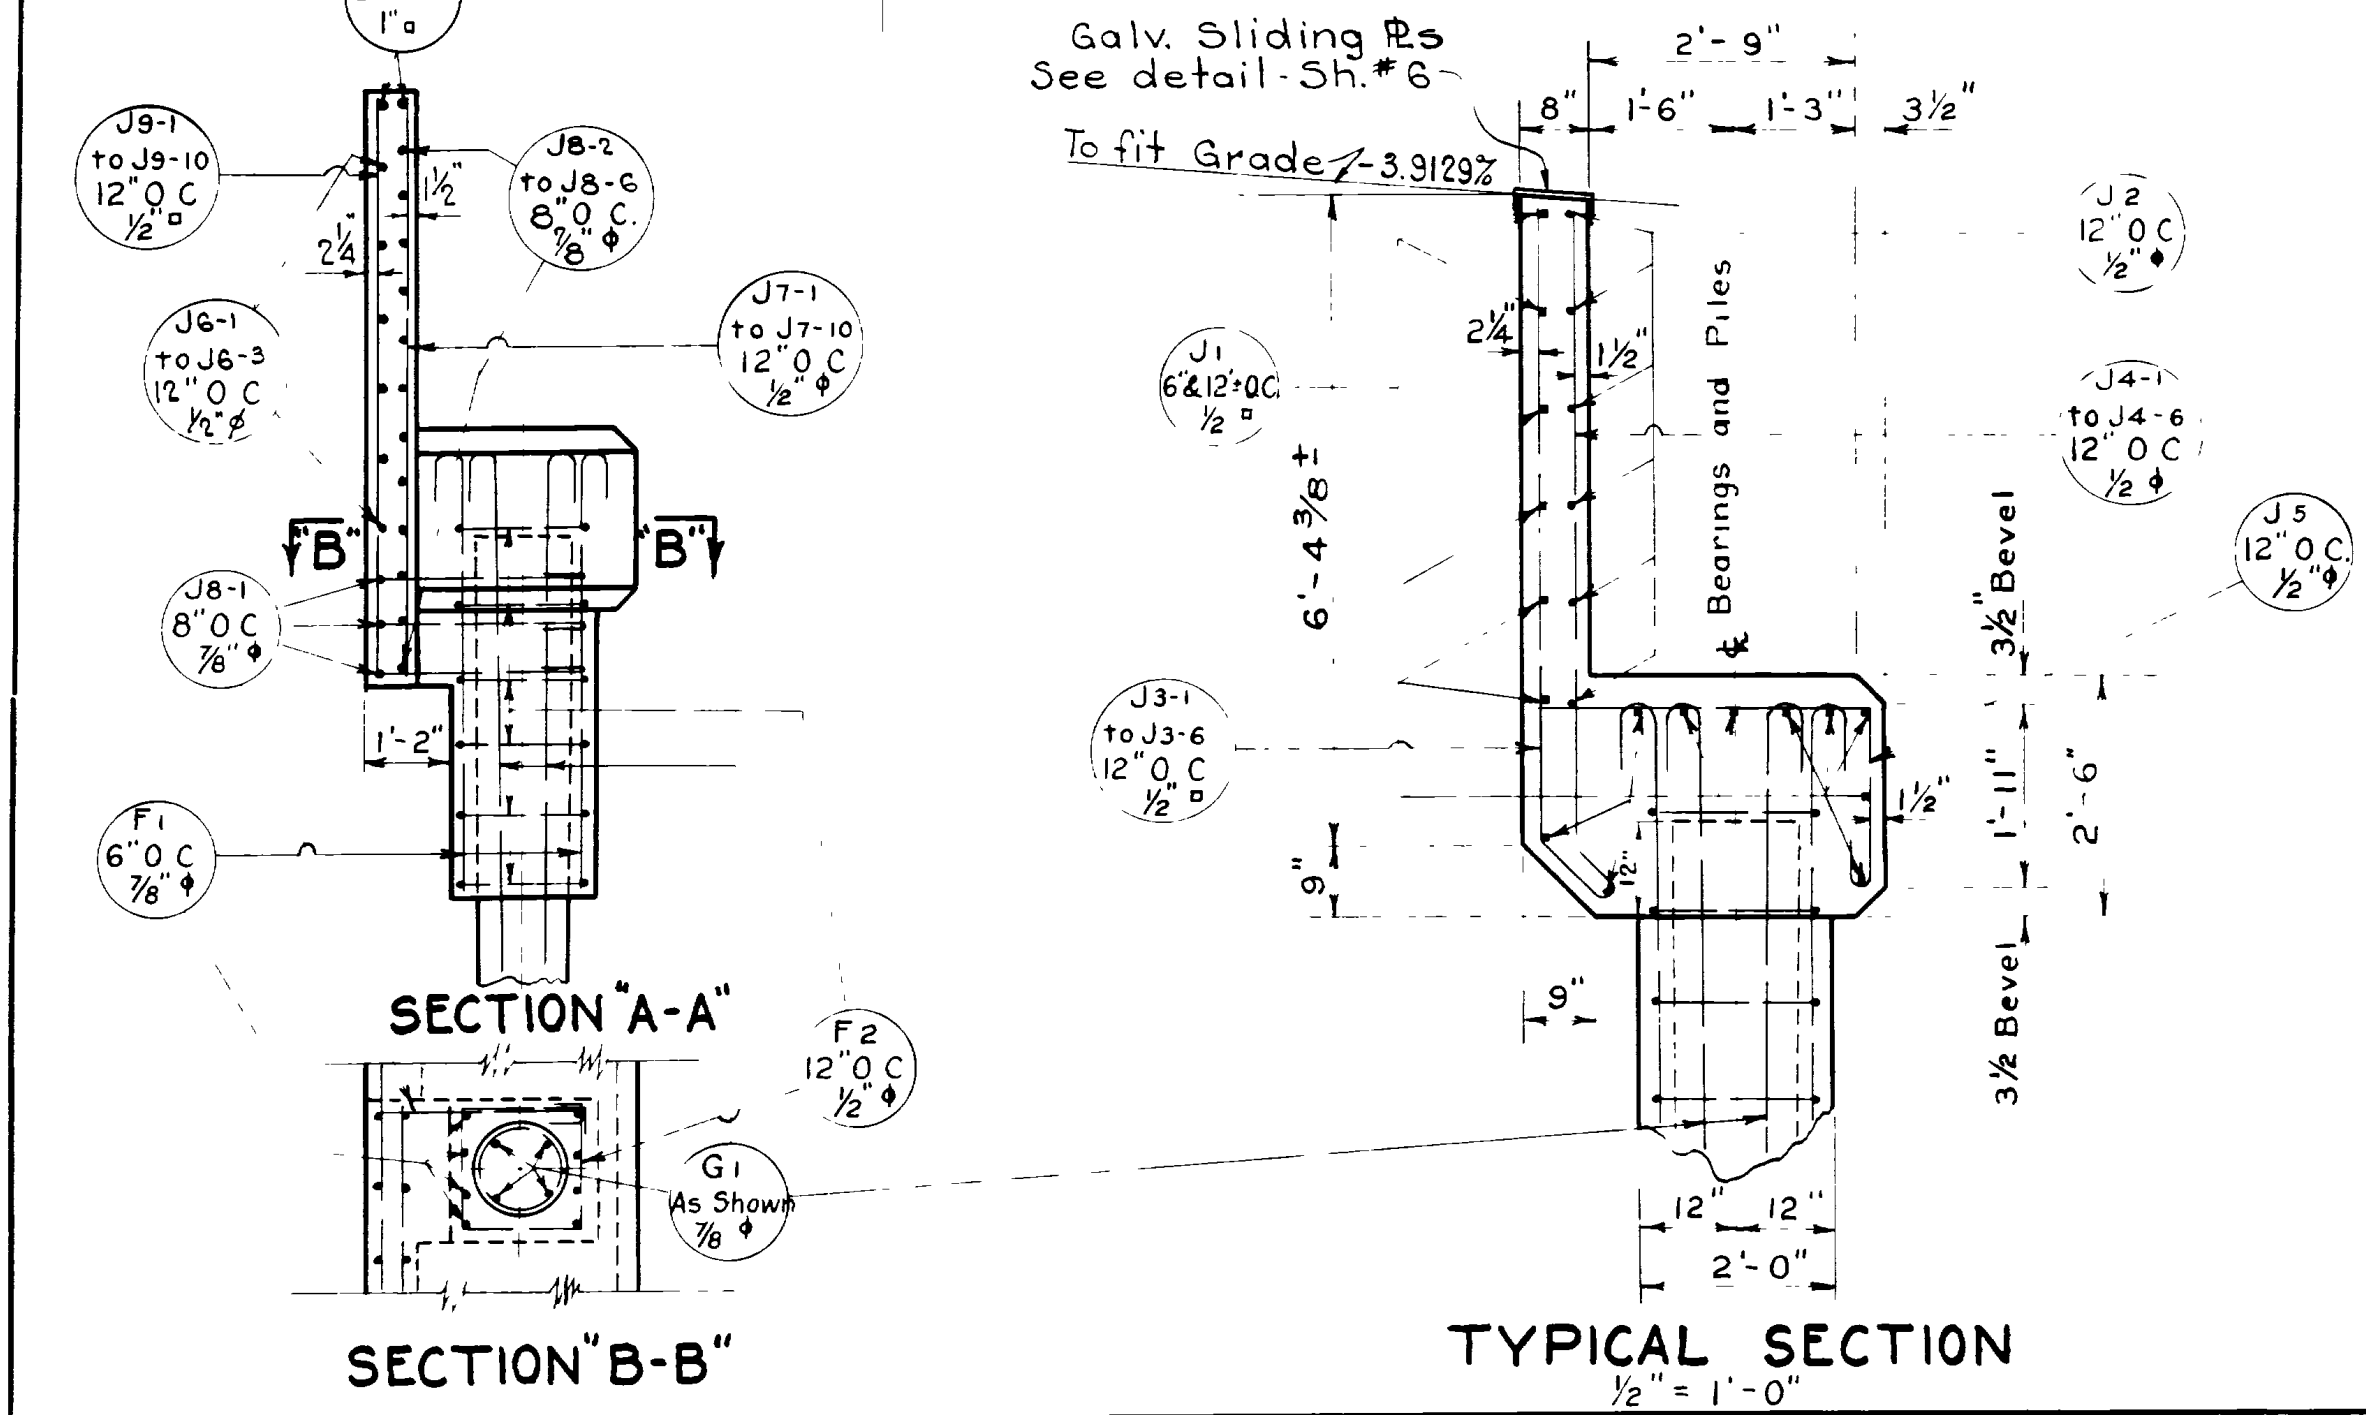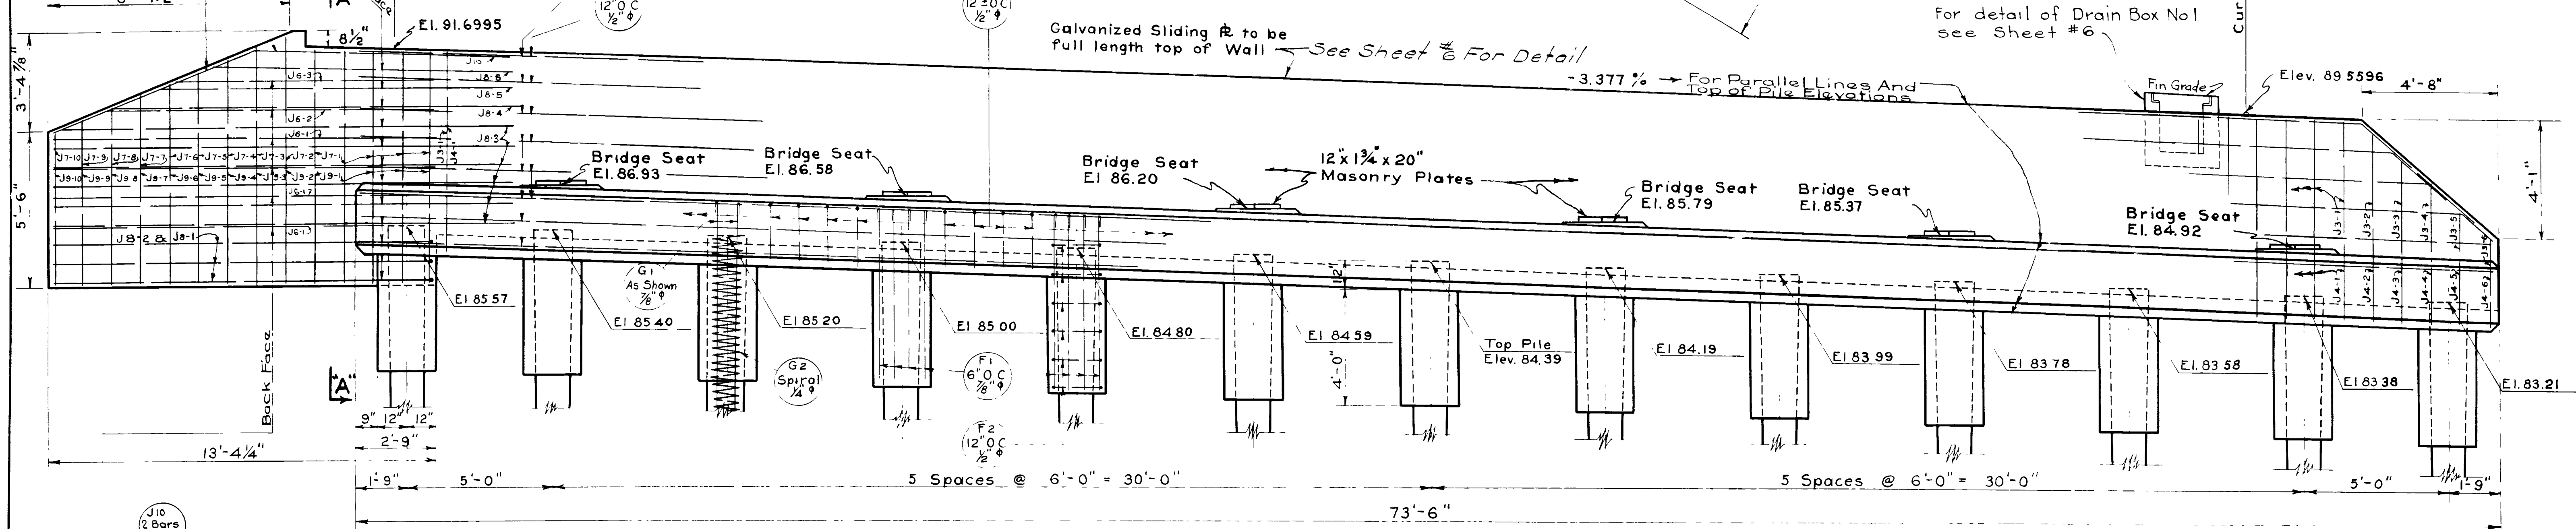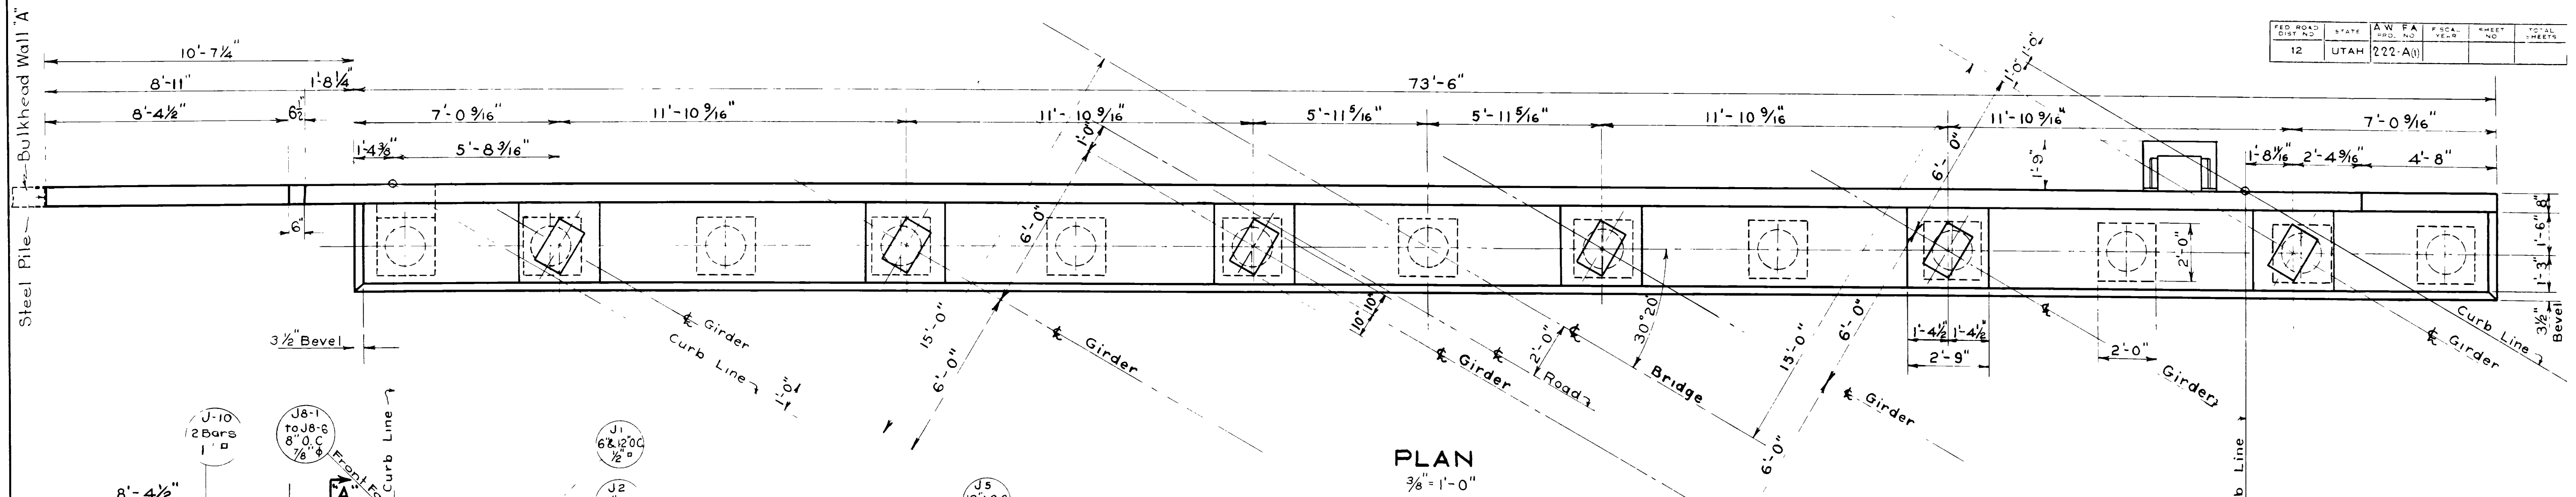

ELEVATION
UPPER ABUTMENT-EXPANSION END
 3/8" = 1'-0"

Sheet #7 of 15 Sheets
 UTAH STATE ROAD COMMISSION
 SALT LAKE CITY, UTAH
 EST. C. ANALYTIC, CHIEF ENGINEER
STEEL DECK GIRDER BRIDGE
 84'-6 3/8" O to 0-149' 40" XING ANGLE
 WEBER-DAVIS CANAL
 Sta 27+46 AWFAP 222 A(1)
 Riverdale Arsenal-Davis Co.
 KWT
 DMS
 As Noted
 Paul Martin
 1/24/14
 No. 6-259-1-1 C-215

FED. ROAD DIST. NO.	STATE	AW-FA PROJ. NO.	SCALE	SHEET NO.	TOTAL SHEETS
12	UTAH	222-A(1)			

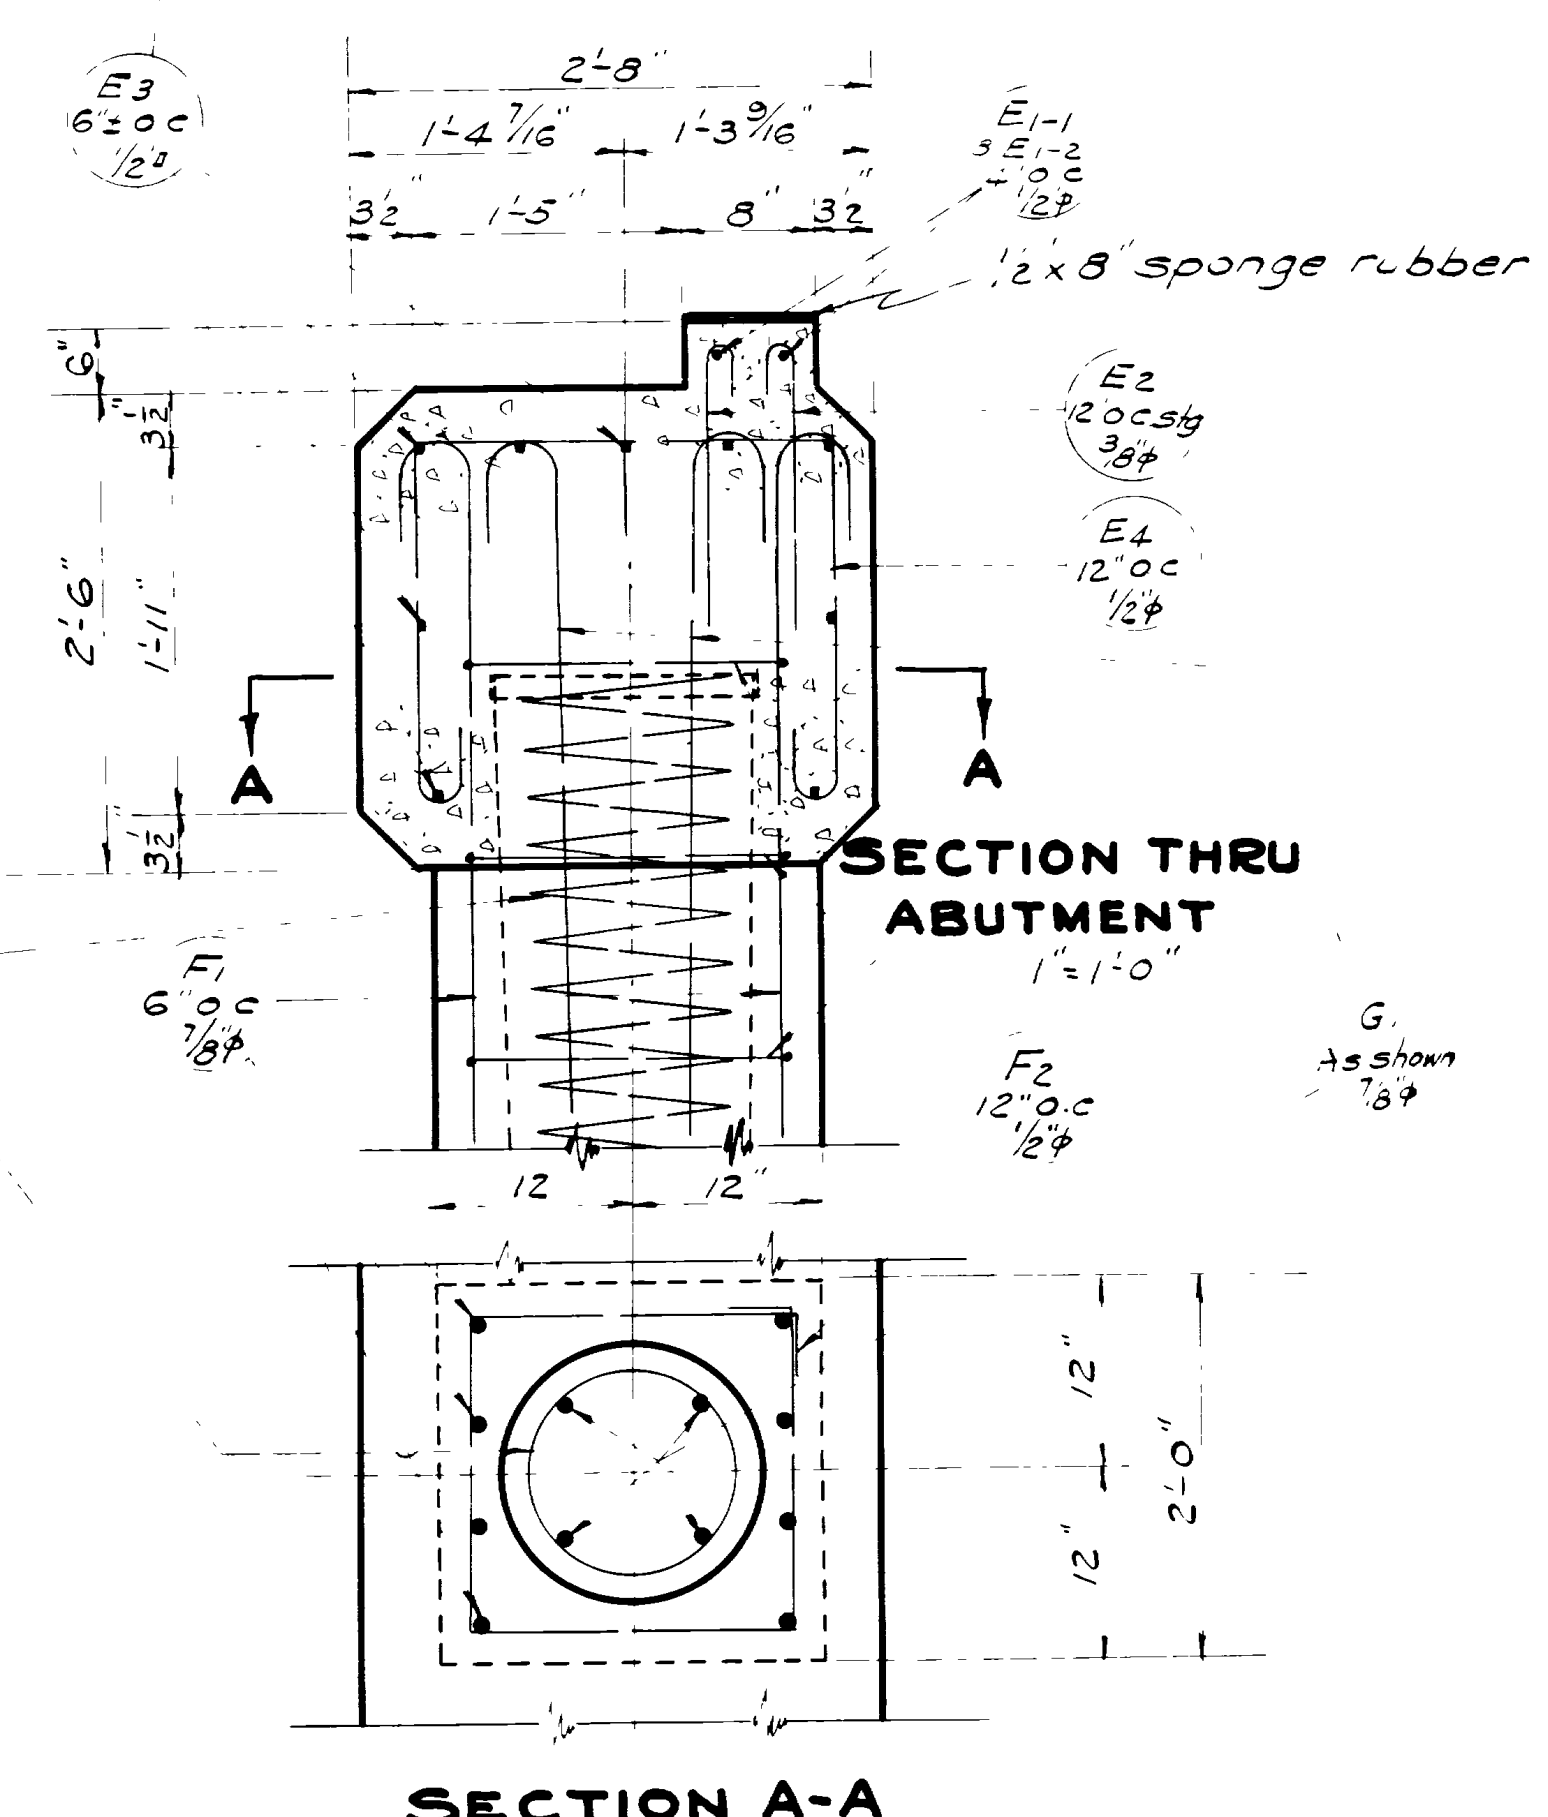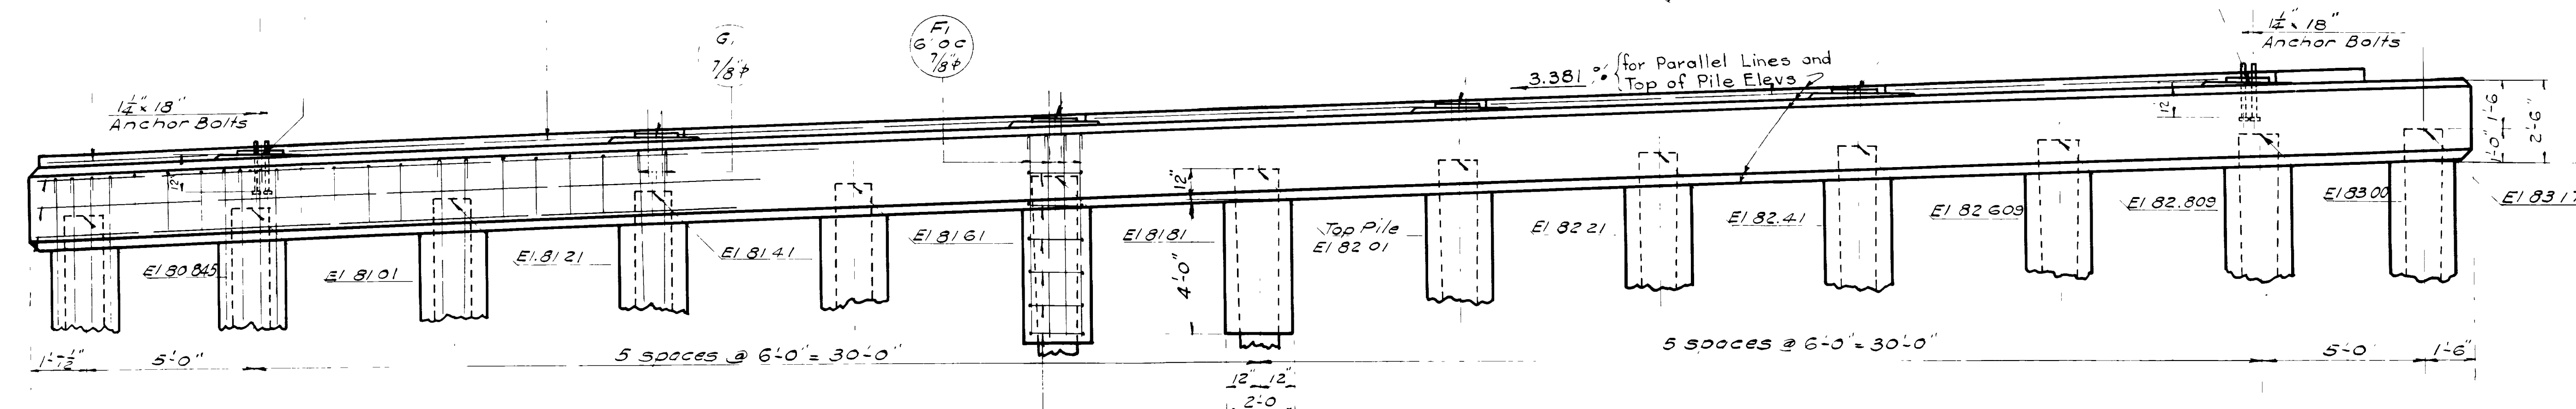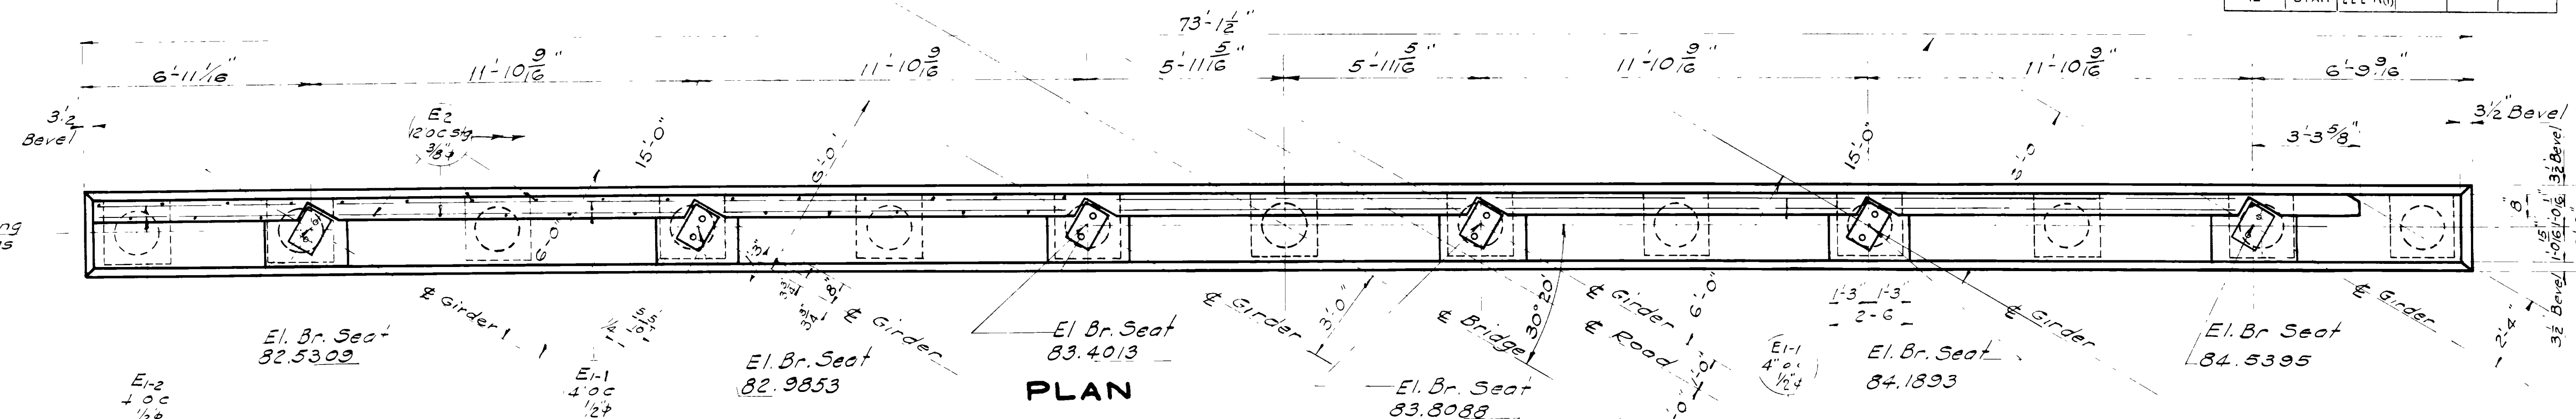

REVISIONS	DATE	BY



Sheet #8 of 15 Sheets

UTAH STATE ROAD COMMISSION
SALT LAKE CITY, UTAH
EXTRA CLASSIFICATION CIVIL ENGINEER



STEEL DECK GIRDER BRIDGE
84'-6 3/8" O to 0 149' 40" XING ANGLE
WEBER DAVIS CANAL
Sta 27+46 AW FAP 222 A(1)
Riverdale Arsenal-Davis Co.

DESIGNED BY: K.W.T. As Noted
DRAWN BY: D.M.S. July 24, 1941
CHECKED BY: [Signature]

NO. 6-259-1-1 C-215

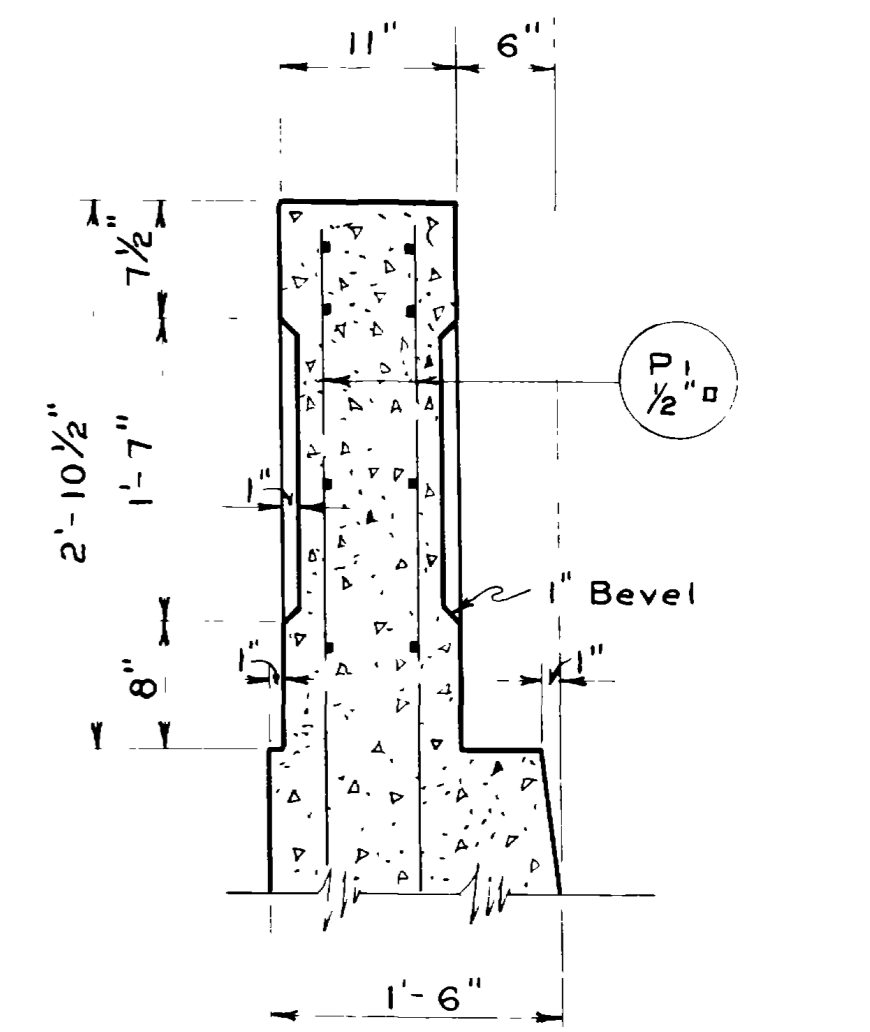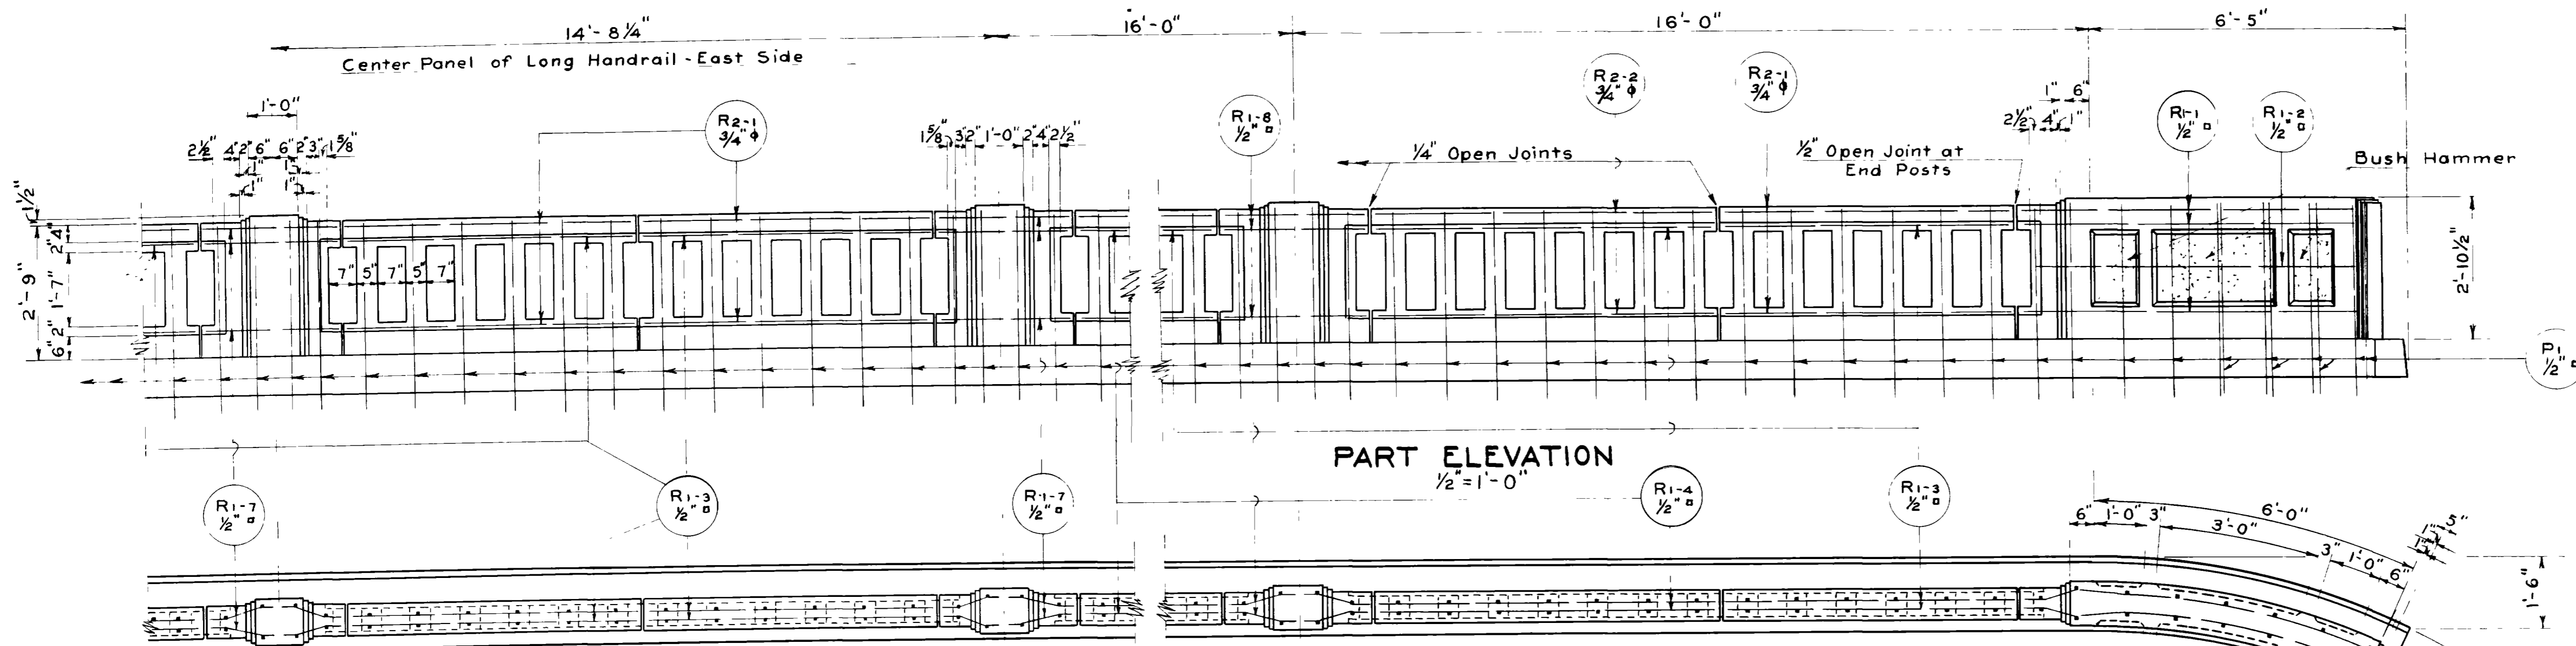


SECTION THRU END POST
1" = 1'-0"

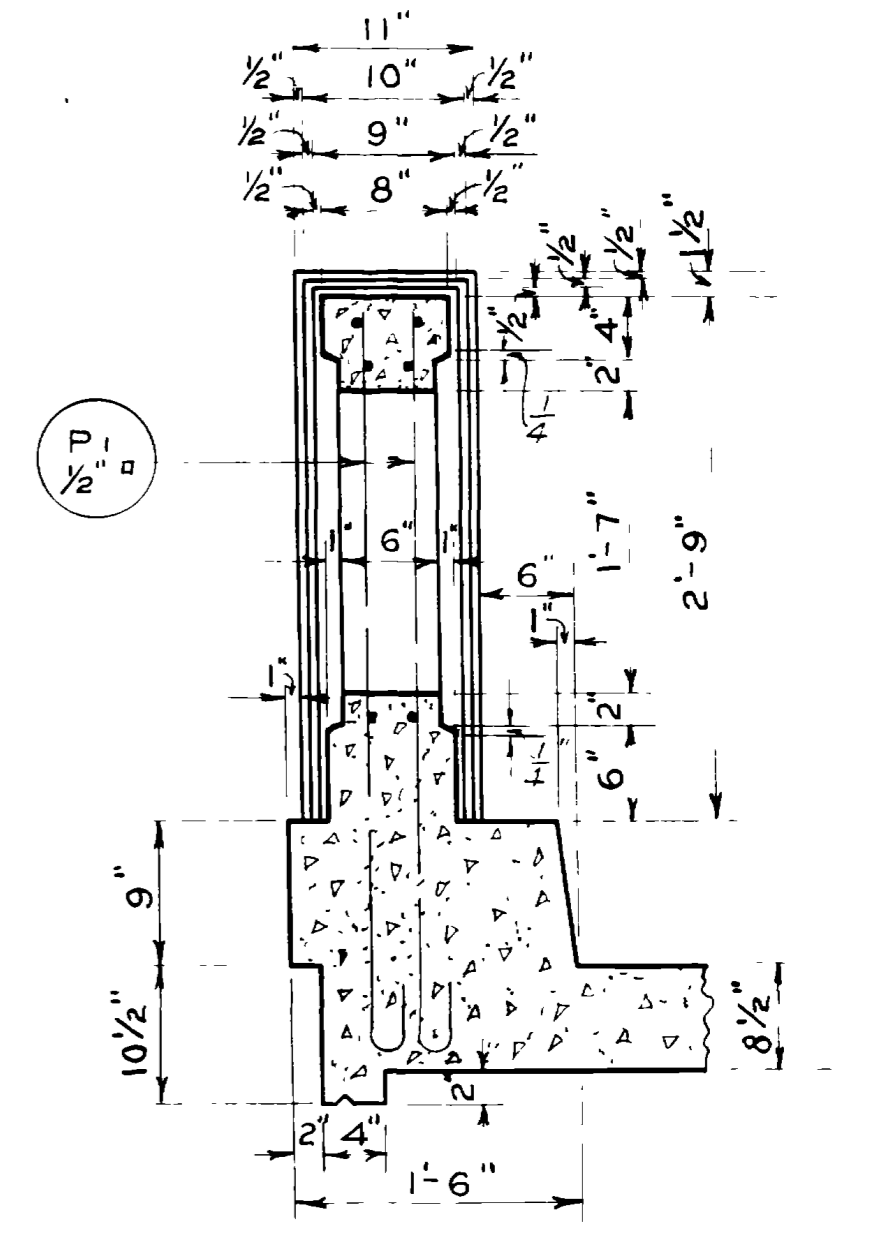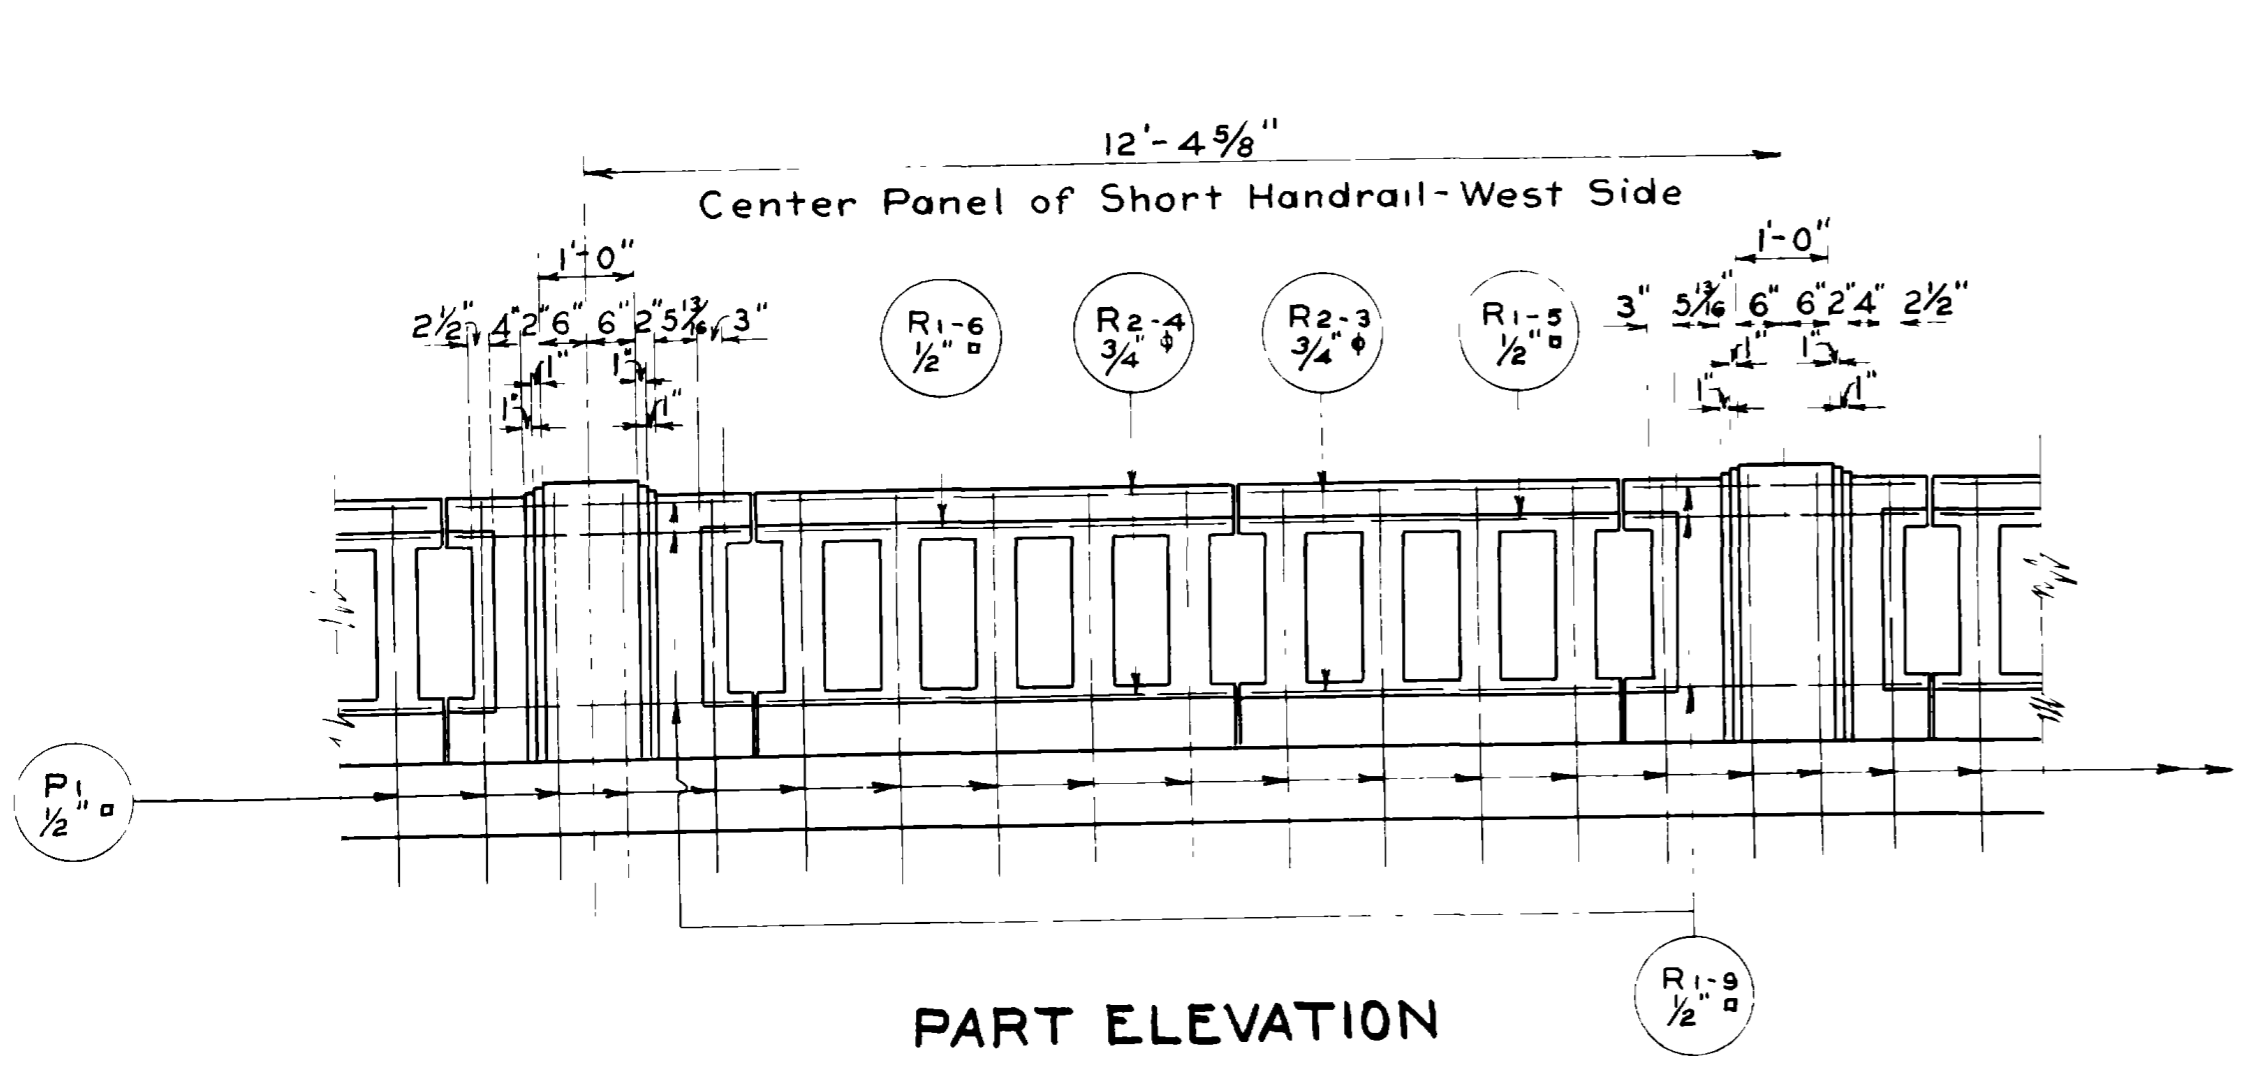


SECTION THRU RAILING
1" = 1'-0"


Note: Handrails Similar Except for Center Panels

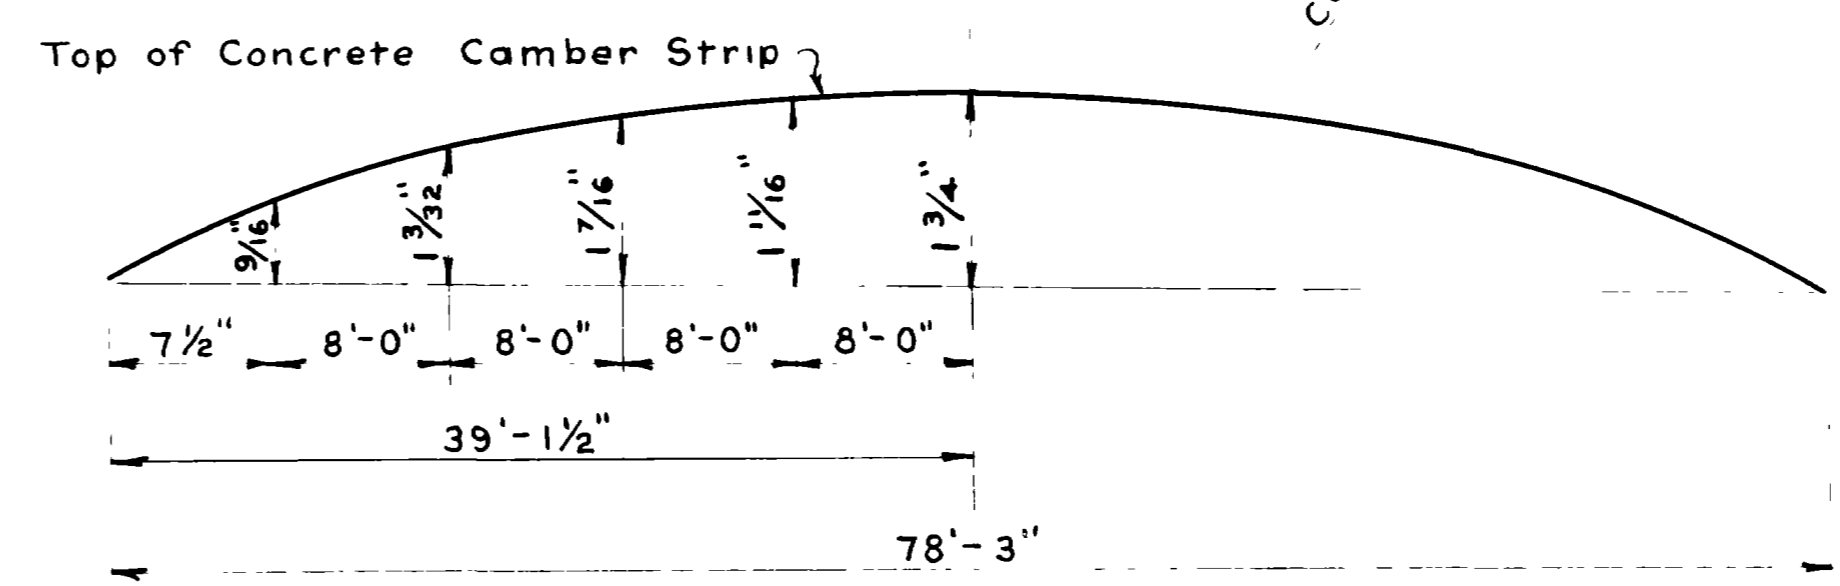

DEAD LOAD CAMBER DIAGRAM FOR BEAMS
No Scale

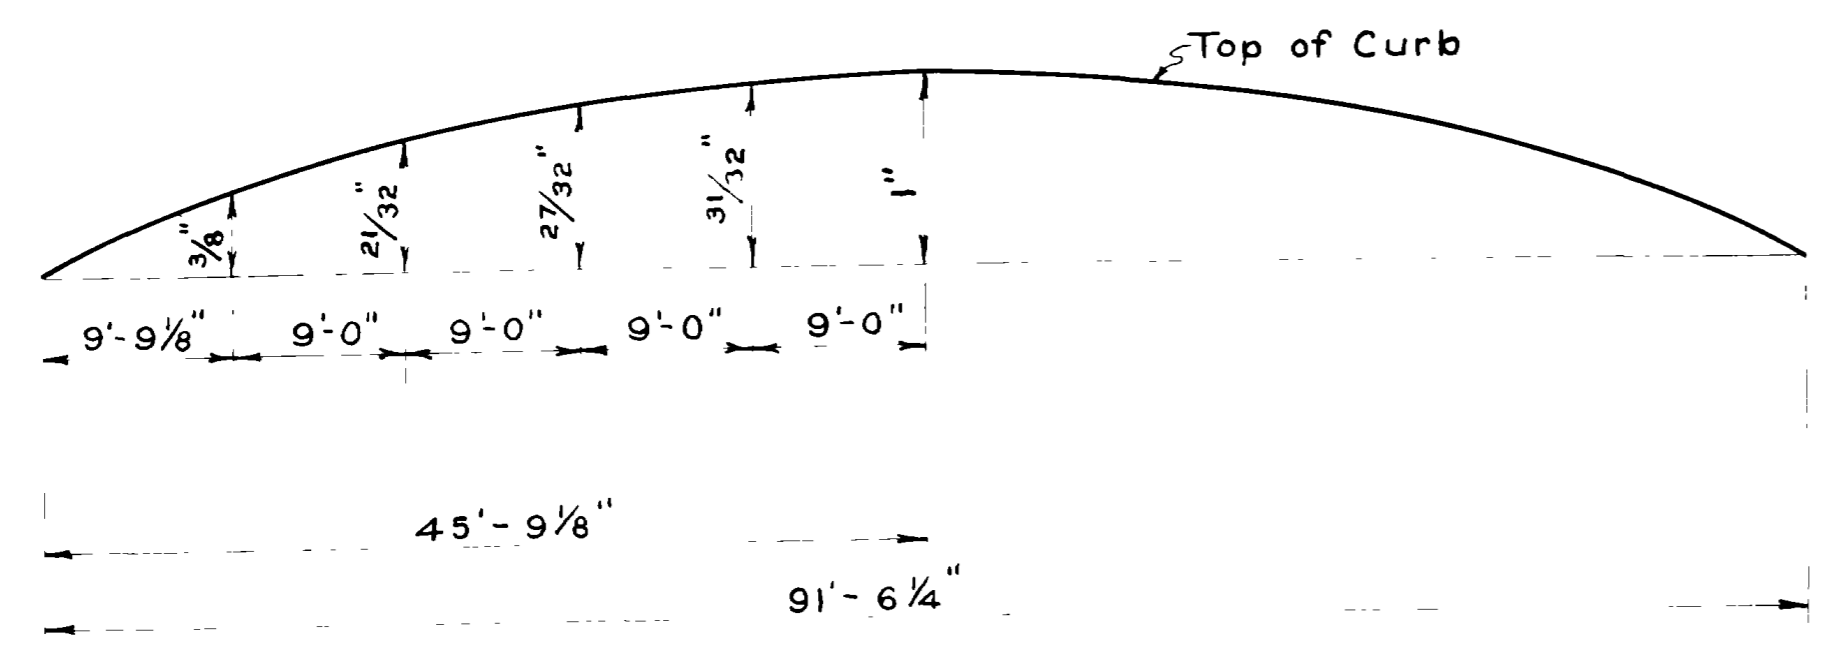


LONG HANDRAIL
EAST SIDE

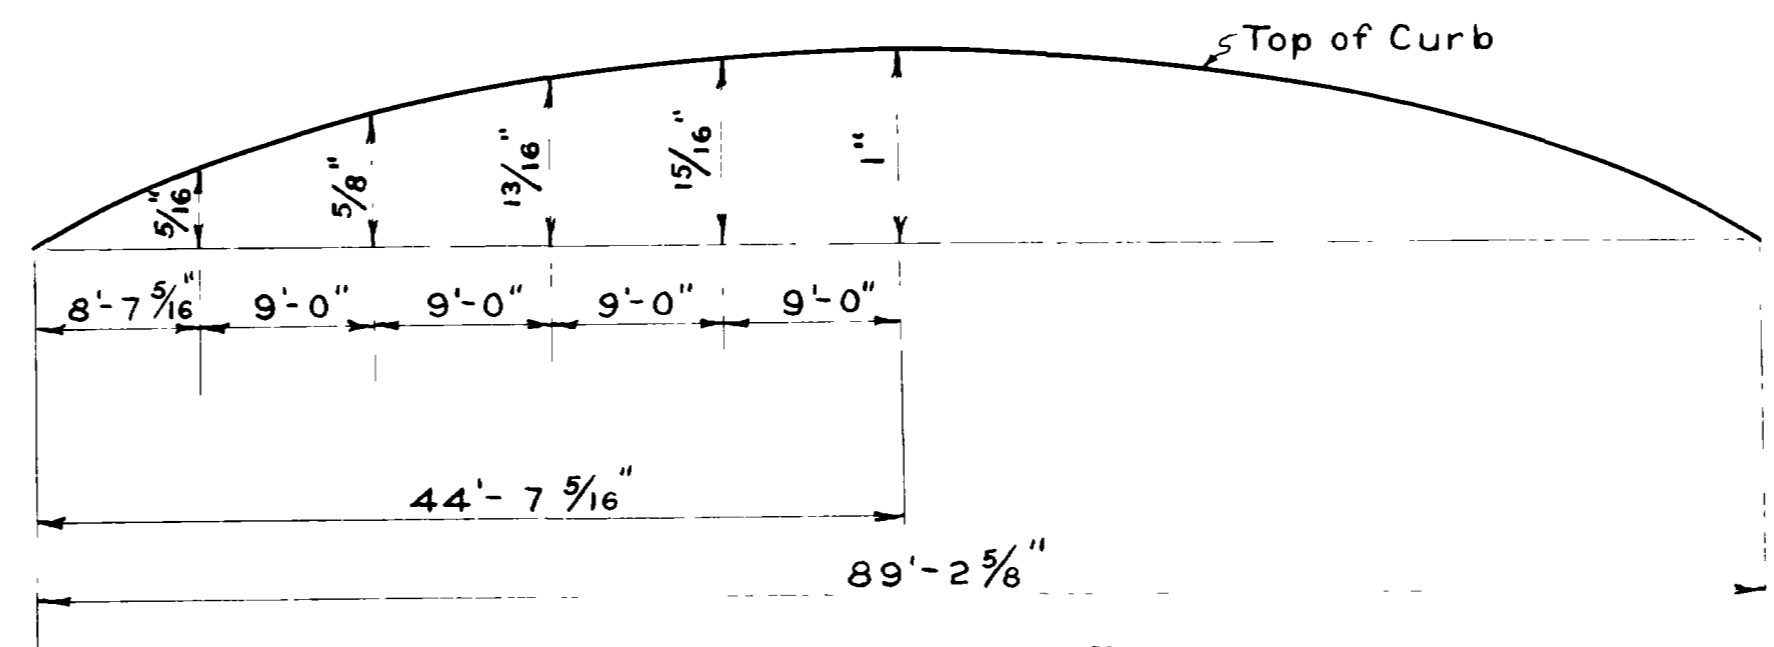


SHORT HANDRAIL
WEST SIDE

CAMBER DIAGRAM - HANDRAILS
No Scale


FED. ROAD DIST. NO.	STATE	A.W.F.A. PROJ. NO.	FISCAL YEAR	SHEET NO.	TOTAL SHEETS
12	UTAH	222 A(1)			

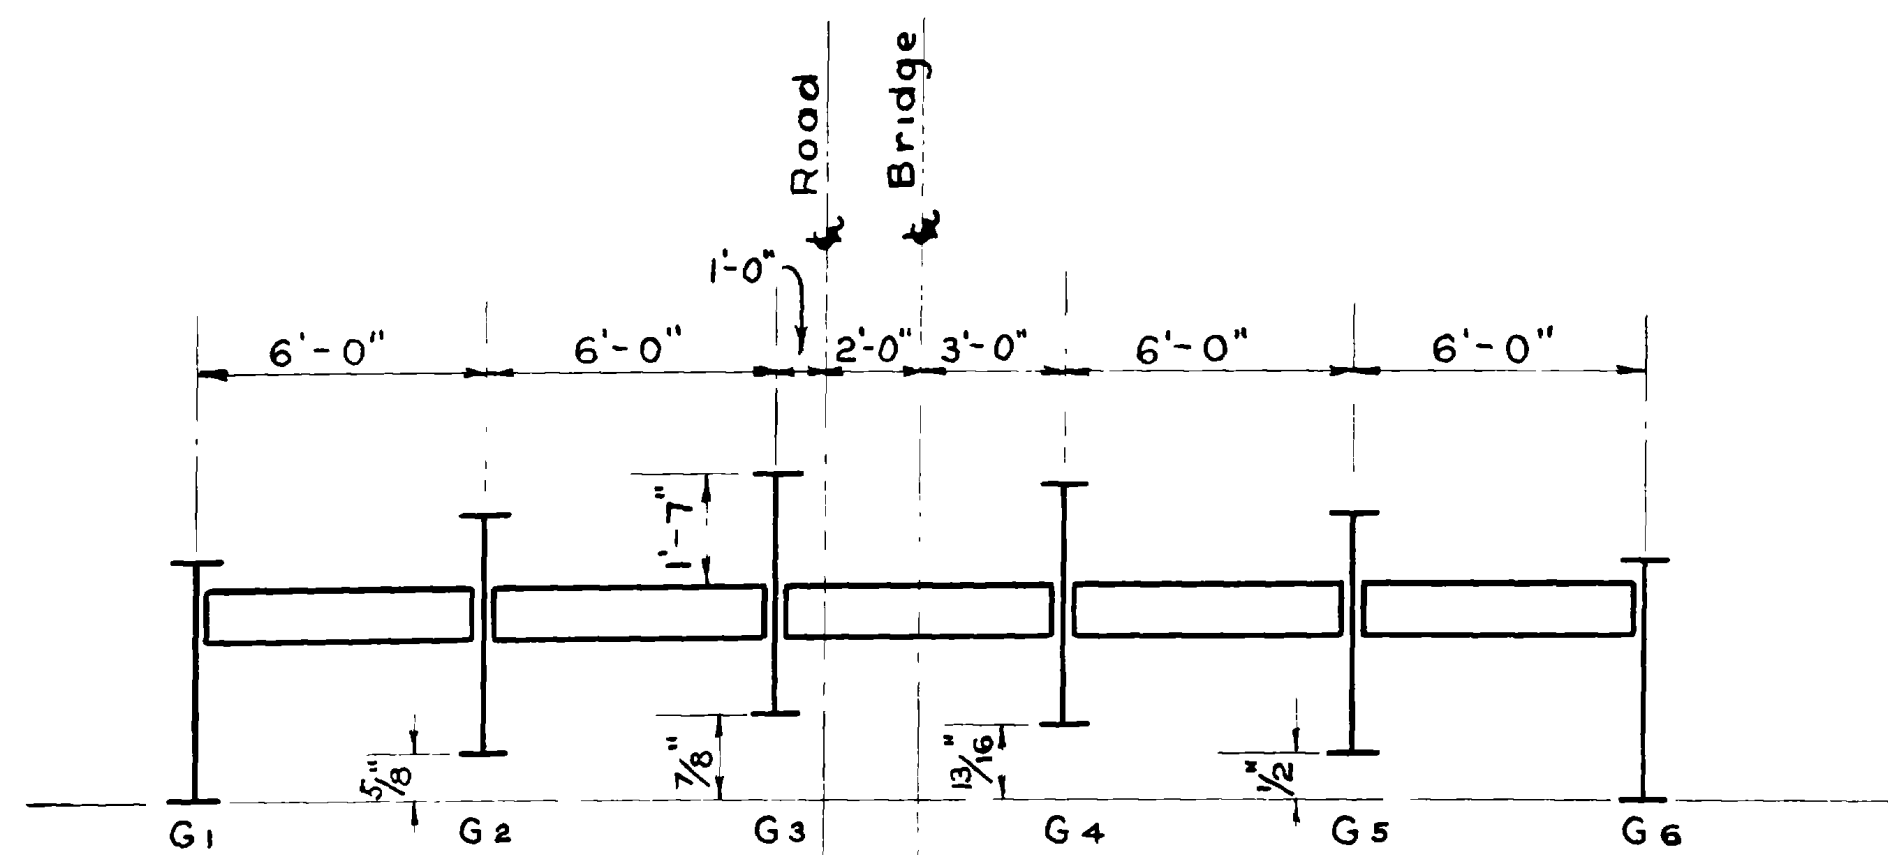


SECTION THRU GIRDERS AT "A-A"
No Scale

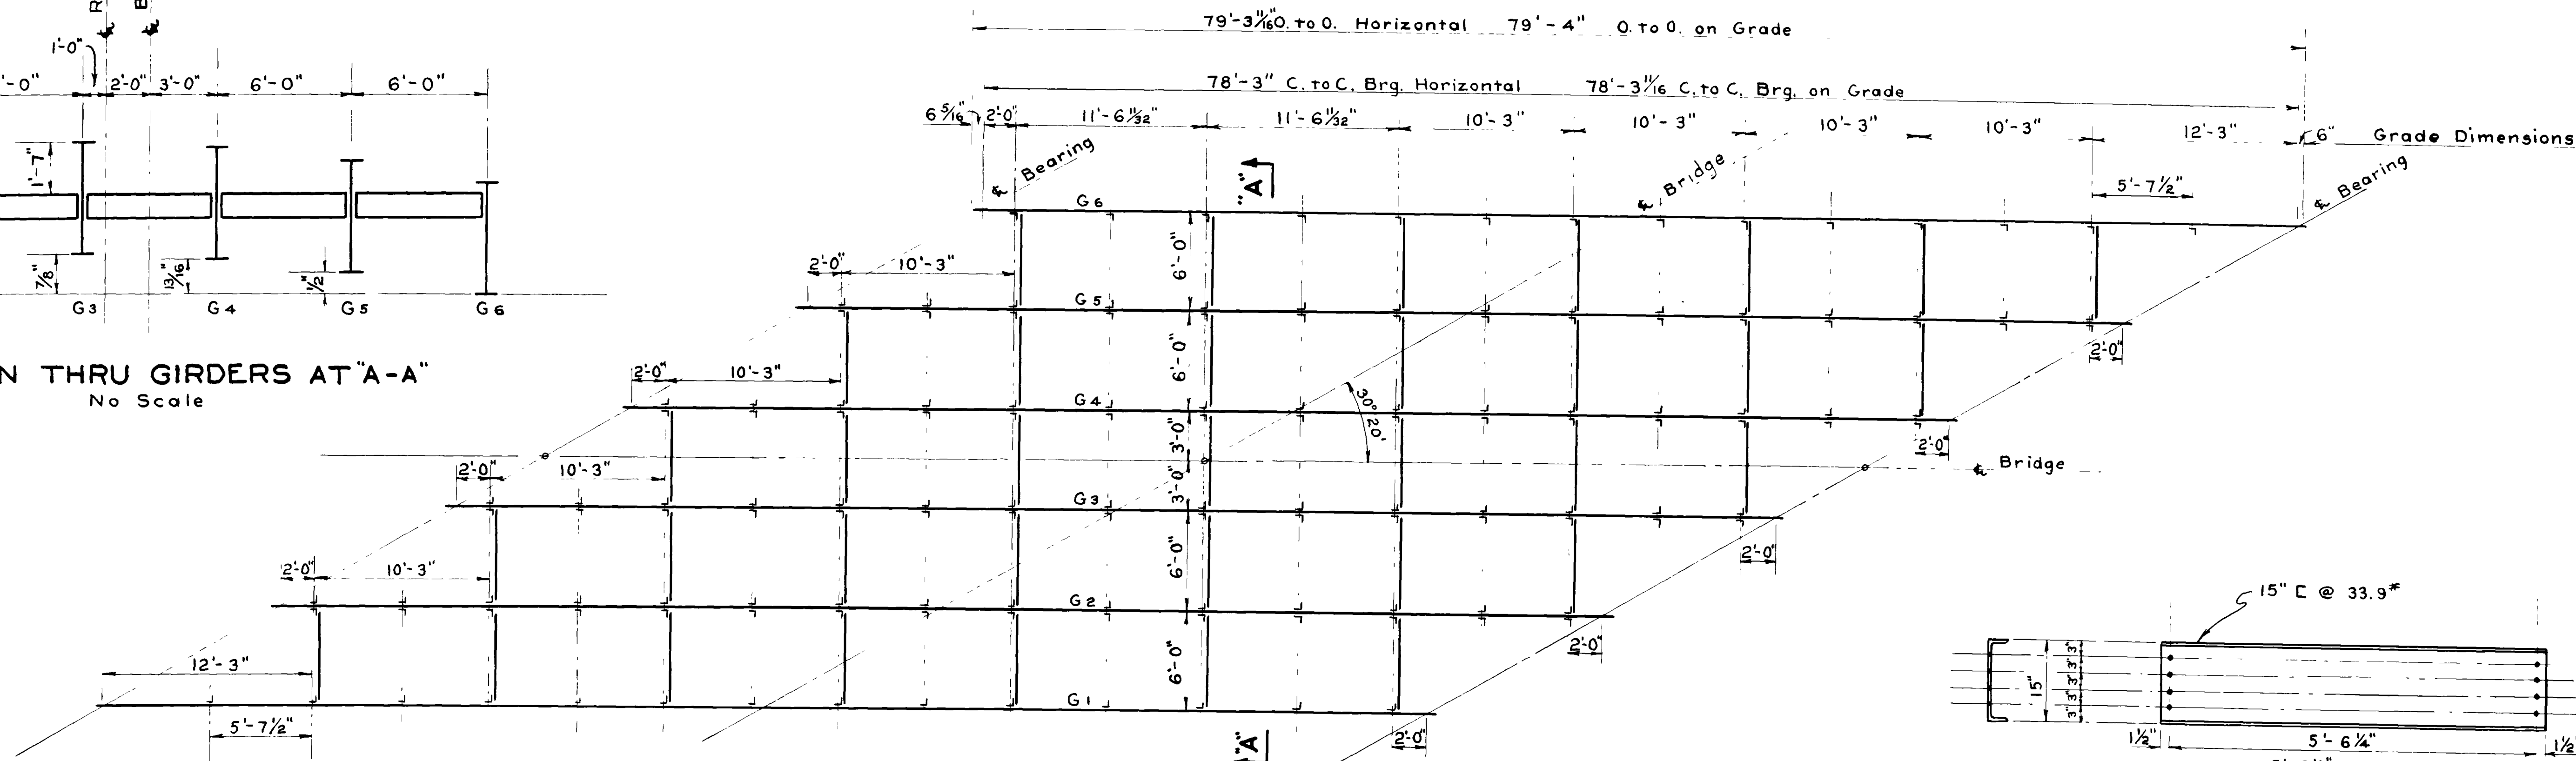

FRAMING DETAIL
 $\frac{3}{16}'' = 1'' - 0''$

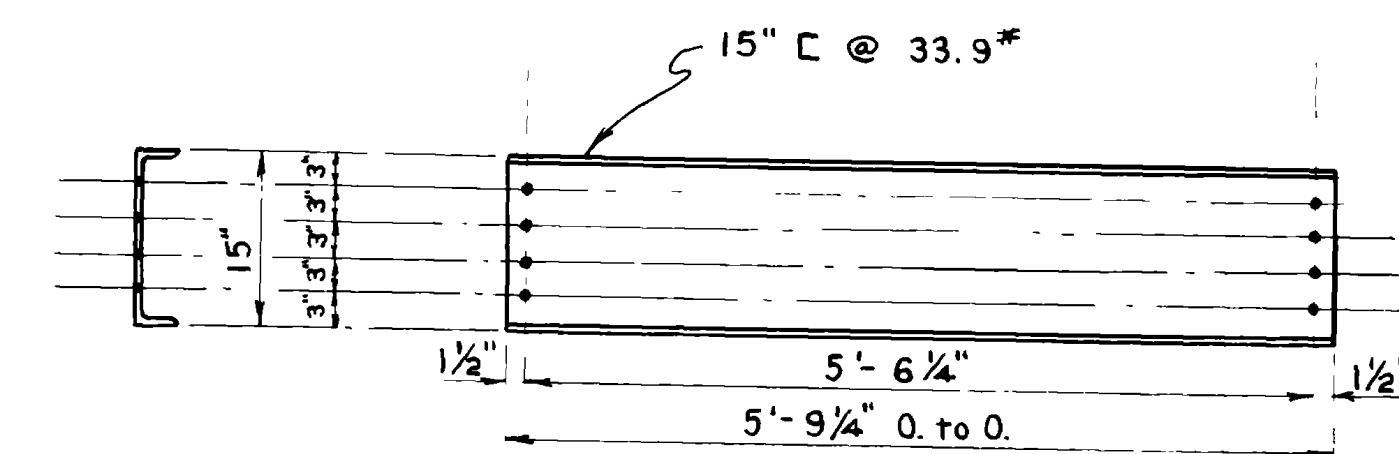


DETAIL DIAPHRAGM
 $\frac{3}{4}'' = 1'' - 0''$

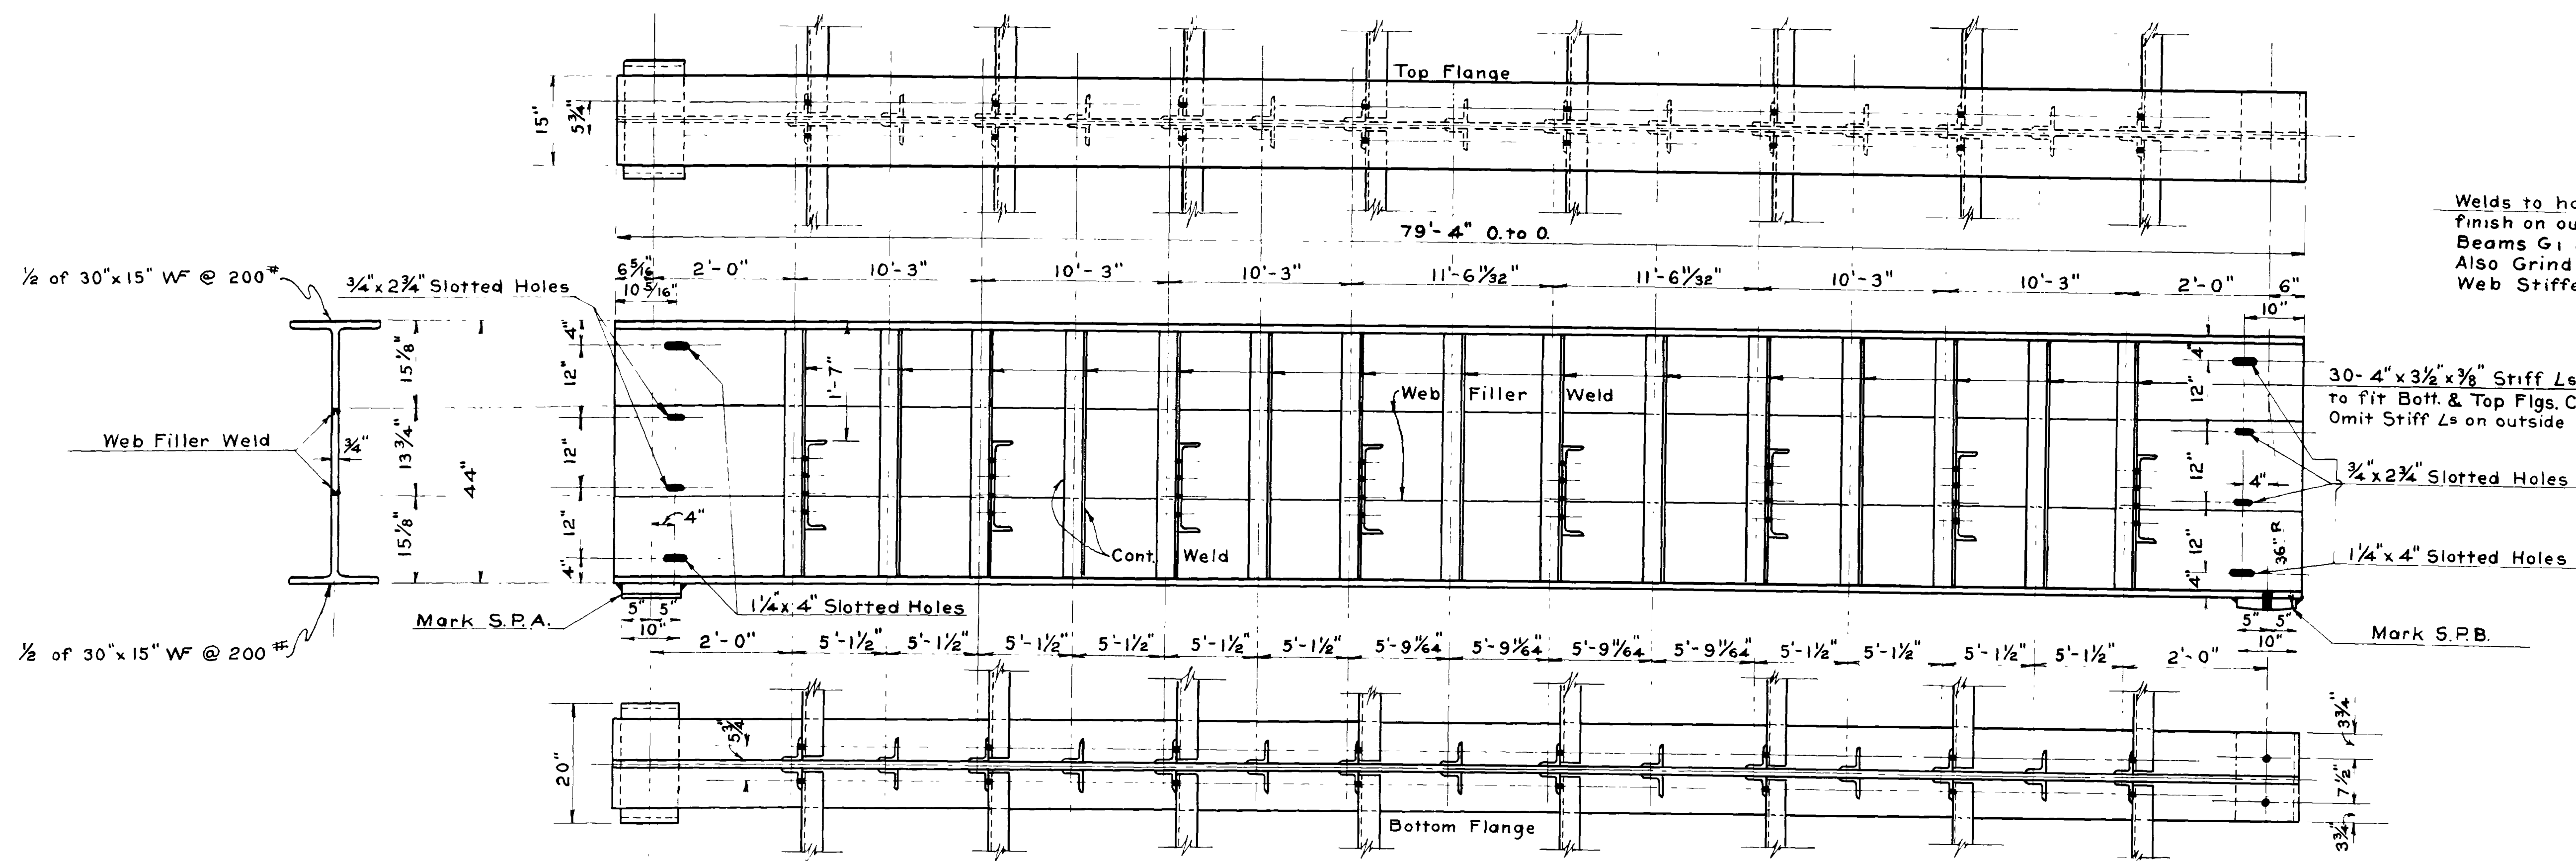

DETAIL OF GIRDER G3, OTHERS SIMILAR
No Scale



Welds to have Smooth finish on outside face of Beams G1 & G6. Also Grind flush at Web Stiffeners

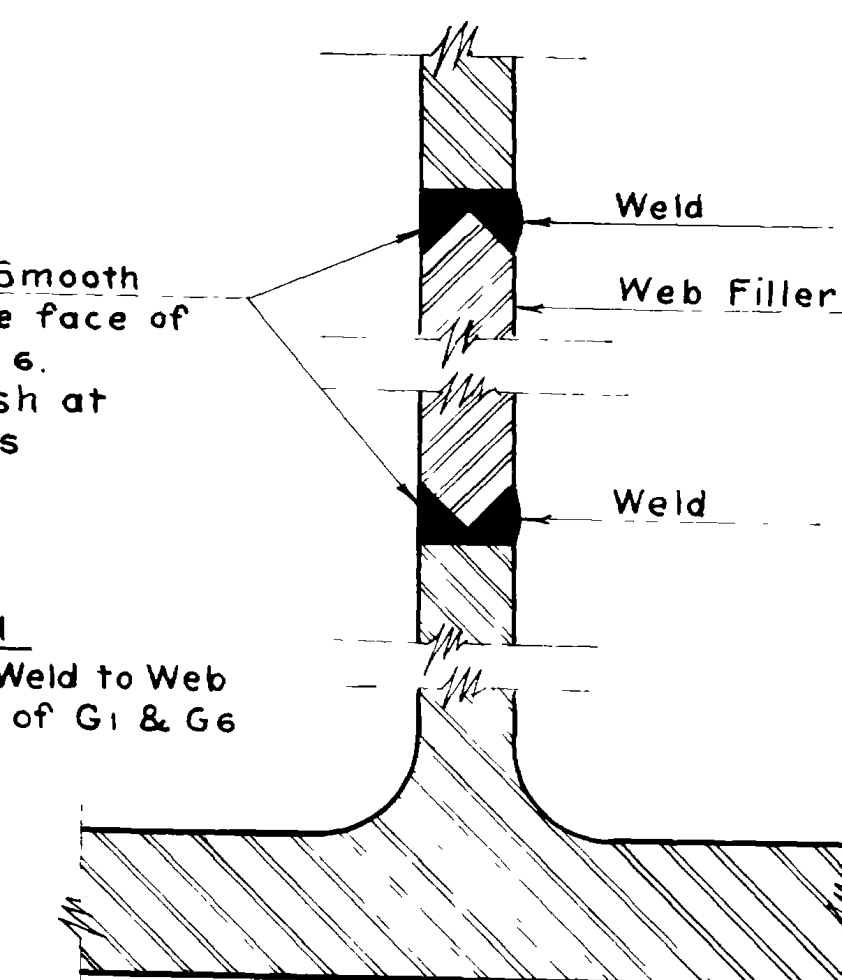







TYPICAL WELDING DETAIL FOR WEB FILLER
No Scale

Sheet # 10 of 15 Sheets
UTAH STATE ROAD COMMISSION
SALT LAKE CITY, UTAH
Ezra C. Knowlton, Chief Engineer
STEEL DECK GIRDER BRIDGE
84'-6 3/8" 0 to 0-149' 40" X-ING ANGLE
WEBER-DAVIS CANAL
Sta. 27+46 A.W.F.A. 222 A(1)
Riverdale Arsenal - Davis Co.
DESIGNED BY K.W.T. SCALE AS NOTED
DRAWN BY R.W.M. SCALE AS NOTED
CHECKED BY [Signature] APPROVED [Signature]
EXAMINED BY [Signature]
BR No 6-259-1-1 DRG No C-215

REVISIONS	DATE	BY

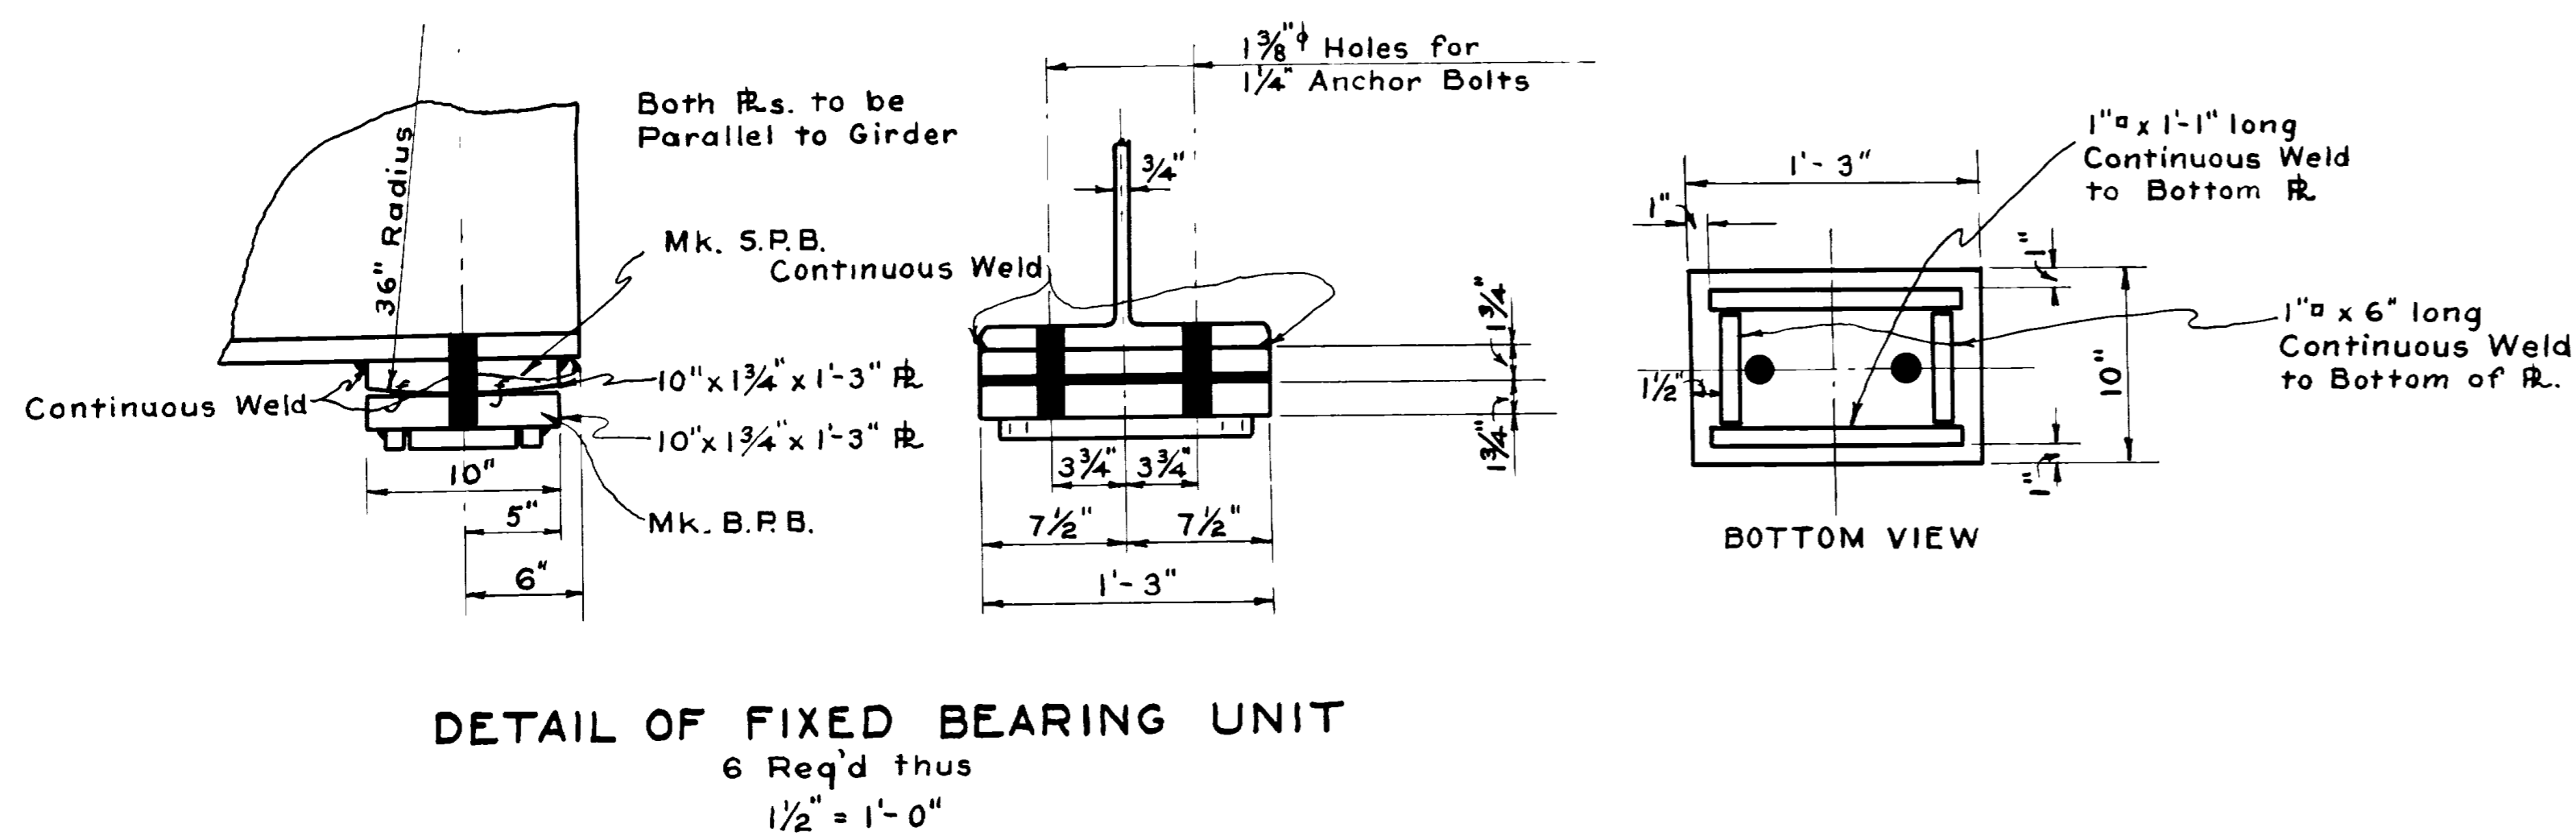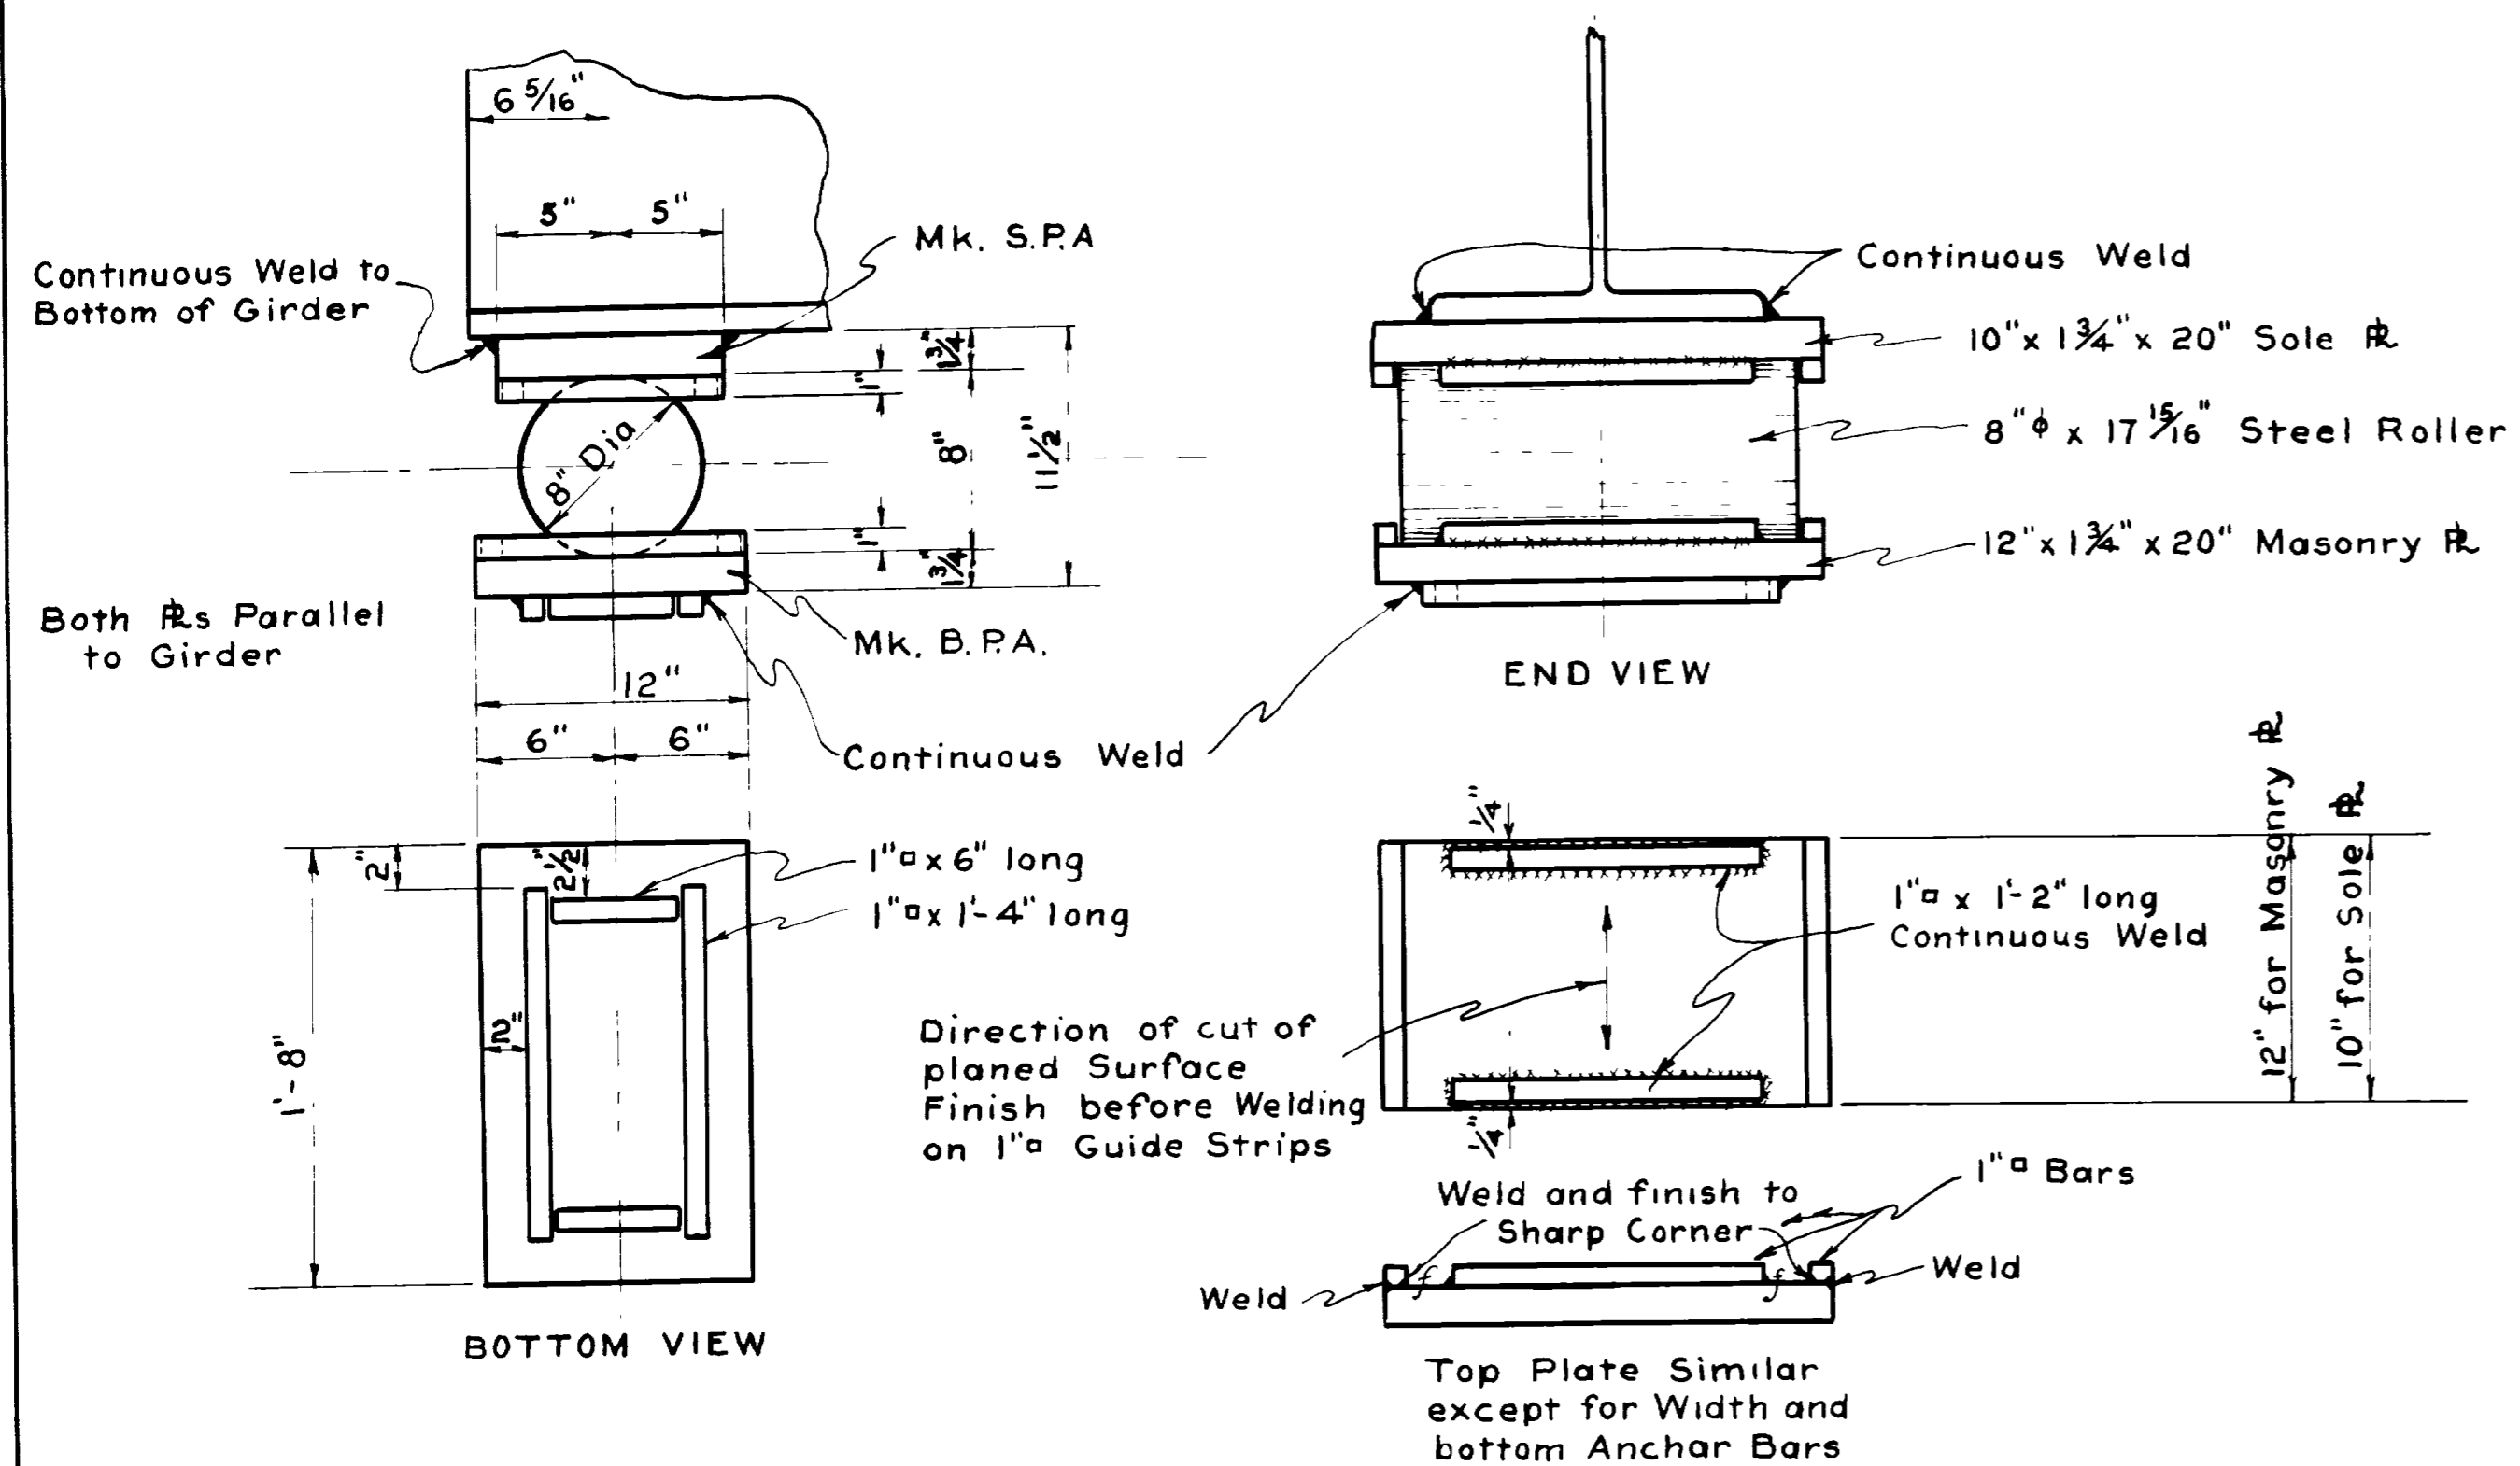

FED. ROAD DIST. NO.	STATE	AWFAP PROJ. NO.	FISCAL YEAR	SHEET NO.	TOTAL SHEETS
12	UTAH	222-A(1)			

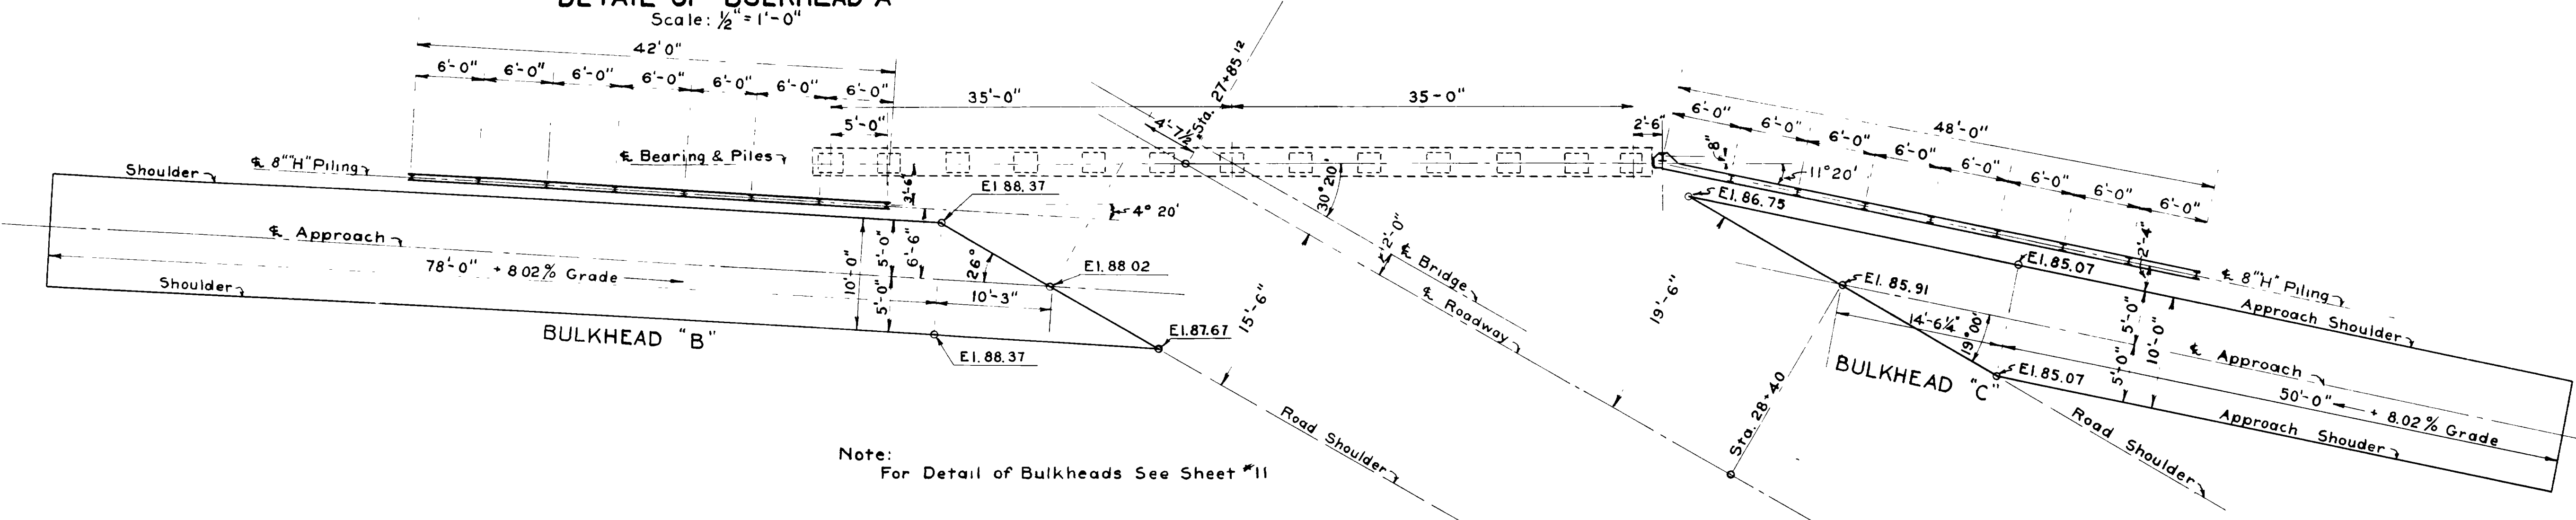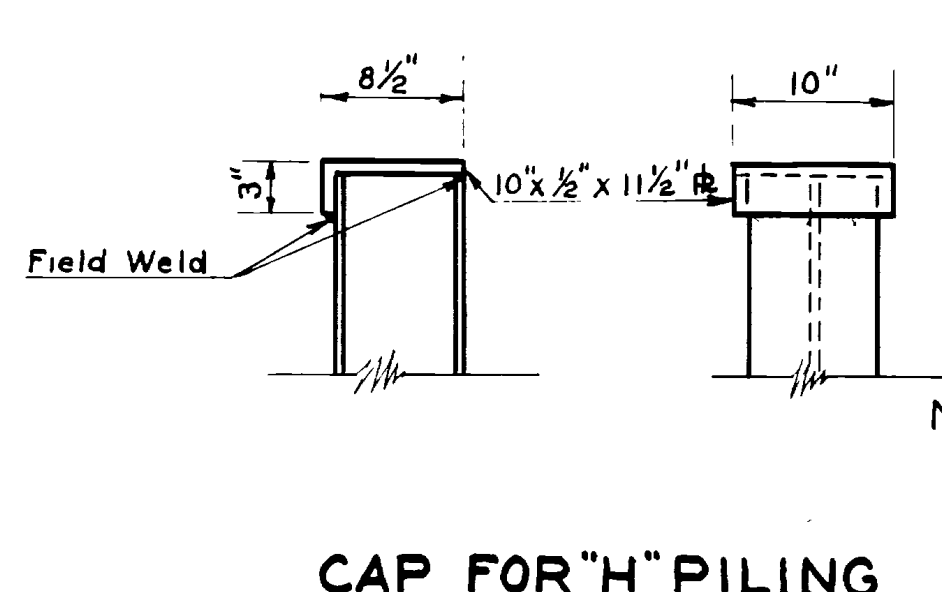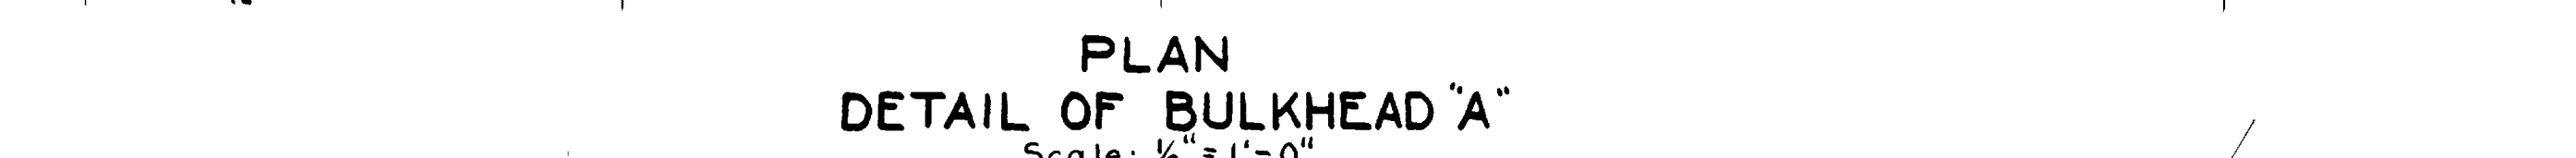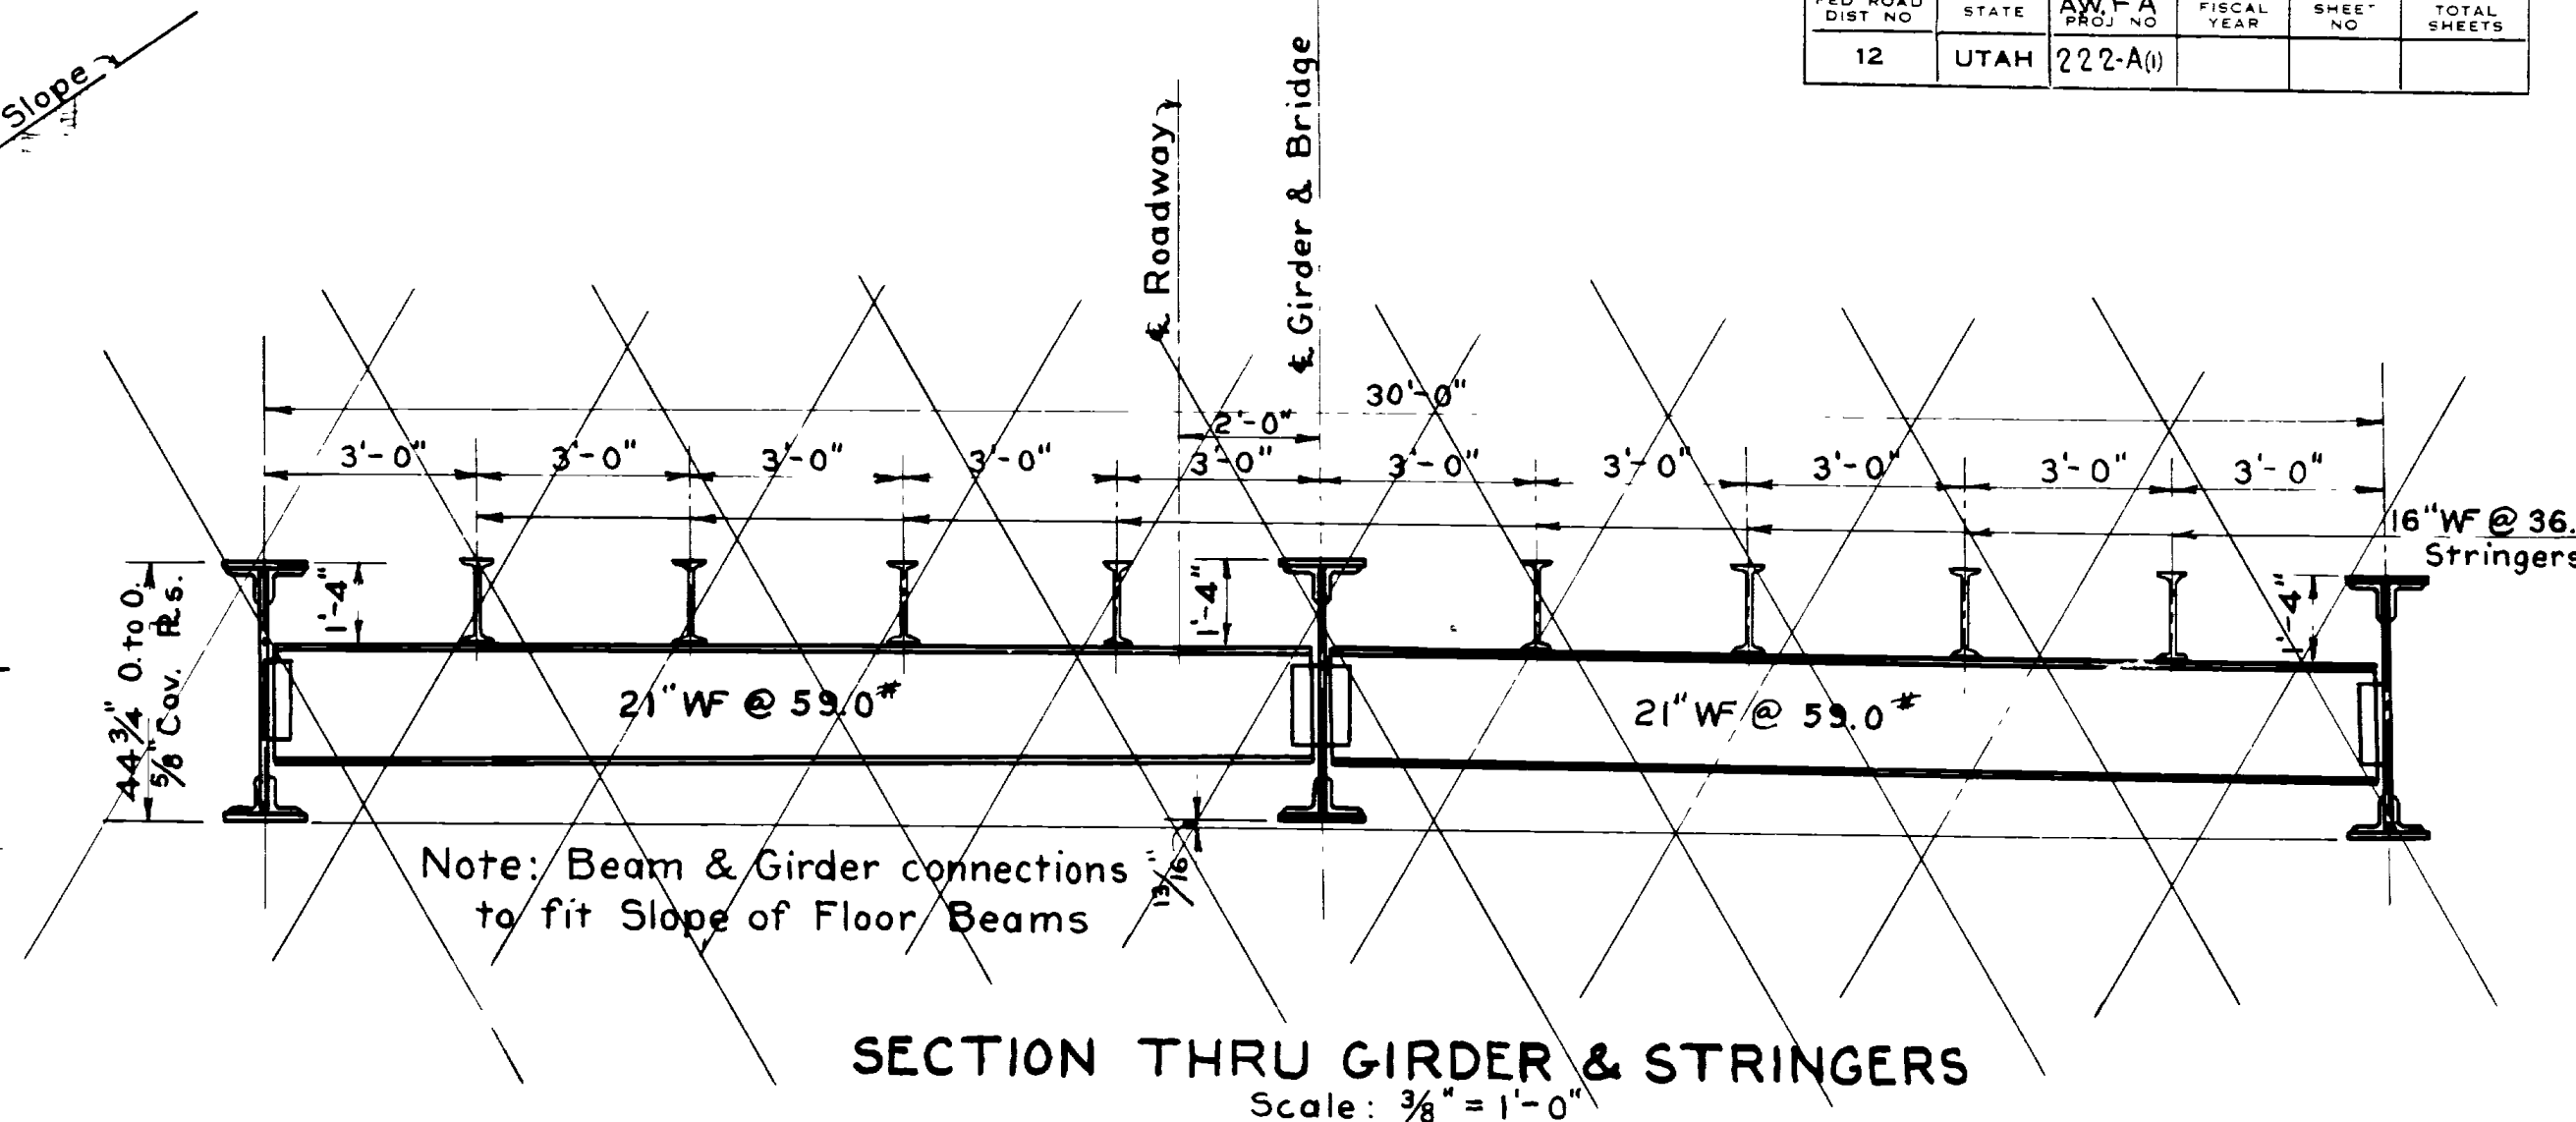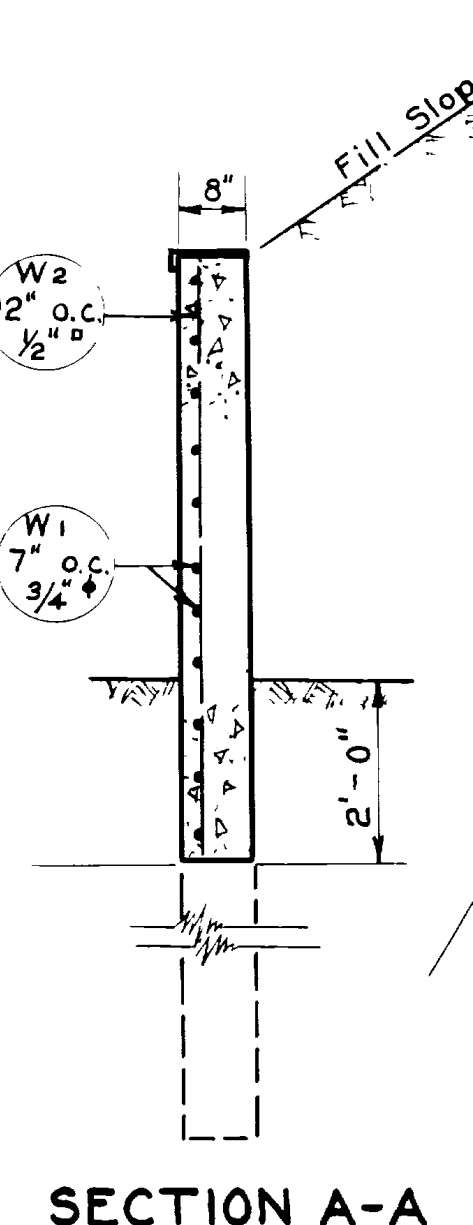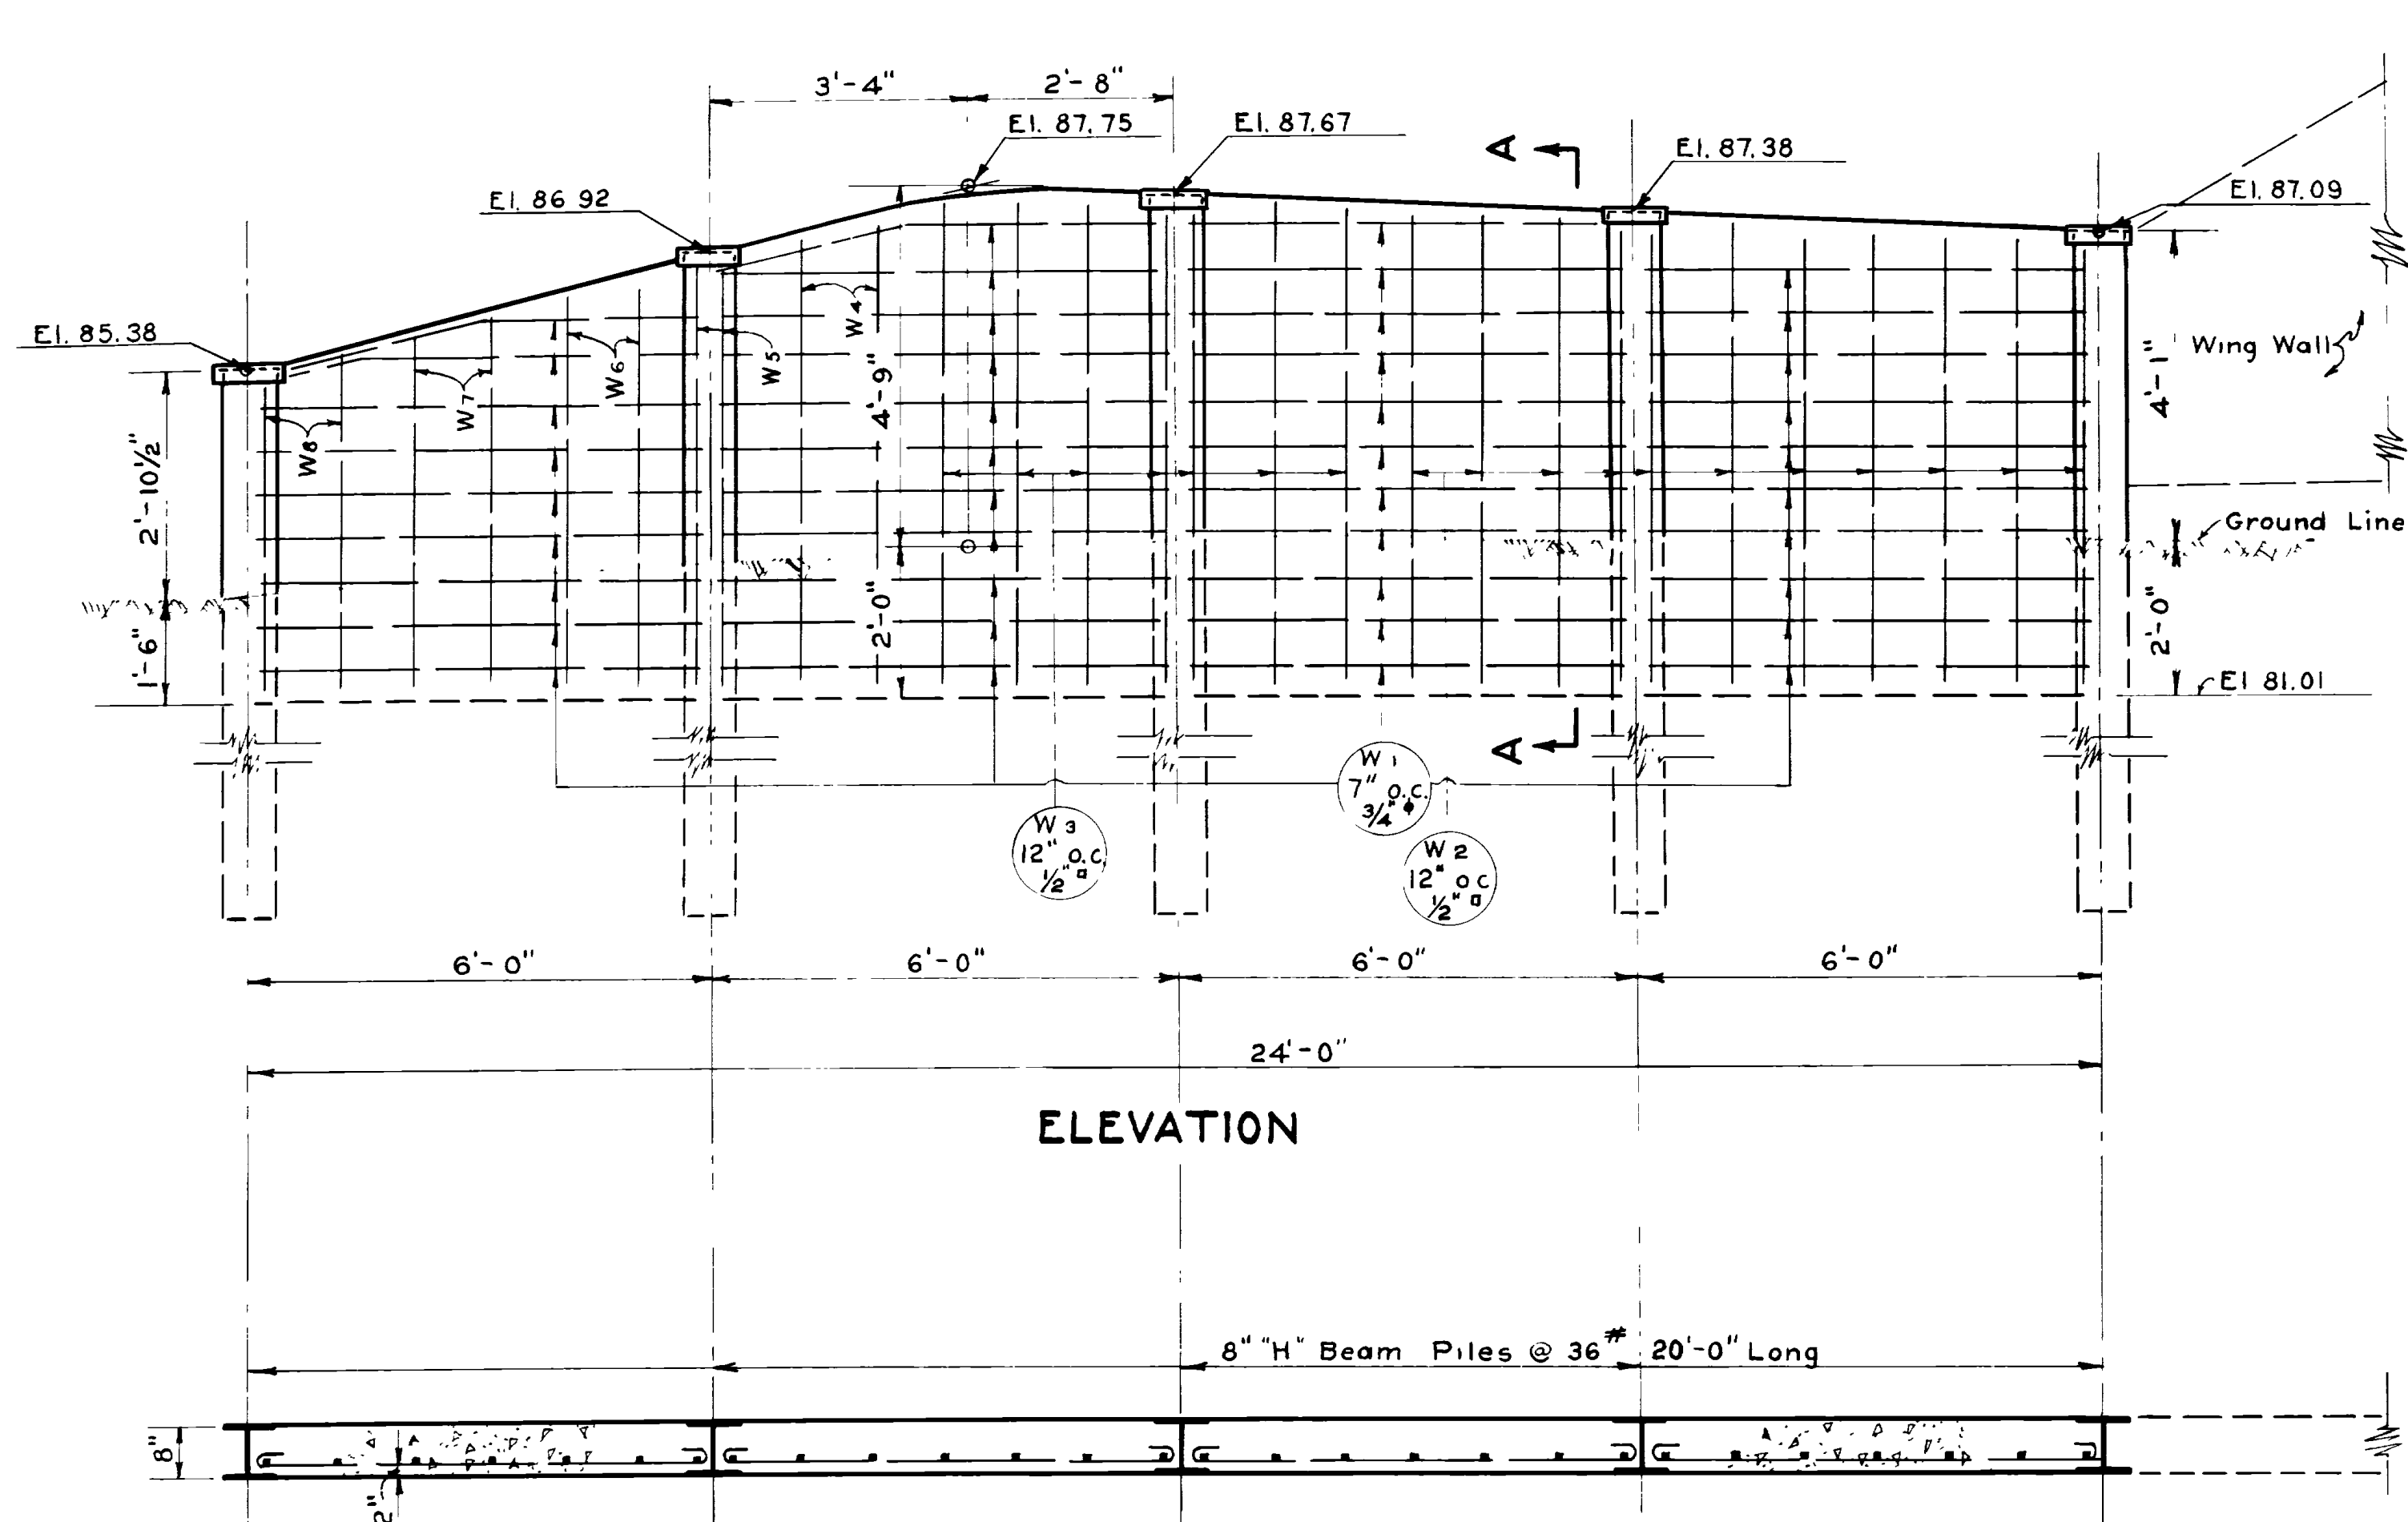


PLAN OF APPROACHES & BULKHEADS FOR CANAL WALKER
Scale: 1/8" = 1'-0"

REVISIONS	DATE	BY	NO.


Sheet #12 of 15 Sheets
 UTAH STATE ROAD COMMISSION
 SALT LAKE CITY, UTAH
 EZRA C. KNOWLTON, CHIEF ENGINEER
STEEL DECK GIRDER BRIDGE
 84'-6 3/8" O.T.O. - 149' 40" XING ANGLE
 WEBER-DAVIS CANAL
 Sta. 27+46 AWFAP 222 A(1)
 Riverdale Arsenal, Davis Co.
 DESIGNED BY: K.W.T.
 DRAWN BY: K.W.T.
 CHECKED BY: [Signature]
 No. 6-259-1-1 C-215

FED. ROAD DIST. NO.	STATE	A.W.F.A. PROJ. NO.	FISCAL YEAR	SHEET NO.	TOTAL SHEETS
12	UTAH	222-A(1)			

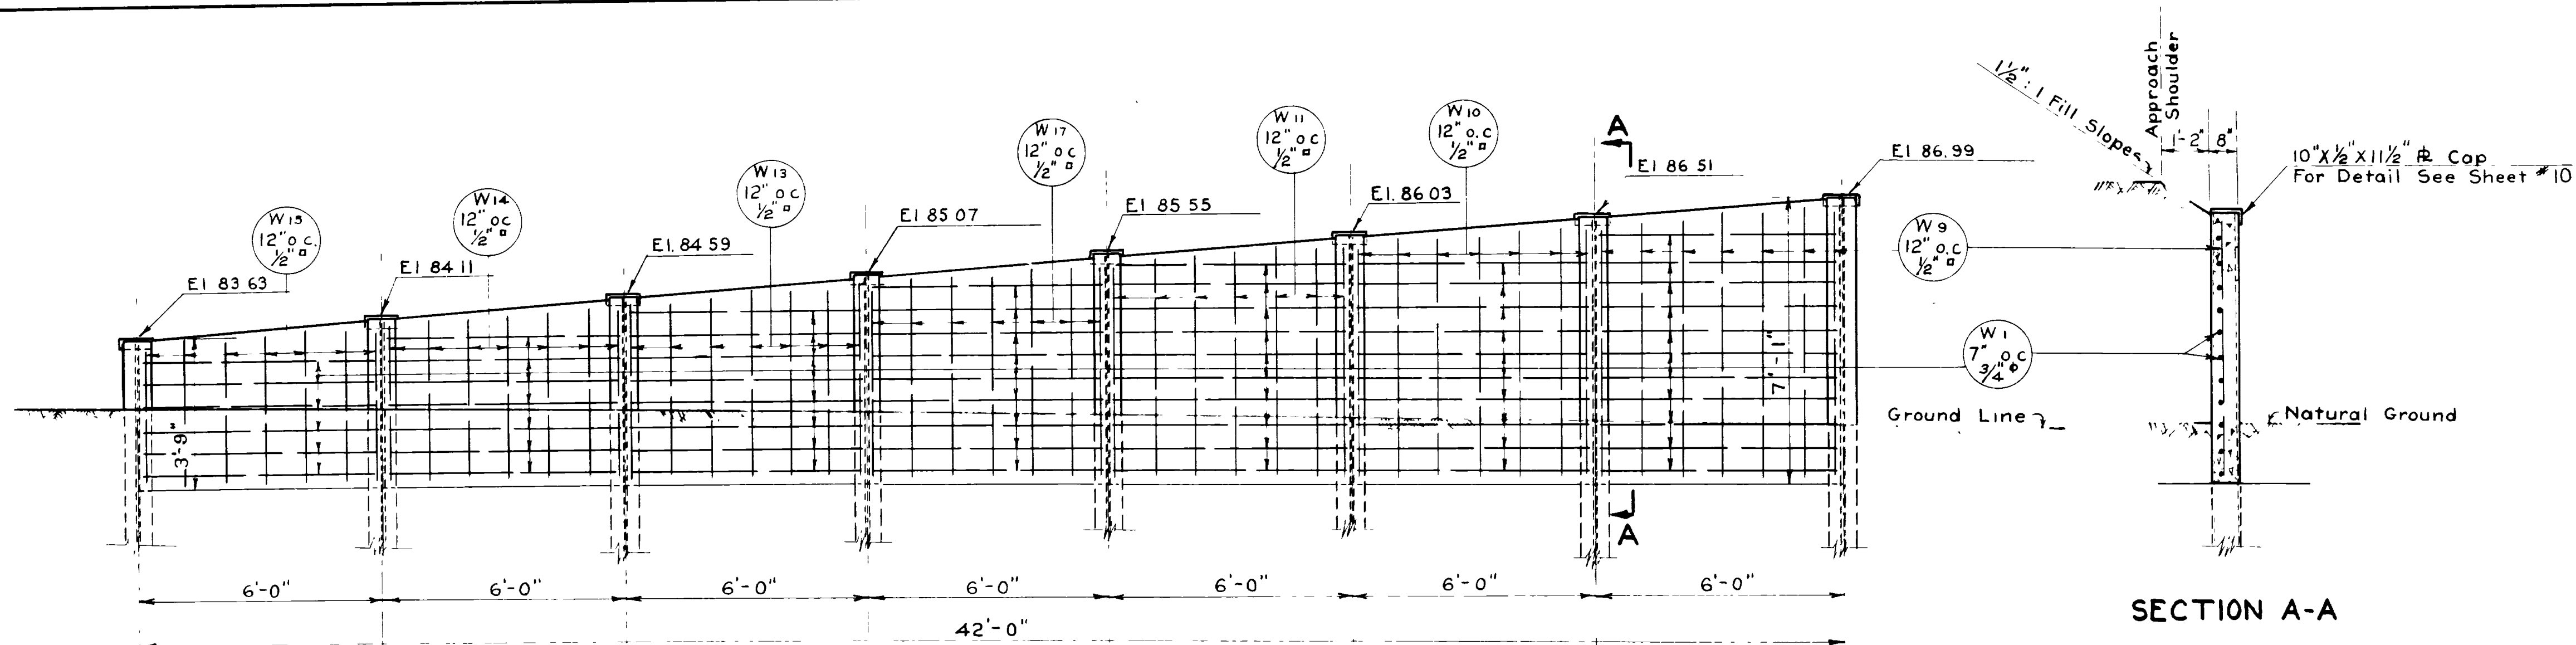


ELEVATION

SECTION A-A

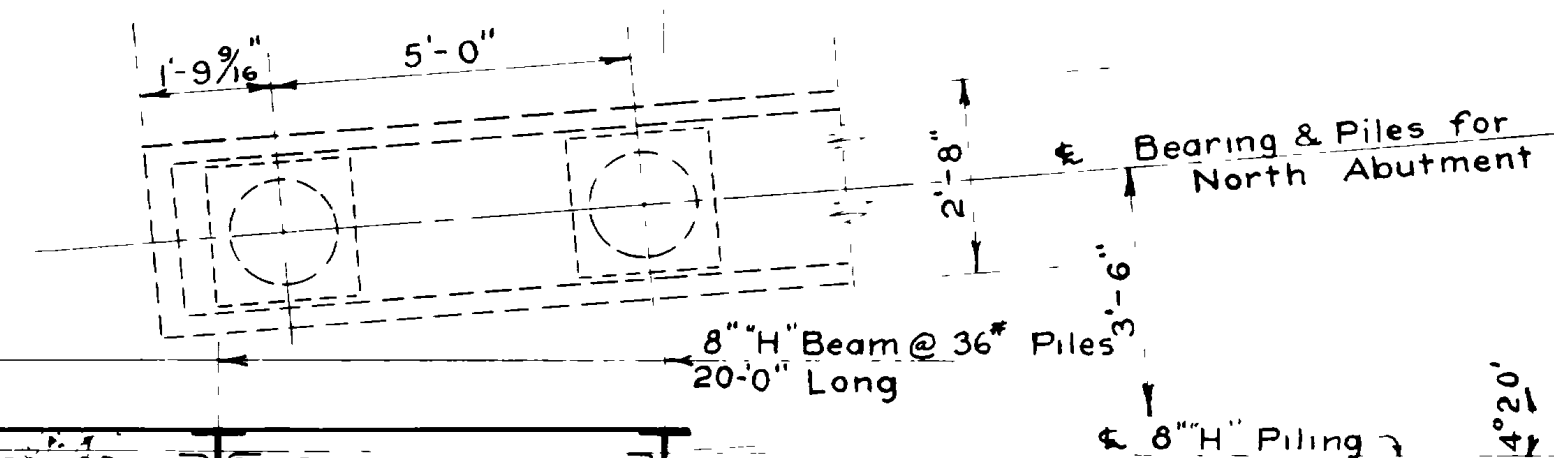


PLAN
DETAIL OF BULKHEAD "B"
Scale: 3/8" = 1'-0"

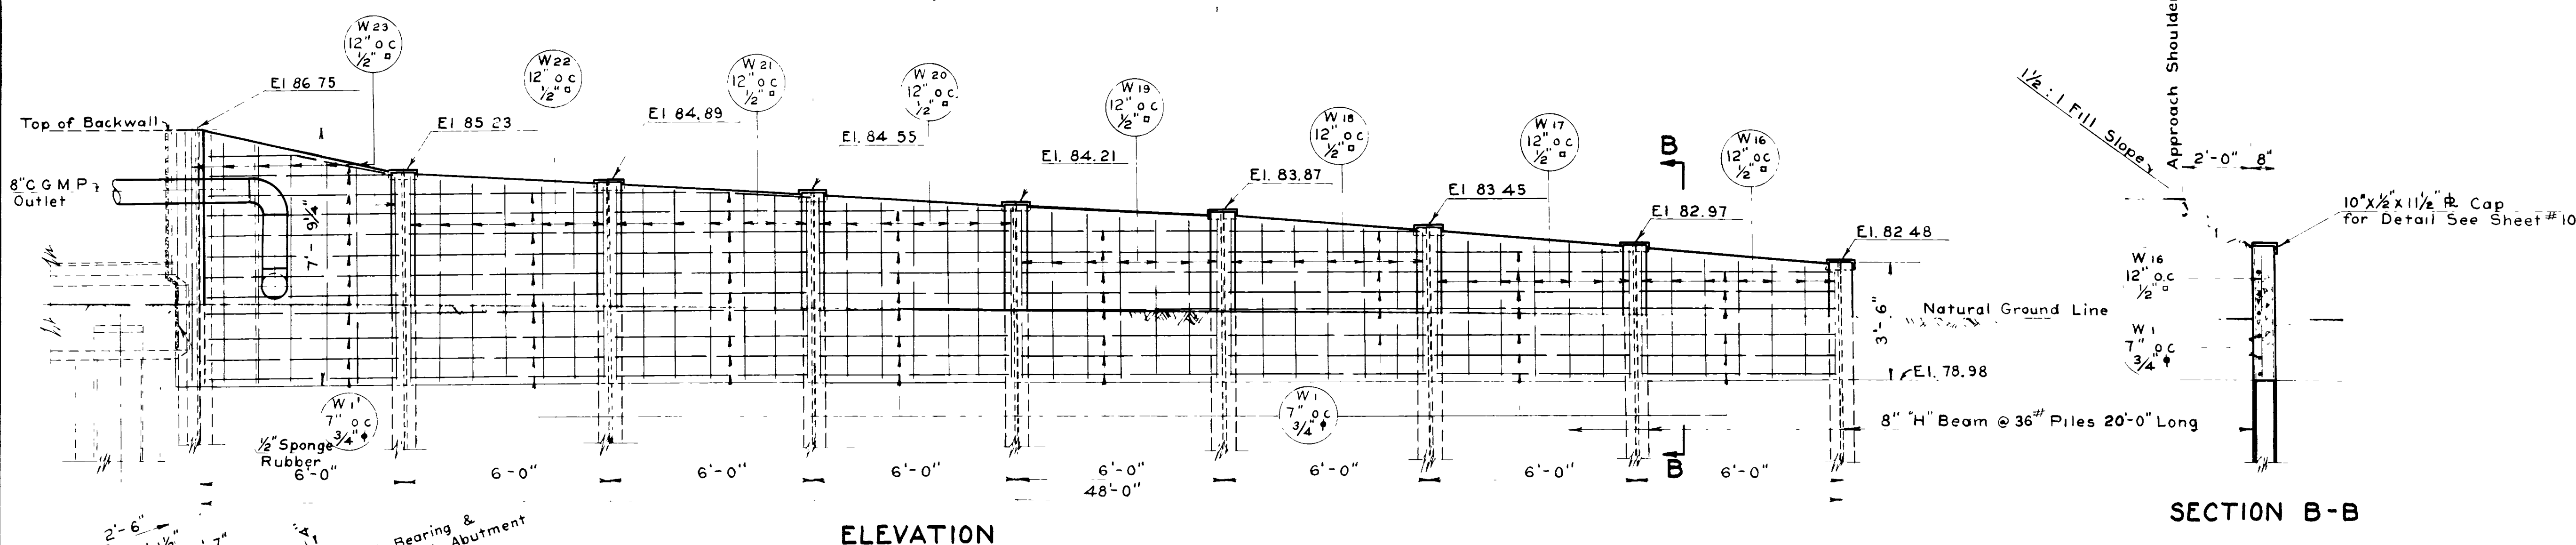

ELEVATION

SECTION B-B

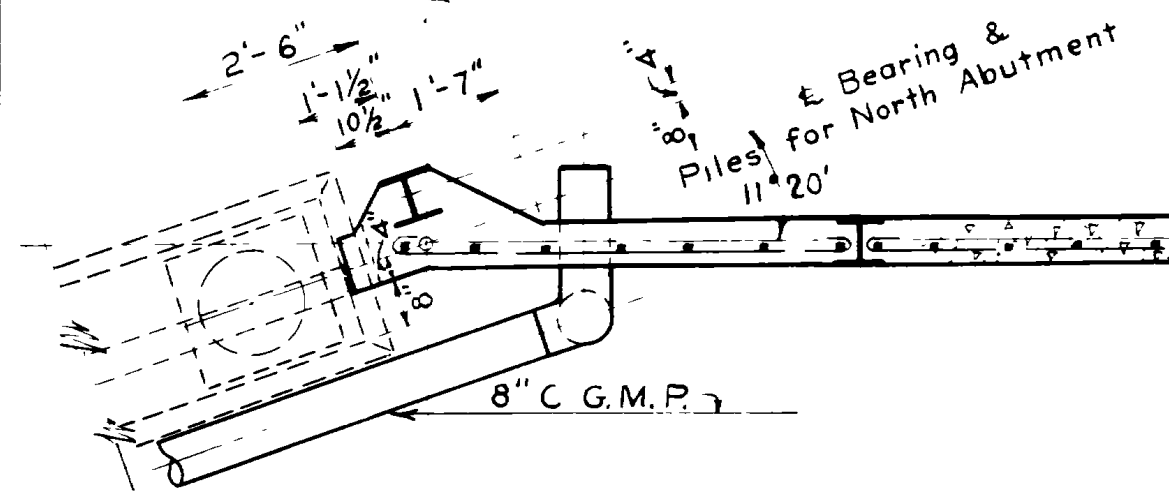

PLAN
DETAIL OF BULKHEAD "C"
Scale: 3/8" = 1'-0"

Sheet #13 of 15 Sheets
 UTAH STATE ROAD COMMISSION
 SALT LAKE CITY, UTAH
 AREA C FORTWORTH STREET BRIDGE
STEEL DECK GIRDER BRIDGE
 84'-6 3/8" O. to O. 149' 40" XING ANGLE
 WEBER-DAVIS CANAL
 Sta. 27+46 A.W.F.A. 222 A(1)
 Riverdale Arsenal, Davis Co.
 DRAWN BY K.W.T.
 CHECKED BY K.W.T.
 DATE July 24, 1946
 BY C. J. Martin
 6-259-1-1 C-215

MARK	LOCATION	SIZE	LGTH	No BARS	TOTAL LENGTH	SKETCH	O _{To} O
A1-1	Slab	3/8"	25'-3"	5	2002'-0"		24'-5"
A1-2	"	3/8"	4'-3"	12	51'-0"		2'-11"
A1-3	"	3/8"	4'-3"	4	18'-0"		3'-2"
A1-4	"	3/8"	5'-7"	1	20'-0"		3'-9"
A1-5	"	3/8"	5'-8"	1	22'-8"		4'-4"
A1-6	"	3/8"	6'-3"	1	25'-0"		4'-11"
A1-7	"	3/8"	6'-10"	1	27'-4"		5'-6"
A1-8	"	3/8"	7'-5"	1	29'-8"		6'-11"
A1-9	"	3/8"	8'-0"	1	32'-0"		6'-8"
A1-10	"	3/8"	8'-7"	1	34'-4"		7'-3"
A1-11	"	3/8"	9'-2"	1	36'-6"		7'-10"
A1-12	"	3/8"	9'-9"	1	39'-0"		8'-5"
A1-13	"	3/8"	10'-4"	1	41'-4"		9'-0"
A1-14	"	3/8"	10'-11"	1	43'-8"		9'-7"
A1-15	"	3/8"	11'-6"	1	46'-0"		10'-2"
A1-16	"	3/8"	12'-1"	1	48'-4"		10'-9"
A1-17	"	3/8"	12'-8"	1	50'-8"		11'-4"
A1-18	"	3/8"	13'-3"	1	53'-0"		11'-11"
A1-19	"	3/8"	13'-10"	1	55'-4"		12'-6"
A1-20	"	3/8"	14'-5"	1	57'-8"		13'-1"
A1-21	"	3/8"	15'-0"	1	60'-0"		13'-8"
A1-22	"	3/8"	15'-8"	1	62'-8"		14'-4"
A1-23	"	3/8"	16'-3"	1	65'-0"		14'-11"
A1-24	"	3/8"	16'-10"	1	67'-4"		15'-6"
A1-25	"	3/8"	17'-5"	1	69'-8"		16'-11"
A1-26	"	3/8"	18'-0"	1	72'-0"		16'-8"
A1-27	"	3/8"	18'-7"	1	74'-4"		17'-3"
A1-28	"	3/8"	19'-2"	1	76'-8"		17'-10"
A1-29	"	3/8"	19'-9"	1	79'-0"		18'-5"
A1-30	"	3/8"	20'-4"	1	81'-4"		19'-0"
A1-31	"	3/8"	20'-11"	1	83'-8"		19'-7"
A1-32	"	3/8"	21'-6"	1	86'-0"		20'-2"
A1-33	"	3/8"	22'-1"	1	88'-4"		20'-9"
A1-34	"	3/8"	22'-8"	1	90'-8"		21'-4"
A1-35	"	3/8"	23'-3"	1	93'-0"		21'-11"
A1-36	Slab	3/8"	23'-10"	4	95'-4"		22'-6"

MARK	LOCATION	SIZE	LGTH	No BARS	TOTAL LENGTH	SKETCH	O _{To} O
A1-37	Slab	3/8"	24'-5"	4	97'-8"		23'-1"
A1-38	"	3/8"	25'-0"	1	100'-0"		23'-8"
A1-39	"	3/8"	25'-7"	1	102'-4"		24'-3"
A1-40	"	3/8"	26'-2"	1	104'-8"		24'-10"
A1-41	"	3/8"	26'-9"	1	107'-0"		25'-5"
A1-42	"	3/8"	27'-4"	1	109'-4"		26'-0"
A1-43	"	3/8"	27'-11"	1	111'-8"		26'-7"
A1-44	"	3/8"	28'-6"	1	114'-0"		27'-2"
A1-45	"	3/8"	29'-1"	1	116'-4"		27'-9"
A1-46	"	3/8"	29'-8"	1	118'-8"		28'-4"
A1-47	"	3/8"	30'-3"	1	121'-0"		28'-11"
A1-48	"	3/8"	30'-10"	1	123'-4"		29'-6"
A1-49	"	3/8"	31'-5"	1	125'-8"		30'-1"
A1-50	"	3/8"	32'-0"	1	128'-0"		30'-8"
A1-51	"	3/8"	32'-7"	1	130'-4"		31'-3"
A1-52	"	3/8"	33'-2"	1	132'-8"		31'-10"
A1-53	"	3/8"	33'-9"	4	135'-0"		32'-5"
A1-54	Slab	3/8"	34'-4"	2	68'-8"		33'-0"
A2-1	Slab	3/8"	32'-0"	57	2052'-0"		
A2-2	"	3/8"	3'	2	6'-0"		
A2-3	"	3/8"	5'-8"	1	5'-8"		
A2-4	"	3/8"	6'-3"	1	6'-3"		
A2-5	"	3/8"	6'-10"	1	6'-10"		
A2-6	"	3/8"	7'-5"	1	7'-5"		
A2-7	"	3/8"	8'-0"	1	8'-0"		
A2-8	"	3/8"	8'-7"	1	8'-7"		
A2-9	"	3/8"	9'-2"	1	9'-2"		
A2-10	"	3/8"	9'-9"	1	9'-9"		
A2-11	"	3/8"	10'-4"	1	10'-4"		
A2-12	"	3/8"	10'-11"	1	10'-11"		
A2-13	Slab	3/8"	11'-6"	2	23'-0"		

MARK	LOCATION	SIZE	LGTH	No BARS	TOTAL LENGTH	SKETCH	O _{To} O
A2-14	Slab	3/8"	12'-1"	2	24'-2"		
A2-15	"	3/8"	12'-8"	1	25'-4"		
A2-16	"	3/8"	13'-3"	1	26'-6"		
A2-17	"	3/8"	13'-10"	1	27'-8"		
A2-18	"	3/8"	14'-5"	1	28'-10"		
A2-19	"	3/8"	15'-0"	1	30'-0"		
A2-20	"	3/8"	15'-7"	1	31'-2"		
A2-21	"	3/8"	16'-2"	1	32'-4"		
A2-22	"	3/8"	16'-9"	1	33'-6"		
A2-23	"	3/8"	17'-4"	1	34'-8"		
A2-24	"	3/8"	17'-11"	1	35'-10"		
A2-25	"	3/8"	18'-6"	1	37'-0"		
A2-26	"	3/8"	19'-1"	1	38'-2"		
A2-27	"	3/8"	19'-8"	1	39'-4"		
A2-28	"	3/8"	20'-3"	1	40'-6"		
A2-29	"	3/8"	20'-10"	1	41'-8"		
A2-30	"	3/8"	21'-5"	1	42'-10"		
A2-31	"	3/8"	22'-0"	1	44'-0"		
A2-32	"	3/8"	22'-7"	1	45'-2"		
A2-33	"	3/8"	23'-2"	1	46'-4"		
A2-34	"	3/8"	23'-9"	1	47'-6"		
A2-35	"	3/8"	24'-4"	1	48'-8"		
A2-36	"	3/8"	24'-11"	1	49'-10"		
A2-37	"	3/8"	25'-6"	1	51'-0"		
A2-38	"	3/8"	26'-1"	1	52'-2"		
A2-39	"	3/8"	26'-8"	1	53'-4"		
A2-40	"	3/8"	27'-3"	1	54'-6"		
A2-41	"	3/8"	27'-10"	1	55'-8"		
A2-42	"	3/8"	28'-5"	1	56'-10"		
A2-43	"	3/8"	29'-0"	1	58'-0"		
A2-44	"	3/8"	29'-7"	1	59'-2"		
A2-45	"	3/8"	30'-2"	1	60'-4"		
A2-46	Slab	3/8"	30'-9"	2	61'-6"		

MARK	LOCATION	SIZE	LGTH	No BARS	TOTAL LENGTH	SKETCH	O _{To} O
A2-47	Slab	3/8"	31'-4"	2	62'-8"		
A2-48	"	3/8"	31'-11"	1	63'-10"		
A2-49	"	3/8"	32'-6"	1	65'-2"		
A2-50	"	3/8"	33'-1"	1	66'-4"		
A2-51	"	3/8"	33'-8"	1	67'-6"		
A2-52	Slab	3/8"	34'-4"	2	68'-8"		
B1	Slab	3/8"	29'-0"	321	9309'-0"		
NOTE: For B1-1 to B3-2 and A2-1 to A2-52 see next sheet							
C1-1	Curb (Long)	3/8"	31'-11"	6	191'-6"		
C1-2	" (Short)	3/8"	28'-10"	6	173'-0"		
C2-1	Curb at #3 Drain Box	3/8"	7'-3"	4	29'-0"		
C2-2	"	3/8"	6'-10"	4	27'-4"		
C2-3	"	3/8"	10'-3"	3	30'-9"		
C2-4	"	3/8"	2'-0"	2	4'-0"		
C2-5	"	3/8"	2'-6"	2	5'-0"		
C2-6	"	3/8"	2'-11"	2	5'-10"		
C2-7	"	3/8"	3'-4"	1	3'-4"		
C2-8	"	3/8"	3'-9"	2	7'-6"		
C2-9	Curb at #3 Drain Box	3/8"	4'-1"	2	8'-2"		

NO.	DATE	BY	REVISION

MARK	LOCATION	SIZE	LGTH	No BARS	TOTAL LENGTH	SKETCH	O _{To} O
C3-1	Curb at #1 Box	3/8"	8'-6"	3	25'-6"		
C3-2	"	3/8"	8'-8"	1	8'-8"		
C3-3	"	3/8"	9'-3"	1	9'-3"		
C3-4	"	3/8"	5'-6"	3	16'-6"		
D1-1	Drain Box #3	3/8"	5'-9"	3	17'-3"		
D1-2	"	3/8"	3'-6"	3	10'-6"		2'-5"
D1-3	"	3/8"	2'-8"	1	2'-8"		
D1-4	"	3/8"	2'-3"	6	13'-0"		
D1-5	" #1 & #2	3/8"	2'-8"	14	37'-4"		
D1-6	"	3/8"	2'-3"	9	20'-3"		
D1-7	"	3/8"	2'-3"	10	22'-6"		
D1-8	" #1	3/8"	1'-5"	2	2'-10"		
E1-1	Lower Abut (Fixed End)	3/8"	10'-6"	10	105'-0"		
E1-2	"	3/8"	6'-0"	2	12'-0"		
E2	"	3/8"	2'-0"	62	124'-0"		
E3	"	3/8"	37'-5"	18	673'-6"		

MARK	LOCATION	SIZE	LGTH	No BARS	TOTAL LENGTH	SKETCH	O _{To} O
E4	Lower Abut (Fixed End)	3/8"	5'-9"	46	264'-6"		
F1	Pile Casings	3/8"	7'-0"	208	1456'-0"		
F2	"	3/8"	7'-4"	156	1144'-0"		
G1	Piles	3/8"	18'-2"	104	1889'-4"		
G2	Piles (Spiral)	3/8"	179'-7"	26	4669'-2"		
J1	Upper Abut (Exp End)	3/8"	39'-2"	32	1253'-4"		
J2	"	3/8"	39'-2"	32	1253'-4"		

MARK	LOCATION	SIZE	LGTH	No BARS	TOTAL LENGTH	SKETCH	O _{To} O
J3-1	Upper Abut (Exp End)	3/8"	7'-9"	66	511'-6"		
J3-2	"	3/8"	7'-3"	1	7'-3"		
J3-3	"	3/8"	6'-5"	1	6'-5"		
J3-4	"	3/8"	5'-7"	1	5'-7"		
J3-5	"	3/8"	4'-9"	1	4'-9"		
J3-6	"	3/8"	3'-11"	1	3'-11"		
J4-1	"	3/8"	6'-4"	66	418'-0"		
J4-2	"	3/8"	5'-10"	1	5'-10"		
J4-3	"	3/8"	5'-0"	1	5'-0"		
J4-4	"	3/8"	4'-2"	1	4'-2"		
J4-5	"	3/8"	3'-4"	1	3'-4"		
J4-6	"	3/8"	2'-6"	1	2'-6"		
J5	Upper Abut (Wing Wall)	3/8"	5'-10"	46	268'-4"		
J6-1	"	3/8"	13'-1"				

MARK	LOCATION	SIZE	LGTH	No. BARS	TOTAL LENGTH	SKETCH	O.to.O.
J8-1	Upper Abut. Wing Wall	5/8"	16'-10"	3	50'-6"		
J8-2		5/8"	15'-1"	3	39'-3"		
J8-3		5/8"	15'-10"	6	95'-0"		
J8-4		5/8"	13'-10"	1	13'-10"		
J8-5		5/8"	12'-3"	1	12'-3"		
J8-6		5/8"	10'-8"	1	10'-8"		
J9-1		5/8"	7'-11"	5	39'-7"		
J9-2		5/8"	8'-6"	1	8'-6"		
J9-3		5/8"	8'-11"	1	8'-11"		
J9-4		5/8"	7'-8"	1	7'-8"		
J9-5		5/8"	7'-3"	1	7'-3"		
J9-6		5/8"	6'-10"	1	6'-10"		
J9-7		5/8"	6'-5"	1	6'-5"		
J9-8		5/8"	6'-0"	1	6'-0"		
J9-9		5/8"	5'-7"	1	5'-7"		
J9-10	Upper Abut. Wing Wall	5/8"	5'-2"	1	5'-2"		
J10		5/8"	16'-2"	2	32'-4"		
P1	Hand Rail & Posts	5/8"	4'-4"	378	1638'-0"		3'-9 1/2"
R1-1	End Posts	5/8"	7'-0"	24	168'-0"	Field bend	
R1-2		5/8"	8'-8"	8	69'-4"	Field bend	
R1-3	Hand Rail	5/8"	5'-9"	20	115'-0"		
R1-4		5/8"	6'-9"	16	108'-0"		
R1-5		5/8"	3'-9"	2	7'-6"		
R1-6		5/8"	4'-9"	2	9'-6"		
R1-7	H. Rail Posts	5/8"	2'-8"	12	32'-0"	Field bend	
R1-8		5/8"	2'-10"	24	68'-0"		
R1-9		5/8"	3'-0"	12	36'-0"		

MARK	LOCATION	SIZE	LGTH	No. BARS	TOTAL LENGTH	SKETCH	O.to.O.
R2-1	Hand Rail	5/8"	5'-9"	20	230'-0"		
R2-2		5/8"	6'-9"	32	216'-0"		
R2-3		5/8"	3'-9"	4	15'-0"		
R2-4		5/8"	4'-9"	4	19'-0"		
W1	Bulkheads A-B-C	5/8"	7'-3"	160	1160'-0"		5'-7 1/2"
W1	C	5/8"	8'-11"	12	97'-0"		6'-5 1/2"
W2	A	5/8"	5'-10"	11	64'-2"		
W3	A	5/8"	6'-3"	7	43'-9"		
W4	A	5/8"	5'-10"	2	11'-8"		
W5	A	5/8"	5'-6"	2	11'-0"		
W6	A	5/8"	5'-11"	2	10'-2"		
W7	A	5/8"	4'-7"	2	9'-2"		
W8	A	5/8"	4'-1"	2	8'-2"		
W9	B	5/8"	6'-4"	7	44'-4"		
W10	B	5/8"	5'-10"	7	40'-10"		
W11	B	5/8"	5'-4"	7	37'-4"		
W12	B	5/8"	4'-10"	7	33'-10"		
W13	B	5/8"	4'-5"	7	30'-11"		
W14	B	5/8"	3'-11"	7	27'-5"		
W15	B	5/8"	3'-5"	7	23'-11"		
W16	C	5/8"	3'-2"	7	22'-2"		
W17	C	5/8"	3'-8"	7	25'-8"		
W18	C	5/8"	4'-2"	7	29'-2"		
W19	C	5/8"	4'-7"	7	32'-11"		
W20	C	5/8"	4'-11"	7	34'-5"		
W21	C	5/8"	5'-4"	7	37'-2"		
W22	C	5/8"	5'-7"	7	39'-11"		
W23	Bulkhead C	5/8"	5'-11"	7	41'-5"		

MARK	LOCATION	SIZE	LGTH	No. BARS	TOTAL LENGTH	SKETCH	O.to.O.
A2-1	Slab	5/8"	38'-0"	29	1102'-0"	See Sketch	34'-8"
A2-2		5/8"	5'-2"	2	10'-4"		3'-8"
A2-3		5/8"	5'-9"	2	11'-6"	a = 2'-11"	4'-3"
A2-4		5/8"	6'-6"	2	13'-0"		4'-10"
A2-5		5/8"	7'-1"	2	14'-2"	a = 1'-7"	5'-5"
A2-6		5/8"	7'-8"	2	15'-4"	a = 2'-2"	6'-0"
A2-7		5/8"	8'-3"	2	16'-6"	a = 2'-9"	6'-7"
A2-8		5/8"	8'-10"	2	17'-8"	a = 3'-4"	7'-2"
A2-9		5/8"	9'-5"	2	18'-10"	a = 3'-11"	7'-9"
A2-10		5/8"	10'-2"	2	20'-4"		8'-4"
A2-11		5/8"	10'-9"	2	21'-6"	a = 1'-8 1/2"	8'-11"
A2-12		5/8"	11'-4"	2	22'-8"	a = 2'-3 1/4"	9'-6"
A2-13	Slab	5/8"	11'-11"	2	23'-10"	a = 2'-10 1/4"	10'-11"

MARK	LOCATION	SIZE	LGTH	No. BARS	TOTAL LENGTH	SKETCH	O.to.O.
A2-14	Slab	5/8"	12'-8"	2	25'-4"		10'-8"
A2-15		5/8"	13'-3"	2	26'-6"	a = 1'-5"	11'-3"
A2-16		5/8"	13'-10"	2	27'-8"	a = 2'-0"	11'-10"
A2-17		5/8"	14'-5"	2	28'-10"	a = 2'-7"	12'-5"
A2-18		5/8"	15'-0"	2	30'-0"	a = 3'-2"	13'-0"
A2-19		5/8"	15'-7"	2	31'-2"	a = 3'-9"	13'-7"
A2-20		5/8"	16'-3"	2	32'-6"		14'-2"
A2-21		5/8"	16'-10"	2	33'-8"	a = 1'-5 1/4"	14'-9"
A2-22		5/8"	17'-5"	2	34'-10"	a = 2'-0 1/4"	15'-4"
A2-23		5/8"	18'-0"	2	36'-0"	a = 2'-7 1/2"	15'-11"
A2-24		5/8"	18'-7"	2	37'-2"	a = 3'-2 1/4"	16'-6"
A2-25		5/8"	19'-5"	2	38'-10"	a = 1'-3"	17'-1"
A2-26		5/8"	20'-0"	2	40'-0"	a = 1'-10"	17'-8"
A2-27		5/8"	20'-7"	2	41'-2"	a = 2'-5"	18'-3"
A2-28		5/8"	21'-2"	2	42'-4"	a = 3'-0"	18'-10"
A2-29	Slab	5/8"	21'-9"	2	43'-6"	a = 3'-7"	19'-5"

REVISIONS	NO.	DATE	BY	DESCRIPTION
1	12	8-31	D.M.S.	

MARK	LOCATION	SIZE	LGTH	No. BARS	TOTAL LENGTH	SKETCH	O.to.O.
A2-30	Slab	5/8"	22'-6"	2	45'-0"	a = 0'-9 1/4"	20'-0"
A2-31		5/8"	23'-1"	2	46'-2"	a = 1'-4 1/4"	20'-7"
A2-32		5/8"	23'-8"	2	47'-4"	a = 1'-11 1/4"	21'-2"
A2-33		5/8"	24'-3"	2	48'-6"	a = 2'-6 1/4"	21'-9"
A2-34	Slab	5/8"	24'-10"	2	49'-8"	a = 3'-1 1/4"	22'-4"
A2-35	Slab	5/8"	25'-7"	2	51'-2"	a = 1'-1"	22'-11"
A2-36		5/8"	26'-2"	2	52'-4"	a = 1'-8"	23'-6"
A2-37		5/8"	26'-9"	2	53'-6"	a = 2'-3"	24'-1"
A2-38		5/8"	27'-4"	2	54'-8"	a = 2'-10"	24'-8"
A2-39		5/8"	27'-11"	2	55'-4"	a = 3'-5"	25'-3"
A2-40	Slab	5/8"	28'-6"	2	57'-0"	a = 4'-0"	25'-10"

MARK	LOCATION	SIZE	LGTH	No. BARS	TOTAL LENGTH	SKETCH	O.to.O.
A2-41	Slab	5/8"	29'-3"	2	58'-6"	a = 1'-2 1/4"	26'-5"
A2-42		5/8"	29'-10"	2	59'-8"	a = 1'-9 1/4"	27'-0"
A2-43		5/8"	30'-5"	2	60'-10"	a = 2'-4 1/4"	27'-7"
A2-44	Slab	5/8"	31'-0"	2	62'-0"	a = 2'-11 1/4"	28'-2"
A2-45	Slab	5/8"	31'-9"	2	63'-6"	a = 0'-11"	28'-9"
A2-46		5/8"	32'-4"	2	64'-8"	a = 1'-6"	29'-4"
A2-47		5/8"	32'-11"	2	65'-10"	a = 2'-1"	29'-11"
A2-48		5/8"	33'-6"	2	67'-0"	a = 2'-8"	30'-6"
A2-49		5/8"	34'-2"	2	68'-4"	a = 3'-4"	31'-2"
A2-50	Slab	5/8"	34'-9"	2	69'-6"	a = 3'-11"	31'-9"
A2-51	Slab	5/8"	35'-6"	2	71'-0"	a = 1'-1 1/4"	32'-4"
A2-52	Slab	5/8"	36'-1"	2	72'-2"	a = 1'-8 1/4"	32'-11"

MARK	LOCATION	SIZE	LGTH	No. BARS	TOTAL LENGTH	SKETCH	O.to.O.
B1-1	Diaph. Exp. End	1 1/2"	34'-9"	12	417'-0"		
B1-2	Diaph. Exp. End	1 1/2"	33'-4"	8	266'-8"		
B1-3	Diaph. Fixed End	1 1/2"	37'-9"	12	453'-0"		
B1-4	Diaph. Fixed End	1 1/2"	36'-2"	8	289'-4"		
B2	Both Diaphragms	7/8"	8'-0"	110	880'-0"		
B3-1	Both Diaphragms	7/8"	21'-1"	16	337'-4"		
B3-2	Both Diaphragms	7/8"	13'-7"	8	108'-8"		

QUANTITIES

32'-4"	of	1" dia	Bars	@ 3.40 #/ft	= 109.93 #
870'-0"	"	1" dia	"	@ 2.67 #/ft	= 2322.90 #
3566'-8"	"	7/8" dia	"	@ 2.04 #/ft	= 7290.26 #
9226'-8"	"	3/8" dia	"	@ 1.043 #/ft	= 9623.41 #
7134'-2"	"	1/2" dia	"	@ 0.85 #/ft	= 6064.04 #
13848'-5"	"	1/2" dia	"	@ 0.668 #/ft	= 9250.74 #
140'-6"	"	3/8" dia	"	@ 0.376 #/ft	= 52.83 #
4669'-2"	"	1/4" dia	"	@ 0.167 #/ft	= 779.75 #
1737'-0"	"	3/4" dia	"	@ 1.502 #/ft	= 2608.97 #
TOTAL =					38102.83 Lbs.

GENERAL NOTES

Materials, construction, and workmanship shall be in accordance with State Standard Specifications for Road and Bridge construction, edition of 1939.

NOTE: Before Cast-in Place Pile shells are ordered a Timber test pile should be driven to ascertain the correct length of shell to be ordered.




DESIGN DATA

A.A.S.H.O. Specifications of 1941
 H-15 Loading
 $f_c = 1000\%$ $f_s = 18,000\%$


QUANTITIES

Excav. for Structures	150 Cu.Yds.
Gravel Backfill	21 " "
8" C.G.M. Pipe Perforated (1-end plug) (Under drain)	60 Lin Ft
8" C.G.M. Pipe Not (2-30"ells)	118 " "
18" 7ga. Steel Shell Cast-in-place Conc. Piles	870 " "
16" 7ga. " " " " " "	428 " "
Structural Steel	1167 Lbs.
Reinforcing Steel	79728 "
Concrete Class "A"	372 Cu Yds
Hand Rail (Concrete)	284.25 Lin. Ft.
Wood Stairway Complete as Read.	1 each
Structural Steel Bin Type Retaining Wall (Sh.#3)	1 each


SITUATION PLAN

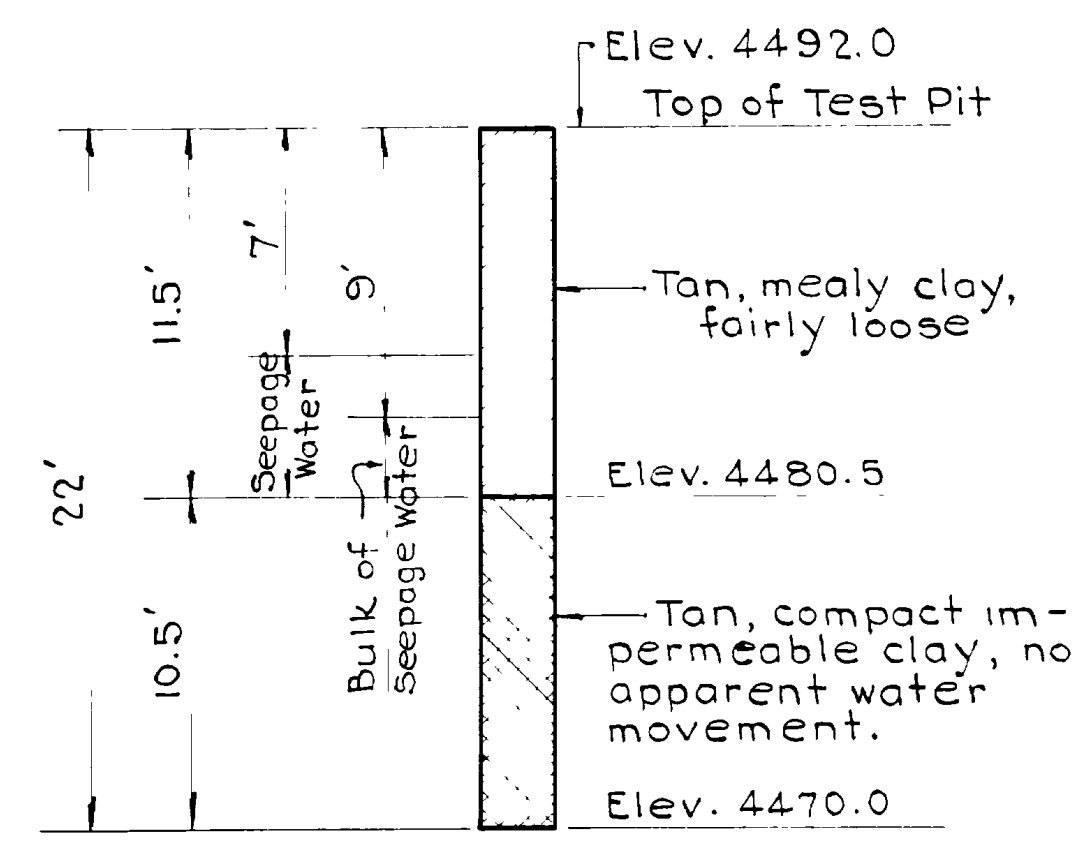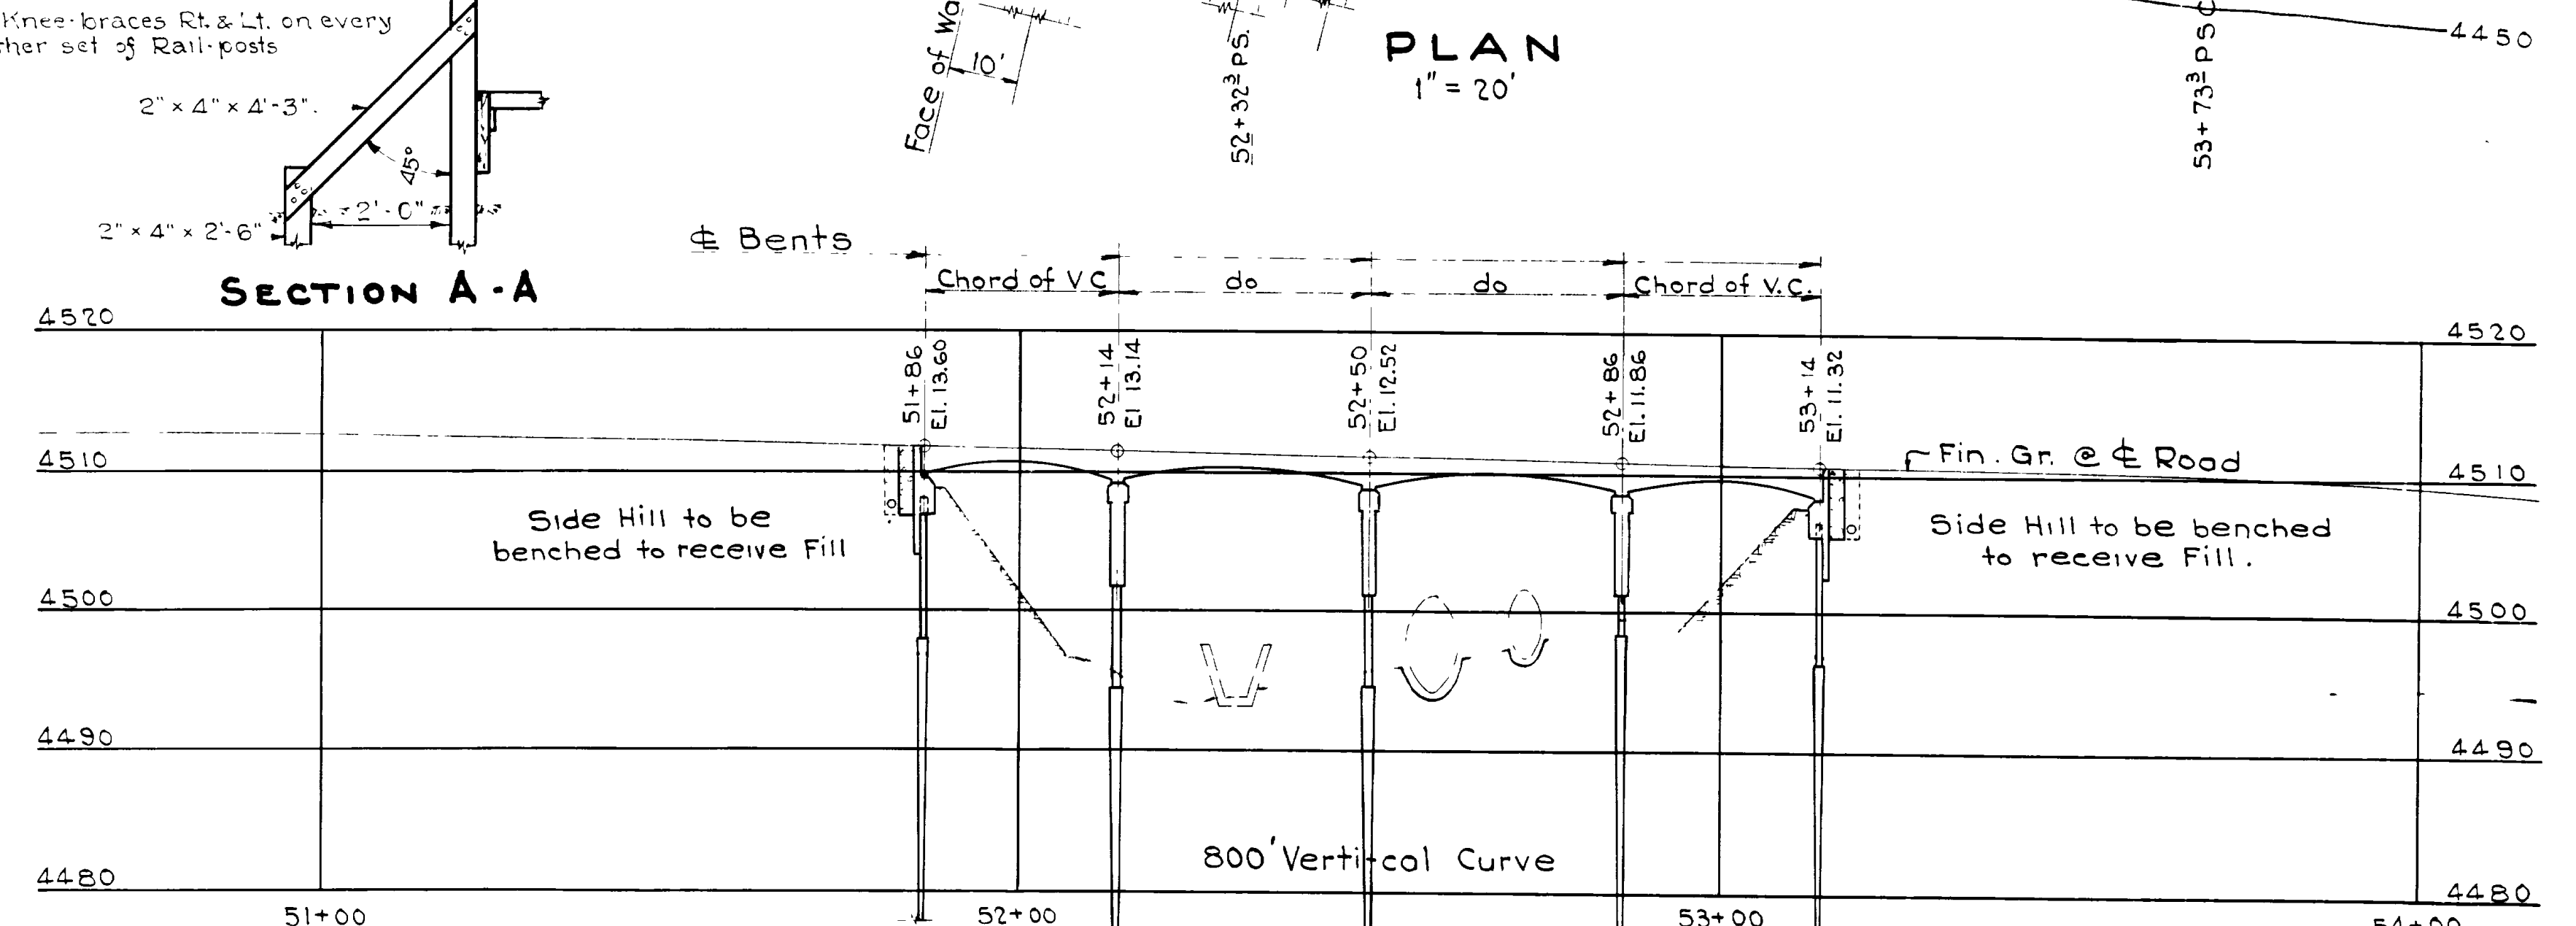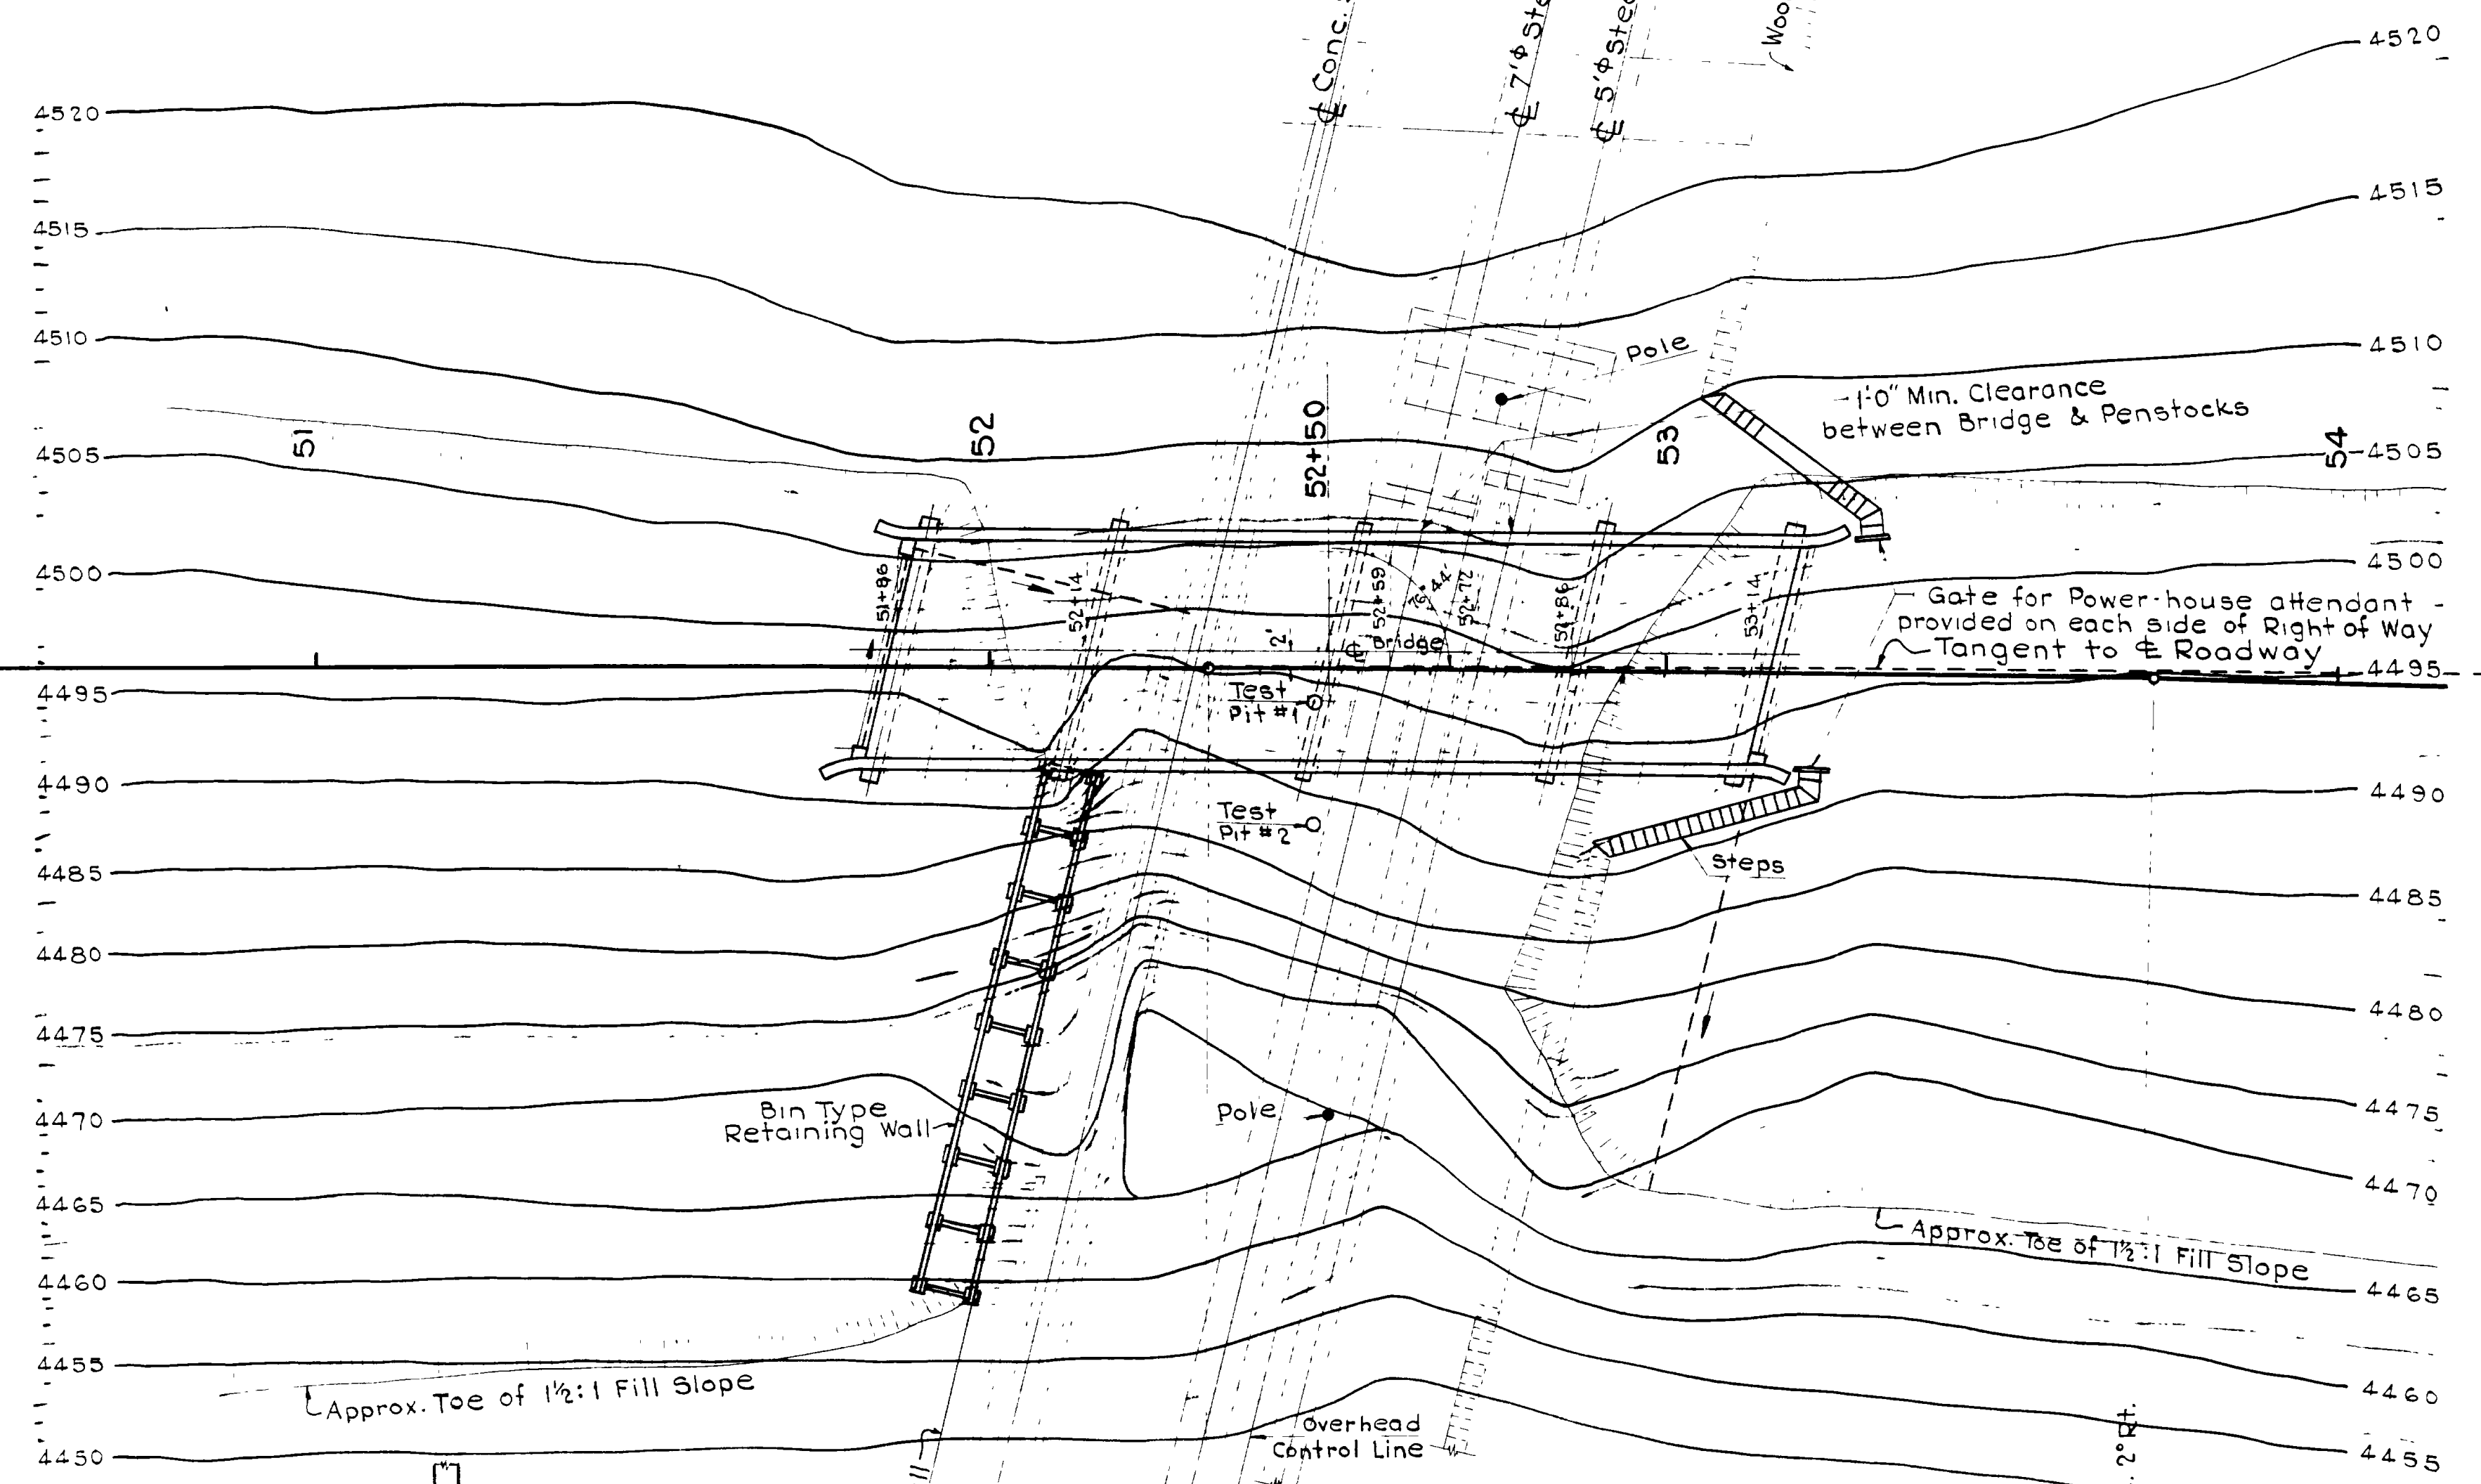


TEST PIT No. 1
 (Located 5' Rt. of Sta. 52+48.0)

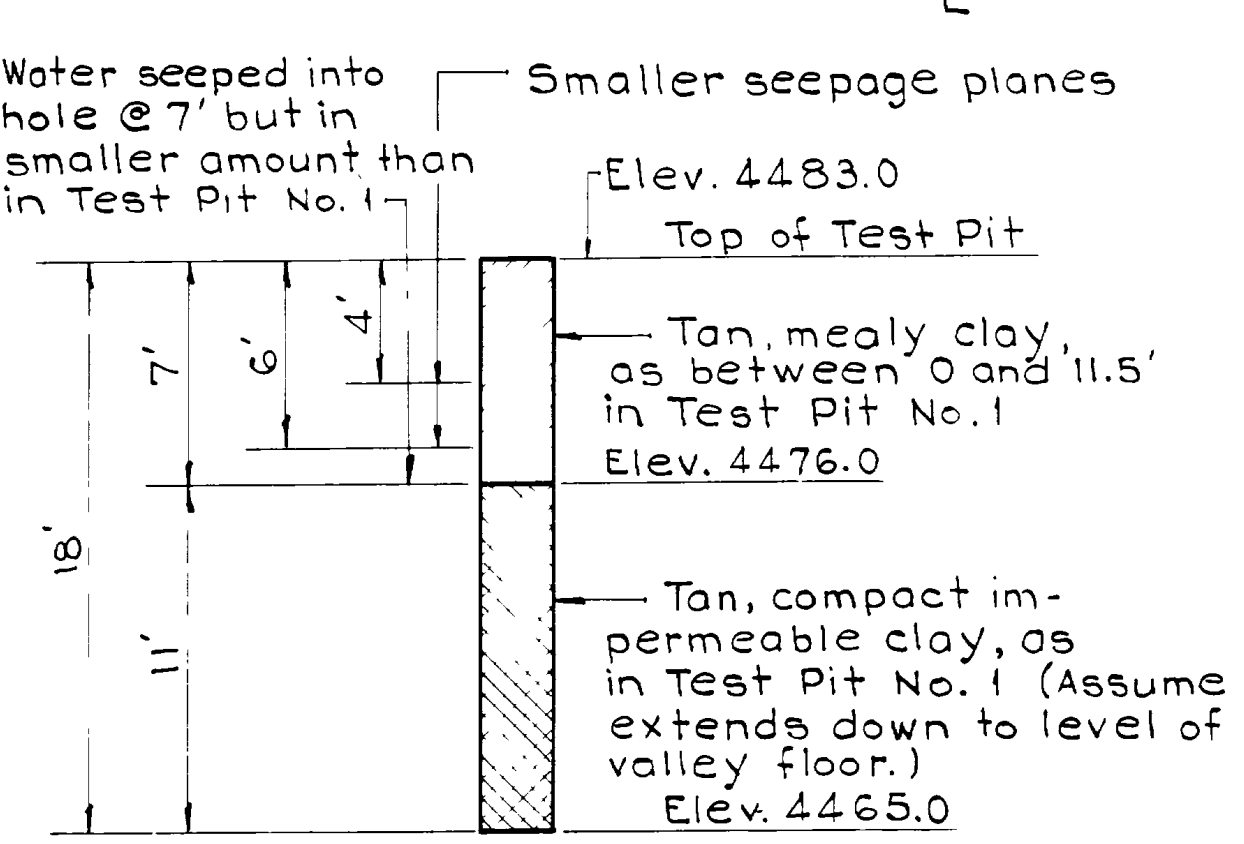

TEST PIT No. 2
 (Located 23' Rt. of Sta 52+48)

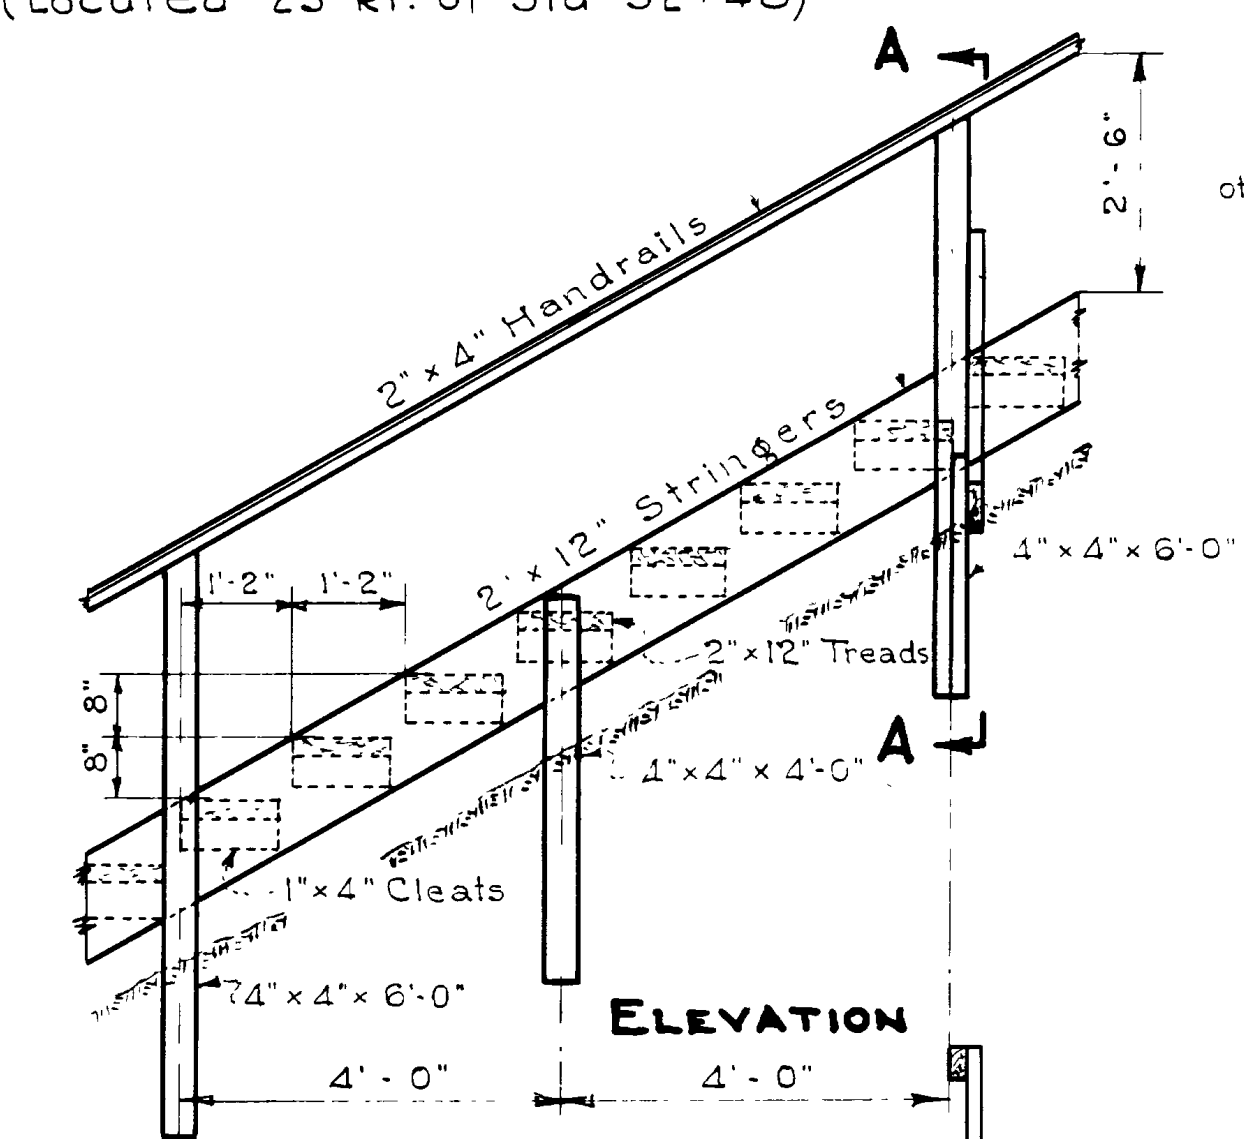

TYPICAL DETAIL OF WOOD STEPS


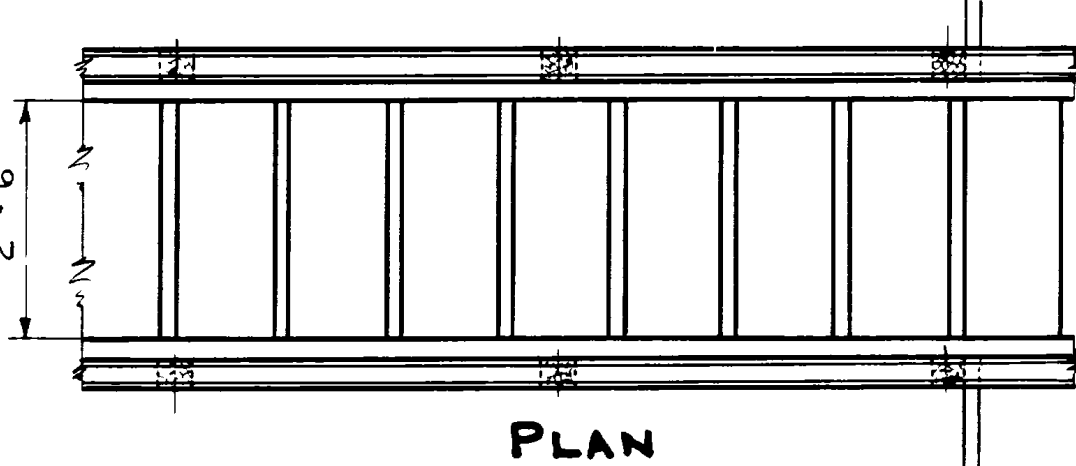


PLAN

REVISIONS	BY	DATE

Sheet 1 of 12 sheets
 UTAH STATE ROAD COMMISSION
 SALT LAKE CITY, UTAH
 BRIDGE OVER U.P. & L. CO'S
 PENSTOCKS
 A.W. (P.C.E.) F.A.P. 222-A(0)
 Sta. 52+50 Weber Co.
 Ogden Arsenal-Riverdale
 F.M.E. As noted
 J.H.B. 10/22/44
 29-259-1-2 D-466

FED. ROAD DIST. NO.	STATE	FED. AID PROJ. NO.	FISCAL YEAR	SHEET NO.	TOTAL SHEETS
12	UTAH	222-A(1)			

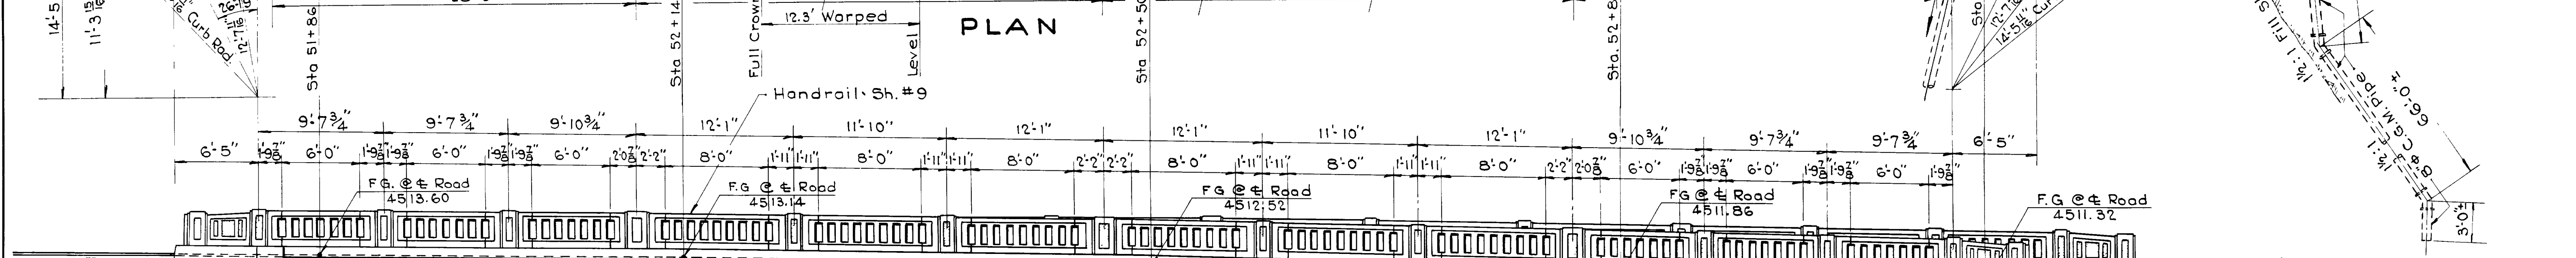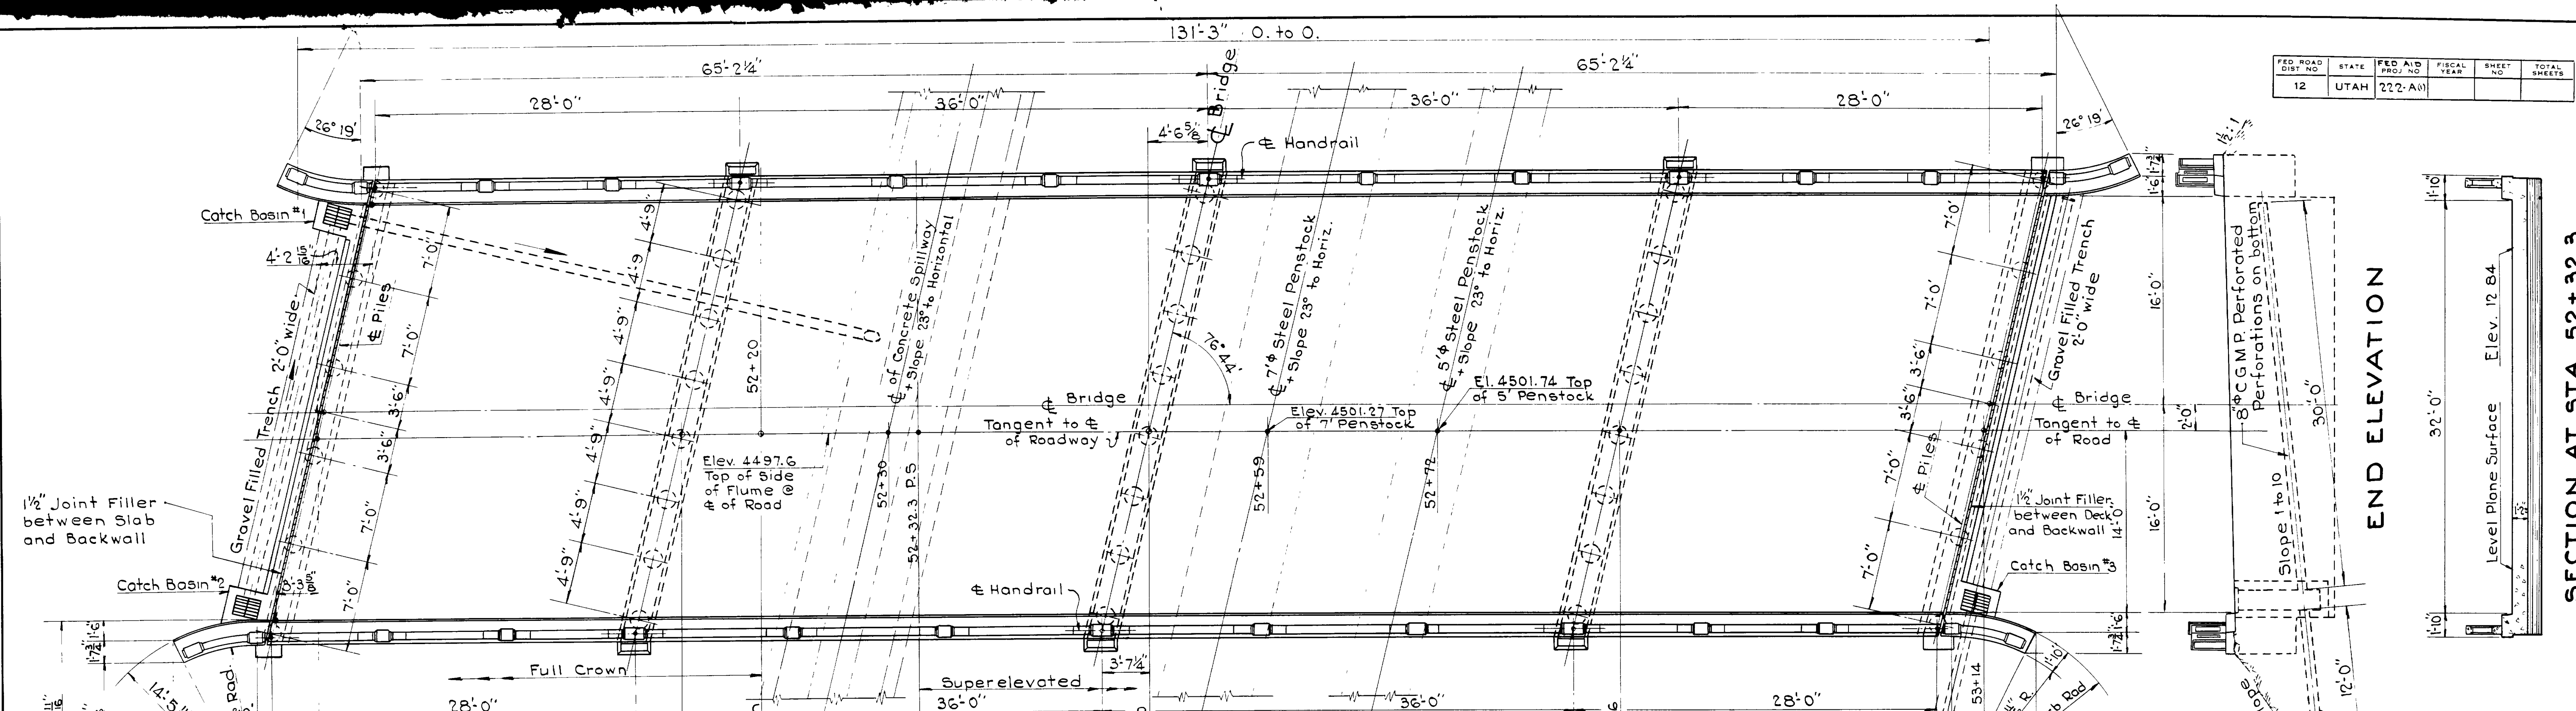

Note: Fill to be thoroughly compacted according to the Specifications before Abutment Piles are driven.

Profile of Ground along outer face of caps

Note: Fill to be thoroughly compacted according to the Specifications before Abutment Piles are driven.

SIDE ELEVATION

END ELEVATION

SECTION AT STA. 52+32.3 (P. Spiral Curve)

GENERAL DRAWING



Sheet 2 of 12 sheets

UTAH STATE ROAD COMMISSION
SALT LAKE CITY - UTAH
EZRA C. KNOWLTON CHIEF ENGINEER

BRIDGE OVER U.P. & L. CO'S
PENSTOCKS
A.W.(P.C.E.) F.A.P. 222-A(1)
Sta. 52+50 Weber Co
Ogden Arsenal - Riverdale

DESIGNED BY F.M.E. SCALE 1" = 6'-0"
DRAWN BY J.H.B. ISSUED May 21, 1944
CHECKED BY APPROVED
EXAMINED BY


BR No. 29-259-1-2 Dwg No. D-466

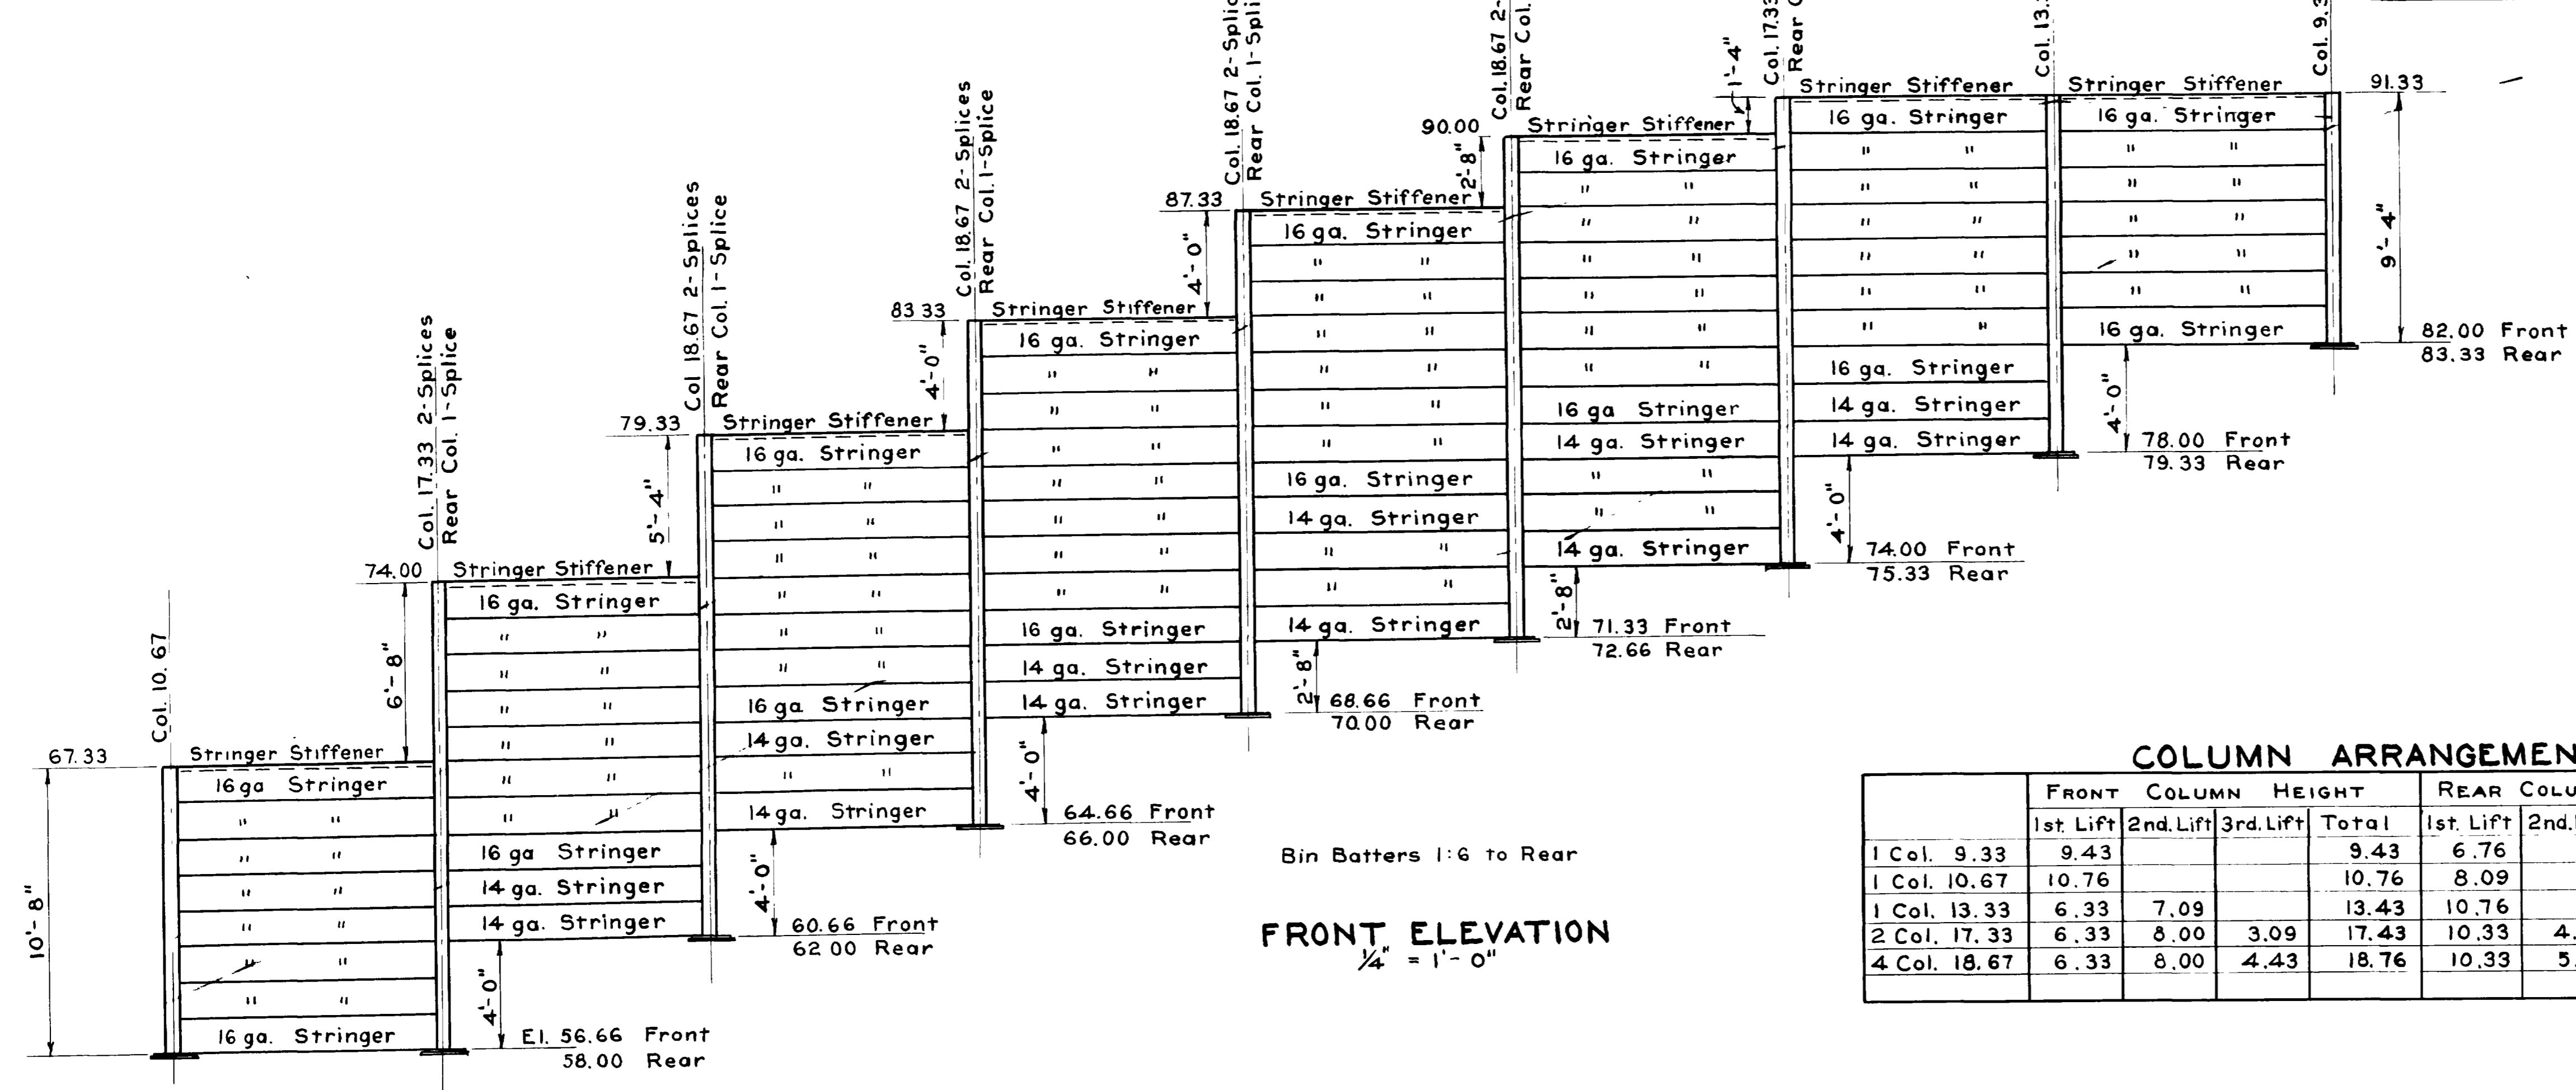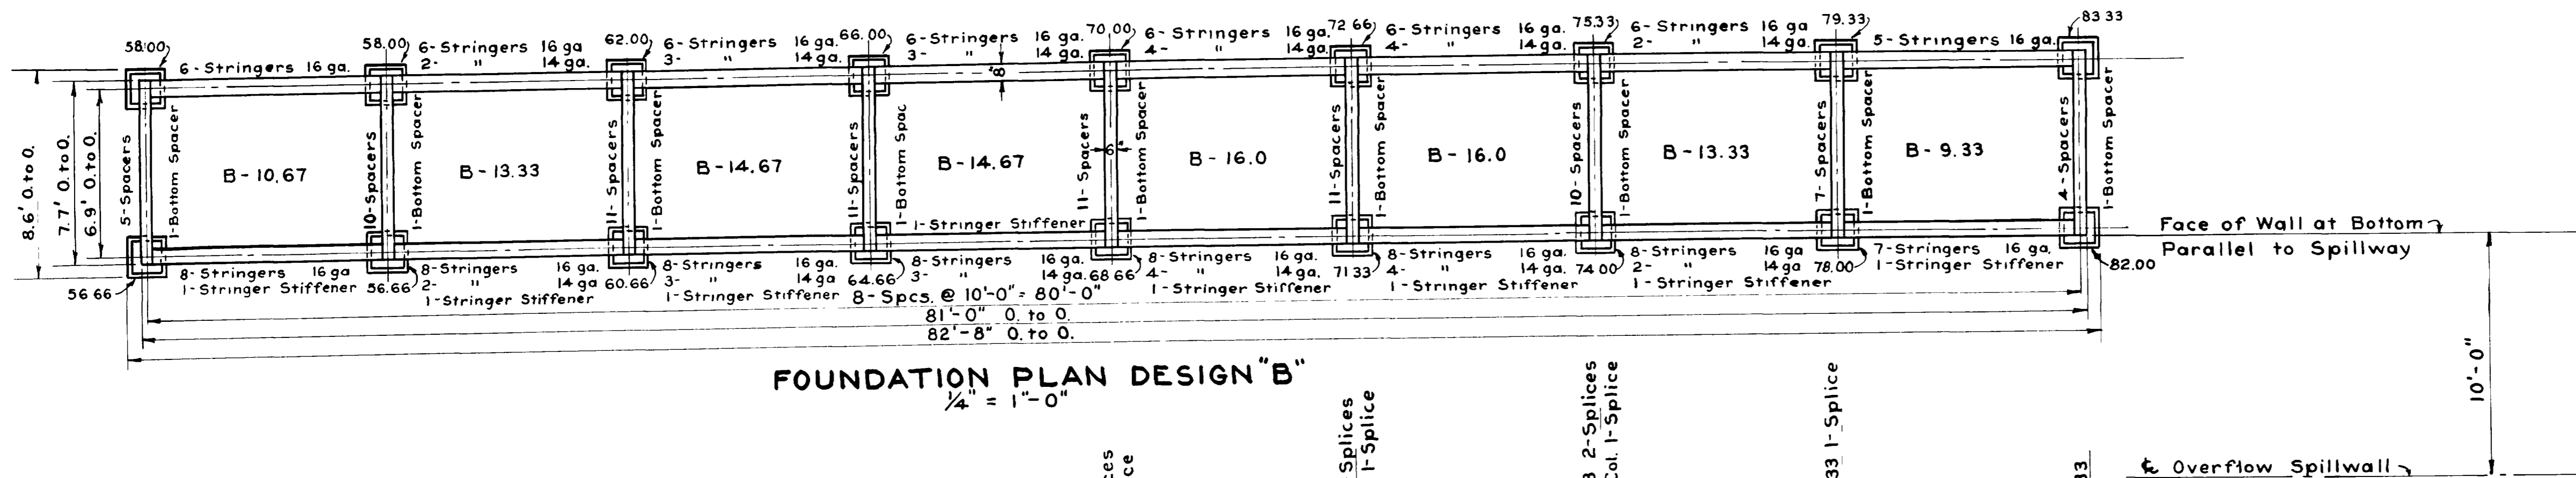

COLUMN ARRANGEMENT

	FRONT COLUMN HEIGHT				REAR COLUMN HEIGHT			FRONT & REAR COLUMN HEIGHT
	1st Lift	2nd Lift	3rd Lift	Total	1st Lift	2nd Lift	Total	
1 Col. 9.33	9.43			9.43	6.76		6.76	16.19 x 1 = 16.19
1 Col. 10.67	10.76			10.76	8.09		8.09	18.85 x 1 = 18.85
1 Col. 13.33	6.33	7.09		13.43	10.76		10.76	24.19 x 1 = 24.19
2 Col. 17.33	6.33	8.00	3.09	17.43	10.33	4.43	14.76	32.19 x 2 = 64.38
4 Col. 18.67	6.33	8.00	4.43	18.76	10.33	5.76	16.09	34.85 x 4 = 139.40
								Total = 263.01

- MATERIAL LIST**
- 110 - Stringers 16 ga. x 9.5'
 - 36 - Stringers 14 ga. x 9.5'
 - 80 - Spacers 16 ga. x 7.4'
 - 9 - Bottom Spacers 16 ga. x 7.4'
 - 8 - Stringer Stiffeners 8 ga. x 9.5'
 - 9 - Column Cap 12 ga.
 - 19 - Column Splices 14 ga.
 - 18 - Bearing Plates 16" x 16" x 1 ga.
 - 18 - Bearing Plates 20" x 20" x 1 ga.
 - 263 - Lin. Ft. Columns 8 ga.

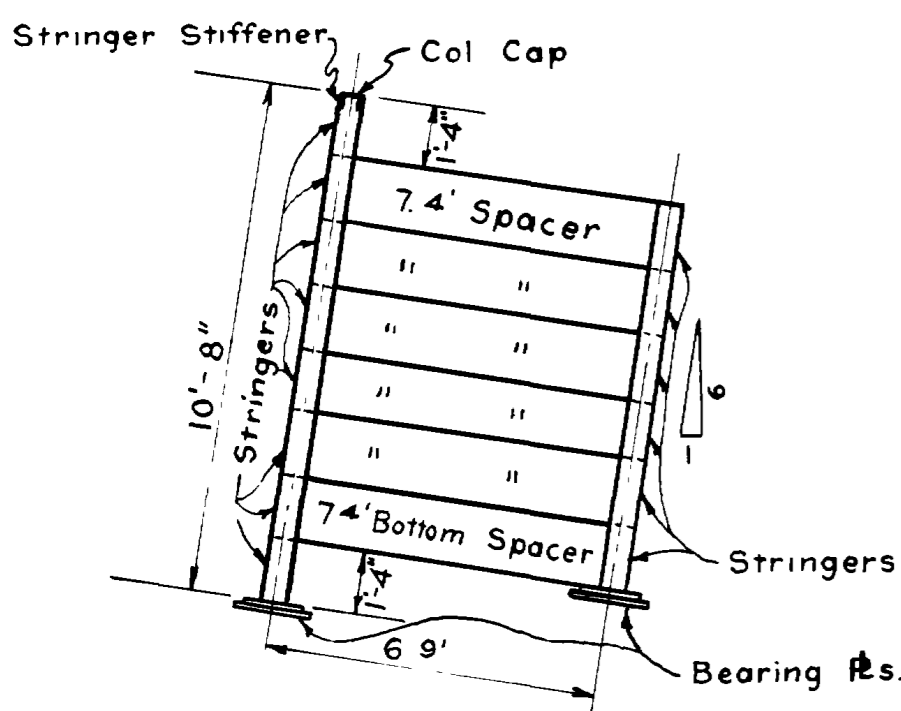

RETAINING WALL


Sheet 3 of 12 sheets
 UTAH STATE ROAD COMMISSION
 SALT LAKE CITY - UTAH
 EZRA C. KNOWLTON CHIEF ENGINEER

BRIDGE OVER U.P. & L. COS. PENSTOCKS
 A.W. (P.C.E.) F.A.P. 222-A(4)
 Sta. 52+50 Weber Co.
 Ogden Arsenal - Riverdale


DESIGNED BY: F.M.E. SCALE: As shown
 DRAWN BY: F.M.E. INT. ED: [Signature]
 CHECKED BY: [Signature]
 APPROVED: [Signature]

EXAMINED BY: [Signature]
 BR. NO. 29-259-1-2 Dwg. No. D-466


FED. ROAD DIST. NO.	STATE	FED. AID PROJ. NO.	FISCAL YEAR	SHEET NO.	TOTAL SHEETS
12	UTAH	222-A(1)			

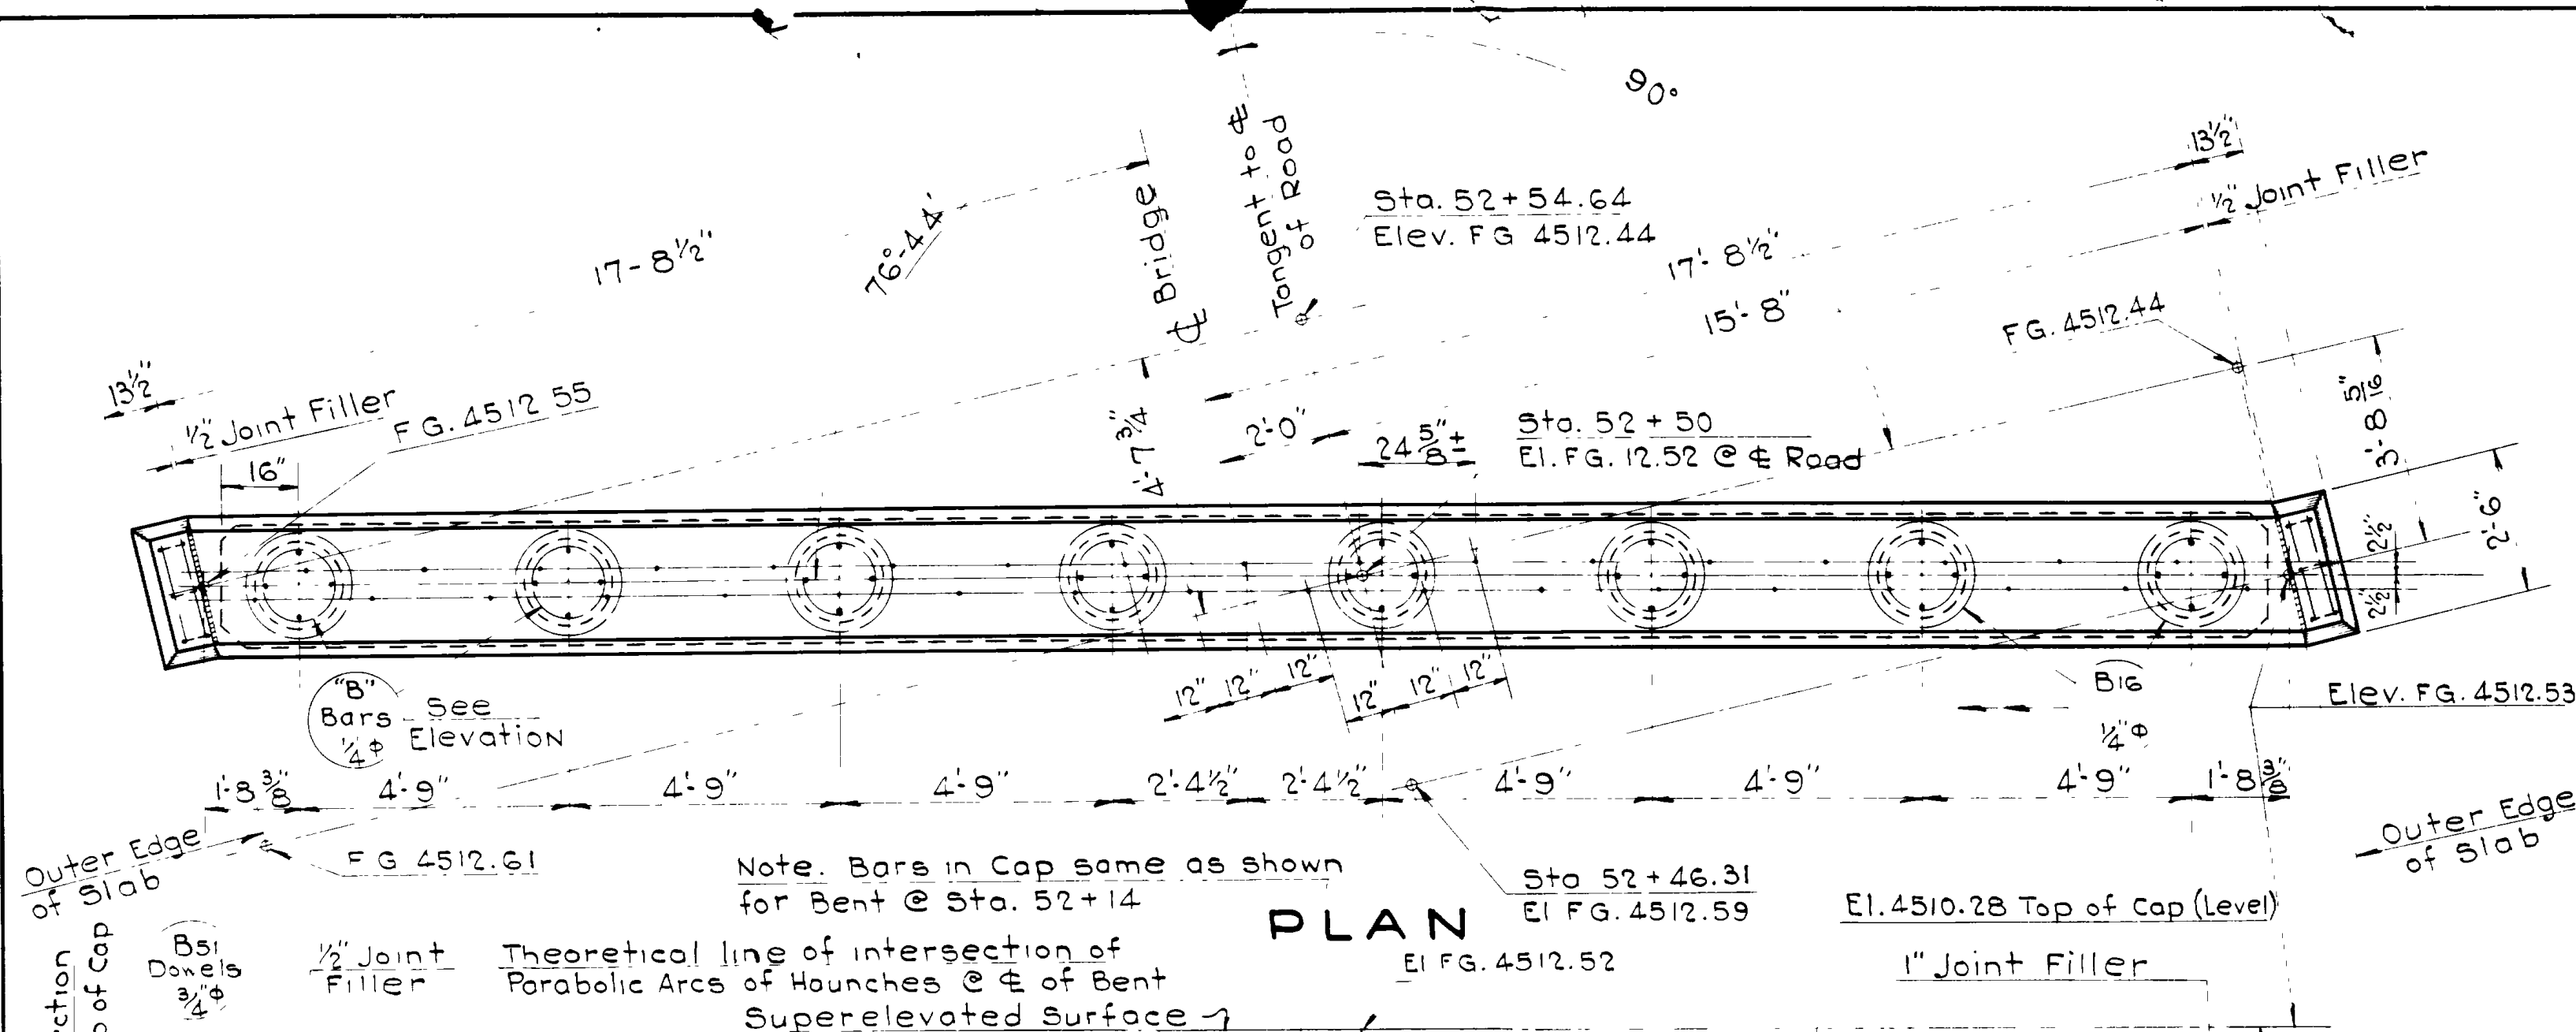


PLAN
Elev. FG. 4512.52

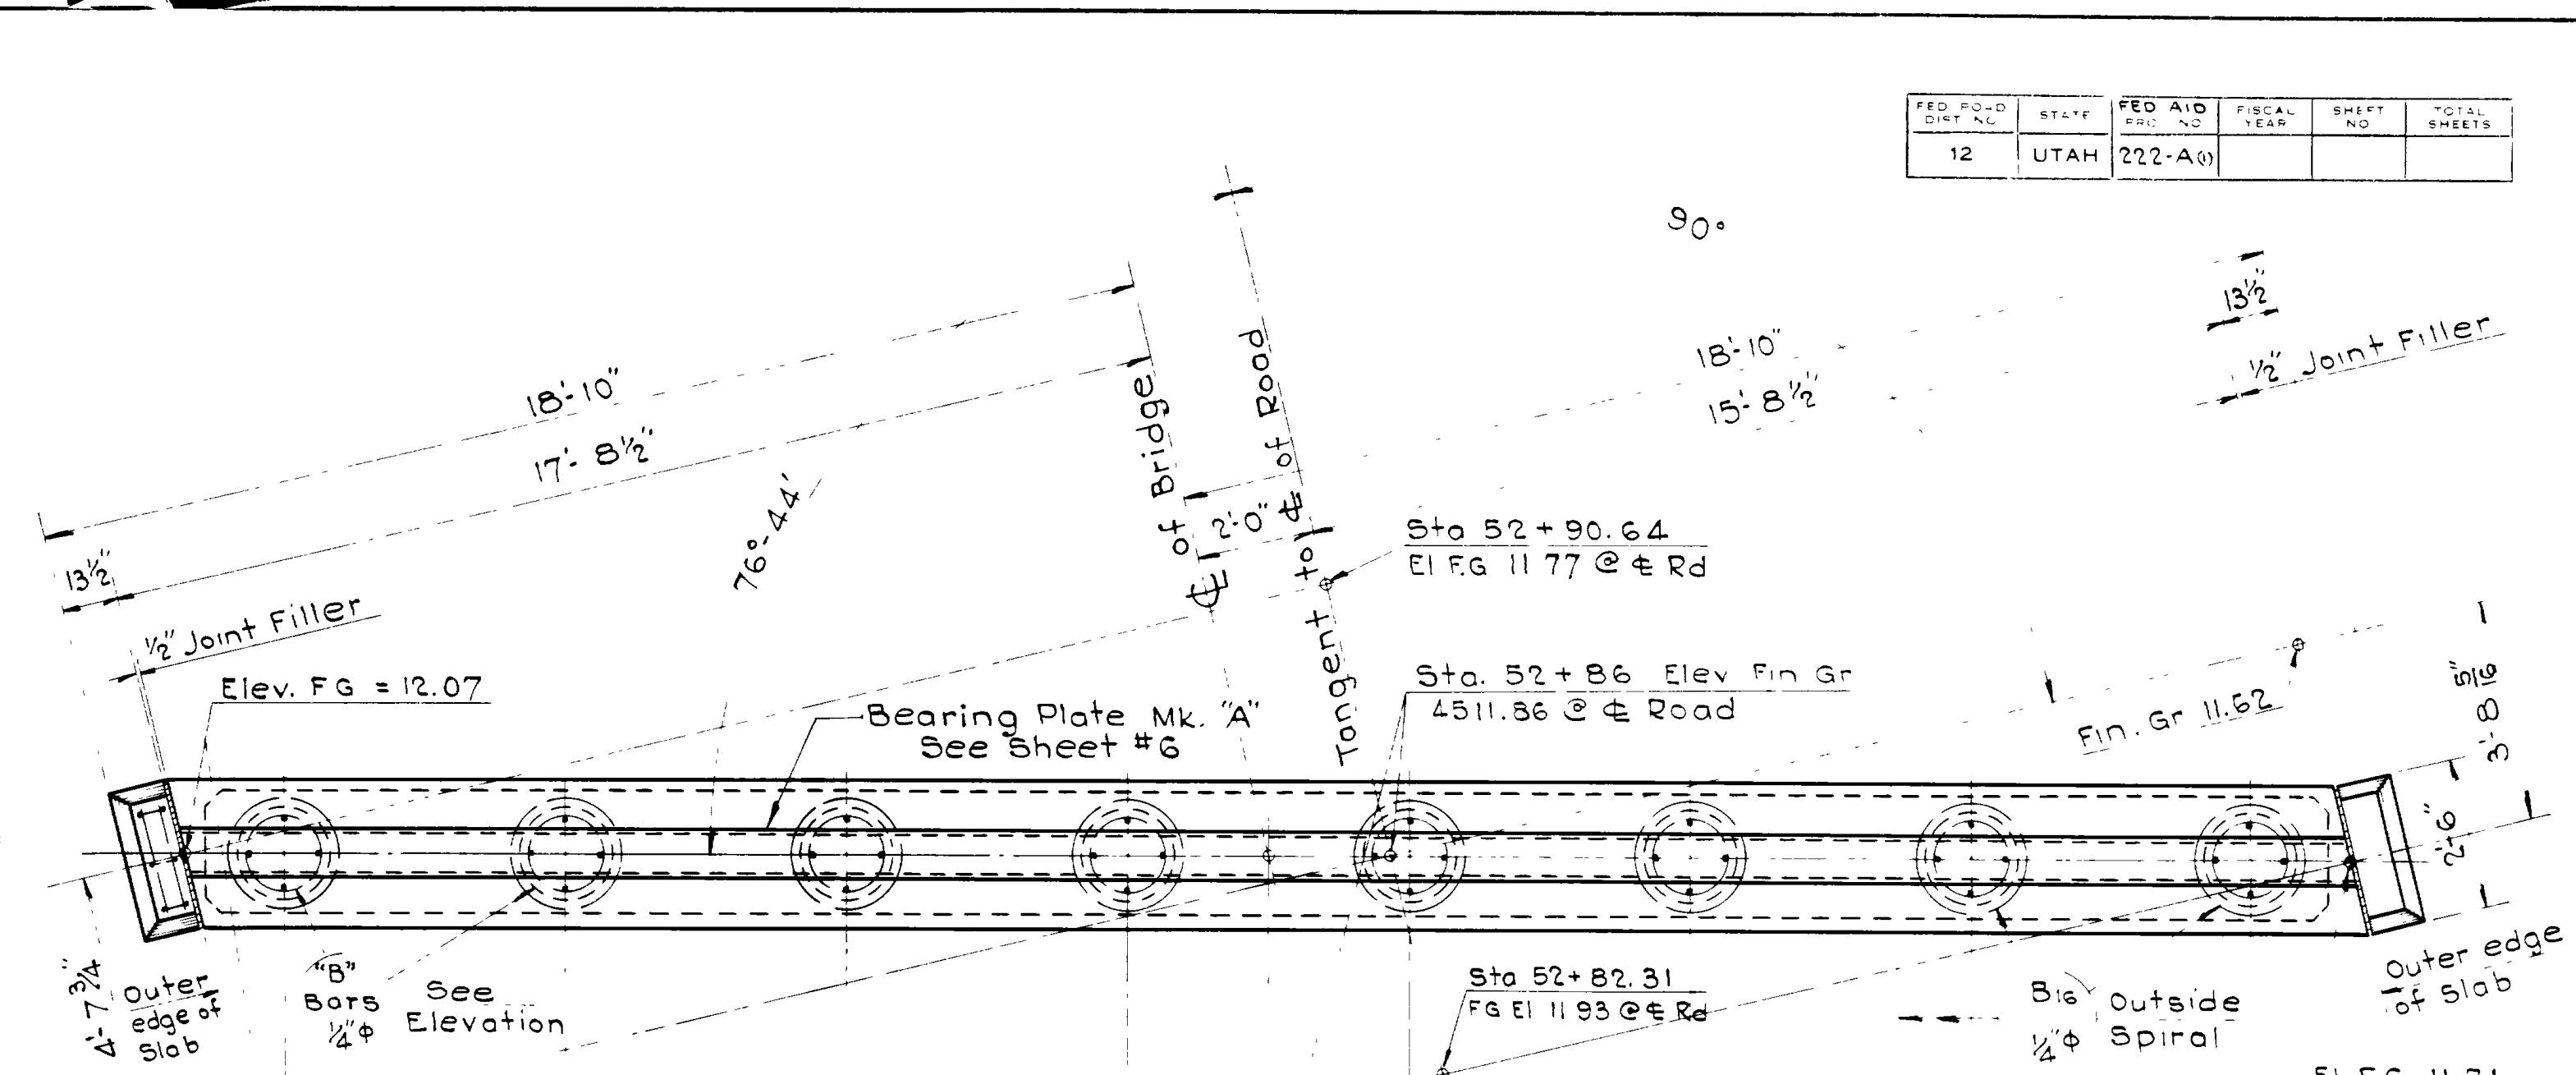

PLAN
Elev. Top of Cap = 4509.46 (Level)

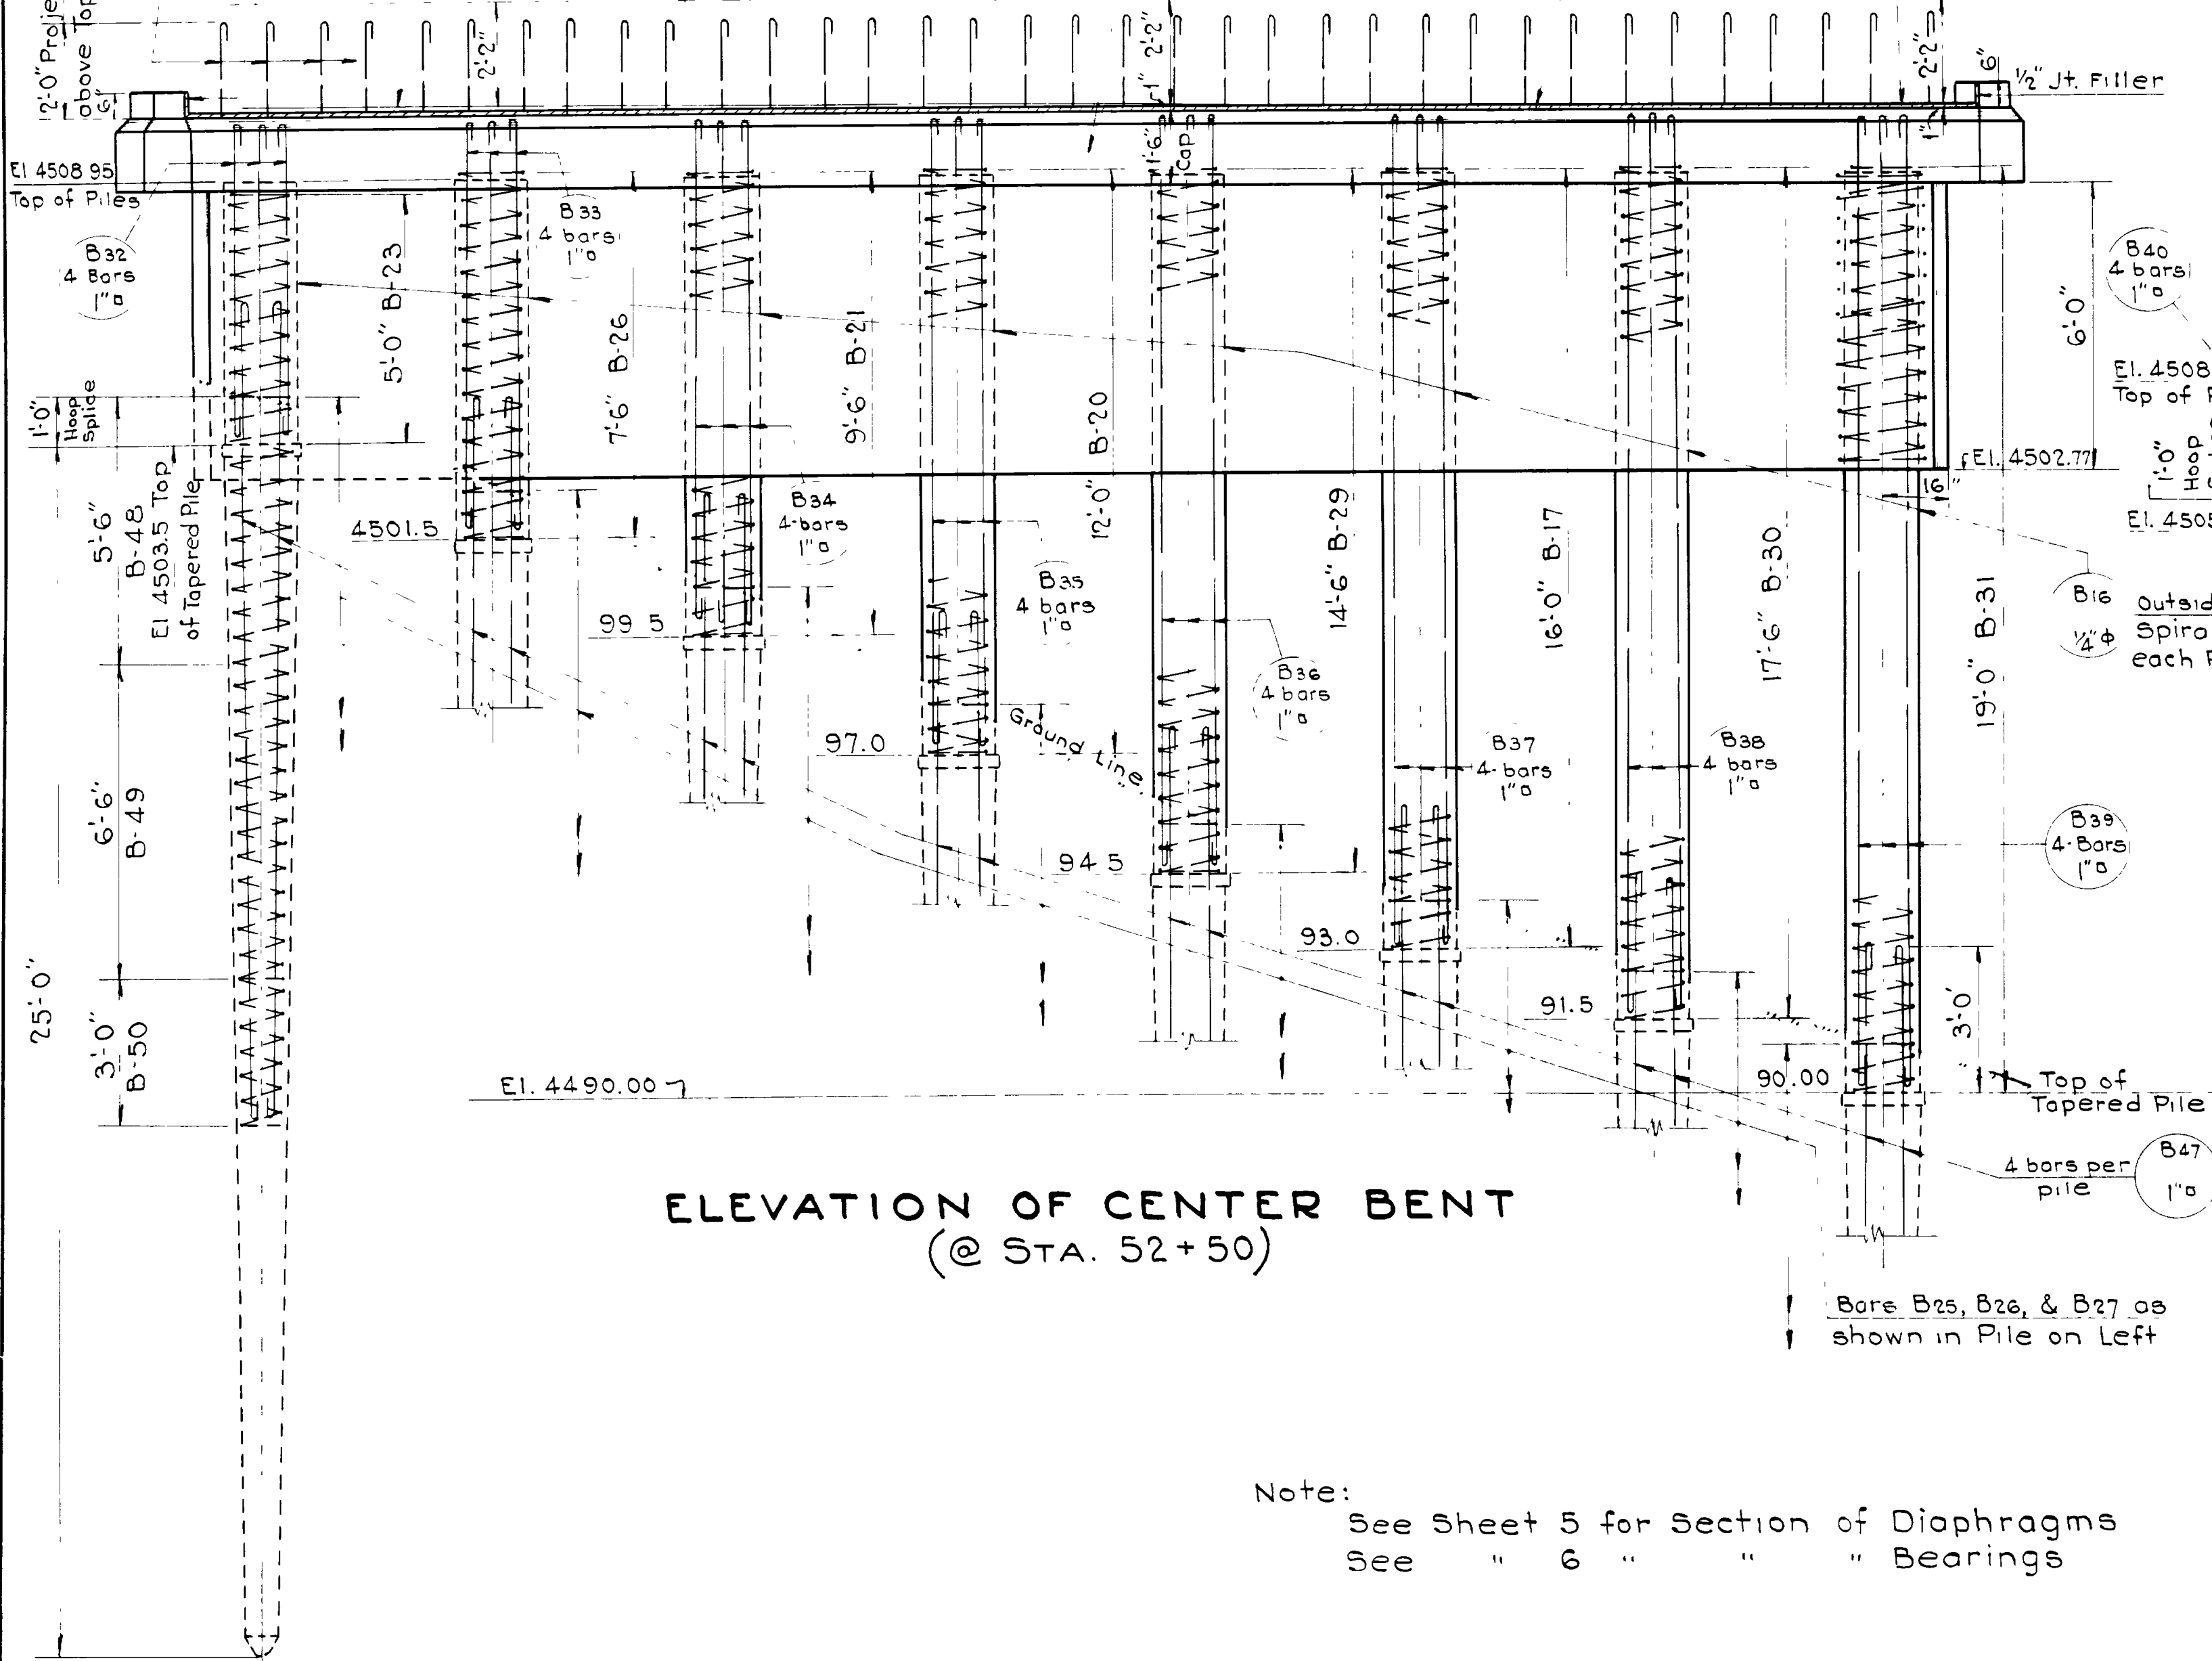

ELEVATION OF CENTER BENT
(@ STA. 52+50)

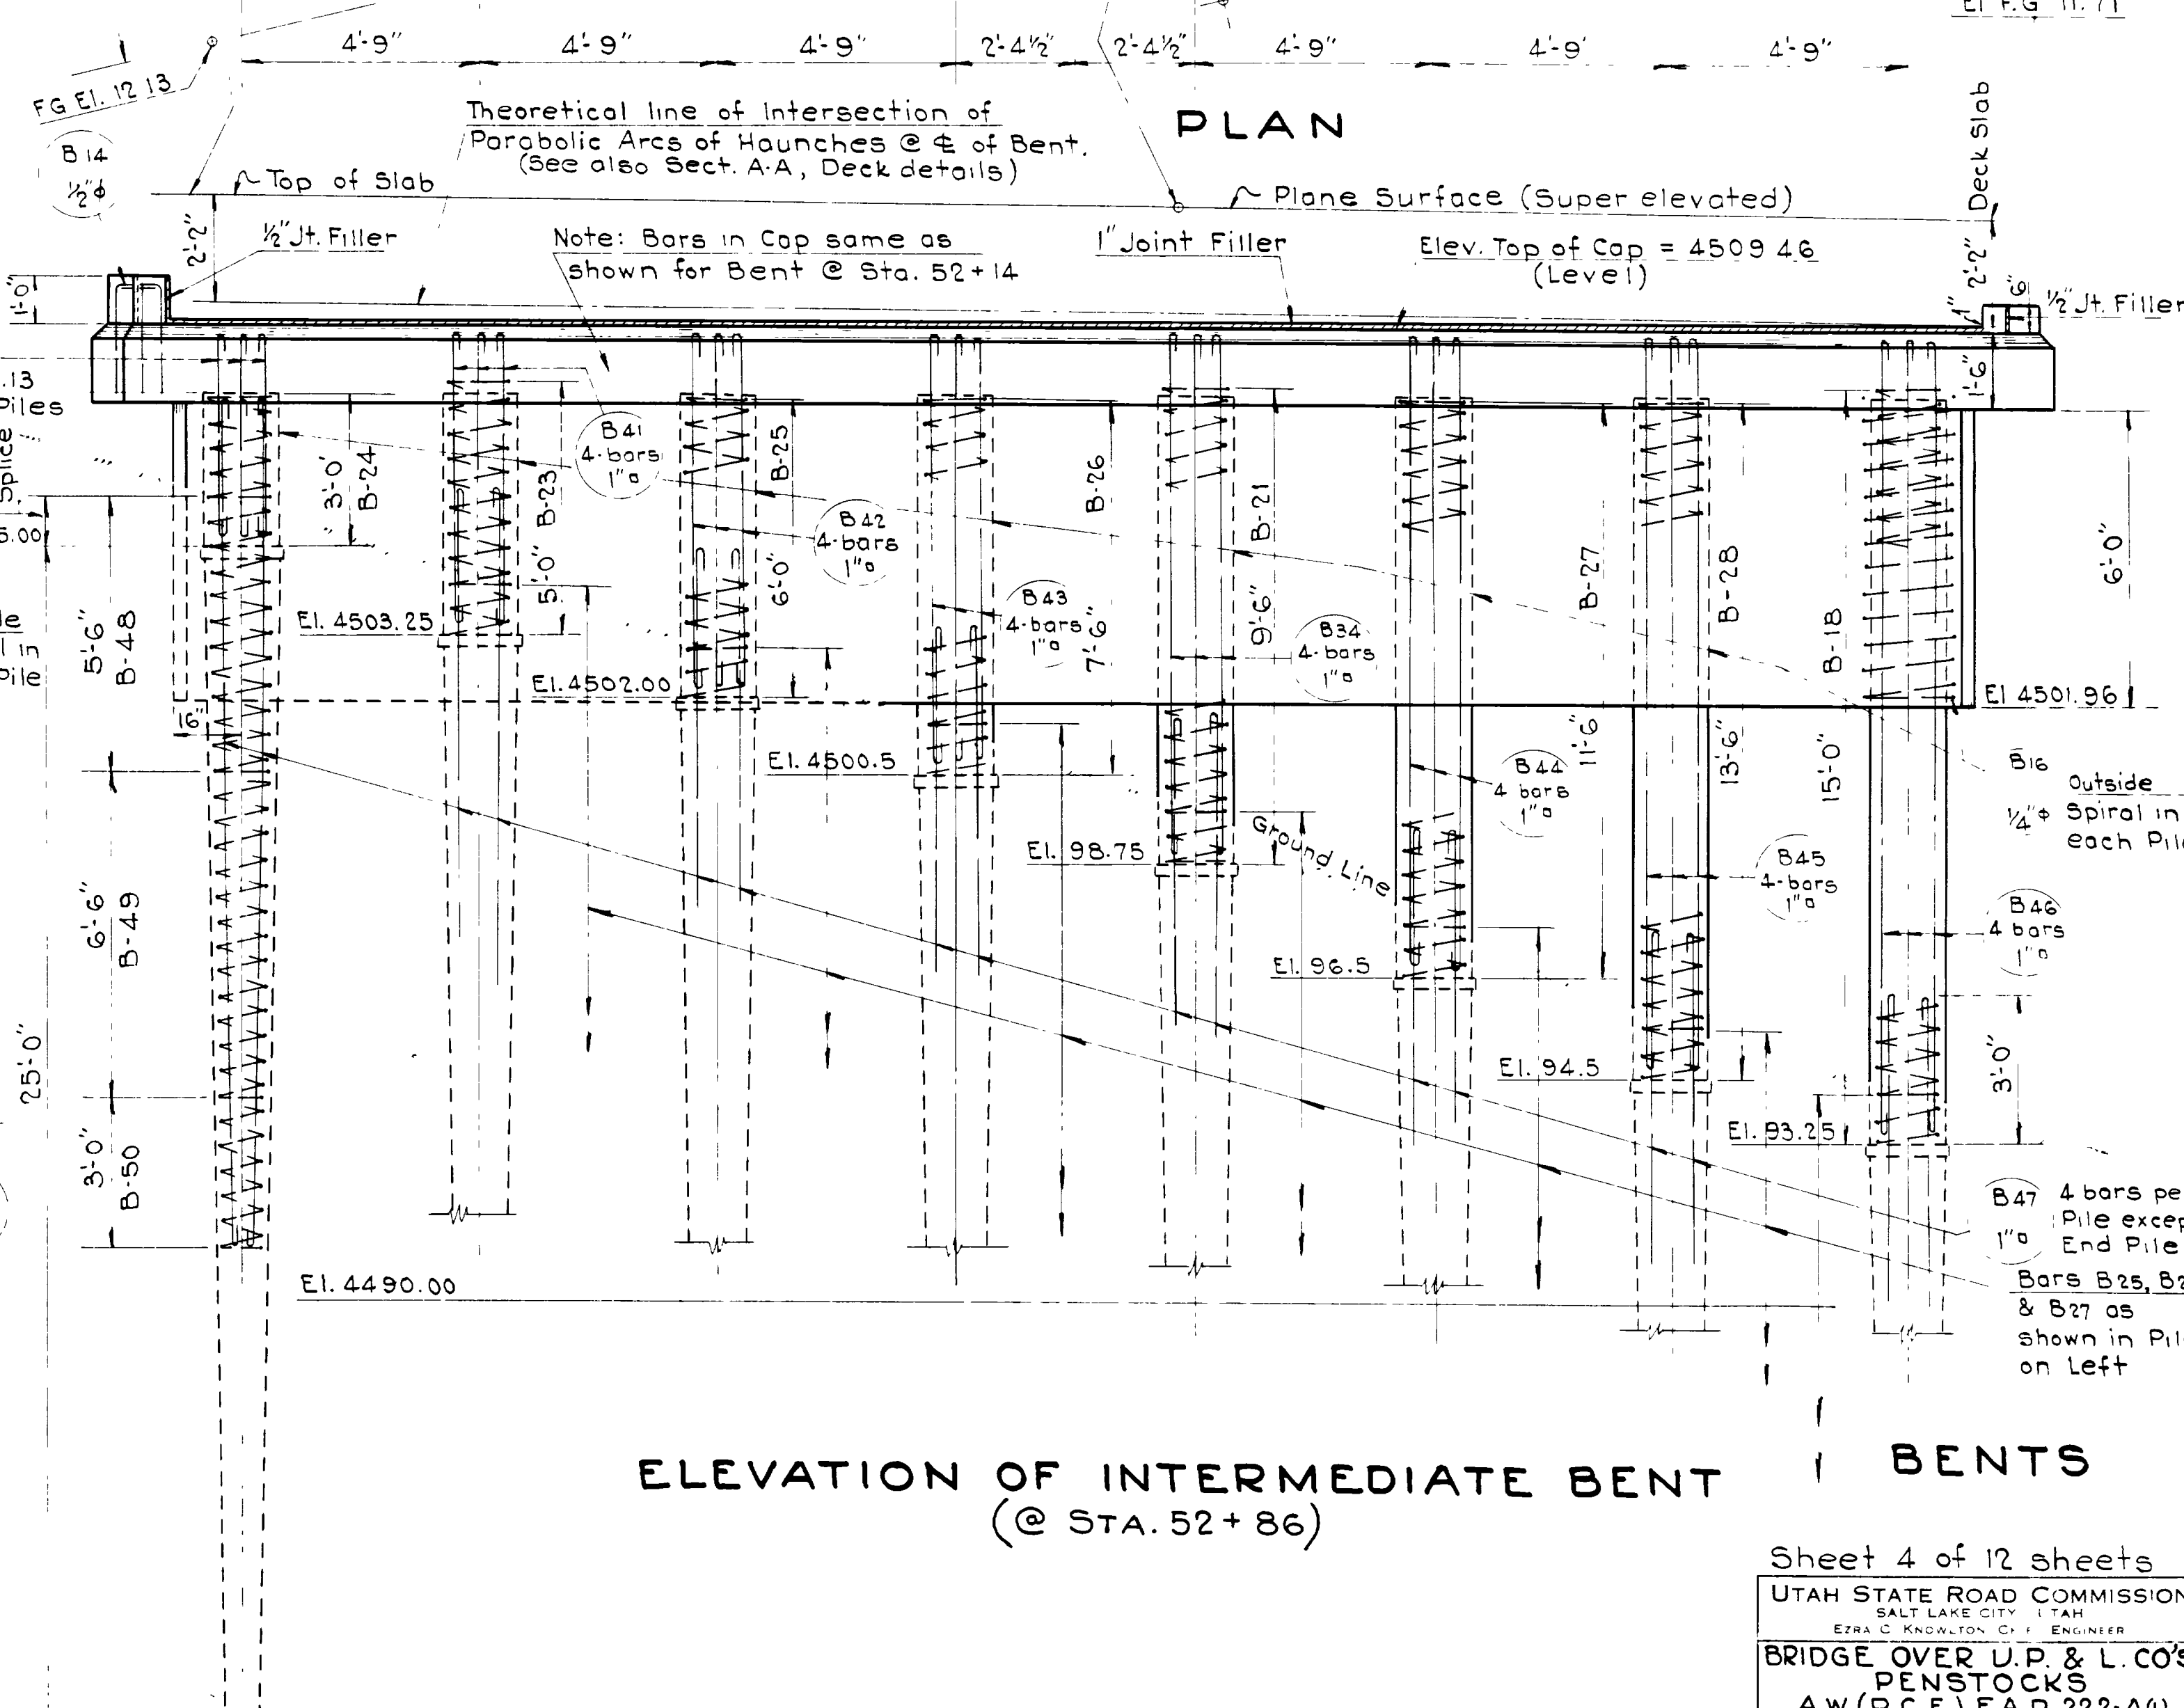

ELEVATION OF INTERMEDIATE BENT
(@ STA. 52+86)

Note:
See Sheet 5 for Section of Diaphragms
See " 6 " " " Bearings

REVISIONS	DATE	BY

Sheet 4 of 12 sheets



UTAH STATE ROAD COMMISSION
SALT LAKE CITY, UTAH
EPHA C. KNOWLTON, C.E., ENGINEER

BRIDGE OVER U.P. & L. CO'S
PENSTOCKS
A.W.(P.C.E) F.A.P. 222-A(1)
Sta 52+50 Weber Co
Ogden Arsenal - Riverdale

DESIGNED BY F.M.E. 3/8" = 1'-0"
DRAWN BY J.H.B. 10/27/41
CHECKED BY [Signature]


29-259-1-2 D-466

REC. ROAD DIST. NO.	STATE	PRO. NO.	F.S.A. YEAR	SHEET NO.	TOTAL SHEETS
12	UTAH				

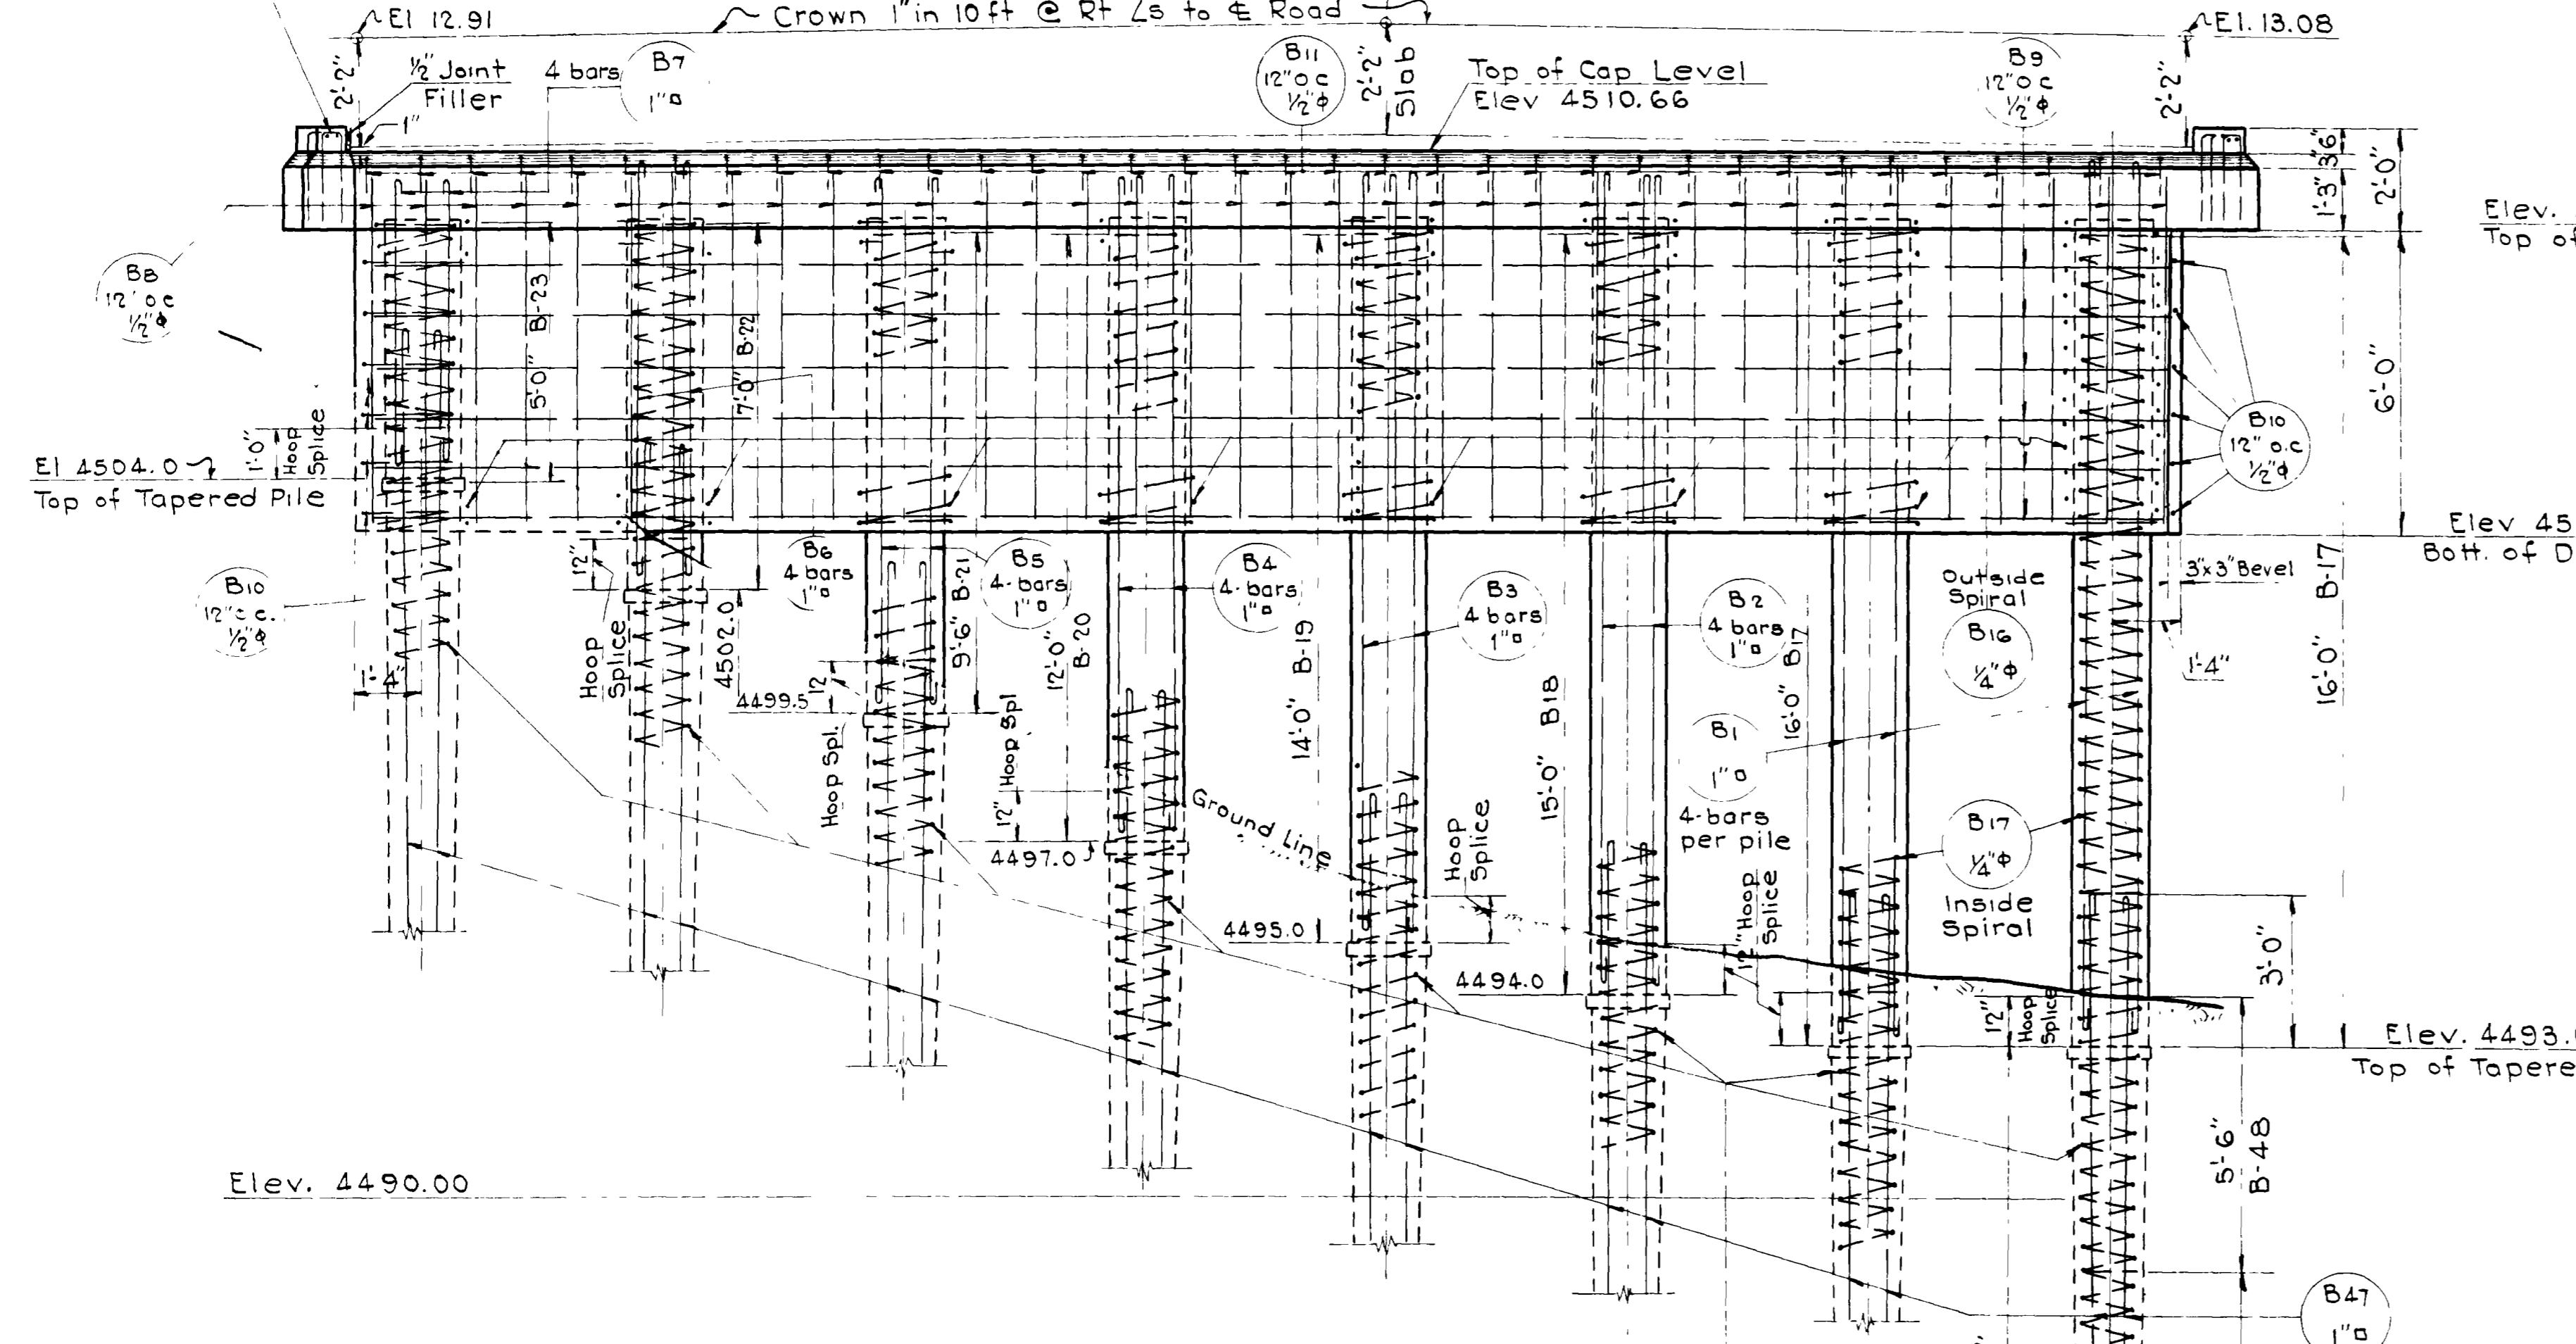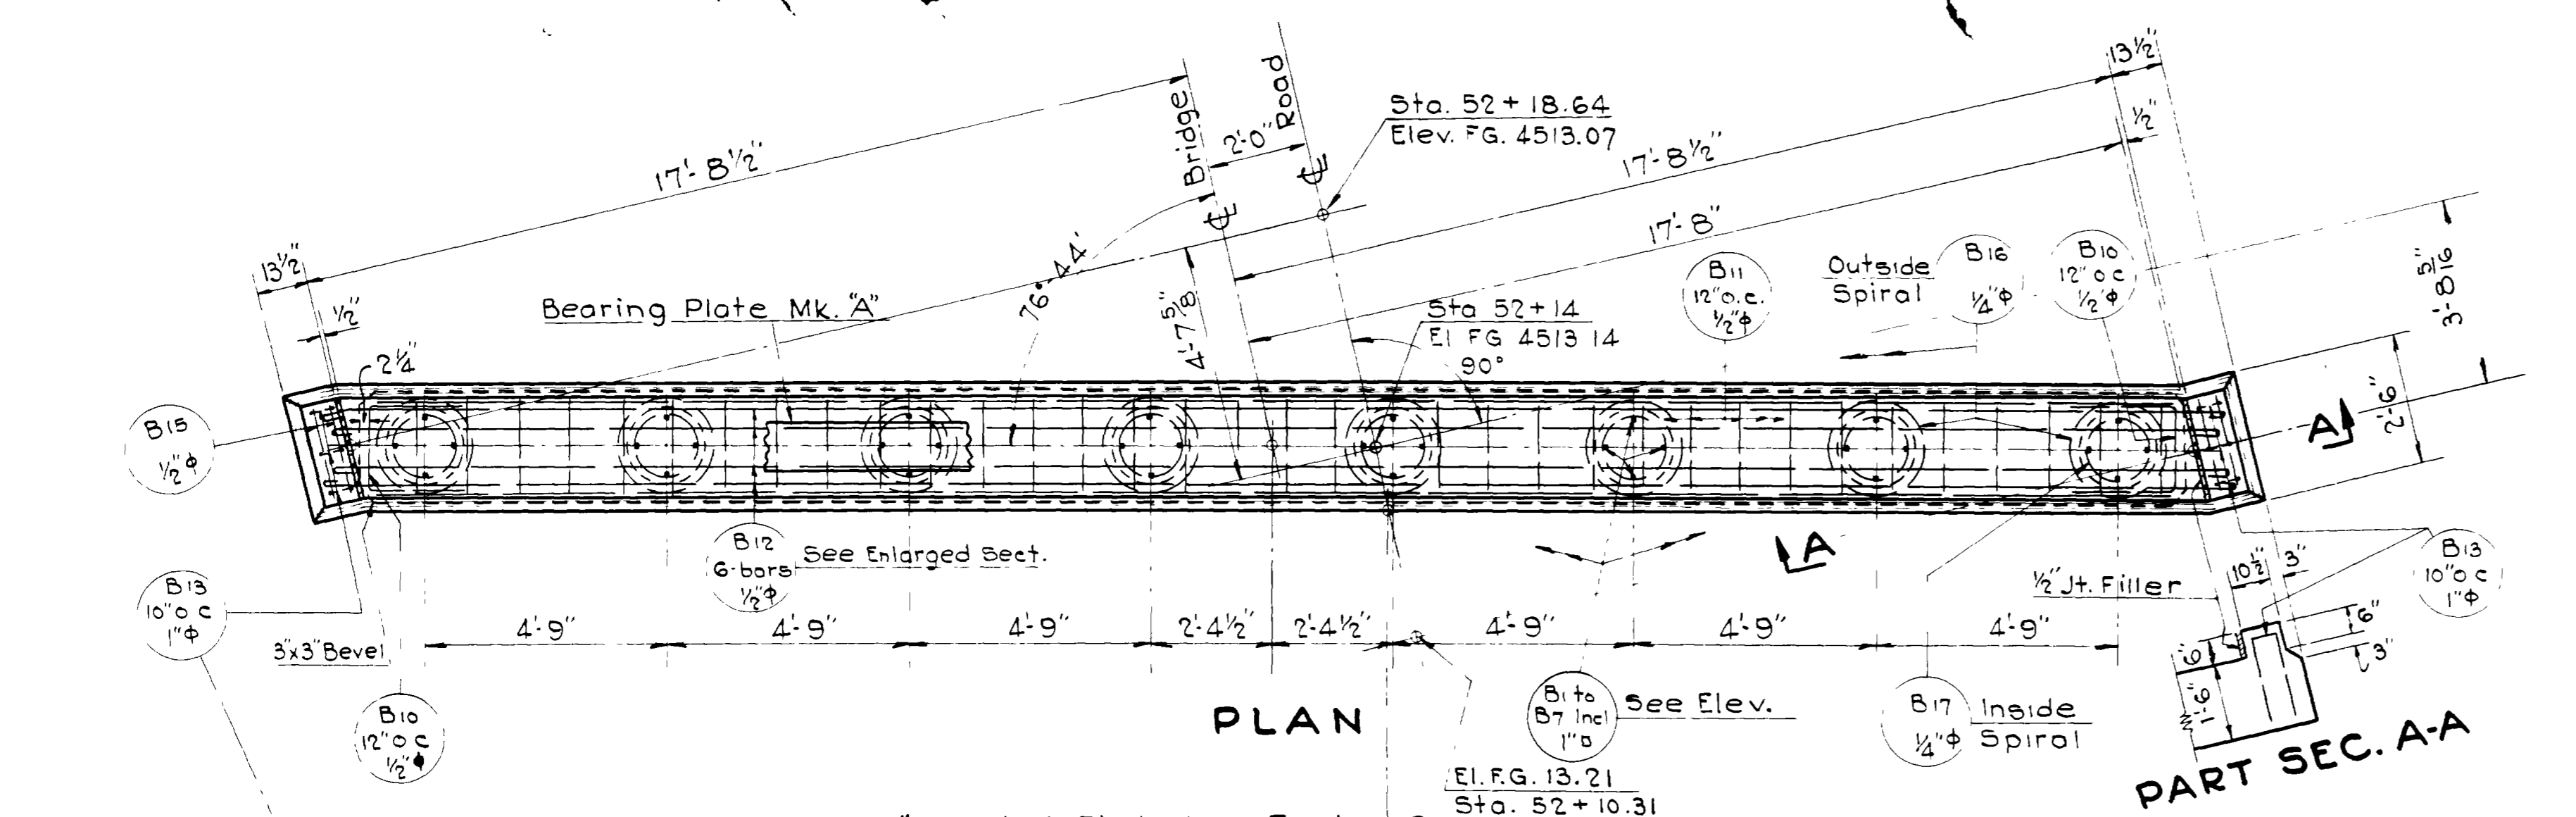


ELEVATION OF INTERMEDIATE BENT
(© Sta. 52+14)
3/8" = 1'-0"

Tapered Inside Spirals as shown in Pile on Right →

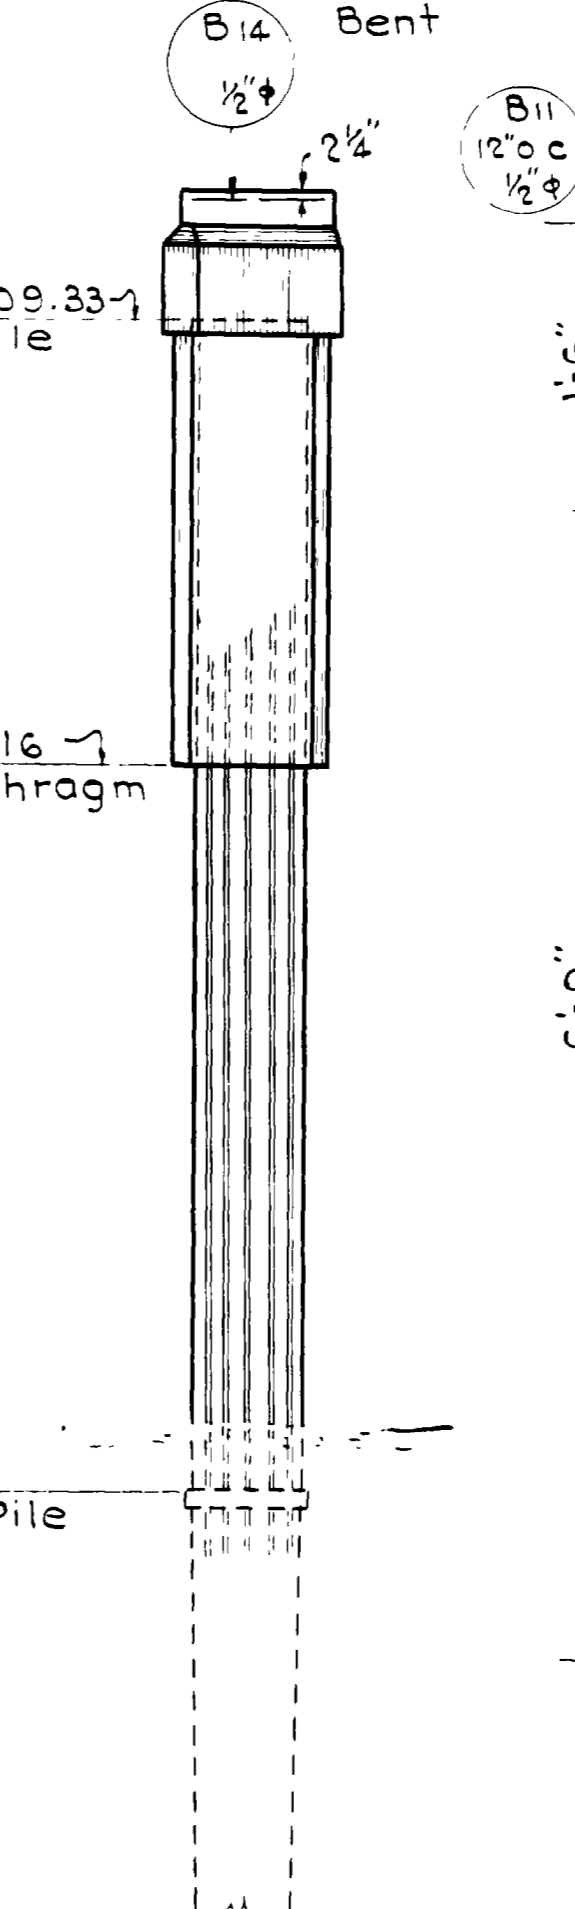


END ELEVATION

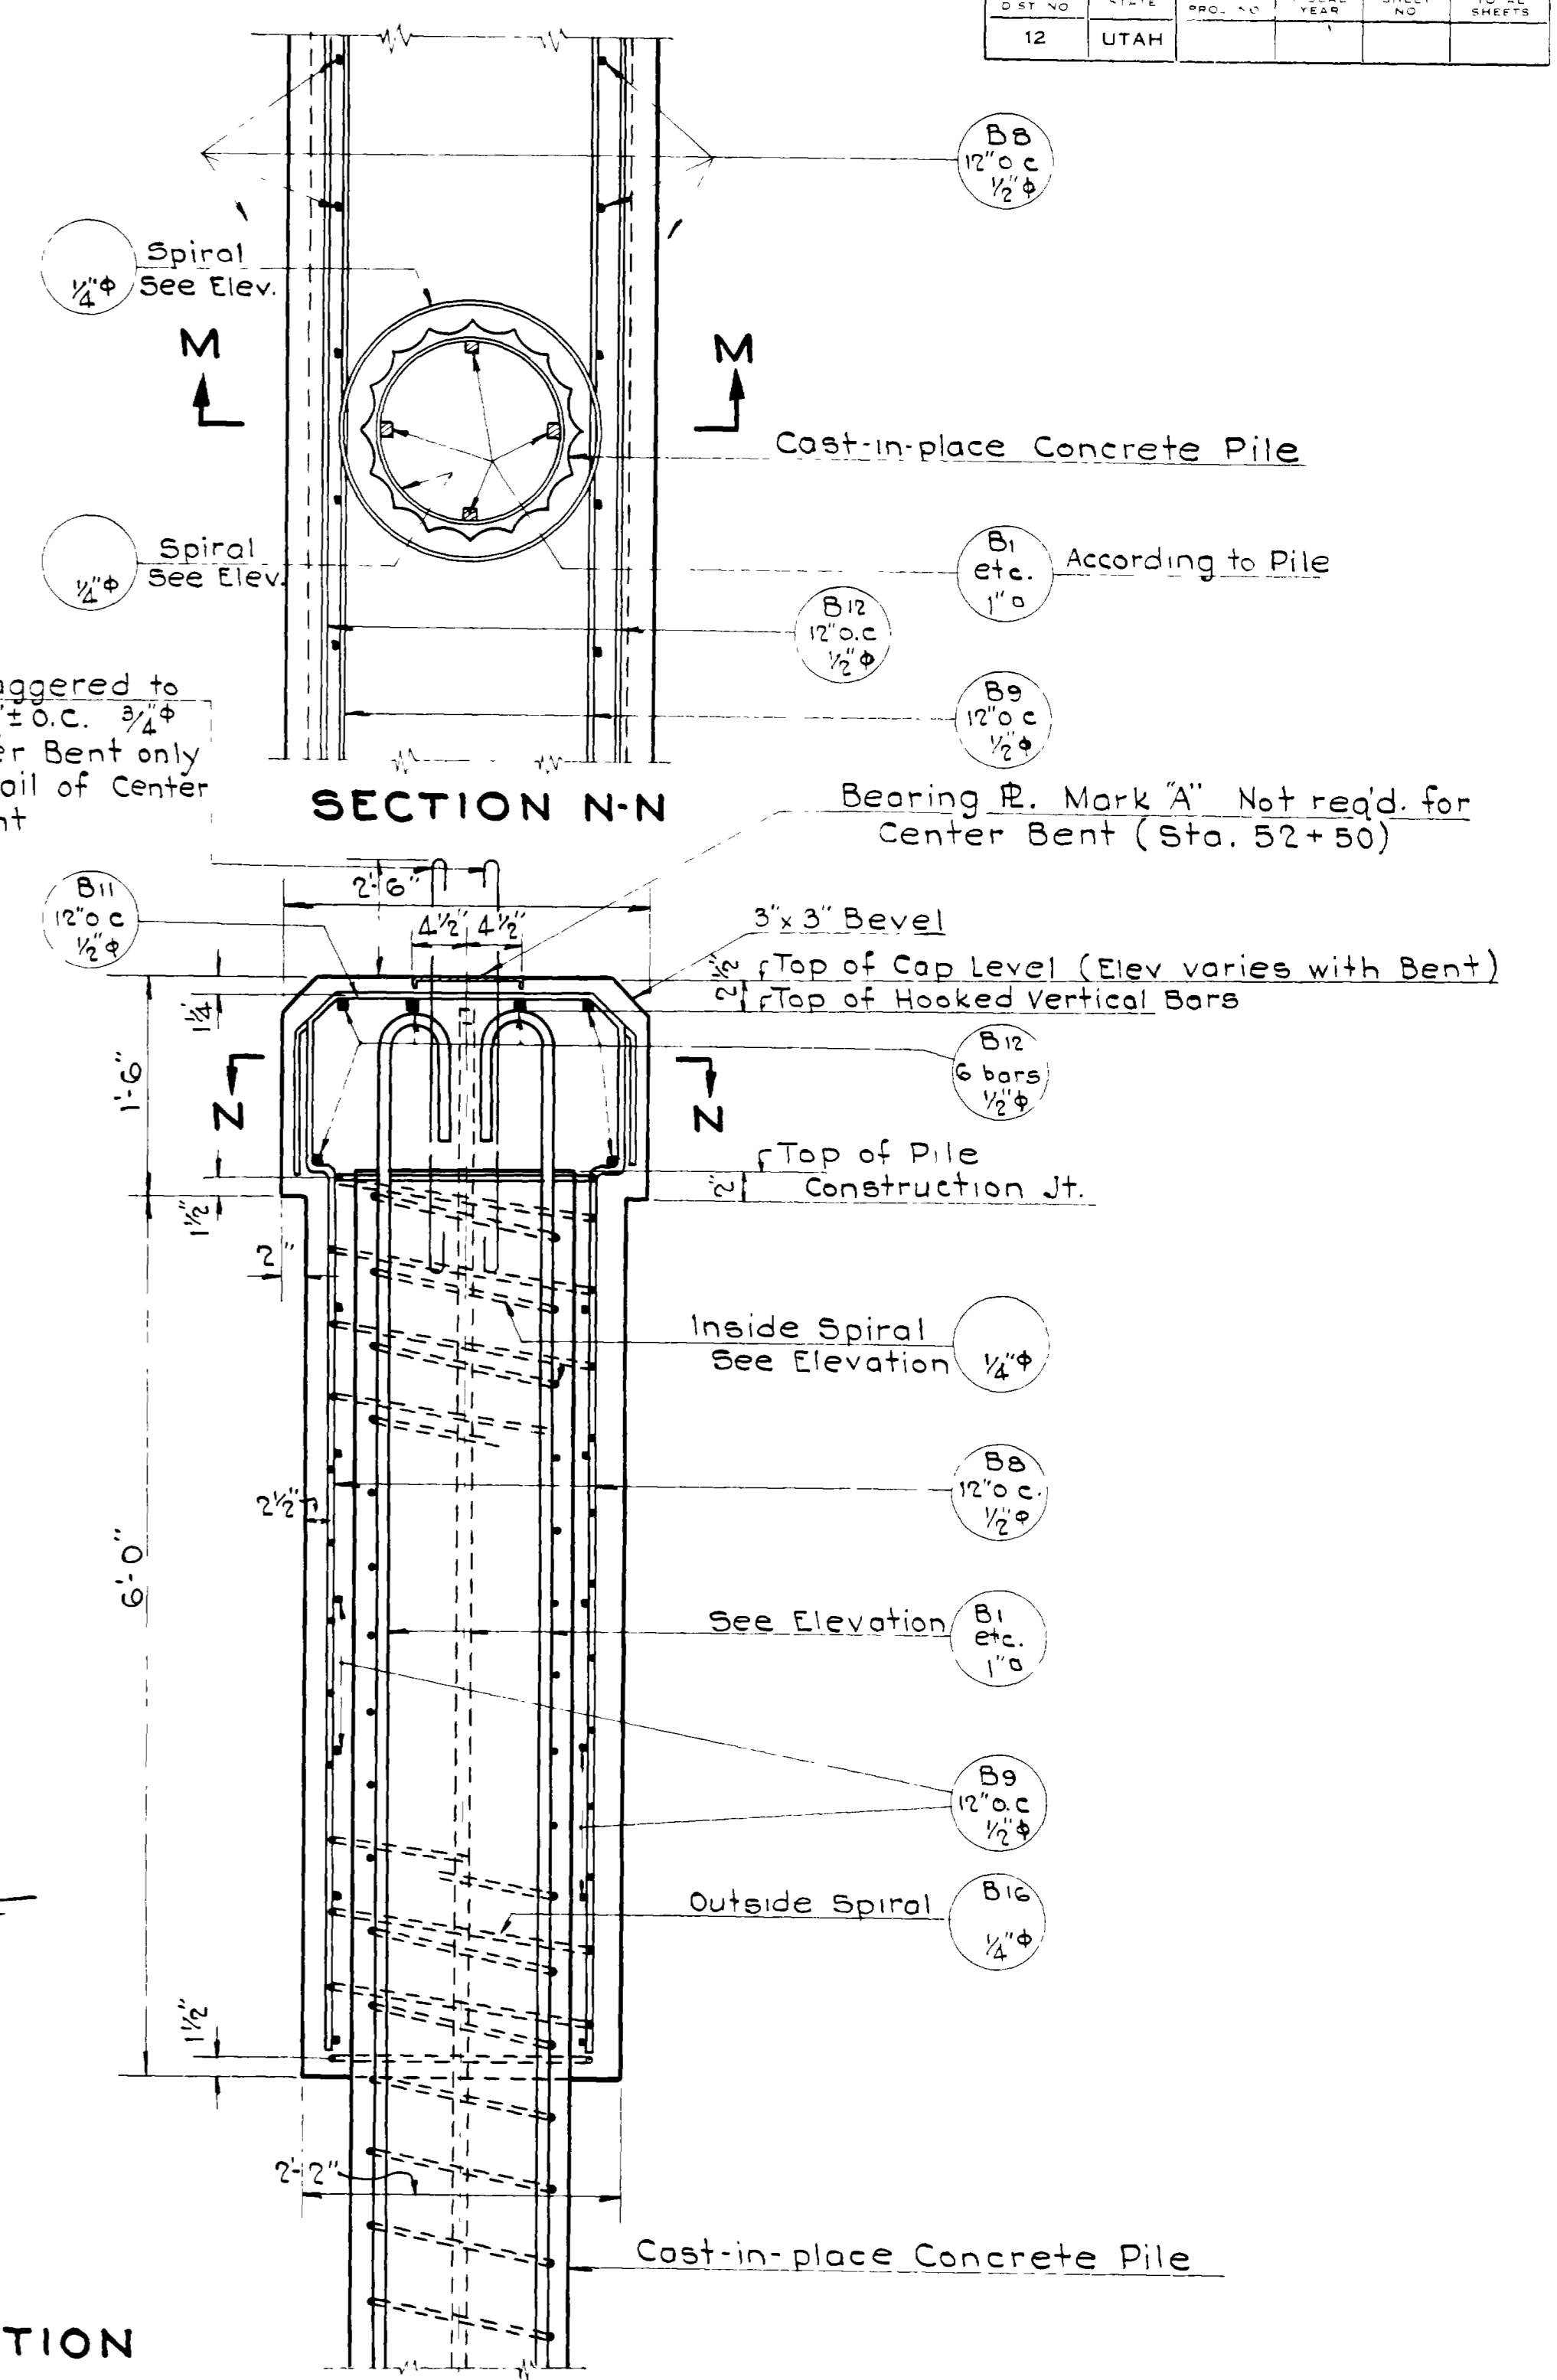


ENLARGED SECTION M-M
1" = 1'-0"


(Typical of All Piles in the Intermediate Bents)

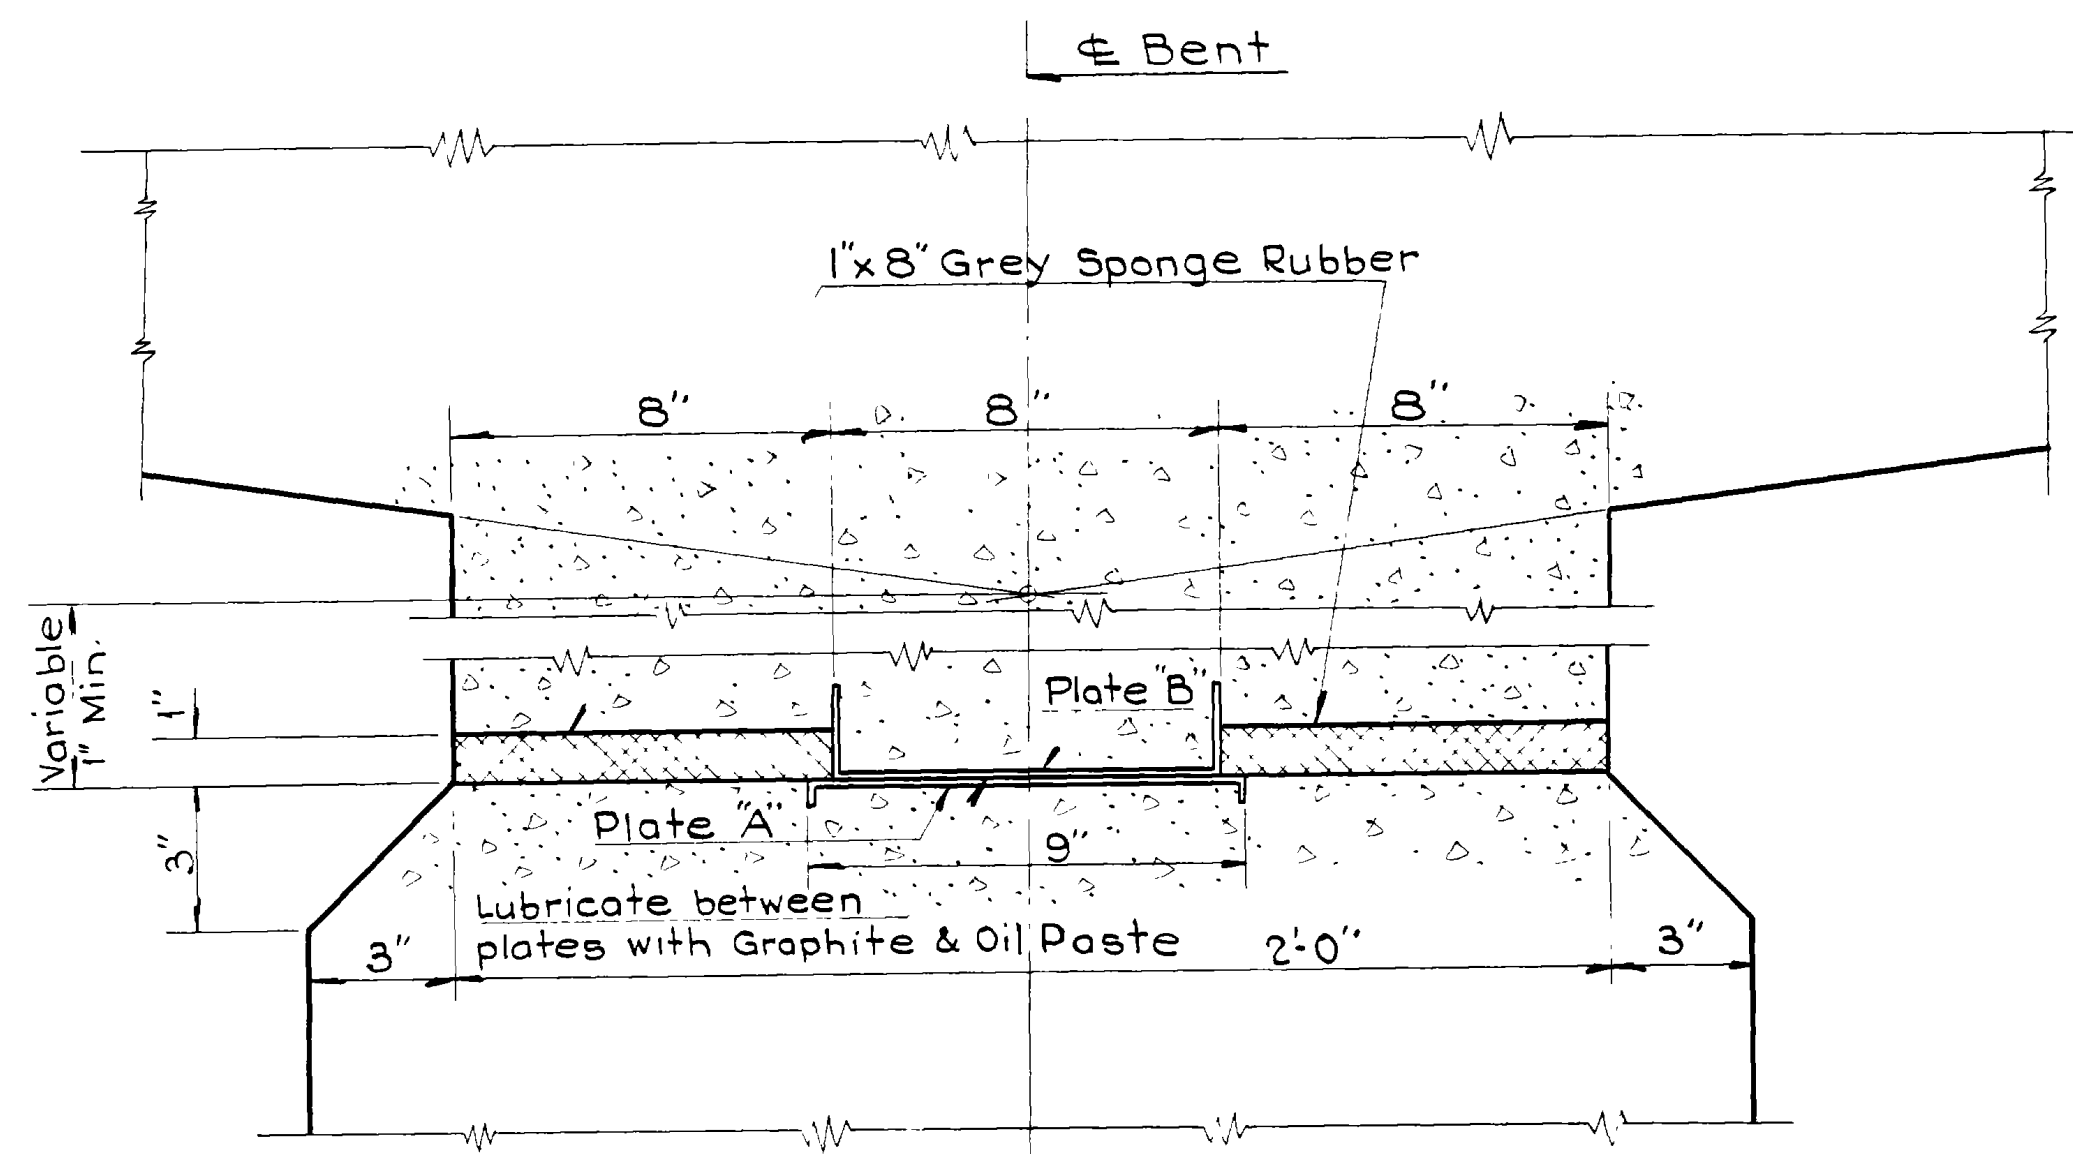


DETAIL OF FREE BEARINGS - INT. BENTS

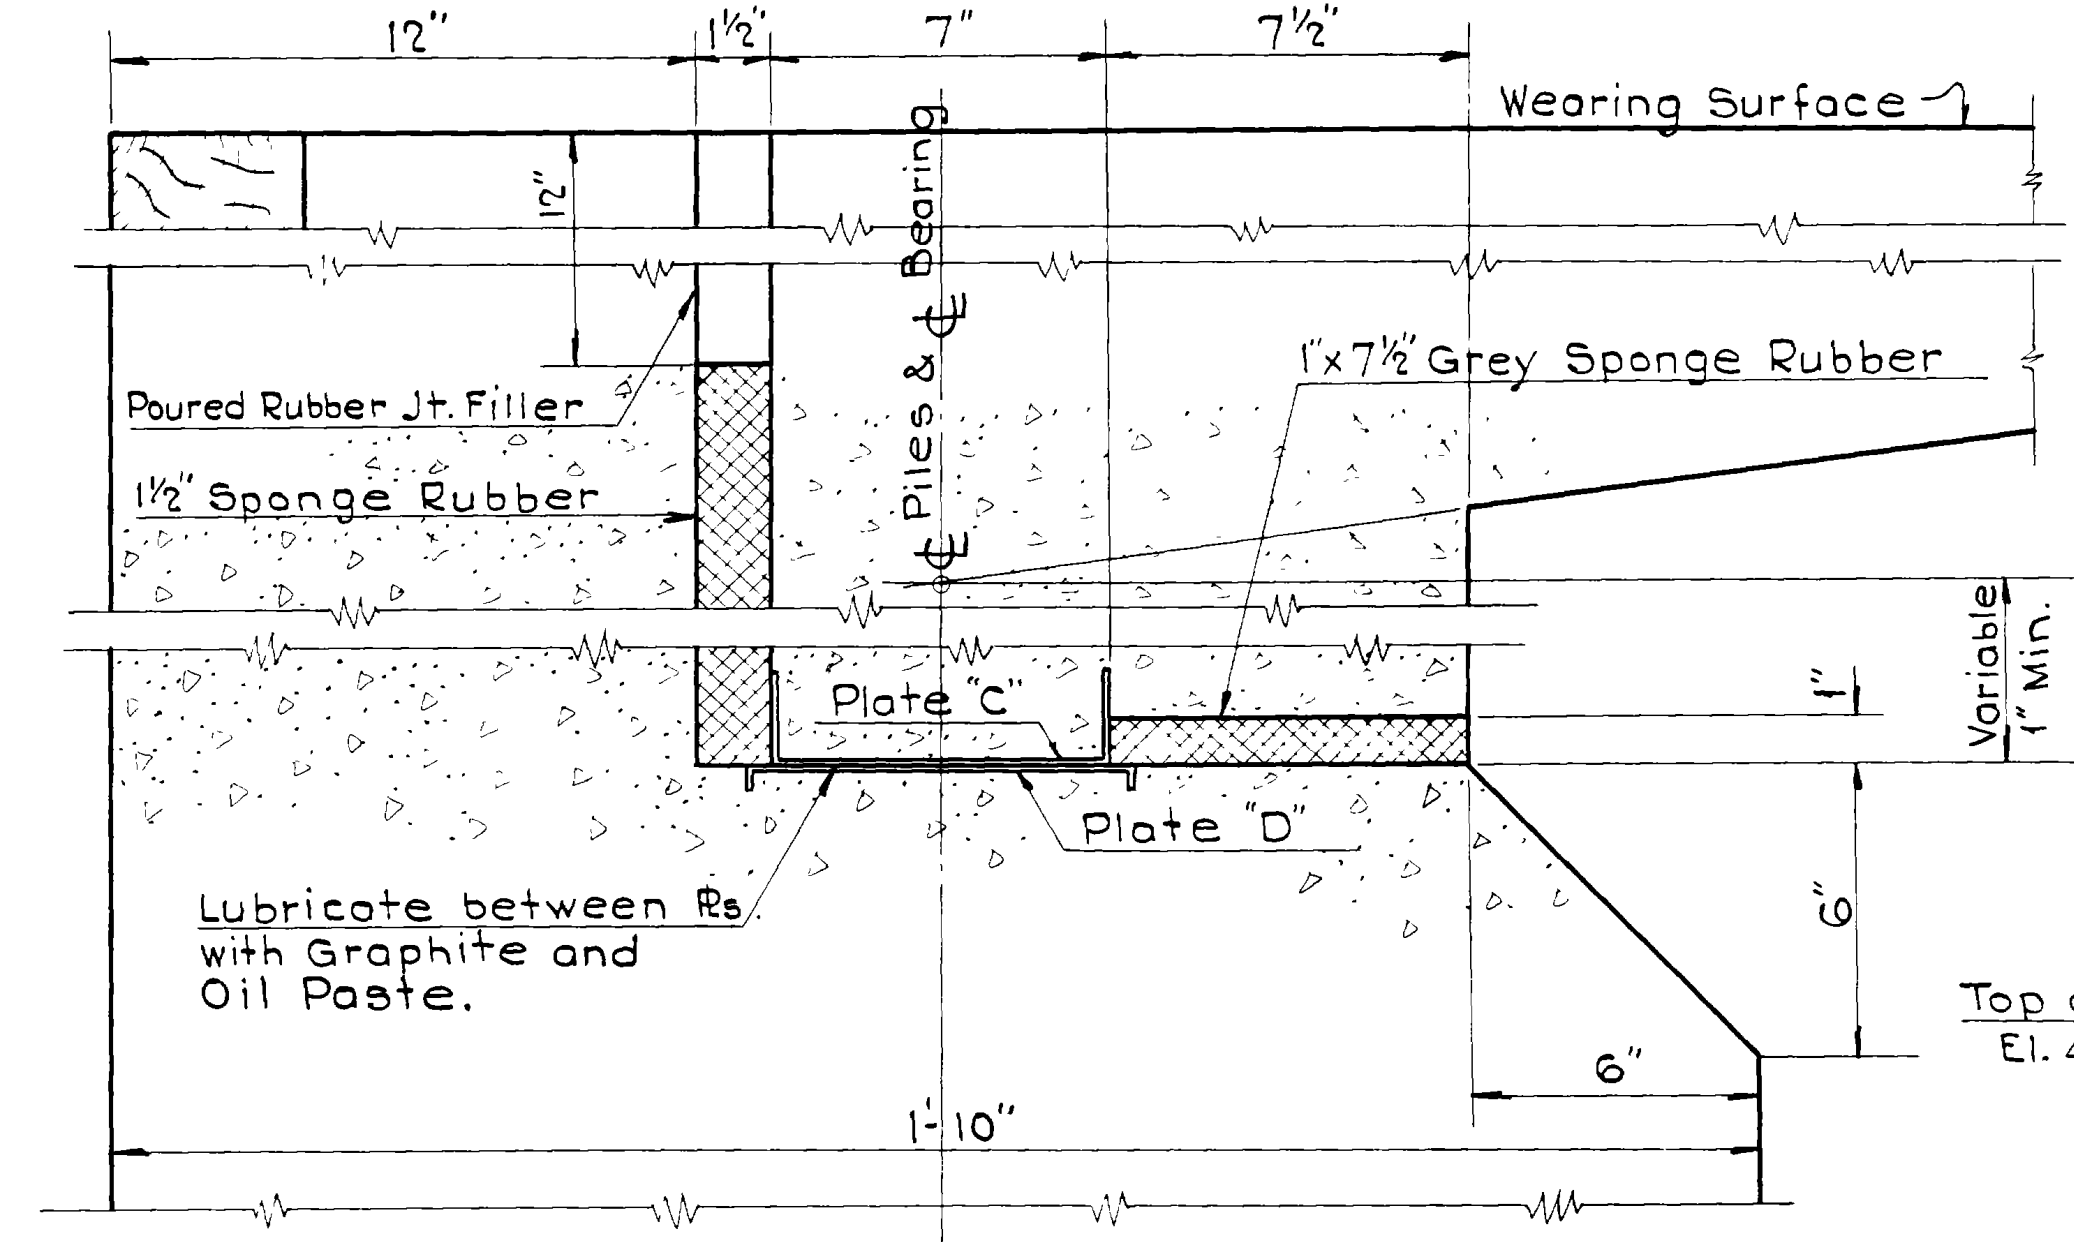

DETAIL OF BEARING AT ABUTMENTS FREE ENDS

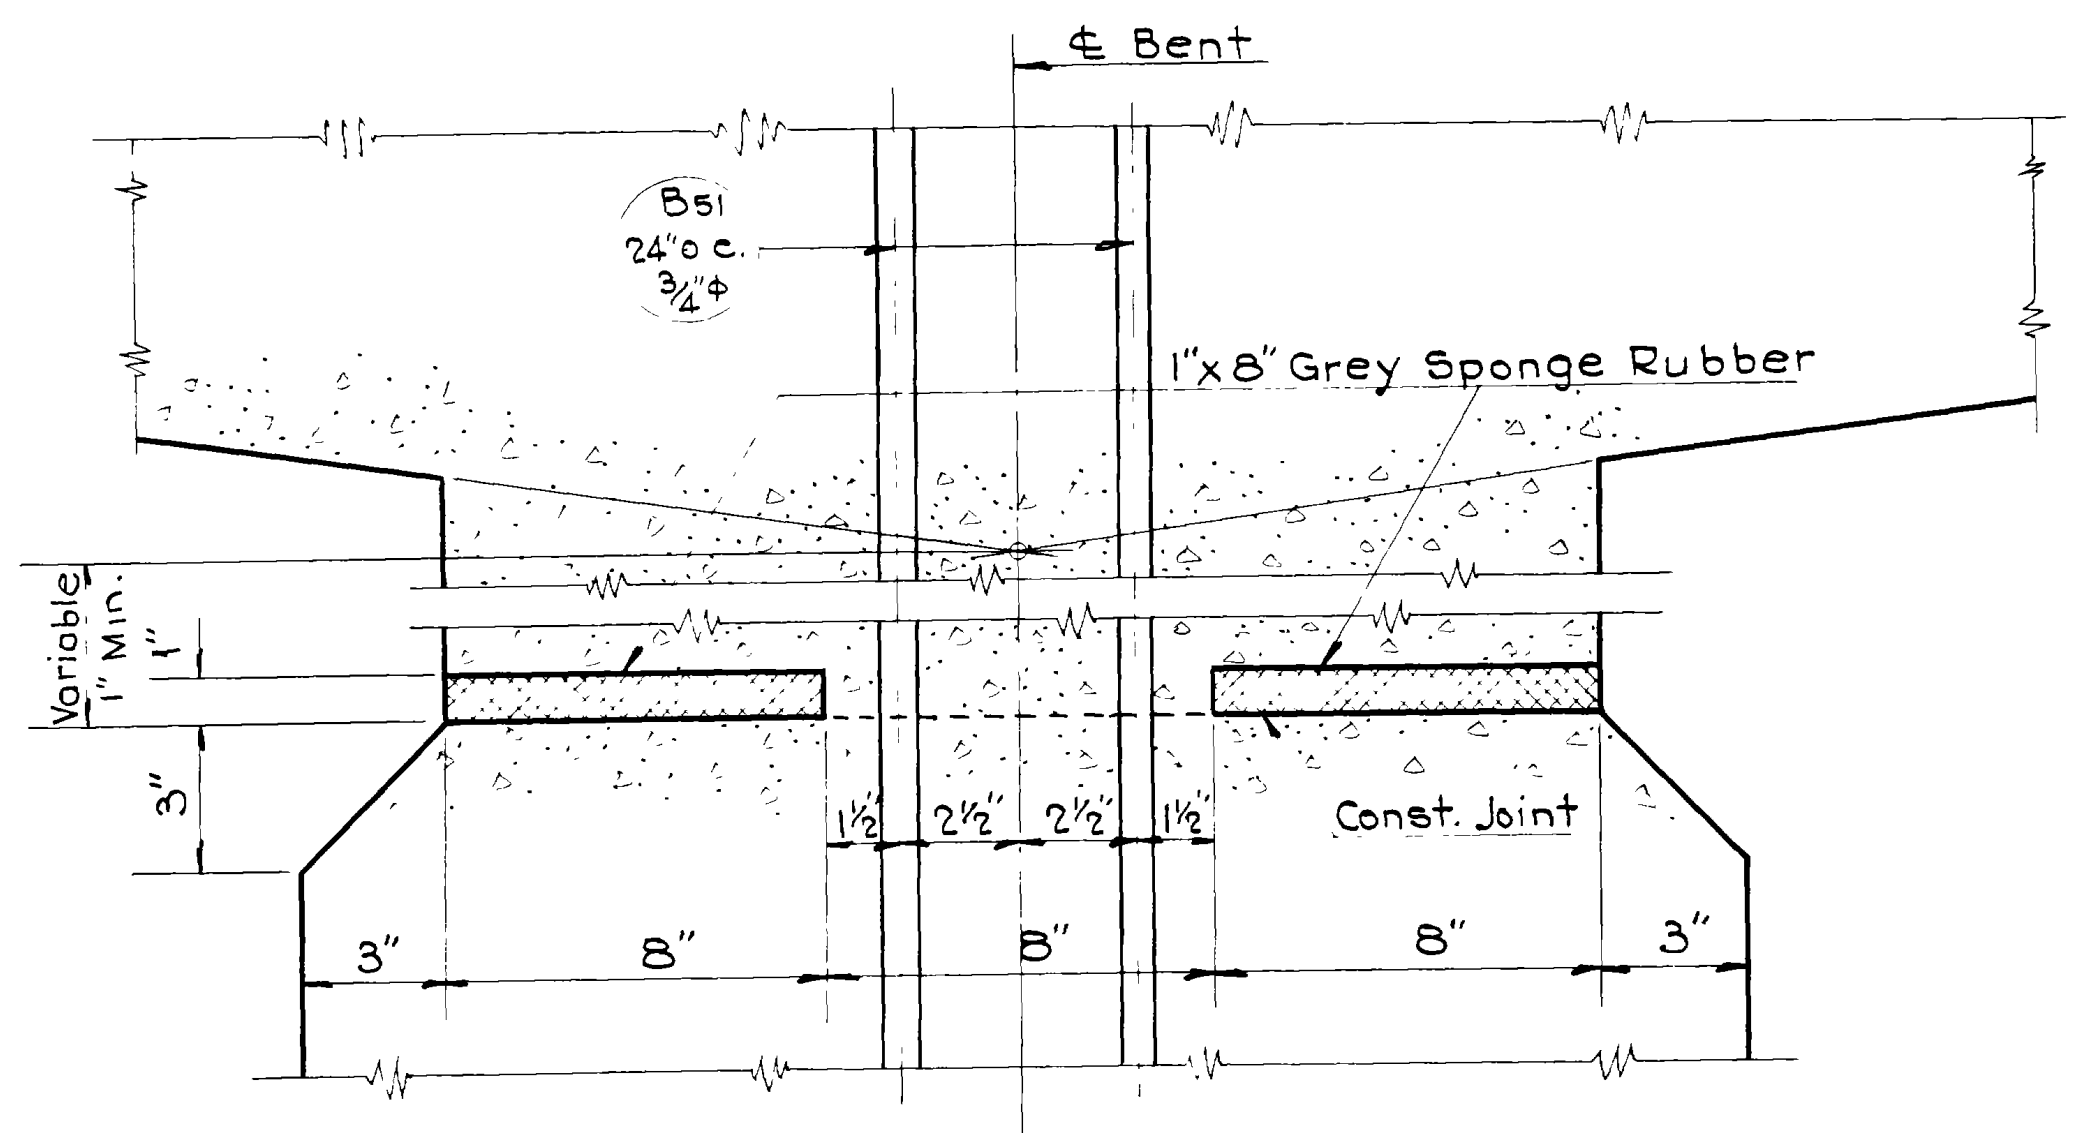


DETAIL OF FIXED BEARING - CENTER BENT

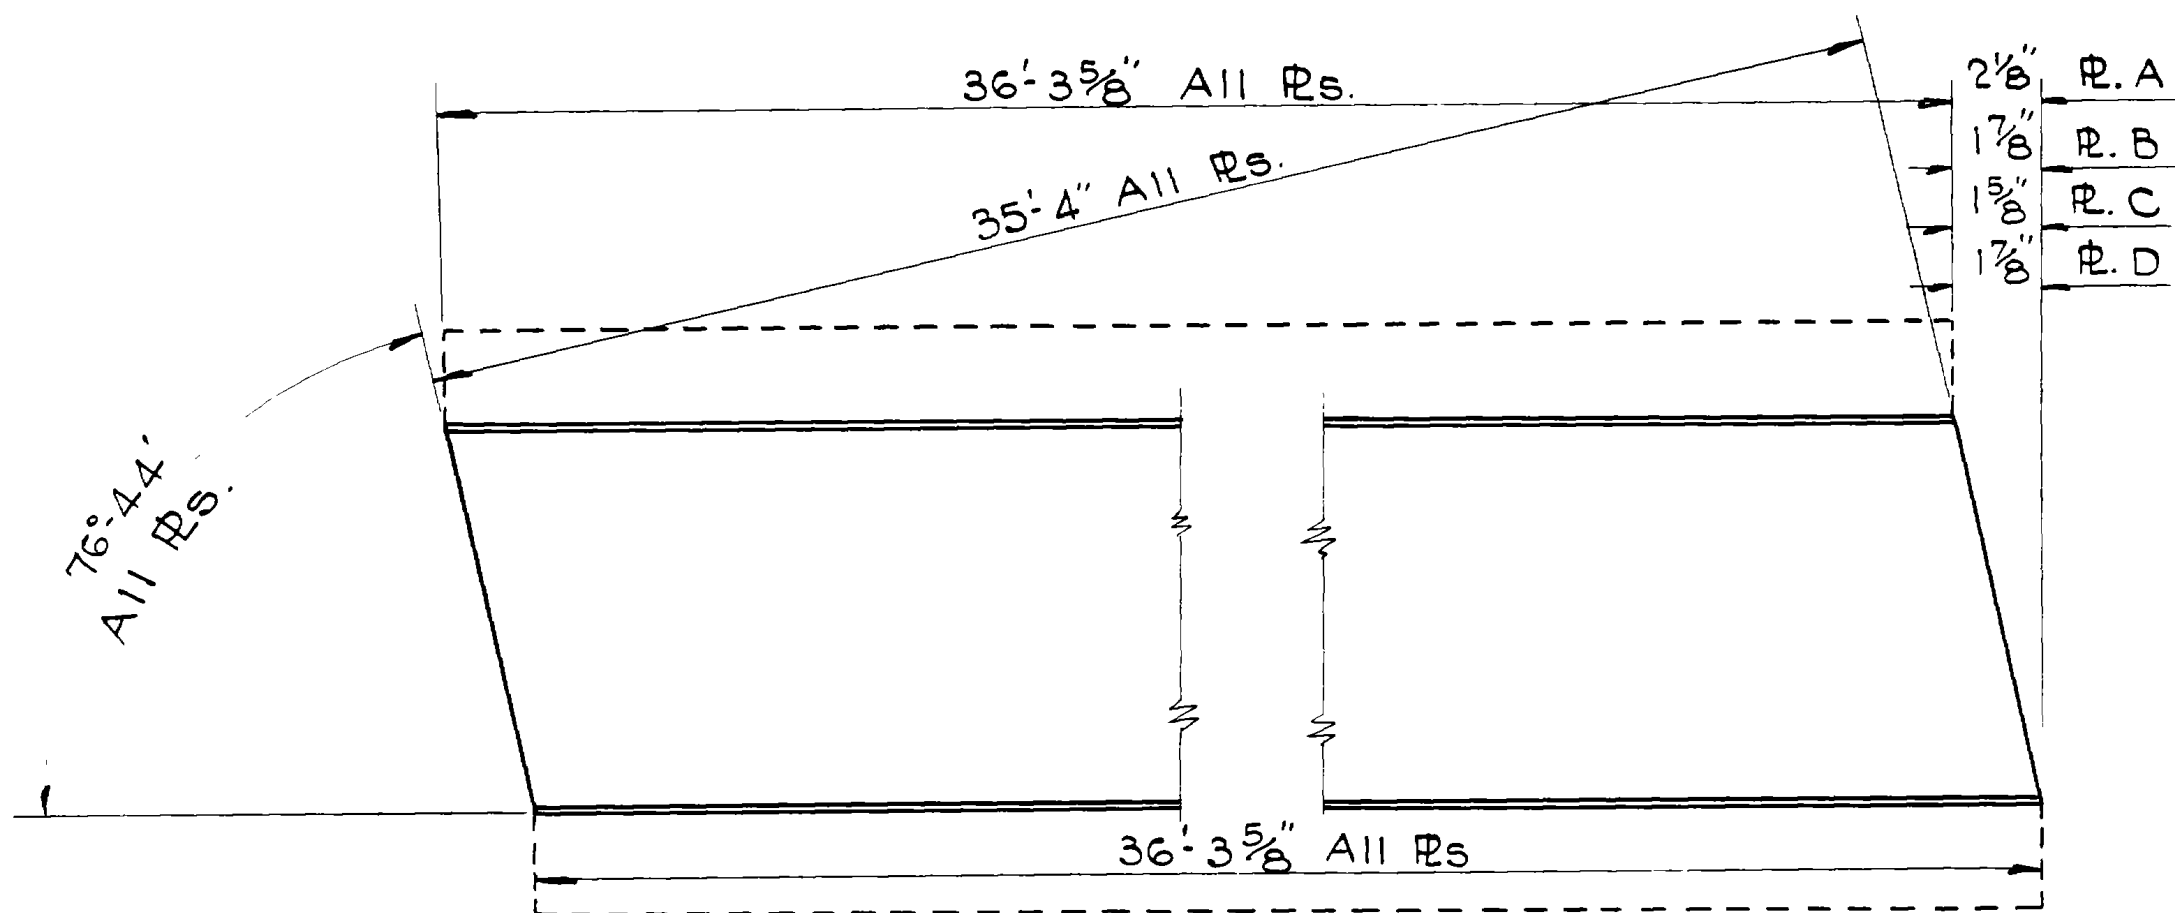


DETAIL OF BEARING PLATES

Make 2 R's. as shown Mark "A" $10 \times \frac{1}{16} \times 36 \cdot 5 \frac{3}{4} @ 2.125 \# = 155.0$ Lbs
 " 2 " " " " "B" $12 \times \frac{1}{16} \times 36 \cdot 5 \frac{1}{2} @ 2.550 \# = 185.9$ "
 " 2 " " " " "C" $11 \times \frac{1}{16} \times 36 \cdot 5 \frac{1}{2} @ 2.338 \# = 170.4$ "
 " 2 " " " " "D" $9 \times \frac{1}{16} \times 36 \cdot 5 \frac{1}{2} @ 1.913 \# = 139.5$ "
 Total Wt All Plates = 650.8 Lbs. Gross

Plate "A" 9"	1/2" R.A
Plate "B" 8"	2" R.B
Plate "C" 7"	2" R.C
Plate "D" 8"	1/2" R.D

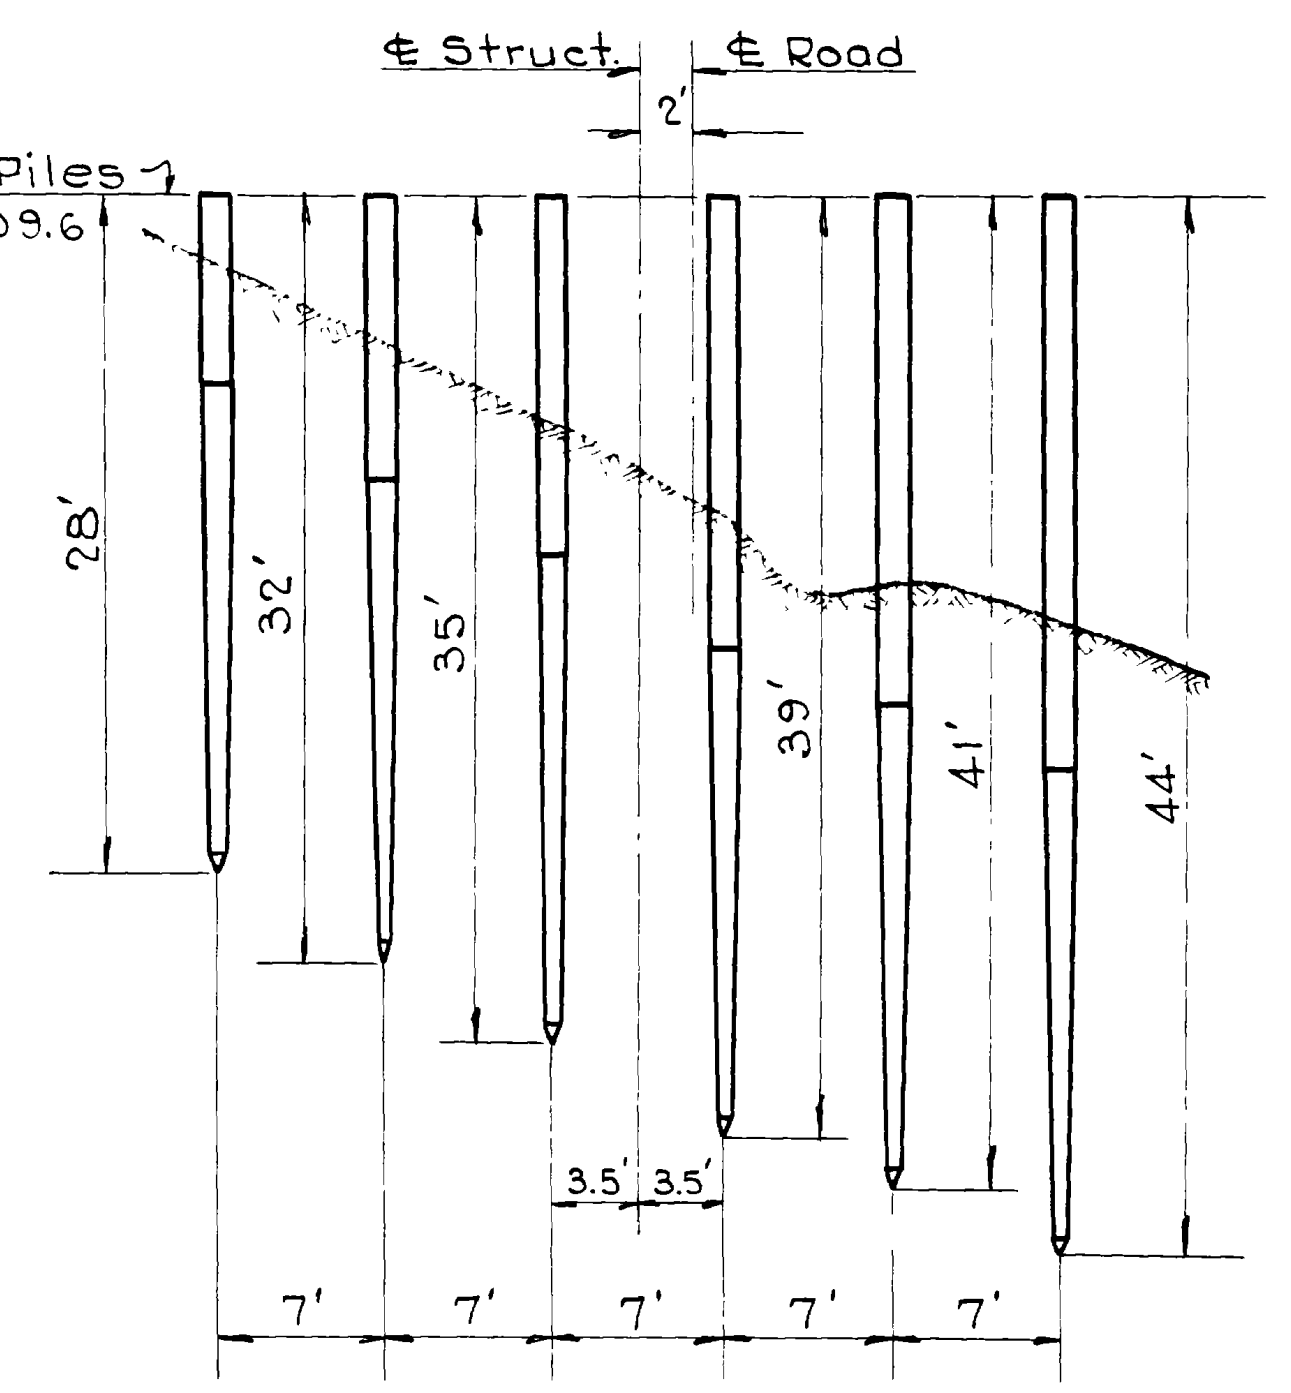


ELEVATION PILING (Upgrade Abut.) Sta. 51+86 1/8" = 1'-0"

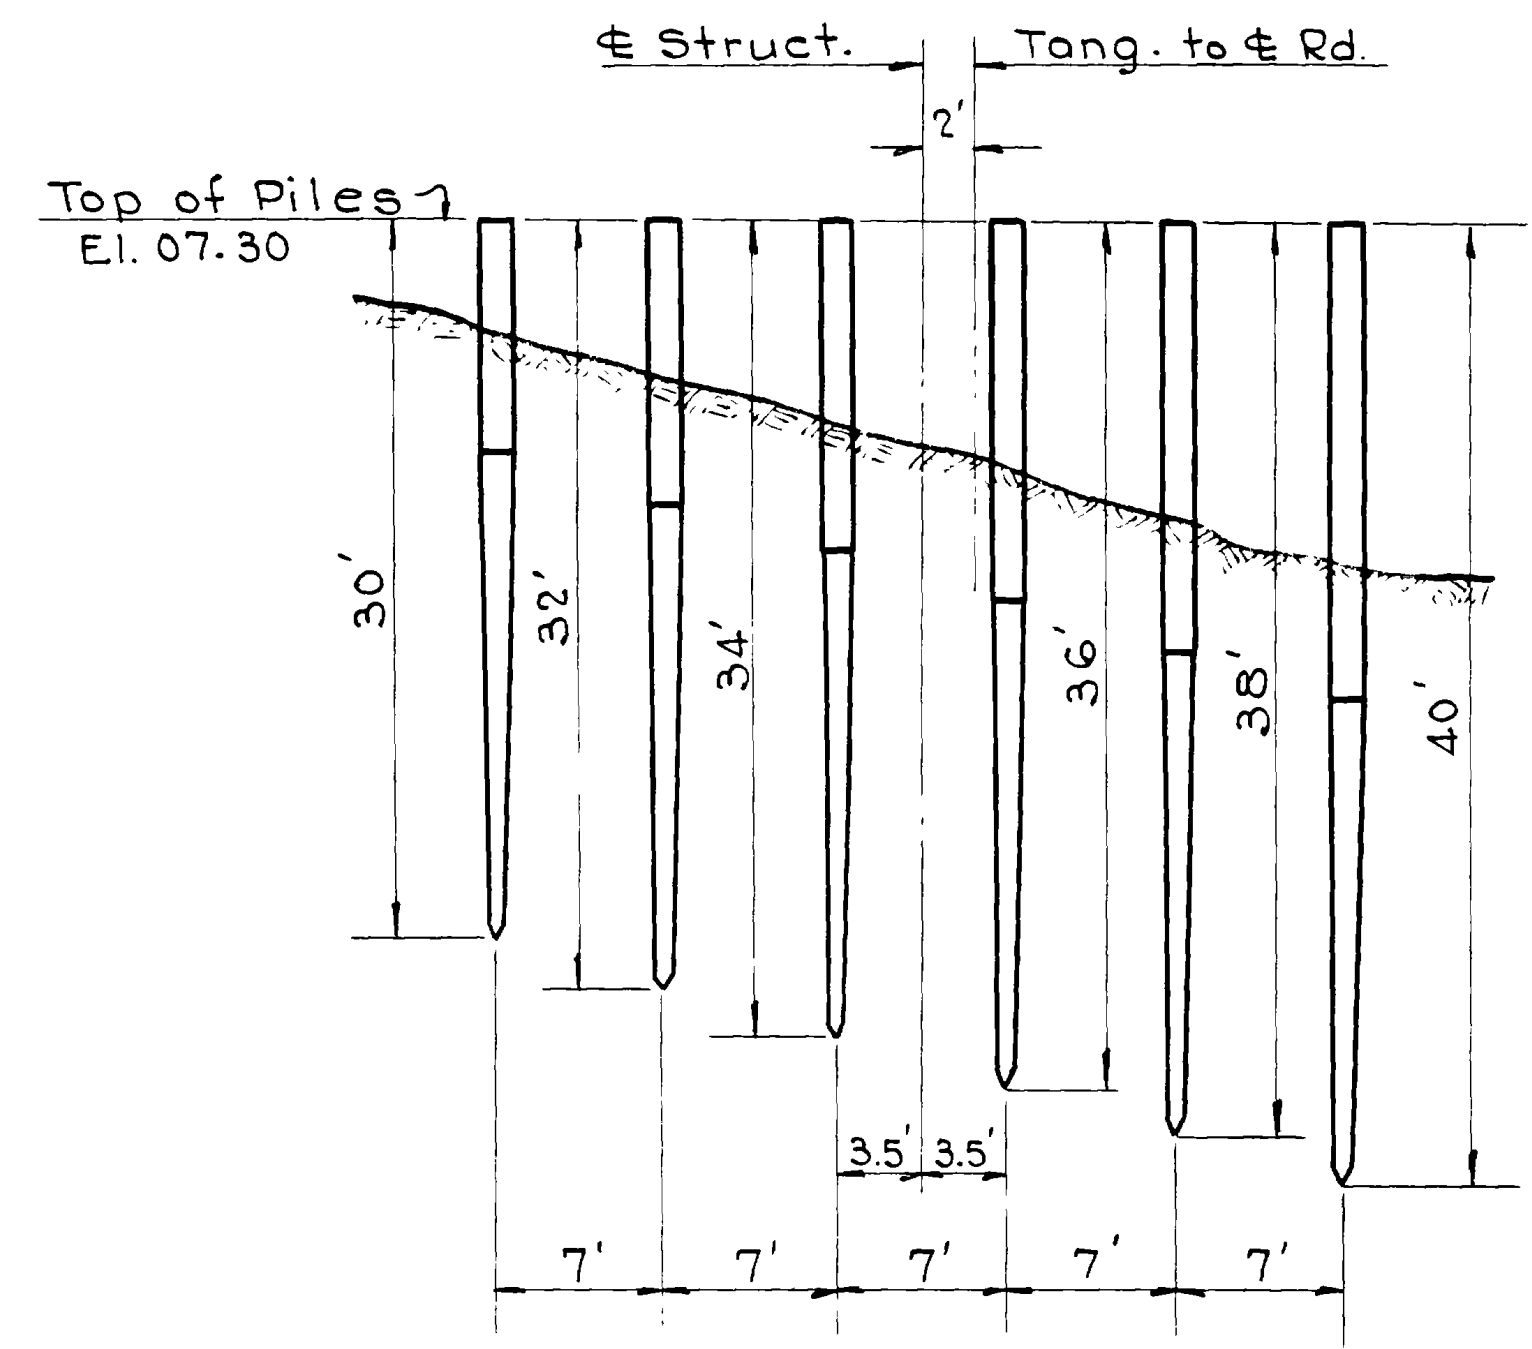

ELEVATION PILING (Downgrade Abut.) Sta. 53+14 1/8" = 1'-0"

BEARINGS & BRG. PLATES

FED. ROAD DIST. NO.	STATE	PRO. NO.	FISCAL YEAR	SHEET NO.	TOTAL SHEETS
12	UTAH				

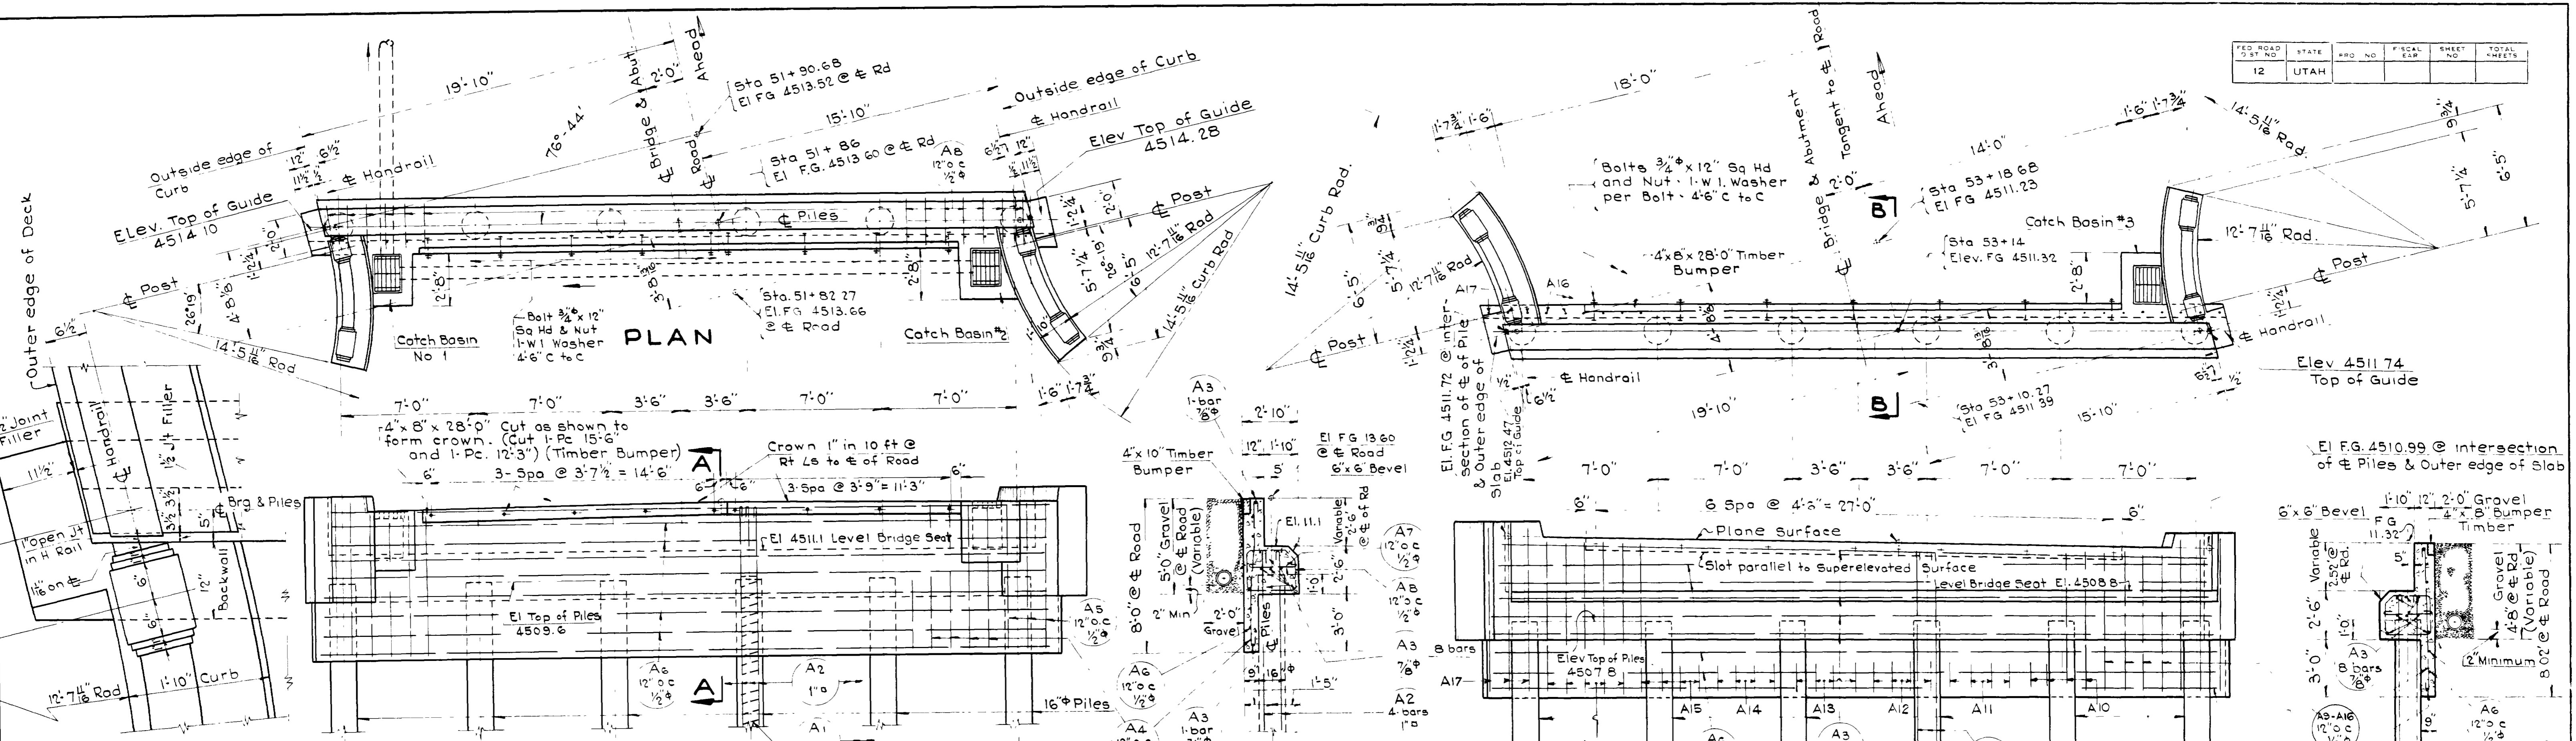




ENLARGED TYPICAL PLAN
(Hand Rail End Post)
1" = 1'-0"

REAR ELEVATION
(Upgrade Abut.)
1/4" = 1'-0"


SEC. A-A
(@ Rt. Ls. to Piles)

FRONT ELEVATION
(Downgrade Abut.)
1/4" = 1'-0"

SEC. B-B
(@ 90° to Piles)

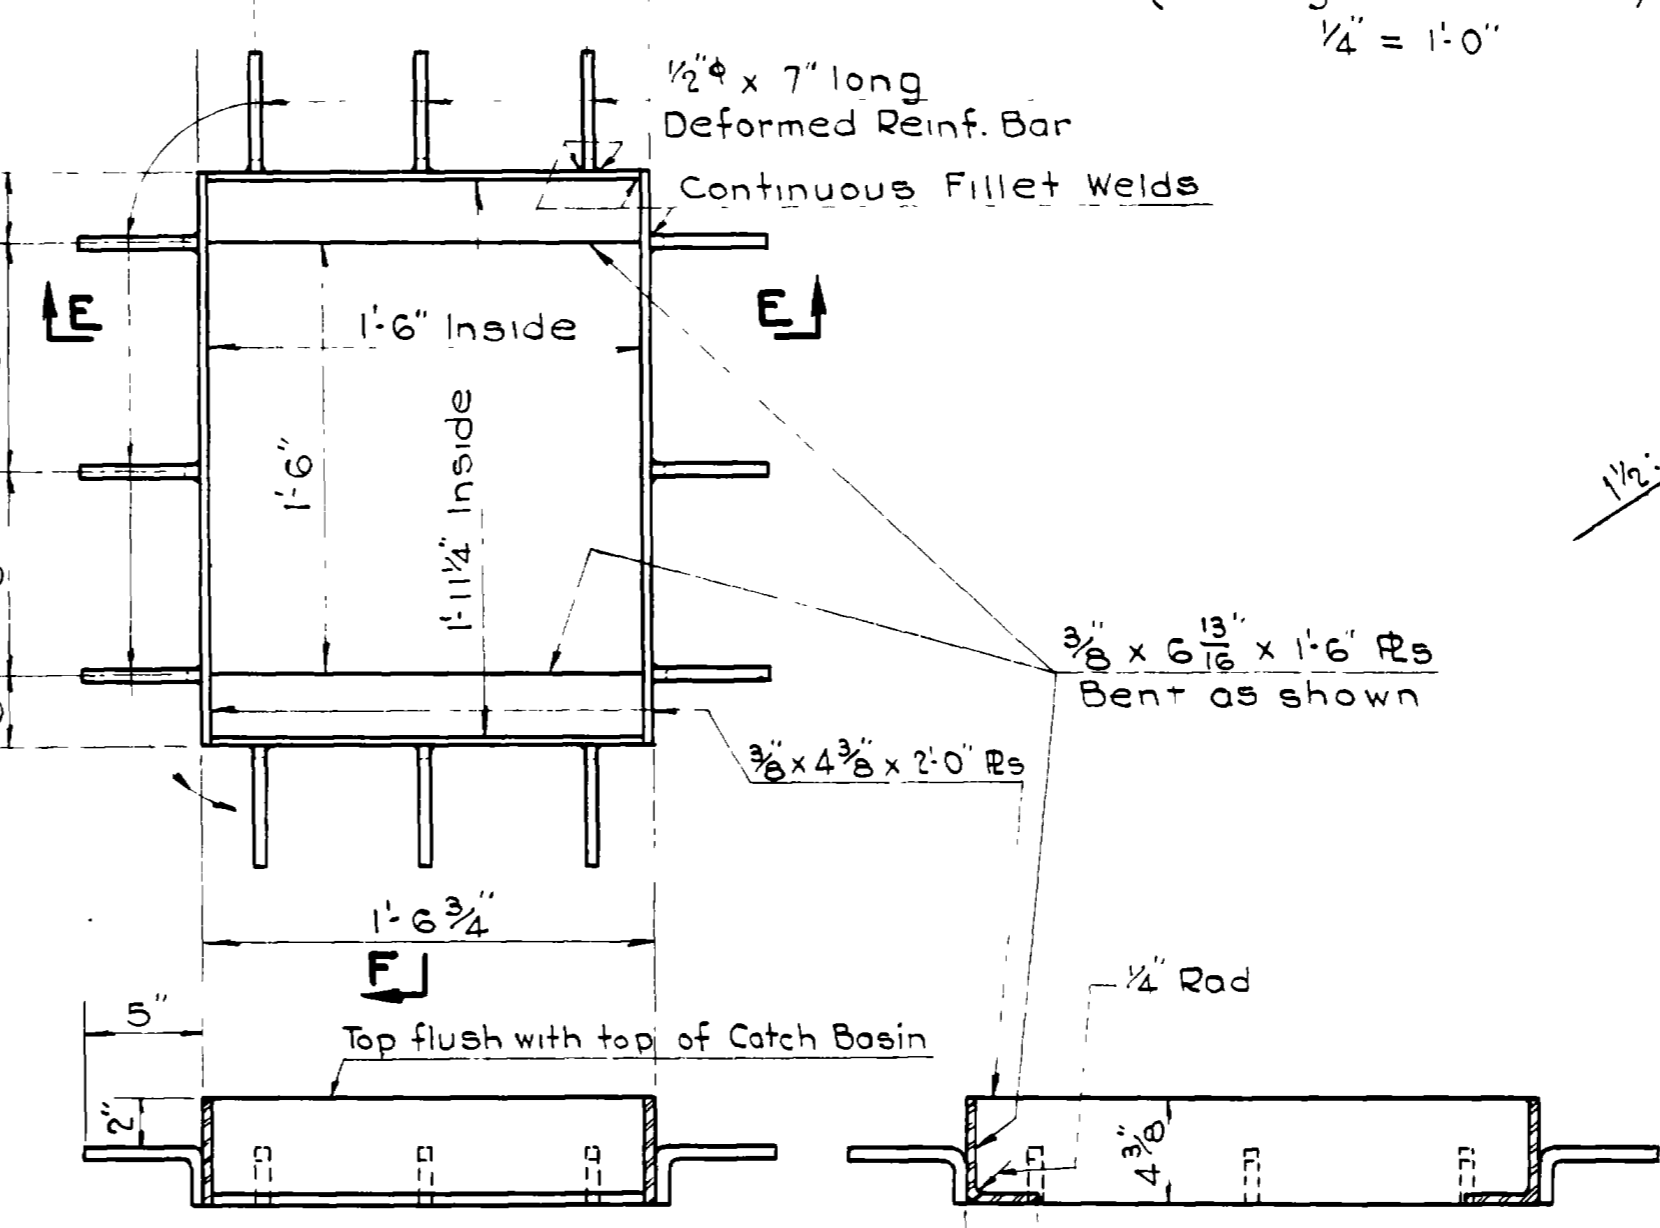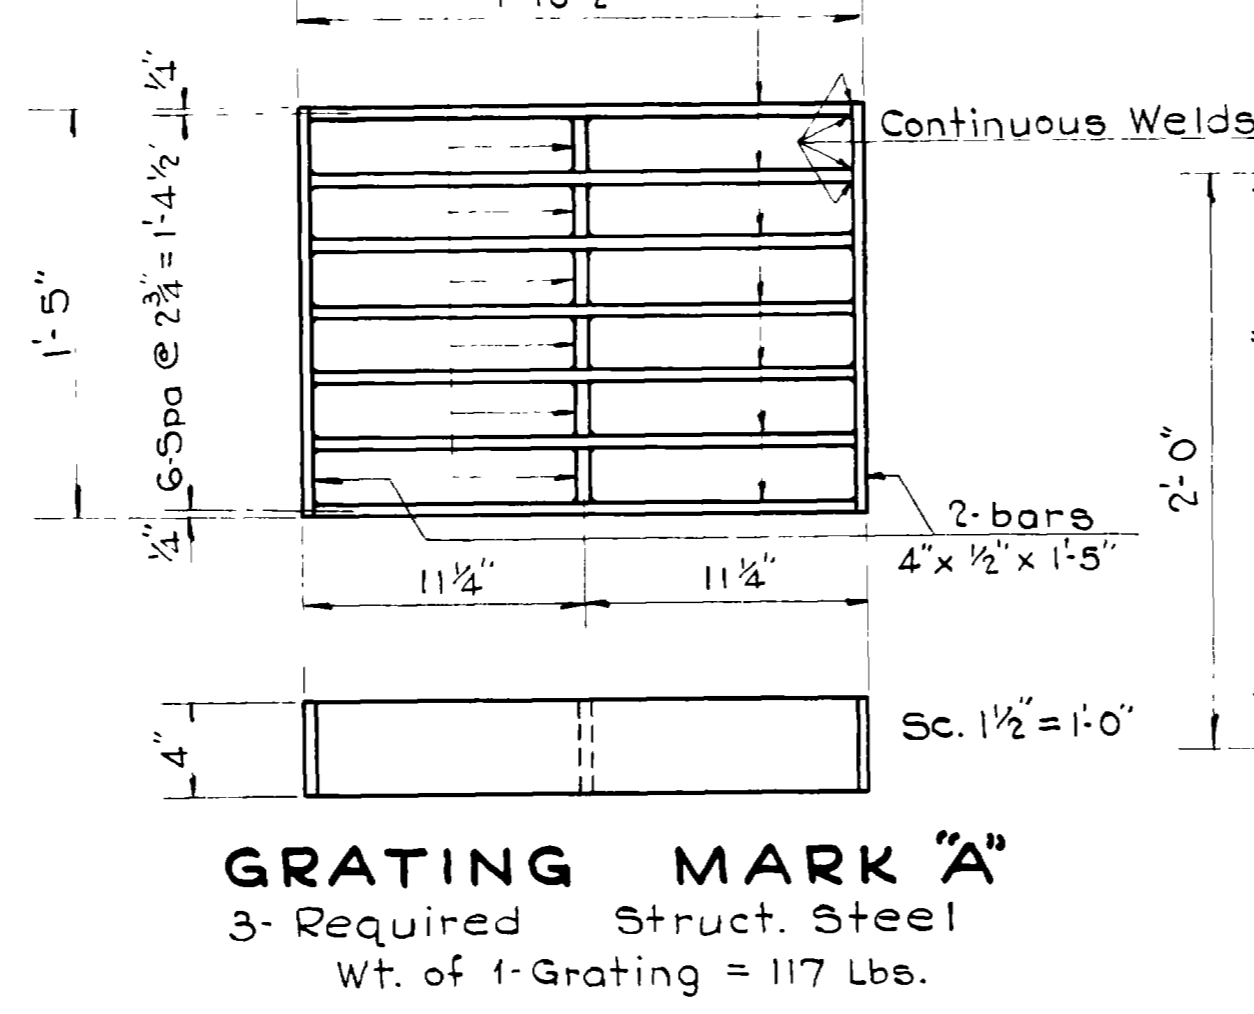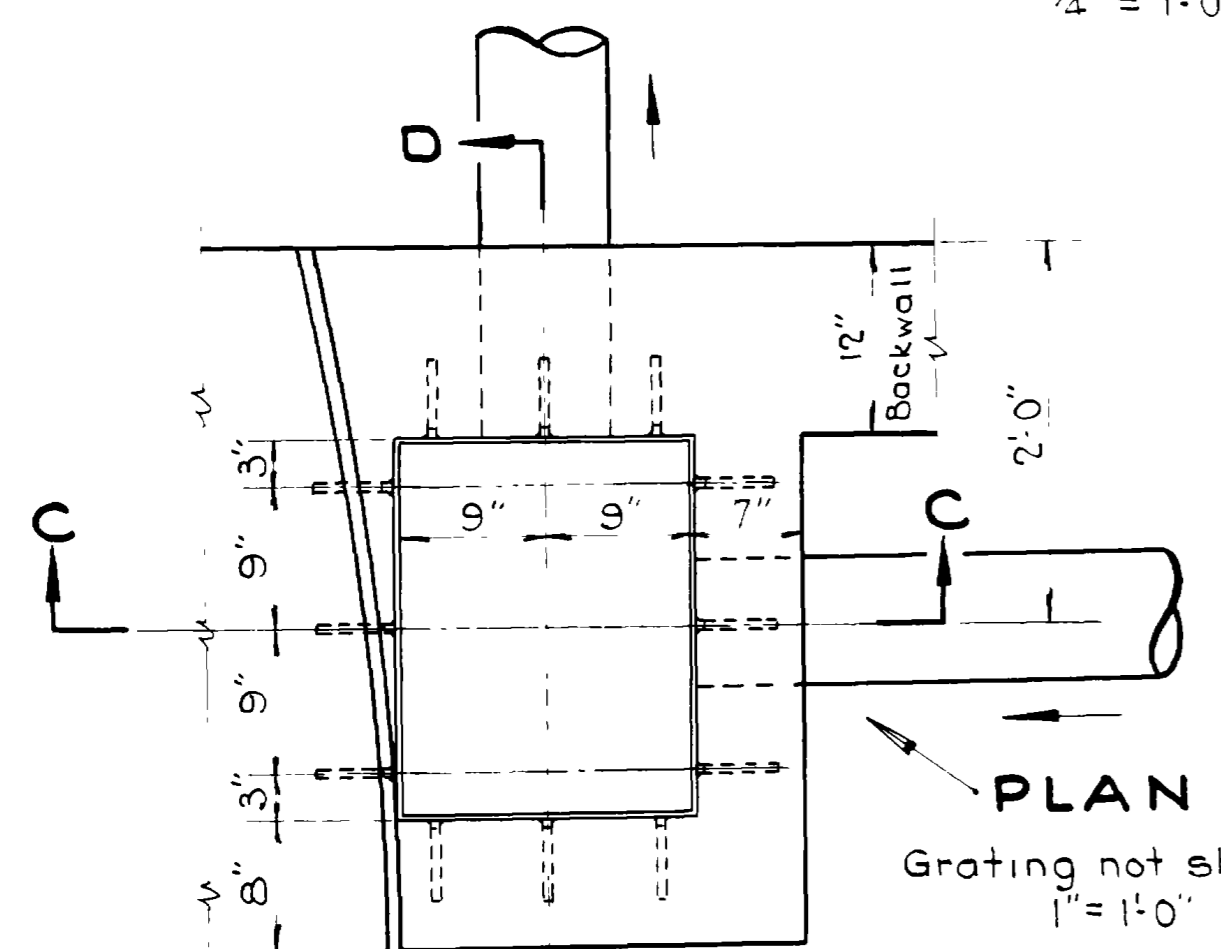

FRAME MARK "B"
3- Required Struct. Steel
Wt. of 1-Frame = 55-Lbs.
1/2" = 1'-0"

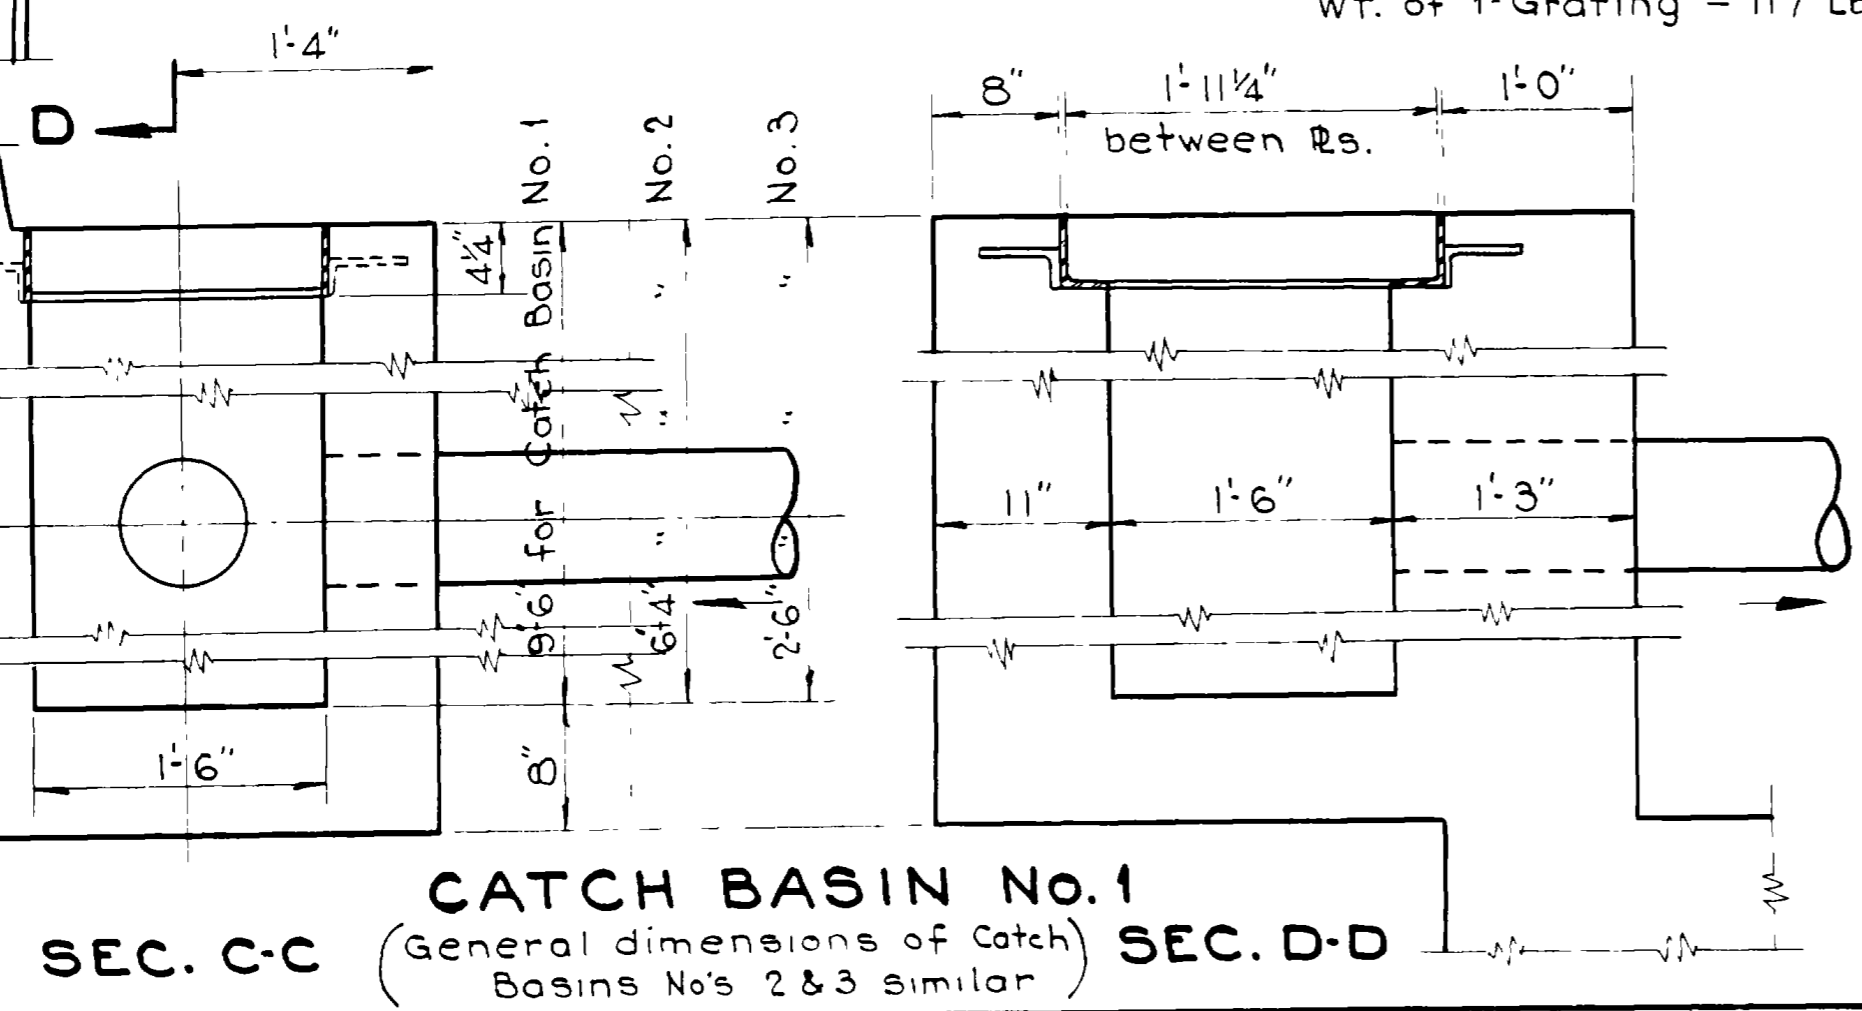


ENLARGED VIEW OF PILE
1/2" = 1'-0"


Note: Penetration 25' in Natural Ground for all piles, both abutments. See Sh.#6 showing elevation of piling in abutments

Sheet 7 of 12 sheets
UTAH STATE ROAD COMMISSION
SALT LAKE CITY, UTAH
BRIDGE OVER U.P. & L. CO'S PENSTOCKS
A.W.(P.C.E.) F.A.P. 222-A(1)
Sta. 52+50 Weber Co.
Ogden Arsenal-Riverdale
F.M.E. As noted
J.H.B. May 27, 1944
29-259-1-2 D-466

FED. ROAD DIST. NO.	STATE	FED. AID PROJ. NO.	FISCAL YEAR	SHEET NO.	TOTAL SHEETS
12	UTAH	222-A(1)			

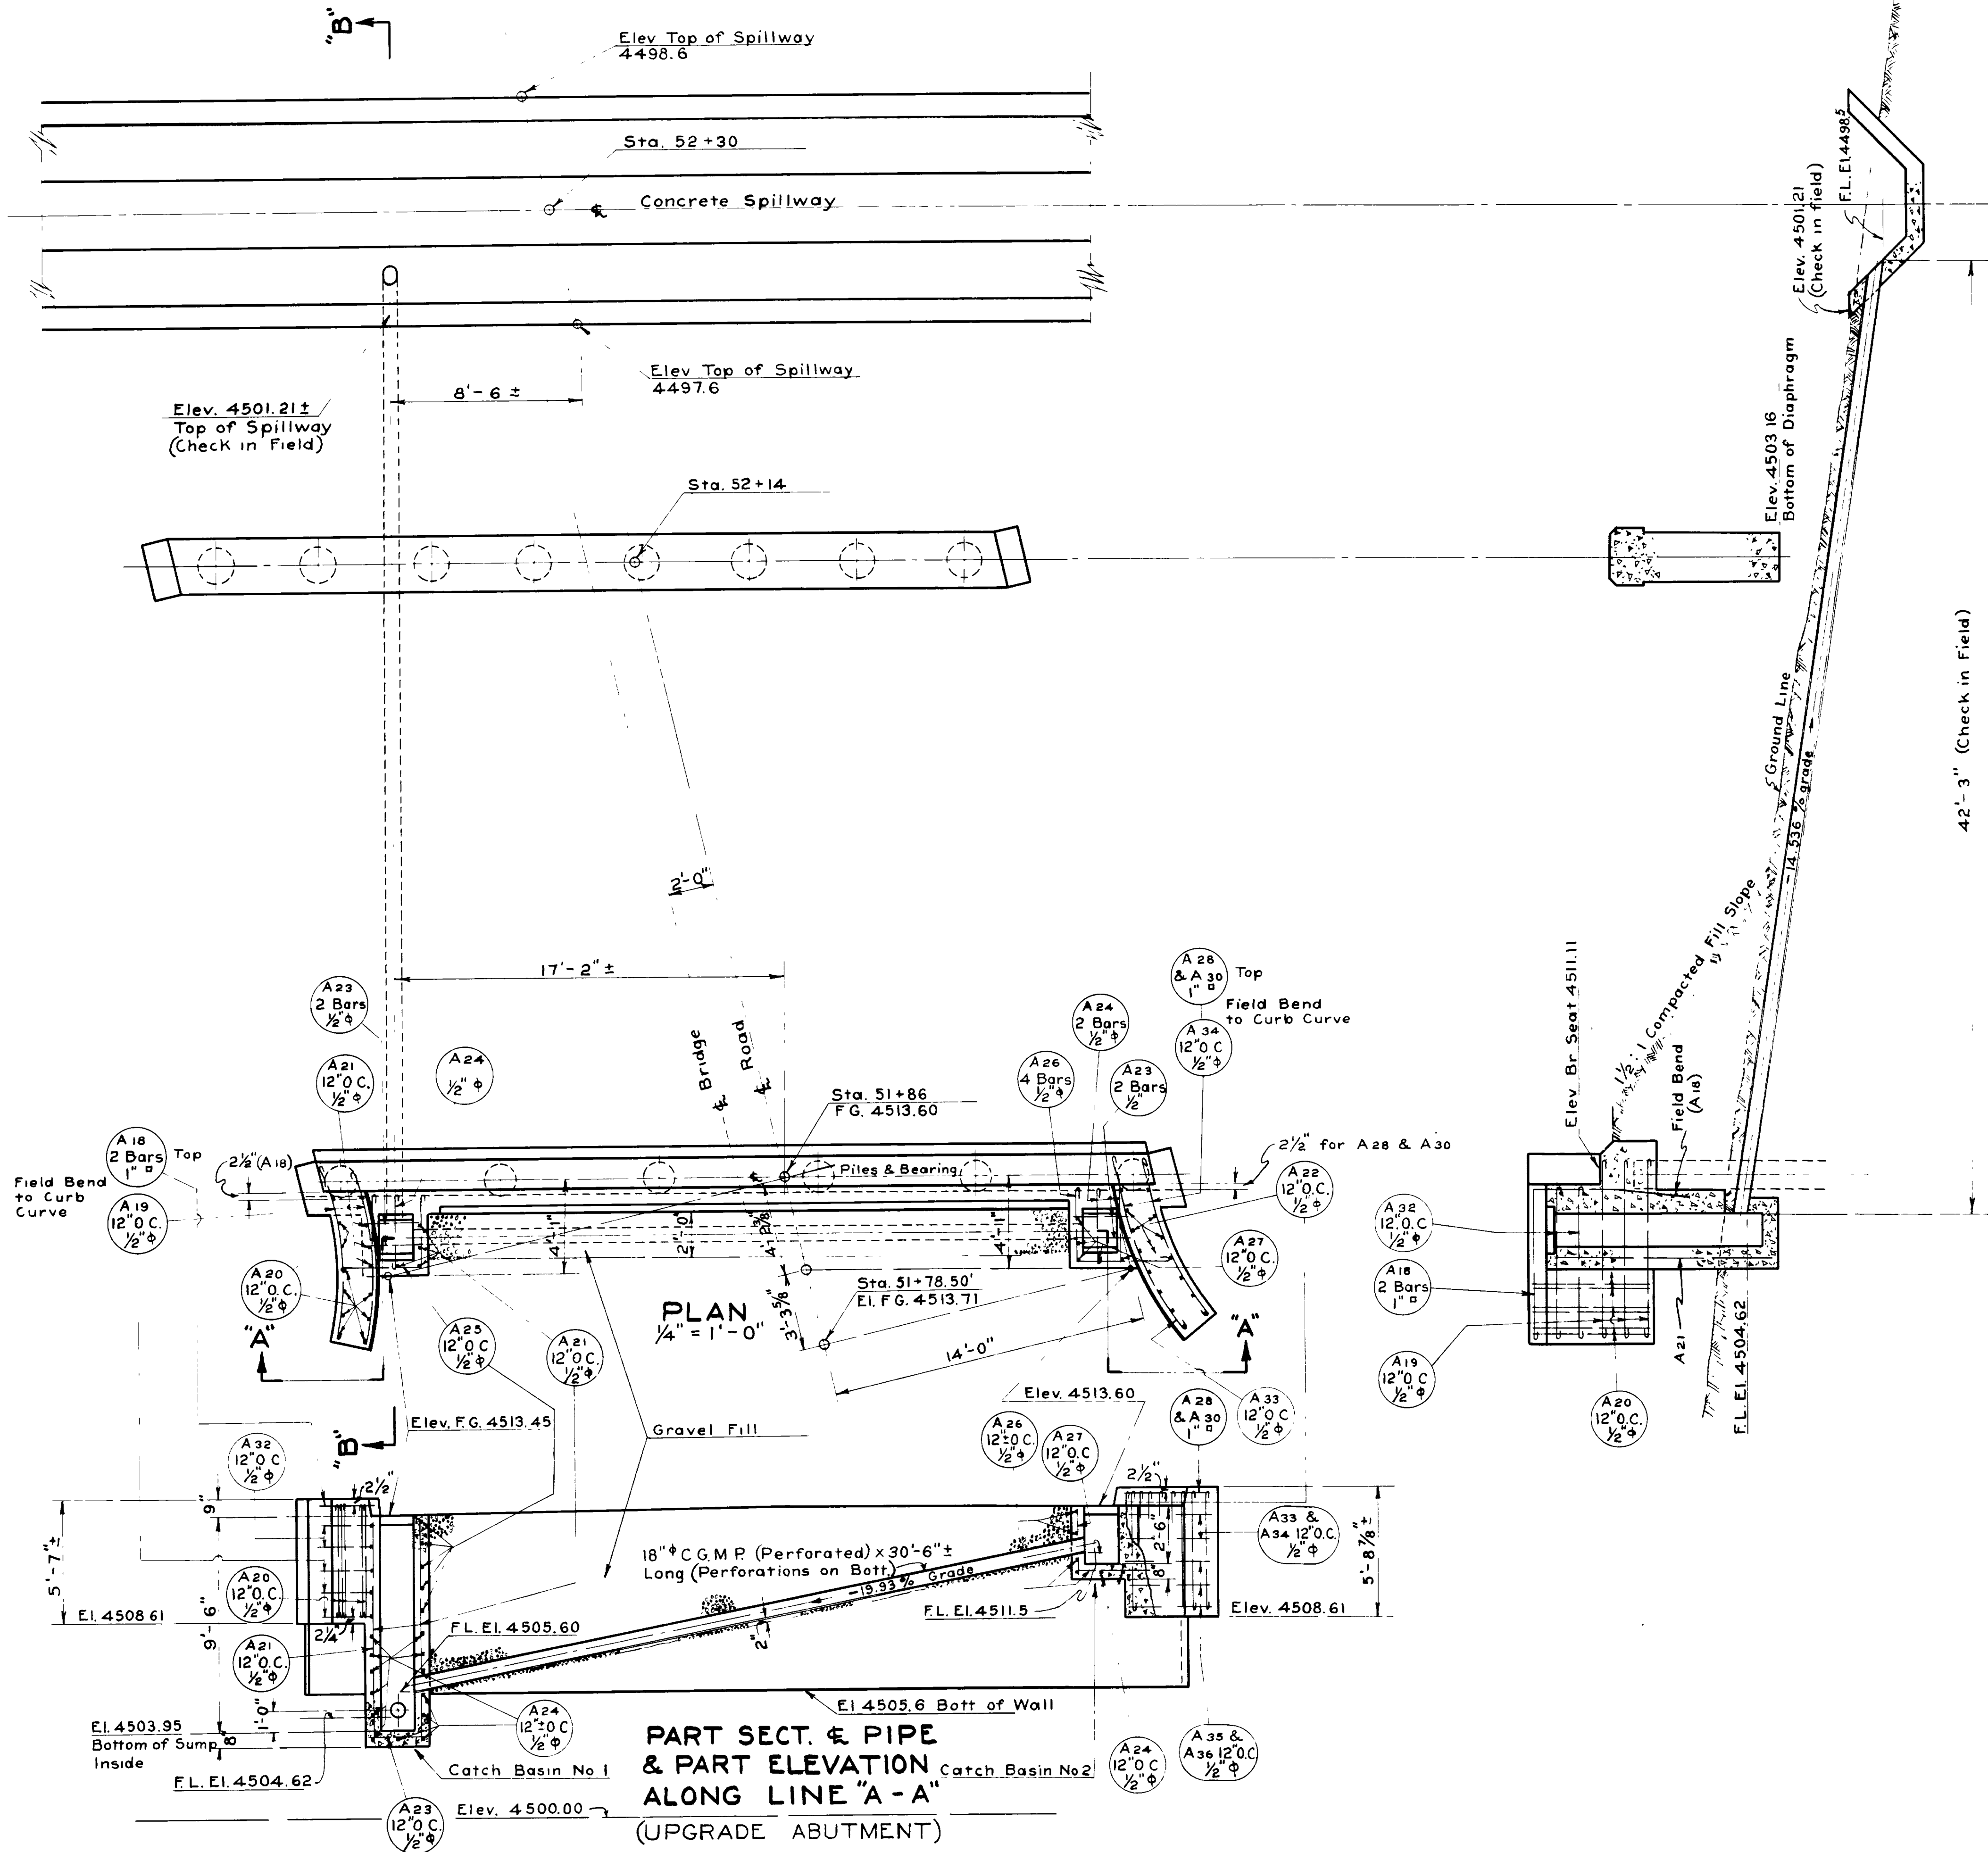

SECTION "B-B"
42'-3" (Check in Field)

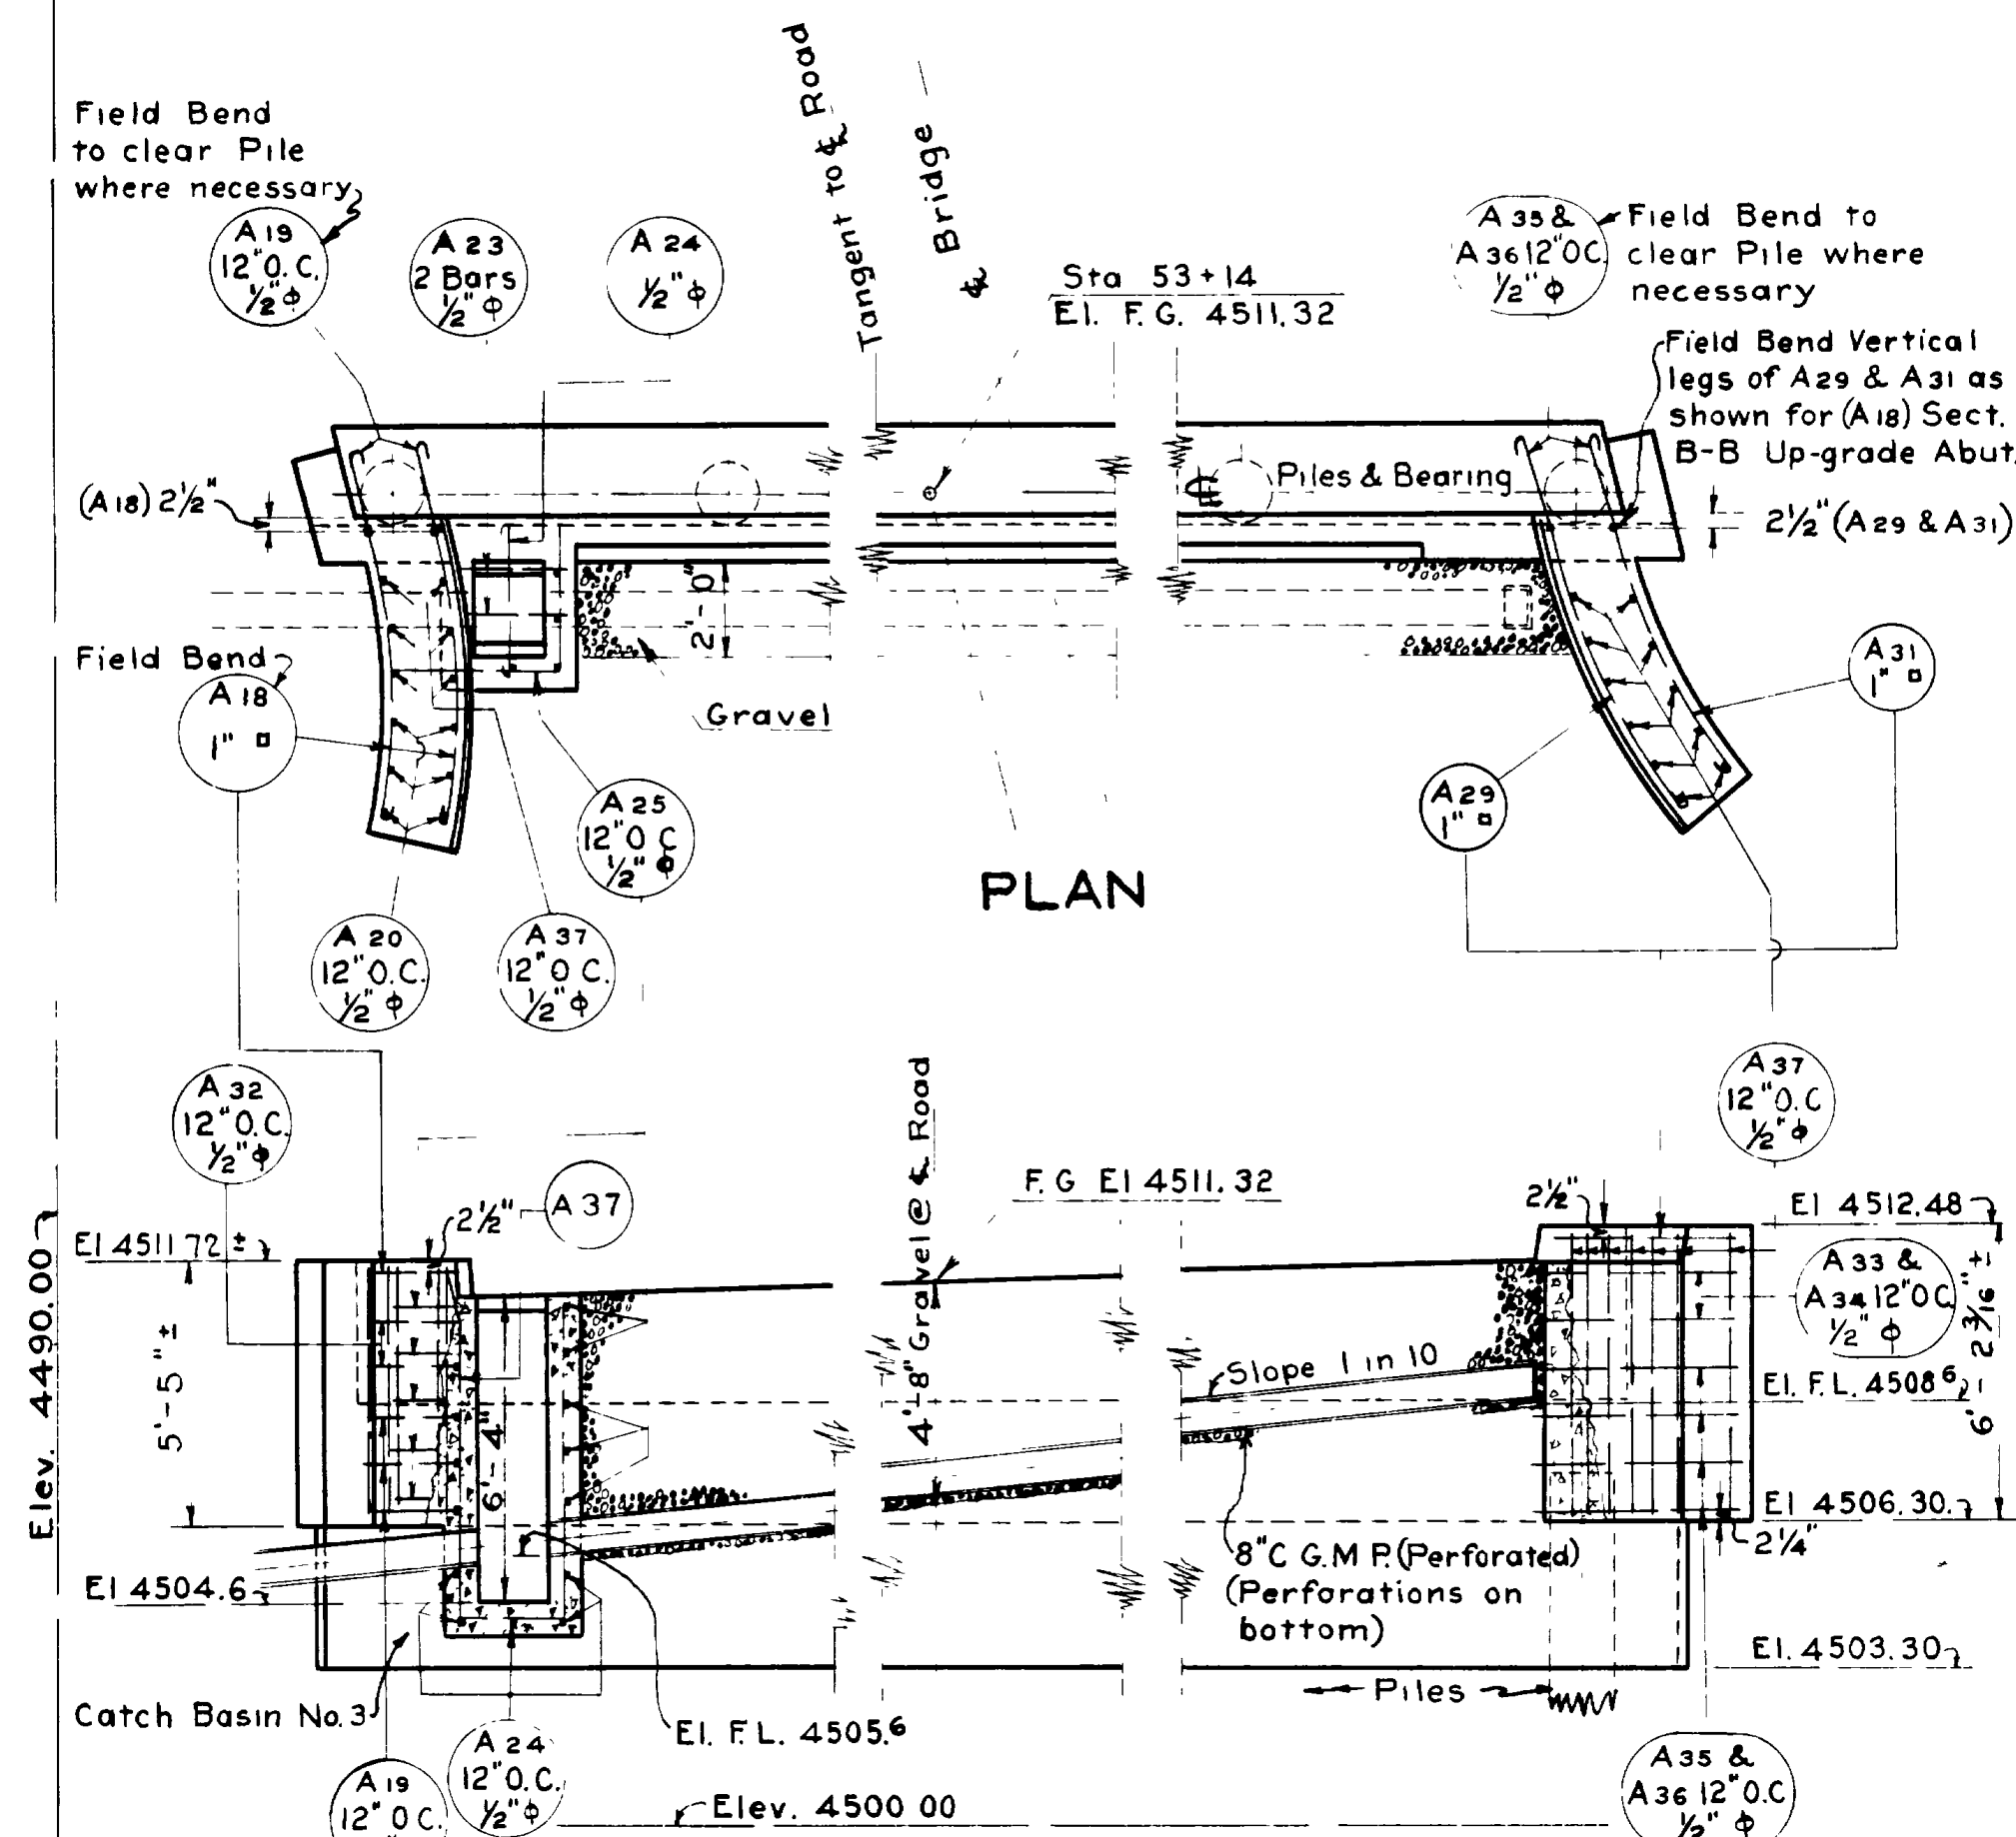


PART SECTION ON PIPE & PART ELEVATION
1/4" = 1'-0"
(DOWNGRADE ABUTMENT)

PART SECT. PIPE & PART ELEVATION
ALONG LINE "A-A"
(UPGRADE ABUTMENT)


MANHOLES & CURBS

Sheet 8 of 12 sheets
 UTAH STATE ROAD COMMISSION
 SALT LAKE CITY, UTAH
 ERIC C. KNOWLTON, CIVIL ENGINEER
 BRIDGE OVER U.P. & L. CO'S
 PENSTOCKS
 A.W. (P.C.E.) F.A.P. 222-A(1)
 Sta 52+50 Weber Co.
 Ogden Arsenal-Riverdale
 DESIGN BY F.M.E. As noted
 DRAWN BY J.H.B. J.H.B.
 CHECKED BY J.H.B. J.H.B.
 NO. 29-259-1-2 D-466

FED. ROAD DIST. NO.	STATE	FED. AID PROJ. NO.	FISCAL YEAR	SHEET NO.	TOTAL SHEETS
12	UTAH	212-A(1)			

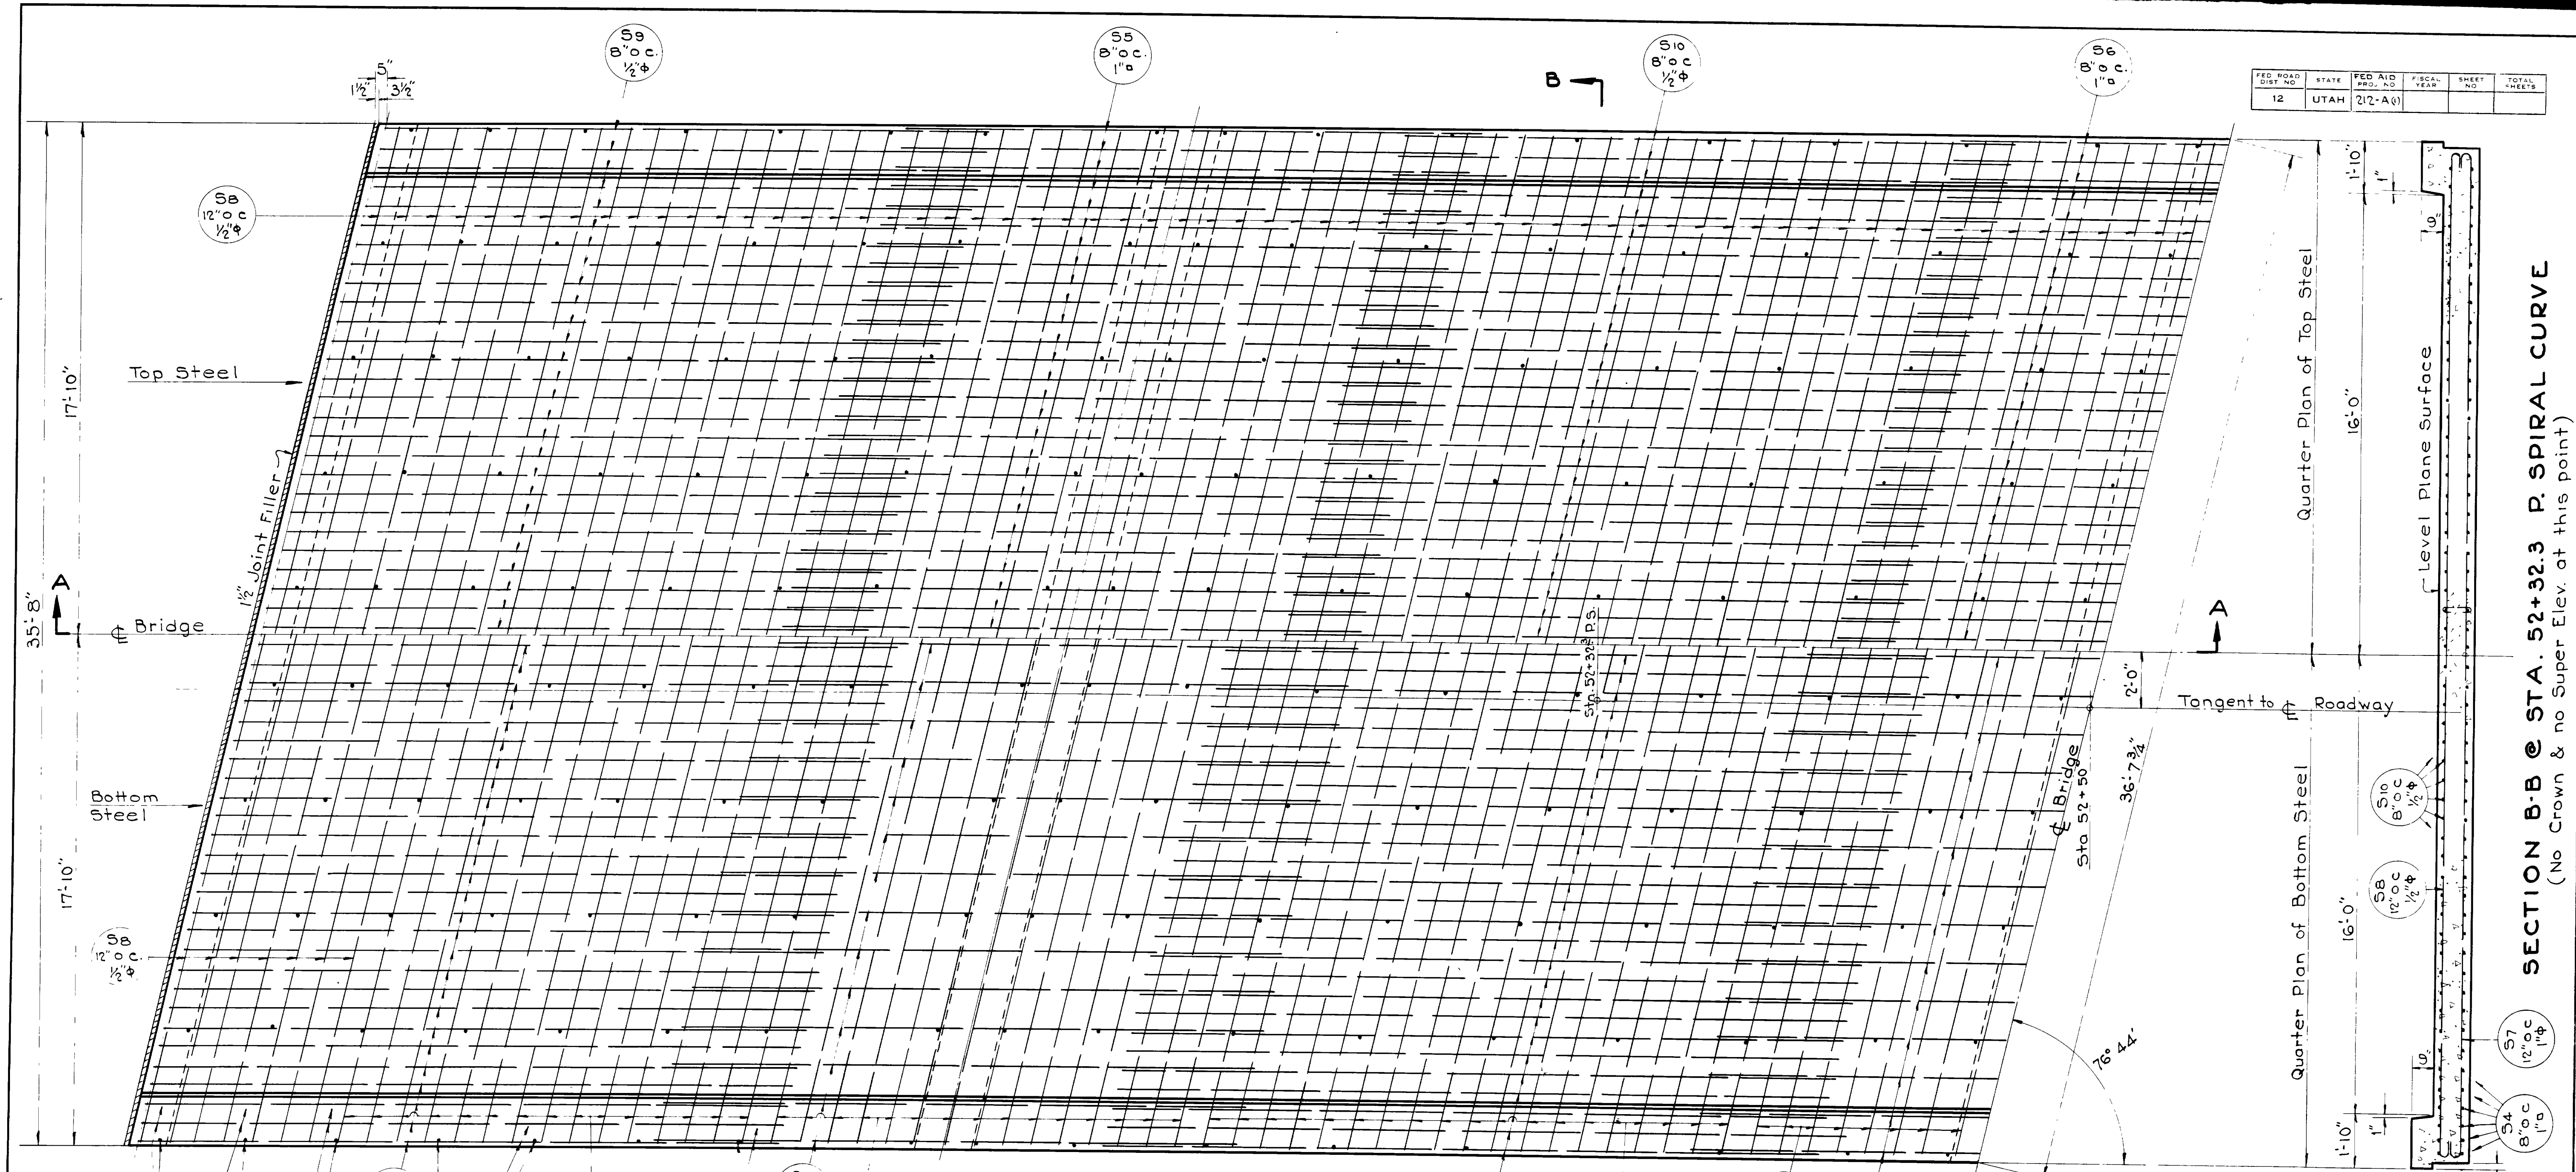

HALF PLAN

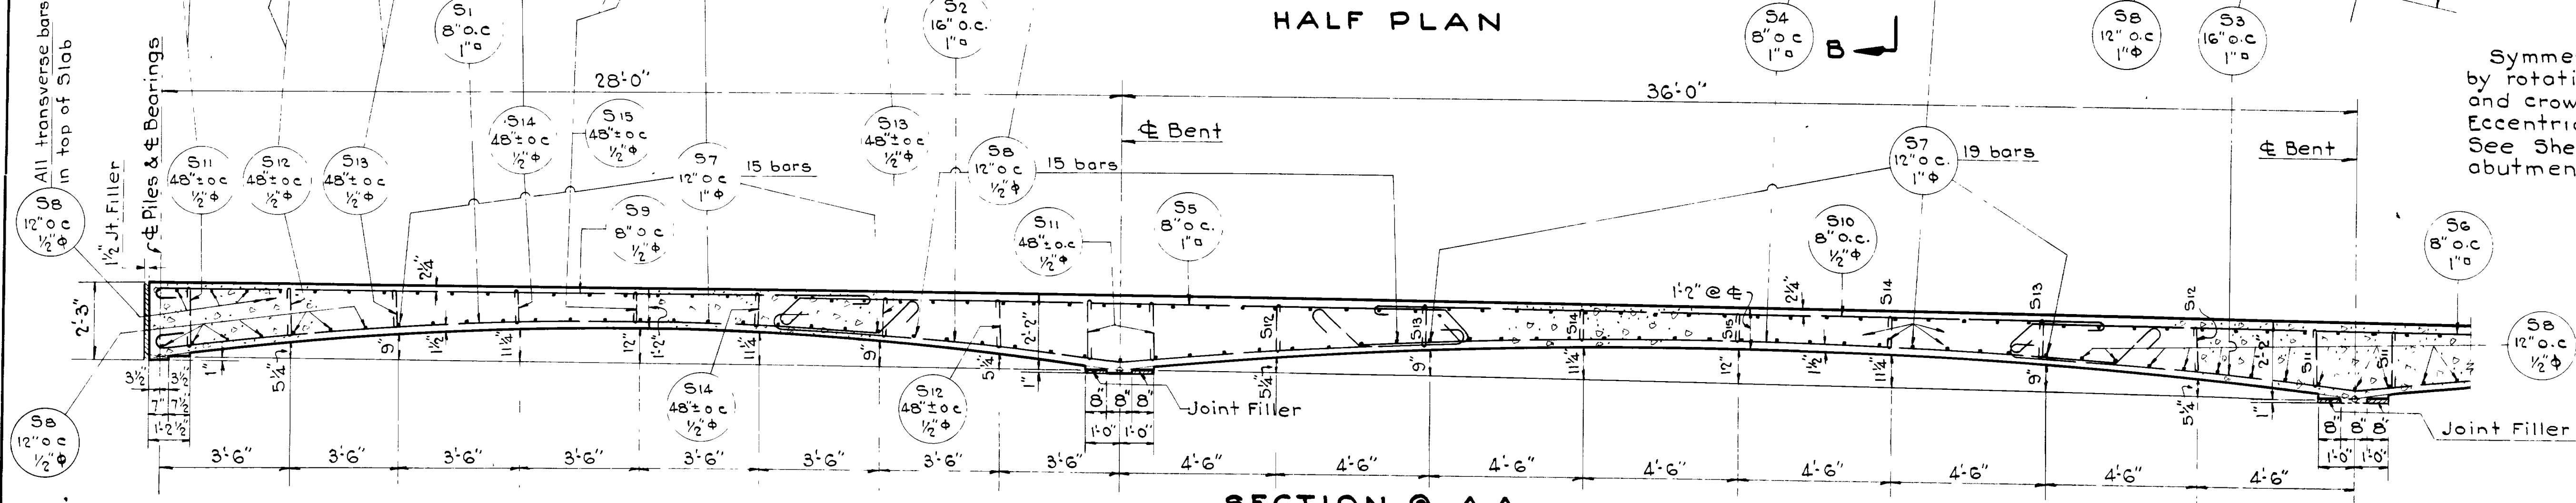

SECTION @ A-A

Symmetrical about Bridge Center Lines by rotation, except for super-elevation and crown, or where shown otherwise. Eccentric with Φ of Road as shown. See Sheet 6 for details of bearings on abutments and interior bents.






DECK STEEL

Sheet 9 of 12 sheets
 UTAH STATE ROAD COMMISSION
 SALT LAKE CITY, UTAH
 EZRA C. KINWALTON, CHIEF ENGINEER
 BRIDGE OVER U.P. & L. CO'S
 PENSTOCKS
 A.W.(P.C.E.) F.A.P. 222-A(1)
 Sta. 52+50 Weber Co.
 Ogden Arsenal-Riverdale
 DESIGNED BY F.M.E. SCALE 3/8" = 1'-0"
 DRAWN BY J.H.B. DATE May 21, 1911
 CHECKED BY [Signature]
 BRIDGE NO. 29-259-1-2 DRAWN BY D-466

SECTION B-B @ STA. 52+32.3 P. SPIRAL CURVE
 (No Crown & no Super Elev. at this point)

REVISIONS	DATE	BY	NO.

FED. ROAD DIST. NO.	STATE	FED. AID PROJ. NO.	FISCAL YEAR	SHEET NO.	TOTAL SHEETS
12	UTAH	222-A(1)			

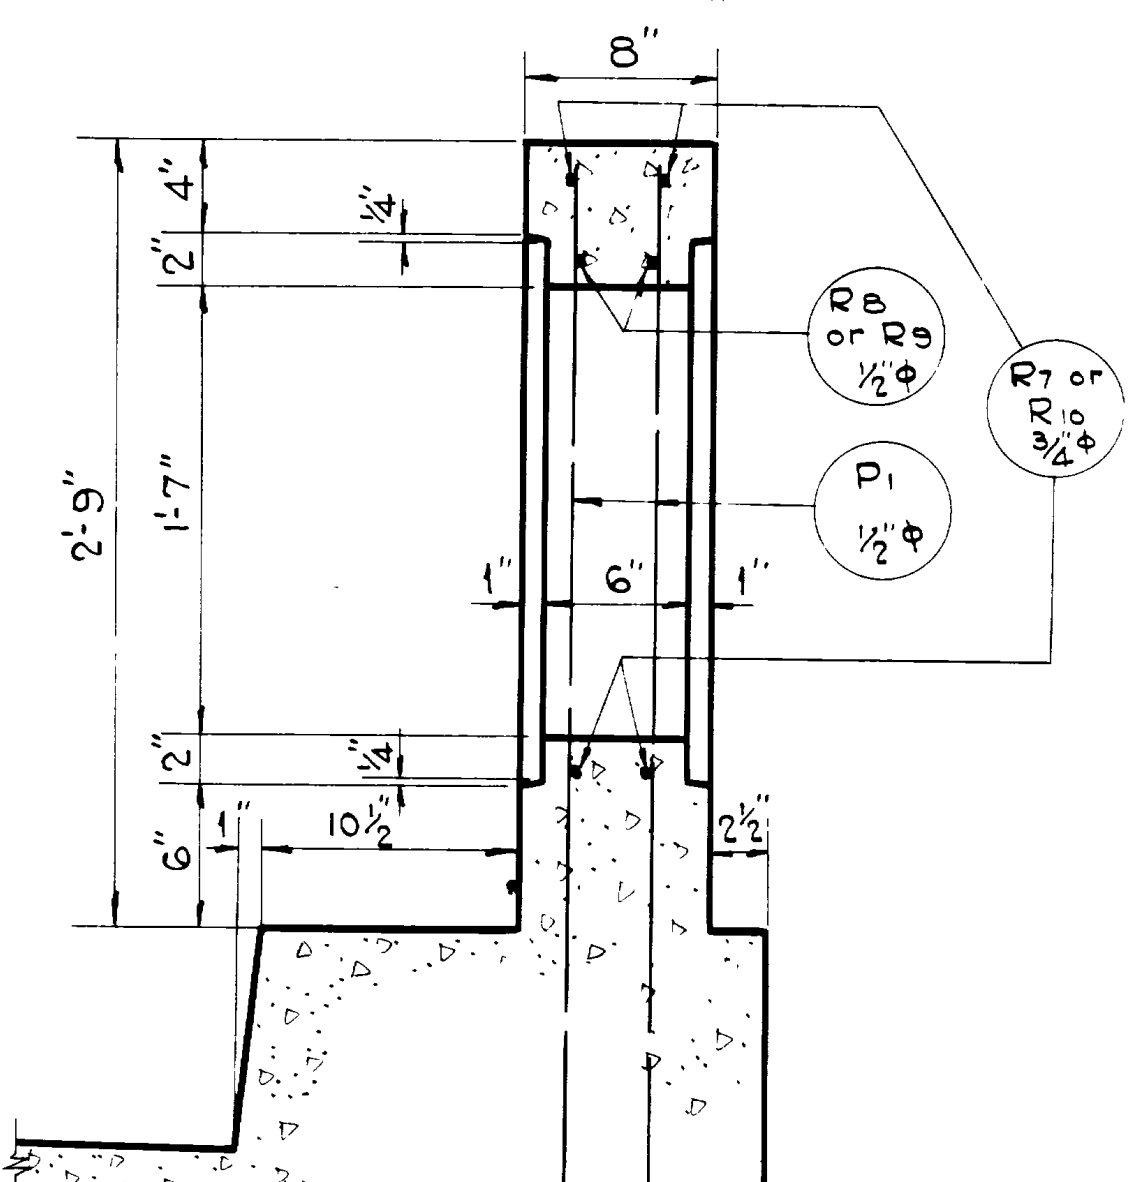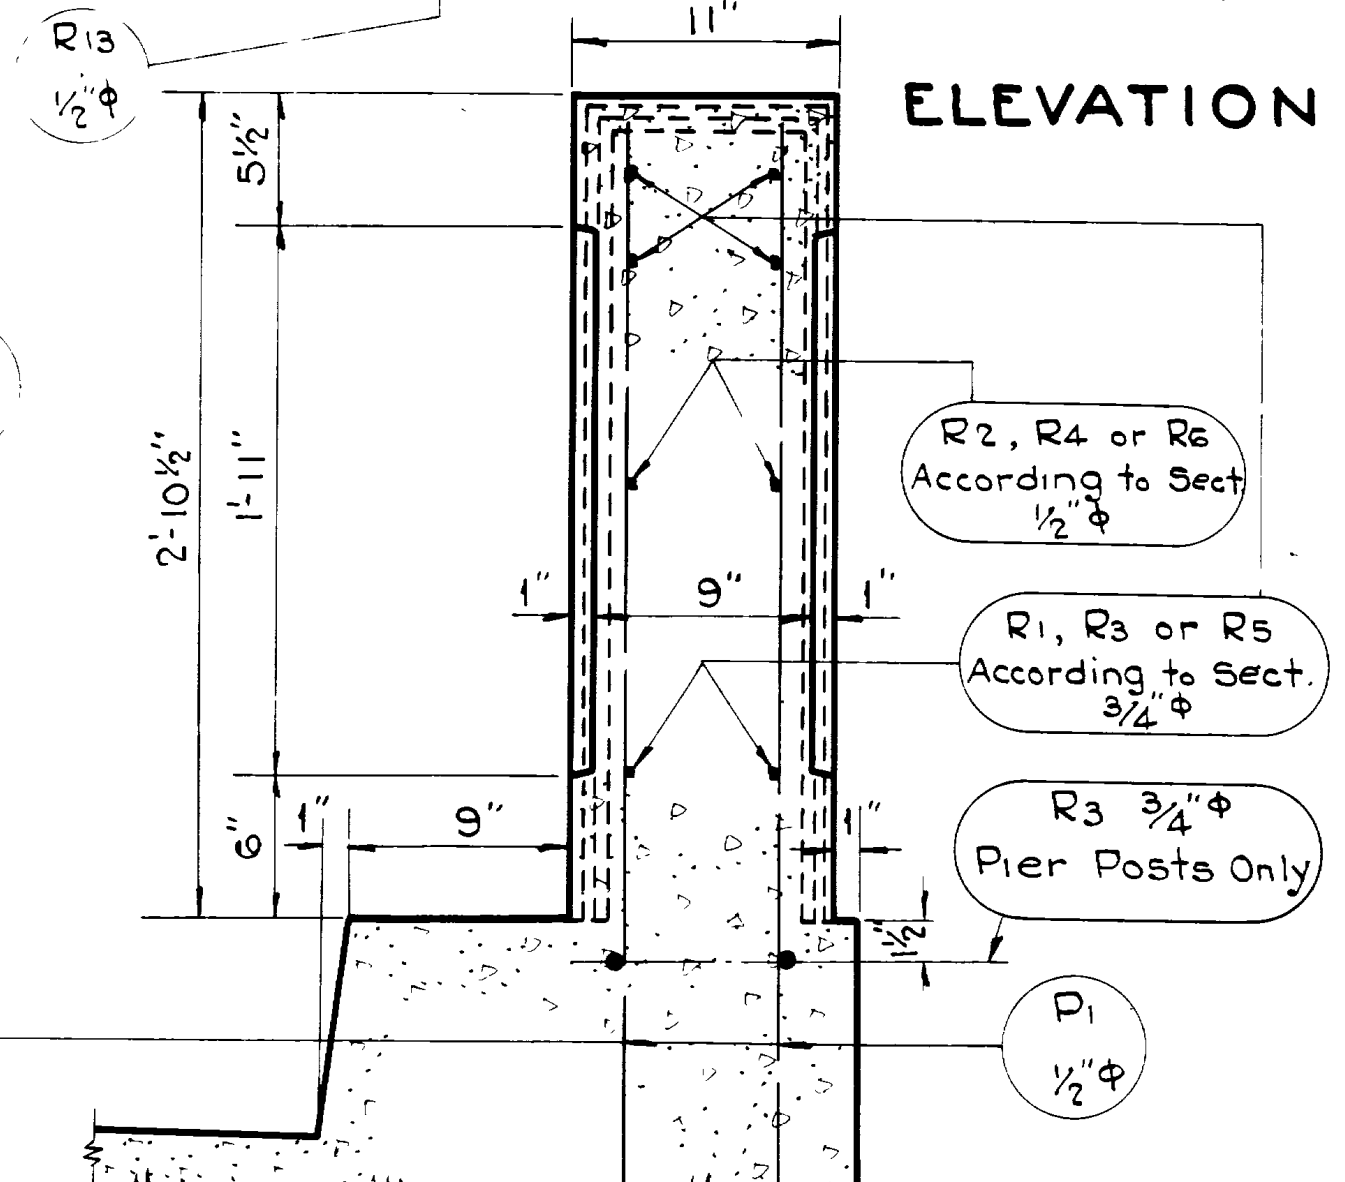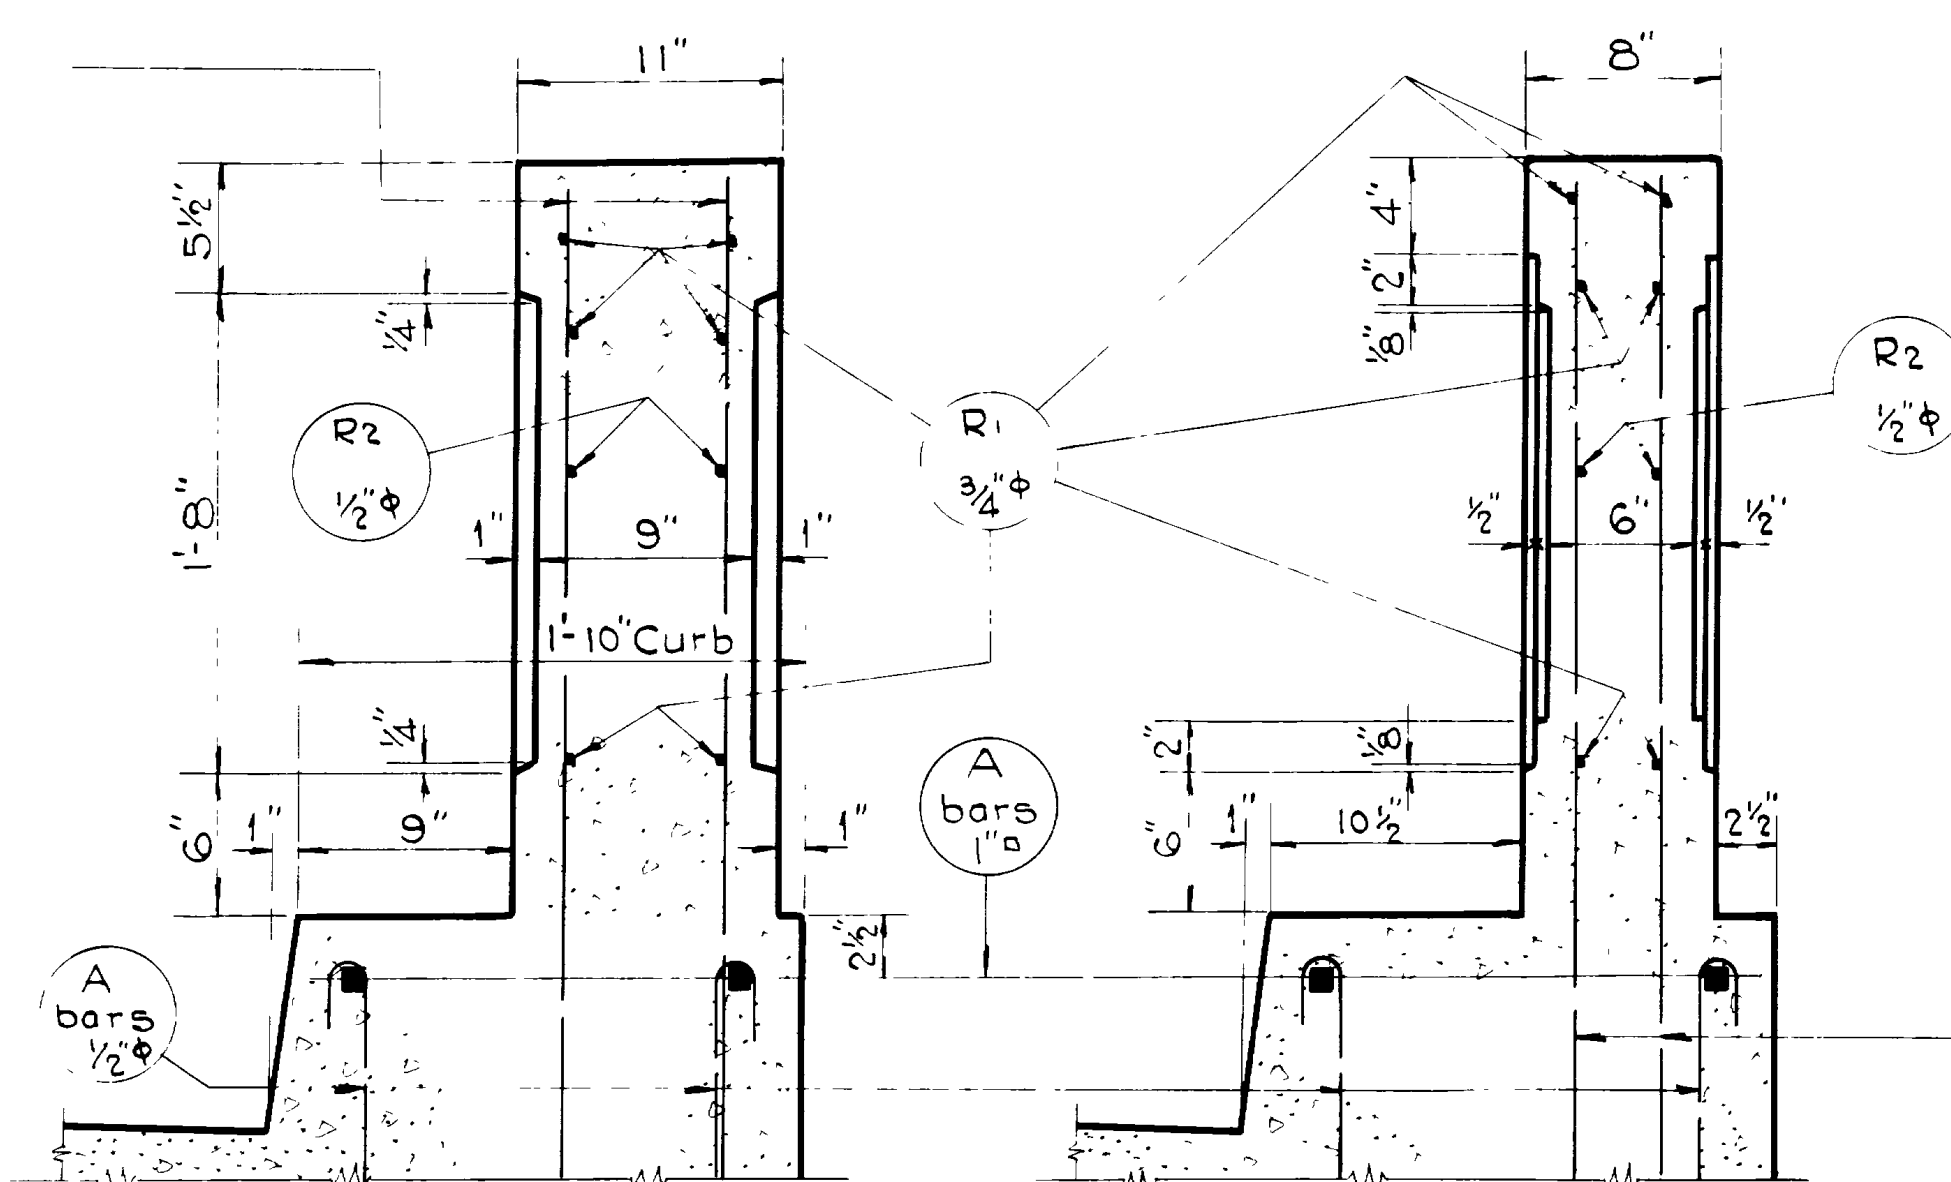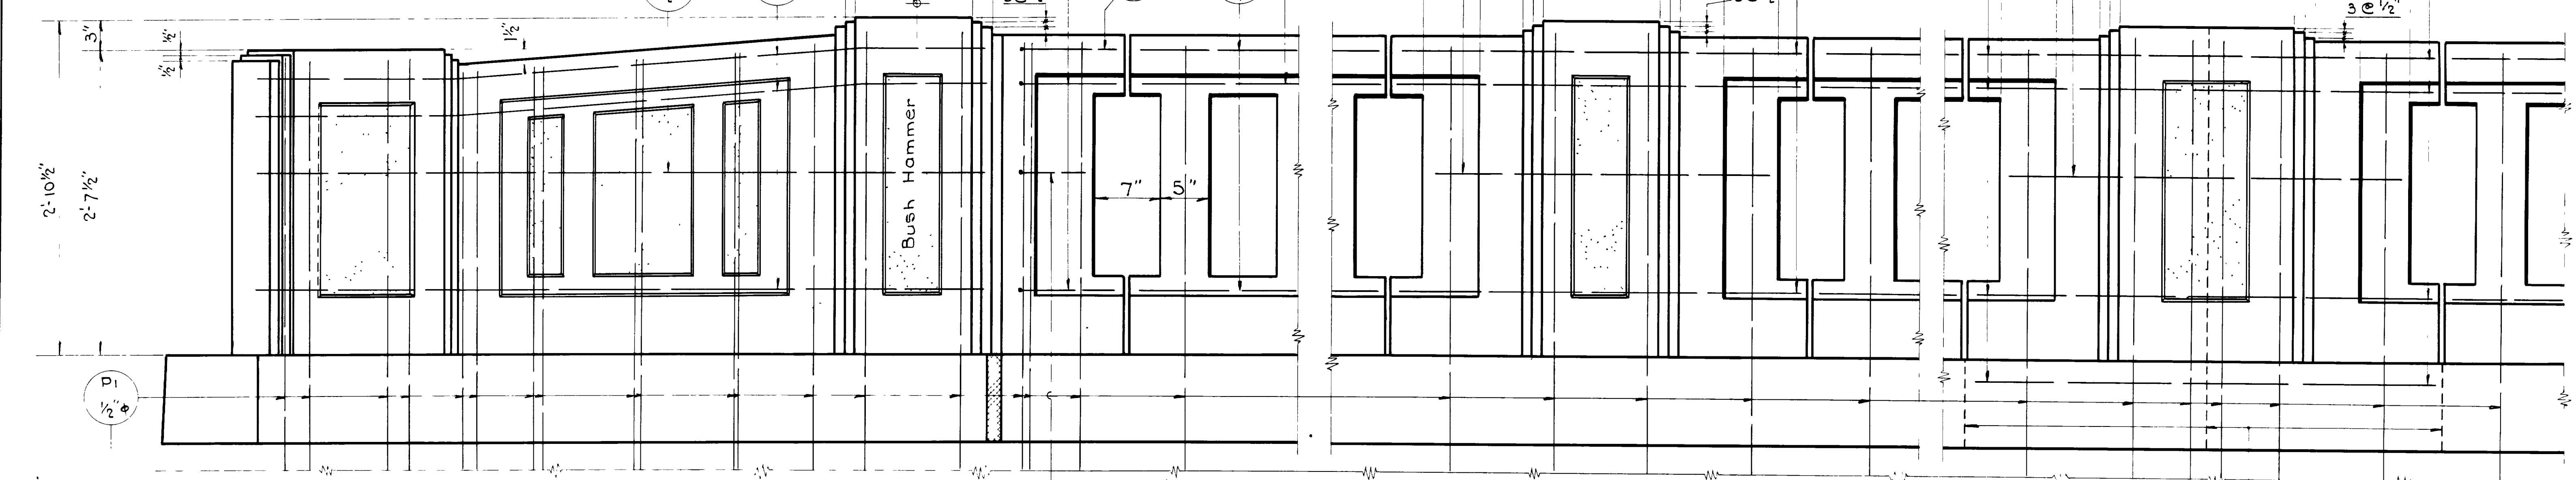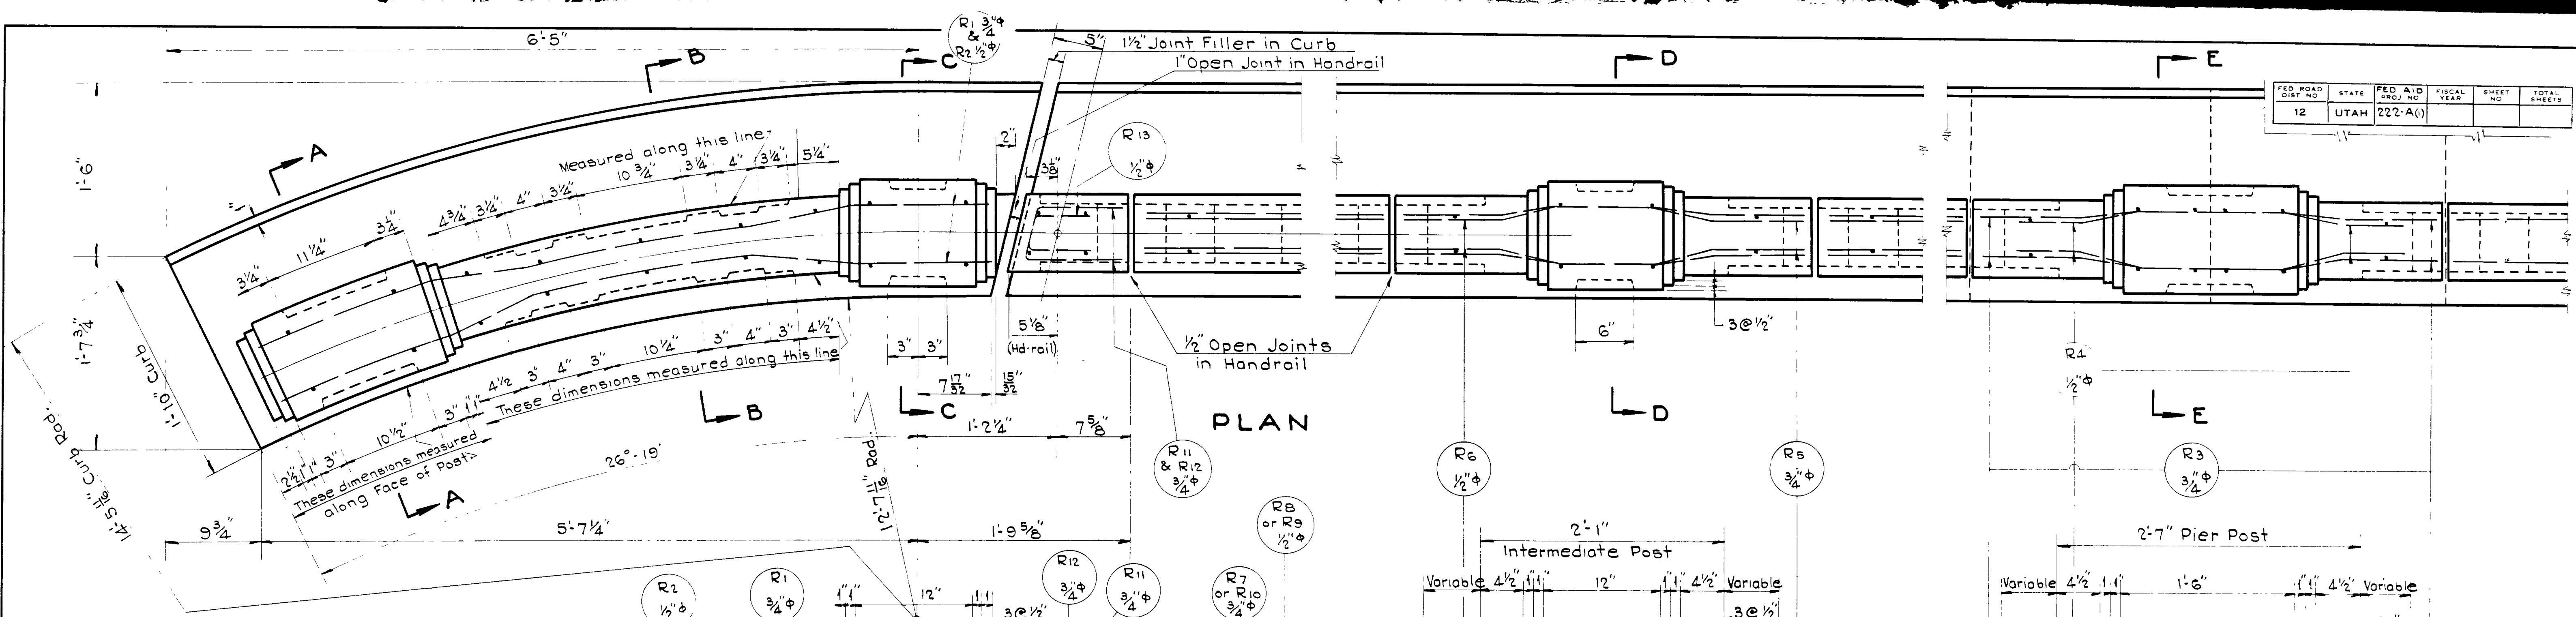

CONCRETE QUANTITIES

One End Post	13.00 Cu. Ft.
One Pier Post	4.69 " "
One Intermediate Post	3.38 " "
Railing per Lin. Ft.	1.19 " "
Variable Portion of Railing per Lin. Ft.	1.51 " "

HAND RAIL

Sheet 10 of 12 sheets
 UTAH STATE ROAD COMMISSION
 SALT LAKE CITY, UTAH
 ERA C. KNOWLTON, CHIEF ENGINEER
 BRIDGE OVER U.P. & L. CO'S
 PENSTOCKS
 A.W. (P.C.E.) F.A.P. 222 A(1)
 Sta. 52+50 Weber Co.
 Ogden Arsenal-Riverdale
 DESIGNED BY: F.M.E. SCALE: 1/2" = 1'-0"
 DRAWN BY: J.H.B. CHECKED BY: J.H.B. APPROVED BY: [Signature]
 DATE: May 22, 1944
 No. 29-259-1-2 Dwg. No. D-466

MARK	LOCATION	SIZE	LGTH	No BARS	TOTAL LENGTH	SKETCH	0 To 0
F 1	Retaining Wall Foot.	1/2"	4'-3"	5	21'-3"		3'-2"
F 2		1/2"	4'-8"	4	23'-4"		3'-7"
F 3		1/2"	5'-3"	4	26'-3"		4'-2"
F 4		1/2"	5'-9"	4	28'-9"		4'-8"
F 5		1/2"	5'-11"	4	29'-7"		4'-10"
F 6		1/2"	6'-5"	4	32'-1"		5'-4"
F 7		1/2"	7'-3"	4	36'-3"		5'-11"
F 8		1/2"	8'-3"	4	41'-3"		6'-7"
F 9		1/2"	9'-0"	4	45'-0"		7'-1"
F 10		1/2"	9'-7"	4	47'-11"		7'-8"
F 11		1/2"	9'-4"	4	46'-8"		7'-5"
F 12		1/2"	9'-0"	4	45'-0"		7'-1"
F 13		1/2"	7'-10"	4	39'-2"		6'-2"
F 14		1/2"	6'-5"	4	32'-1"		5'-4"
F 15		1/2"	3'-1"	5	25'-5"		4'-0"
F 16		1/2"	3'-6"	5	17'-6"		2'-5"
F 17	Retaining Wall Foot.	1/2"	4'-8"	120	560'-0"		
W 1	Retaining Wall	1/2"	6'-4"	1	6'-4"		2'-0"
W 2		1/2"	7'-0"	1	7'-0"		2'-0"
W 3		1/2"	7'-6"	1	7'-6"		2'-0"
W 4		1/2"	8'-1"	1	8'-1"		2'-0"
W 5		1/2"	8'-8"	1	8'-8"		2'-0"
W 6		1/2"	7'-7"	1	7'-7"		2'-3"
W 7		1/2"	8'-2"	1	8'-2"		2'-3"
W 8		1/2"	8'-9"	1	8'-9"		2'-3"
W 9		1/2"	9'-4"	1	9'-4"		2'-3"
W 10		1/2"	9'-11"	1	9'-11"		2'-3"
W 11	Retaining Wall	1/2"	9'-4"	1	9'-4"		2'-6"

MARK	LOCATION	SIZE	LGTH	No BARS	TOTAL LENGTH	SKETCH	0 To 0
W 12	Retaining Wall	1/2"	9'-11"	1	9'-11"		2'-6"
W 13		1/2"	10'-6"	1	10'-6"		2'-6"
W 14		1/2"	11'-1"	1	11'-1"		2'-6"
W 15		1/2"	11'-8"	1	11'-8"		2'-6"
W 16		1/2"	10'-7"	1	10'-7"		2'-9"
W 17		1/2"	11'-2"	1	11'-2"		2'-9"
W 18		1/2"	11'-9"	1	11'-9"		2'-9"
W 19		1/2"	12'-4"	1	12'-4"		2'-9"
W 20		1/2"	12'-11"	1	12'-11"		2'-9"
W 21		1/2"	11'-4"	1	11'-4"		2'-10"
W 22		1/2"	11'-10"	1	11'-10"		2'-10"
W 23		1/2"	12'-5"	1	12'-5"		2'-10"
W 24		1/2"	12'-11"	1	12'-11"		2'-10"
W 25		1/2"	13'-5"	1	13'-5"		2'-10"
W 26		1/2"	12'-5"	1	12'-5"		3'-0"
W 27		1/2"	12'-11"	1	12'-11"		3'-0"
W 28		1/2"	13'-6"	1	13'-6"		3'-0"
W 29		1/2"	14'-0"	1	14'-0"		3'-0"
W 30		1/2"	14'-7"	1	14'-7"		3'-0"
W 31		1/2"	14'-5"	1	14'-5"		3'-4"
W 32		1/2"	14'-10"	1	14'-10"		3'-4"
W 33		1/2"	15'-3"	1	15'-3"		3'-4"
W 34		1/2"	15'-8"	1	15'-8"		3'-4"
W 35		1/2"	16'-1"	1	16'-1"		3'-4"
W 36		1/2"	16'-0"	1	16'-0"		3'-8"
W 37		1/2"	16'-5"	1	16'-5"		3'-8"
W 38		1/2"	16'-11"	1	16'-11"		3'-8"
W 39		1/2"	17'-4"	1	17'-4"		3'-8"
W 40		1/2"	17'-10"	1	17'-10"		3'-8"
W 41		1/2"	17'-8"	1	17'-8"		3'-11"
W 42	Retaining Wall	1/2"	18'-1"	1	18'-1"		3'-11"

MARK	LOCATION	SIZE	LGTH	No BARS	TOTAL LENGTH	SKETCH	0 To 0
W 43	Retaining Wall	1/2"	18'-6"	1	18'-6"		3'-11"
W 44		1/2"	18'-11"	1	18'-11"		3'-11"
W 45		1/2"	19'-4"	1	19'-4"		3'-11"
W 46		1/2"	19'-2"	1	19'-2"		4'-2"
W 47		1/2"	19'-6"	1	19'-6"		4'-2"
W 48		1/2"	19'-11"	1	19'-11"		4'-2"
W 49		1/2"	20'-3"	1	20'-3"		4'-2"
W 50		1/2"	20'-8"	1	20'-8"		4'-2"
W 51		1/2"	19'-4"	1	19'-4"		4'-1"
W 52		1/2"	19'-7"	1	19'-7"		4'-1"
W 53		1/2"	19'-10"	1	19'-10"		4'-1"
W 54		1/2"	20'-1"	1	20'-1"		4'-1"
W 55		1/2"	20'-4"	1	20'-4"		4'-1"
W 56		1/2"	18'-4"	1	18'-4"		3'-11"
W 57		1/2"	18'-7"	1	18'-7"		3'-11"
W 58		1/2"	18'-10"	1	18'-10"		3'-11"
W 59		1/2"	19'-1"	1	19'-1"		3'-11"
W 60		1/2"	19'-4"	1	19'-4"		3'-11"
W 61		1/2"	16'-6"	1	16'-6"		3'-6"
W 62		1/2"	16'-8"	1	16'-8"		3'-6"
W 63		1/2"	16'-9"	1	16'-9"		3'-6"
W 64		1/2"	16'-10"	1	16'-10"		3'-6"
W 65		1/2"	17'-0"	1	17'-0"		3'-6"
W 66		1/2"	14'-2"	1	14'-2"		3'-0"
W 67		1/2"	14'-4"	1	14'-4"		3'-0"
W 68		1/2"	14'-5"	1	14'-5"		3'-0"
W 69		1/2"	14'-7"	1	14'-7"		3'-0"
W 70		1/2"	14'-9"	1	14'-9"		3'-0"
W 71		1/2"	11'-2"	1	11'-2"		2'-4"
W 72		1/2"	11'-1"	1	11'-1"		2'-4"
W 73	Retaining Wall	1/2"	11'-1"	1	11'-1"		2'-4"

MARK	LOCATION	SIZE	LGTH	No BARS	TOTAL LENGTH	SKETCH	0 To 0
W 74	Retaining Wall	3/4"	11'-0"	1	11'-0"		2'-4"
W 75		3/4"	11'-0"	1	11'-0"		2'-4"
W 76		3/4"	7'-2"	1	7'-2"		1'-7"
W 77		3/4"	7'-1"	1	7'-1"		1'-7"
W 78		3/4"	7'-1"	1	7'-1"		1'-7"
W 79		3/4"	7'-0"	1	7'-0"		1'-7"
W 80		3/4"	6'-11"	1	6'-11"		1'-7"
L 1		1/2"	4'-8"	3	14'-0"		
L 2		1/2"	9'-8"	3	29'-0"		
L 3		1/2"	8'-6"	1	8'-6"		
L 4		1/2"	12'-0"	1	12'-0"		
L 5		1/2"	10'-2"	1	10'-2"		
L 6		1/2"	13'-6"	1	13'-6"		
L 7		1/2"	12'-0"	1	12'-0"		
L 8		1/2"	15'-0"	2	30'-0"		
L 9		1/2"	13'-6"	1	13'-6"		
L 10		1/2"	16'-9"	1	16'-9"		
L 11		1/2"	20'-0"	2	40'-0"		
L 12		1/2"	23'-6"	1	23'-6"		
L 13		1/2"	21'-9"	1	21'-9"		
L 14		1/2"	18'-4"	1	18'-4"		
L 15		1/2"	16'-6"	1	16'-6"		
L 16		1/2"	14'-8"	3	44'-0"		
L 17		1/2"	12'-9"	1	12'-9"		
L 18	Retaining Wall	1/2"	10'-9"	1	10'-9"		

REVISIONS
BY
DATE

MARK	LOCATION	SIZE	LGTH	No BARS	TOTAL LENGTH	SKETCH	0 To 0
L 19	Retaining Wall	1/2"	8'-9"	1	8'-9"		
L 20		1/2"	6'-9"	1	6'-9"		
L 21		1/2"	4'-3"	1	4'-3"		
L 22		1/2"	2'-0"	1	2'-0"		
L 23		1/2"	24'-0"	4	96'-0"		
L 24		1/2"	19'-8"	2	39'-4"		
L 25		1/2"	24'-8"	2	49'-4"		
L 26		1/2"	29'-8"	2	59'-4"		
L 27		1/2"	29'-0"	1	29'-0"		
L 28		1/2"	31'-6"	1	31'-6"		
L 29		1/2"	29'-0"	1	29'-0"		
L 30		1/2"	26'-6"	1	26'-6"		
L 31		1/2"	29'-0"	1	29'-0"		
L 32		1/2"	24'-6"	1	24'-6"		
L 33	Retaining Wall	1/2"	20'-6"	1	20'-6"		
B 1	Bent @ Sta. 52+14	1"	19'-4"	8	154'-8"		17'-2"
B 2		1"	18'-4"	4	73'-4"		16'-2"
B 3		1"	17'-4"	4	69'-4"		15'-2"
B 4		1"	15'-4"	4	61'-4"		13'-2"
B 5		1"	12'-10"	4	51'-4"		10'-8"
B 6		1"	10'-4"	4	41'-4"		8'-2"
B 7	Bent @ Sta. 52+14	1"	8'-4"	4	33'-4"		6'-2"
B 8	Bents @ Sta. 52+14, 52+50 & 52+86	1"	7'-2"	216	1548'-0"		7'-0"
B 9		1"	33'-3"	36	1197'-0"		
B 10	Bents @ Sta. 52+14, 52+50 & 52+86	1"	8'-0"	36	288'-0"		

MARK	LOCATION	SIZE	LGTH	No BARS	TOTAL LENGTH	SKETCH	0 To 0
B 11	Bents @ Sta. 52+14, 52+50 & 52+86	1/2"	4'-6"	108	486'-0"		
B 12		1/2"	39'-0"	18	702'-0"		37'-11"
B 13	Bents @ Sta. 52+14, 52+50 & 52+86	1/2"	3'-10"	15	57'-6"		
B 14	Bent @ Sta. 52+86	1/2"	4'-8"	3	14'-0"	Ditto but "A" = 2'-2"	
B 15	Bent @ Sta. 52+14, 52+50 & 52+86	1/2"	1'-9"	12	21'-0"		
B 16	Bent @ Sta. (52+14, 52+50 & 52+86)	1/2"	73'-0"	24	1752'-0"		
B 17	Bent @ Sta. (52+14, 52+50 & 52+86)	1/2"	133'-0"	3	399'-0"		
B 18	Bent @ Sta. (52+14, 52+50 & 52+86)	1/2"	125'-0"	2	250'-0"		
B 19	Bent @ Sta. 52+14	1/2"	116'-0"	1	116'-0"		
B 20	Bent @ Sta. (52+14, 52+50 & 52+86)	1/2"	100'-0"	2	200'-0"		
B 21	Bent @ Sta. (52+14, 52+50 & 52+86)	1/2"	80'-0"	3	240'-0"		
B 22	Bent @ Sta. 52+14	1/2"	60'-0"	1	60'-0"		
B 23	Bent @ Sta. (52+14, 52+50 & 52+86)	1/2"	44'-0"	3	132'-0"		
B 24	Bent @ Sta. 52+86	1/2"	28'-0"	1	28'-0"		
B 25		1/2"	52'-0"	1	52'-0"		
B 26		1/2"	64'-0"	1	64'-0"		
B 27		1/2"	97'-0"	1	97'-0"		
B 28	Bent @ Sta. 52+86	1/2"	113'-0"	1	113'-0"		
B 29	Bent @ Sta. 52+50	1/2"	121'-0"	1	121'-0"		
B 30		1/2"	145'-0"	1	145'-0"		
B 31		1/2"	157'-0"	1	157'-0"		
B 32		1/2"	8'-6"	4	34'-0"		6'-4"
B 33	Bent @ Sta. 52+50	1/2"	10'-6"	4	42'-0"		8'-4"
B 34	Bent @ Sta. (52+14, 52+50 & 52+86)	1/2"	12'-6"	8	100'-0"		10'-4"

* This steel to be used in the Cast-in-place Piles.

MARK	LOCATION	SIZE	LGTH	No BARS	TOTAL LENGTH	SKETCH	0 To 0
B 35	Bent @ Sta. 52+50	1"	15'-0"	4	60'-0"		12'-10"
B 36		1"	17'-6"	4	70'-0"		15'-4"
B 37		1"	19'-0"	4	76'-0"		16'-10"
B 38		1"	20'-6"	4	82'-0"		18'-4"
B 39	Bent @ Sta. 52+50	1"	22'-0"	4	88'-0"		19'-10"
B 40	Bent @ Sta. 52+86	1"	6'-2"	4	24'-8"		4'-0"
B 41		1"	8'-0"	4	32'-0"		5'-10"
B 42		1"	9'-2"	4	36'-8"		7'-0"
B 43		1"	10'-8"	4	42'-8"		8'-6"
B 44		1"	14'-8"	4	58'-8"		12'-6"
B 45		1"	16'-8"	4	66'-8"		14'-6"
B 46	Bent @ Sta. 52+86	1"	18'-0"	4	72'-0"		

MARK	LOCATION	SIZE	LGTH	No. BARS	TOTAL LENGTH	SKETCH	0 TO 0
A 8	Abutments	1/2"	10'-6"	74	777'-0"		
A 9	Down-grade Abut	1/2"	8'-6"	4	34'-0"		7'-5"
A 10		1/2"	8'-7"	1	34'-4"		7'-6"
A 11		1/2"	8'-8"	1	34'-8"		7'-7"
A 12		1/2"	8'-9"	1	35'-0"		7'-8"
A 13		1/2"	8'-10"	1	35'-4"		7'-9"
A 14		1/2"	8'-11"	1	35'-8"		7'-10"
A 15		1/2"	9'-0"	4	36'-0"		7'-11"
A 16		1/2"	9'-1"	5	45'-5"		8'-0"
A 17	Down-grade Abut	1/2"	10'-0"	3	30'-0"		8'-11"
S 1	Deck Slab Bottom (28' Spans)	1"	24'-10"	108	2682'-0"	See Sketch 	22'-5"
S 2	Deck Slab Bottom	1"	22'-6"	56	1260'-0"	See Sketch 	20'-4"

MARK	LOCATION	SIZE	LGTH	No. BARS	TOTAL LENGTH	SKETCH	0 TO 0
S 3	Deck Slab Bottom (Over Center Bent)	1"	22'-6"	28	630'-0"	See Sketch 	20'-4"
S 4	Deck Slab Bottom	1"	27'-9"	108	2997'-0"	See Sketch 	24'-10"
S 5	Deck Slab Top	1"	23'-0"	108	2484'-0"	See Sketch 	20'-0 1/2"
S 6	Deck Slab Top	1"	23'-2"	54	1251'-0"	See Sketch 	20'-2"
S 7	Deck Slab Bottom (Trans)	1"	38'-2"	68	2595'-4"		36'-0"
S 8	Deck Slab Top & Bottom	1/2"	37'-1"	189	7008'-9"		36'-0"
S 9	Deck Slab Top 28' Spans	1/2"	22'-0"	108	2376'-0"		20'-11"
S 10	Deck Slab Top 36' "	1/2"	22'-6"	108	2430'-0"		21'-5"

MARK	LOCATION	SIZE	LGTH	No. BARS	TOTAL LENGTH	SKETCH	0 TO 0
S 11	Deck Slab	1/2"	3'-0"	80	240'-0"	See Sketch 	1'-10 1/2"
S 12		1/2"	2'-8"	213'-4"	186'-8"	Ditto but A = 1'-5 3/4"	1'-6 3/4"
S 13		1/2"	2'-4"	186'-8"	173'-4"	Ditto but A = 1'-2"	1'-3"
S 14		1/2"	2'-2"	80	173'-4"	Ditto but A = 0'-11 3/4"	1'-0 3/4"
S 15	Deck Slab	1/2"	2'-1"	40	86'-8"	Ditto but A = 0'-11"	1'-0"
A 18	Abutment Curb	1"	14'-0"	4	56'-0"	See Sketch 	
A 19		1/2"	9'-3"	12	111'-0"		8'-2"
A 20	Abutment Curb	1/2"	6'-4"	18	114'-0"		5'-3"
A 21	Up-grade Abut.	1/2"	9'-10"	7	68'-10"		
A 22	Up-grade Abut.	1/2"	6'-6"	13	84'-6"		5'-5"
A 23	Both Abutments	1/2"	2'-6"	6	15'-6"		
A 24		1/2"	4'-4"	20	86'-8"		3'-3"
A 25	Both Abutments	1/2"	7'-9"	10	77'-6"	See Sketch 	
A 26	Up-grade Abut.	1/2"	8'-3"	4	33'-0"	Ditto but A = 3'-11"	
A 27	Up-grade Abut.	1/2"	2'-10"	5	15'-0"		

MARK	LOCATION	SIZE	LGTH	No. BARS	TOTAL LENGTH	SKETCH	0 TO 0
A 28	Up-grade Abut.	1"	14'-0"	1	14'-0"	See Sketch 	
A 29	Down-grade Abut.	1"	15'-6"	1	15'-6"		
A 30	Up-grade Abut.	1"	13'-0"	1	13'-0"		
A 31	Down-grade Abut.	1"	14'-6"	1	14'-6"		
A 32	Both Abutments	1/2"	7'-6"	8	60'-0"		6'-5"
A 33		1/2"	8'-2"	4	32'-8"		7'-1"
A 34		1/2"	7'-2"	4	28'-8"		6'-1"
A 35		1/2"	10'-0"	7	70'-0"		8'-11"
A 36	Both Abutments	1/2"	9'-0"	7	63'-0"		7'-11"
A 37	Down-grade Abut.	1/2"	7'-0"	11	77'-0"		5'-11"
P 1	Hand Rail	1/2"	4'-3"	624	2652'-0"		
R 1	End Posts	3/4"	6'-3"	24	150'-0"		Field Bend
R 2	End Posts	1/2"	6'-3"	8	50'-0"		
R 3	Pier Posts	3/4"	2'-0"	96	192'-0"		
R 4	Pier Posts	1/2"	1'-8"	24	40'-0"		
R 5	Int. Post.	3/4"	3'-6"	96	336'-0"		Field Bend
R 6	Int. Post.	1/2"	3'-0"	32	96'-0"		
R 7	Railing End Spans	3/4"	5'-8"	48	272'-0"		
R 8		1/2"	5'-8"	24	136'-0"		
R 9		1/2"	7'-8"	24	184'-0"		
R 10	Railing End Spans	3/4"	7'-8"	48	368'-0"		

REVISIONS	DATE	BY

MARK	LOCATION	SIZE	LGTH	No. BARS	TOTAL LENGTH	SKETCH	0 TO 0
R 11	End Spans	3/4"	2'-0"	8	16'-0"	8 1/2" 10" 5 1/2" 5 3/8"	
R 12	" "	3/4"	1'-10"	16	29'-4"	9" 9 1/4" 3 1/2" 3 3/8"	
R 13	End Spans	1/2"	1'-4"	8	10'-8"	5 3/4" 6 1/4" 3 1/2" 3 5/8"	


TOTAL REINFORCING STEEL

7437.00	Lin. Ft	1/4" #	@ 0.167 #	= 1242.0
23169.75	" "	1/2" #	@ 0.668 #	= 15477.4
17463.75	" "	3/8" #	@ 0.850 #	= 14853.2
1561.67	" "	3/4" #	@ 1.502 #	= 2345.6
800.00	" "	7/8" #	@ 2.044 #	= 1635.2
2595.33	" "	1" #	@ 2.670 #	= 6929.5
15323.00	" "	1 1/8" #	@ 4.303 #	= 52098.2
	" "	1 1/4" #	@ 5.313 #	= 82906.9

Total = ~~82,906.9~~ Lbs.
= 79,727.9

REINFORCING STEEL

Sheet 12 of 12 sheets
 UTAH STATE ROAD COMMISSION
 SALT LAKE CITY - UTAH
 EZRA C. KNOWLTON, CHIEF ENGINEER
 BRIDGE OVER U.P. & L.CO'S
 PENSTOCKS
 A.W.(P.C.E.) F.A.P. 222-A(1)
 Sta. 52+50 Weber Co.
 Ogden Arsenal - Riverdale
 DESIGNED BY: F.M.E. SEC-1
 DRAWN BY: R.M.E. HB
 CHECKED BY: *[Signature]*
 APPROVED BY: *[Signature]*
 DATE: May 22 1941
 BR. No. 29-259-1-2 DPG No. D-466

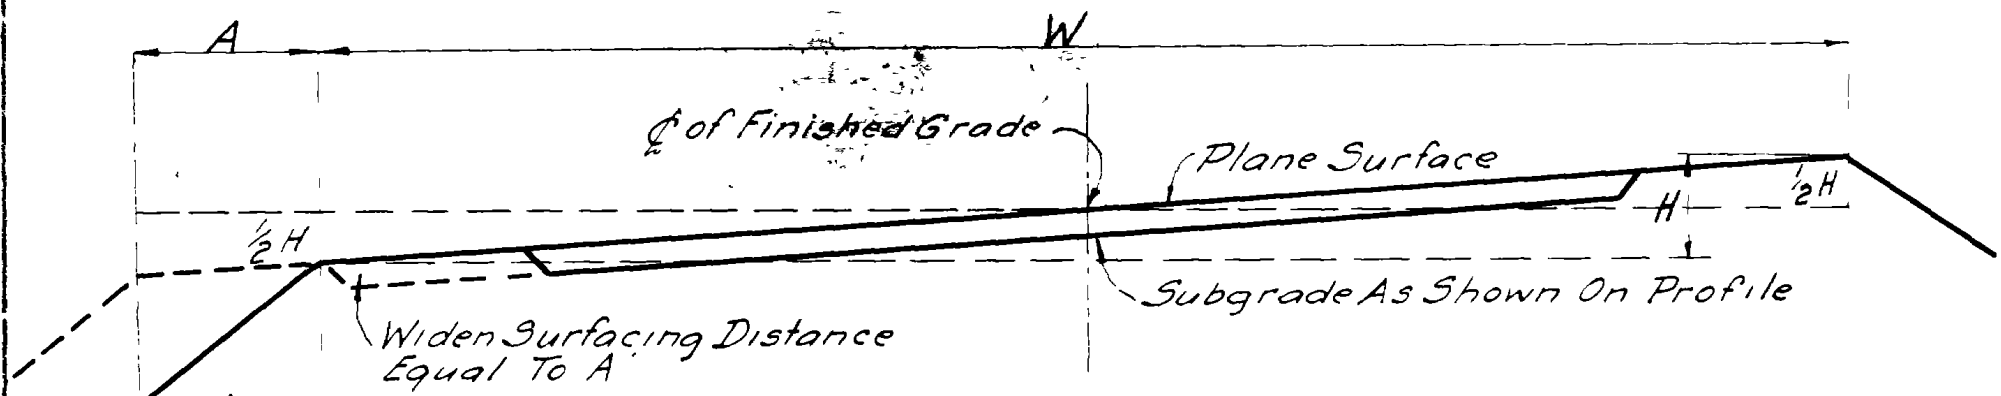

(Extra Width if Curve is Widened)

WIDENING SCHEDULE:
 4° Curves To 7° A = 2
 Over 7° To 12° A = 4
 Over 12° A = 6

$H = .02 \times WD$
 D = Degree of Curve
 W = Width of Roadway

Superelevate All Curves.
 Superelevation Transition Shall Be Equal To The Length of Spiral on Spiraled Curves
 On Curves Not Spiraled, Use Transition as Follows, The Transition Beg. & Ending Equal Distances From PC & PT. of Curves

0°30'	to 1°30'	- 100'	Total Trans
Over 1°30'	" 2°00'	- 140'	"
" 2°00'	" 2°30'	- 180'	"
" 2°30'	" 3°00'	- 220'	"
" 3°00'	" 3°30'	- 240'	"
" 3°30'	"	- 280'	"

On All Curves Sharper Than 4° Use 4 For Value of D When Grade is Less Than 4%
 On Grades Over 4% Use 3 For Value of 'D' For Curves Over 3°

The Surface of The Roadway ^{on Curves} Shall be a Plane Surface Across Entire Section & of Grade Shall be Held, Inner & Outer Edge Lowered & Raised Respective y a Distance ^{Equal to 1/2 H} A Except in Flat Country When Bad Drainage Conditions Might Develop, or When Otherwise Directed, ~~in which case~~ Hold Inner Edge and Raise The Outer Edge a Distance Equal to 'H'

WIDENING:

4° Curves or Sharper Shall be Widened if Indicated on Plans or Directed by Engineer Transition Shall be Same as Specified For Super. Curve Shall be Widened on Inside Distance 'A' According to Above Schedule.

UTAH STATE ROAD COMMISSION
 SALT LAKE CITY - UTAH
 H. S. ... ENGINEER



STANDARD FOR SUPERELEVATING & WIDENING OF CURVES

DESIGNED BY W.L.A.
 DRAWN BY Miller
 CHECKED BY
 DATE 6-7-40
 APPROVED BY

BRIDGE NO. DRG NO. J-479

TYPICAL CROSS SECTION

FED. ROAD DIST. NO.	STATE	F.A. PROJ. NO.	FISCAL YEAR	SHEET NO.	TOTAL SHEETS
12	UTAH	222 B(1)	1942	3-A	10
		EA. WK. # 12(U)	1942		10

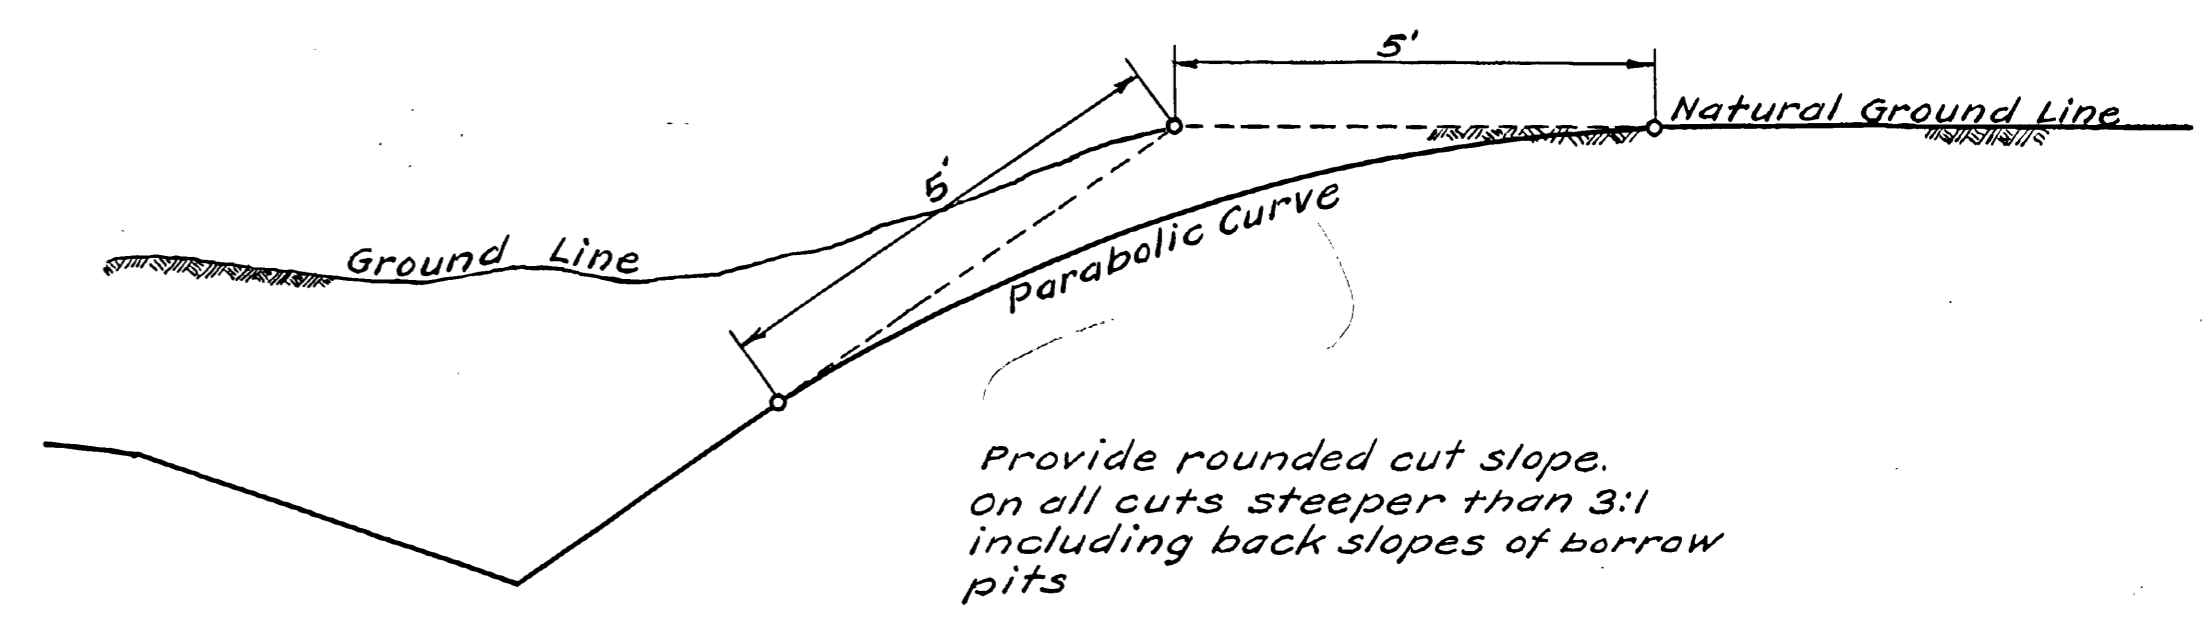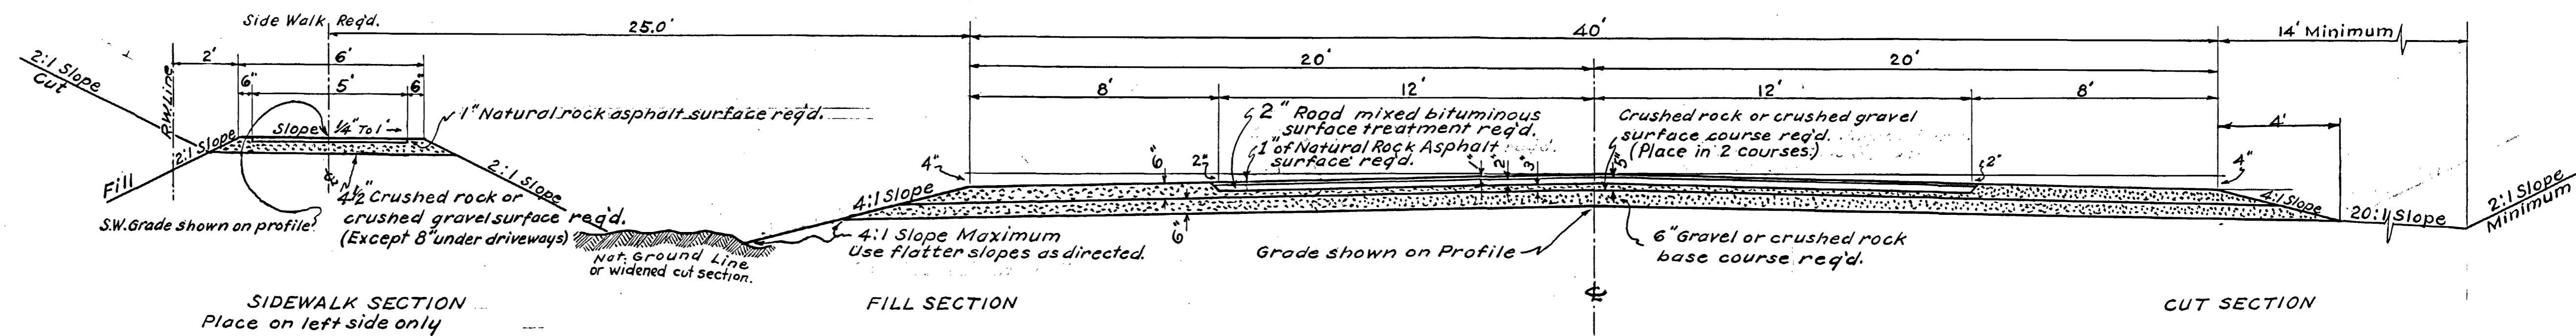

REVISIONS	
DATE	BY


UTAH STATE ROAD COMMISSION
SALT LAKE CITY - UTAH
W.L. ANDERSON DESIGN ENGINEER

- TYPE -

Bituminous Surfaced Roadway

P.O. ROAD DIST. NO.	STATE	PLD. AND PROJ. NO.	FINAL YEAR	SHEET NO.	TOTAL SHEETS
12	UTAH	222B(1)1942	4	10	10


J.B. BURNS 1941
 J.B. BURNS
 H.S. WRIGHT
 H.S. WRIGHT
 4799 TRACED

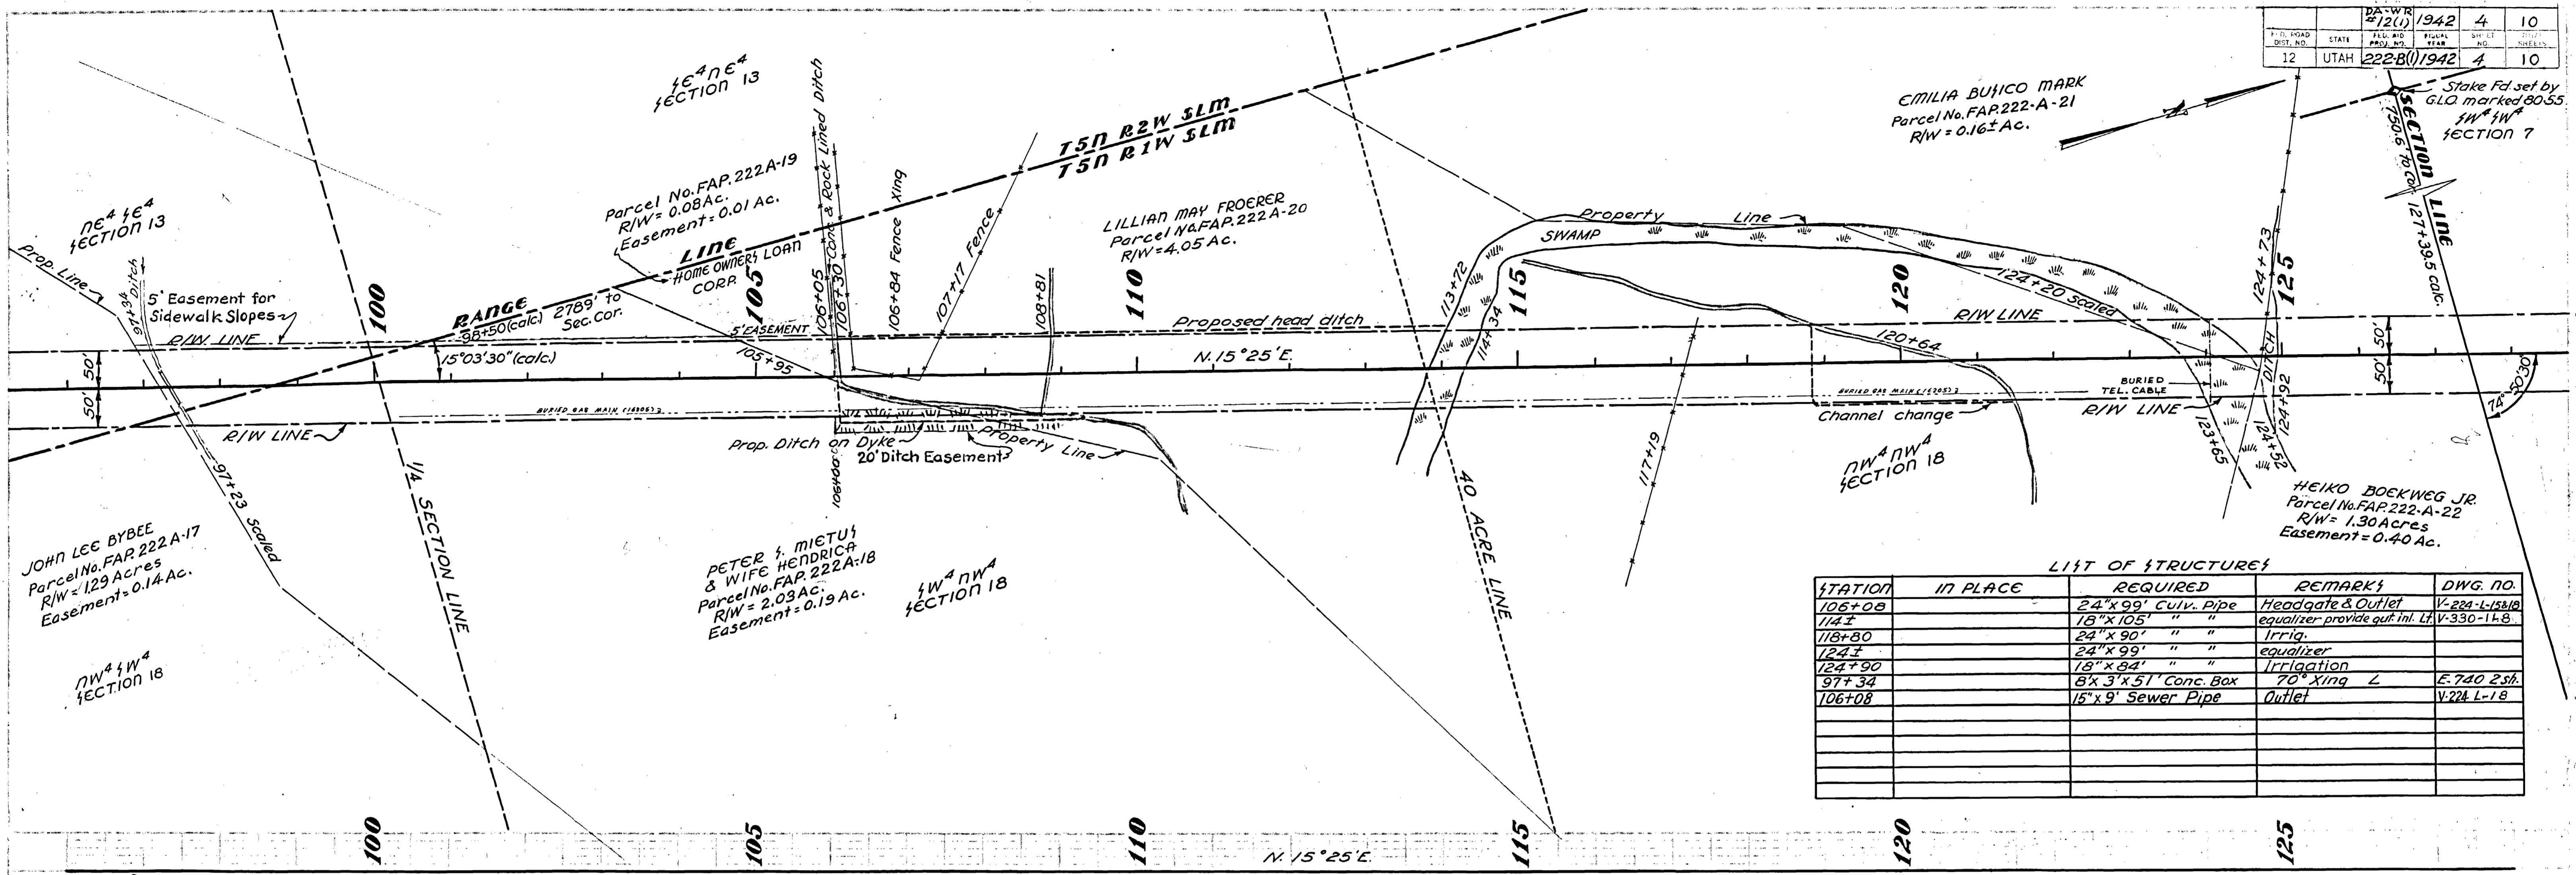

LIST OF STRUCTURES

STATION	IN PLACE	REQUIRED	REMARKS	DWG. NO.
106+08		24" x 99' Conv. Pipe	Headgate & Outlet	V-224-L-15B
114±		18" x 105' " "	equalizer provide quit int. Lt.	V-330-14B
118+80		24" x 90' " "	Irrig.	
124±		24" x 99' " "	equalizer	
124+90		18" x 84' " "	Irrigation	
97+34		8' x 3' x 51' Conc. Box	70° Xing L	E-740 2sh
106+08		15" x 9' Sewer Pipe	Outlet	V-224-L-18



J.B. BURNS 1941
 J.B. BURNS
 H.S. WRIGHT
 H.S. WRIGHT
 4799

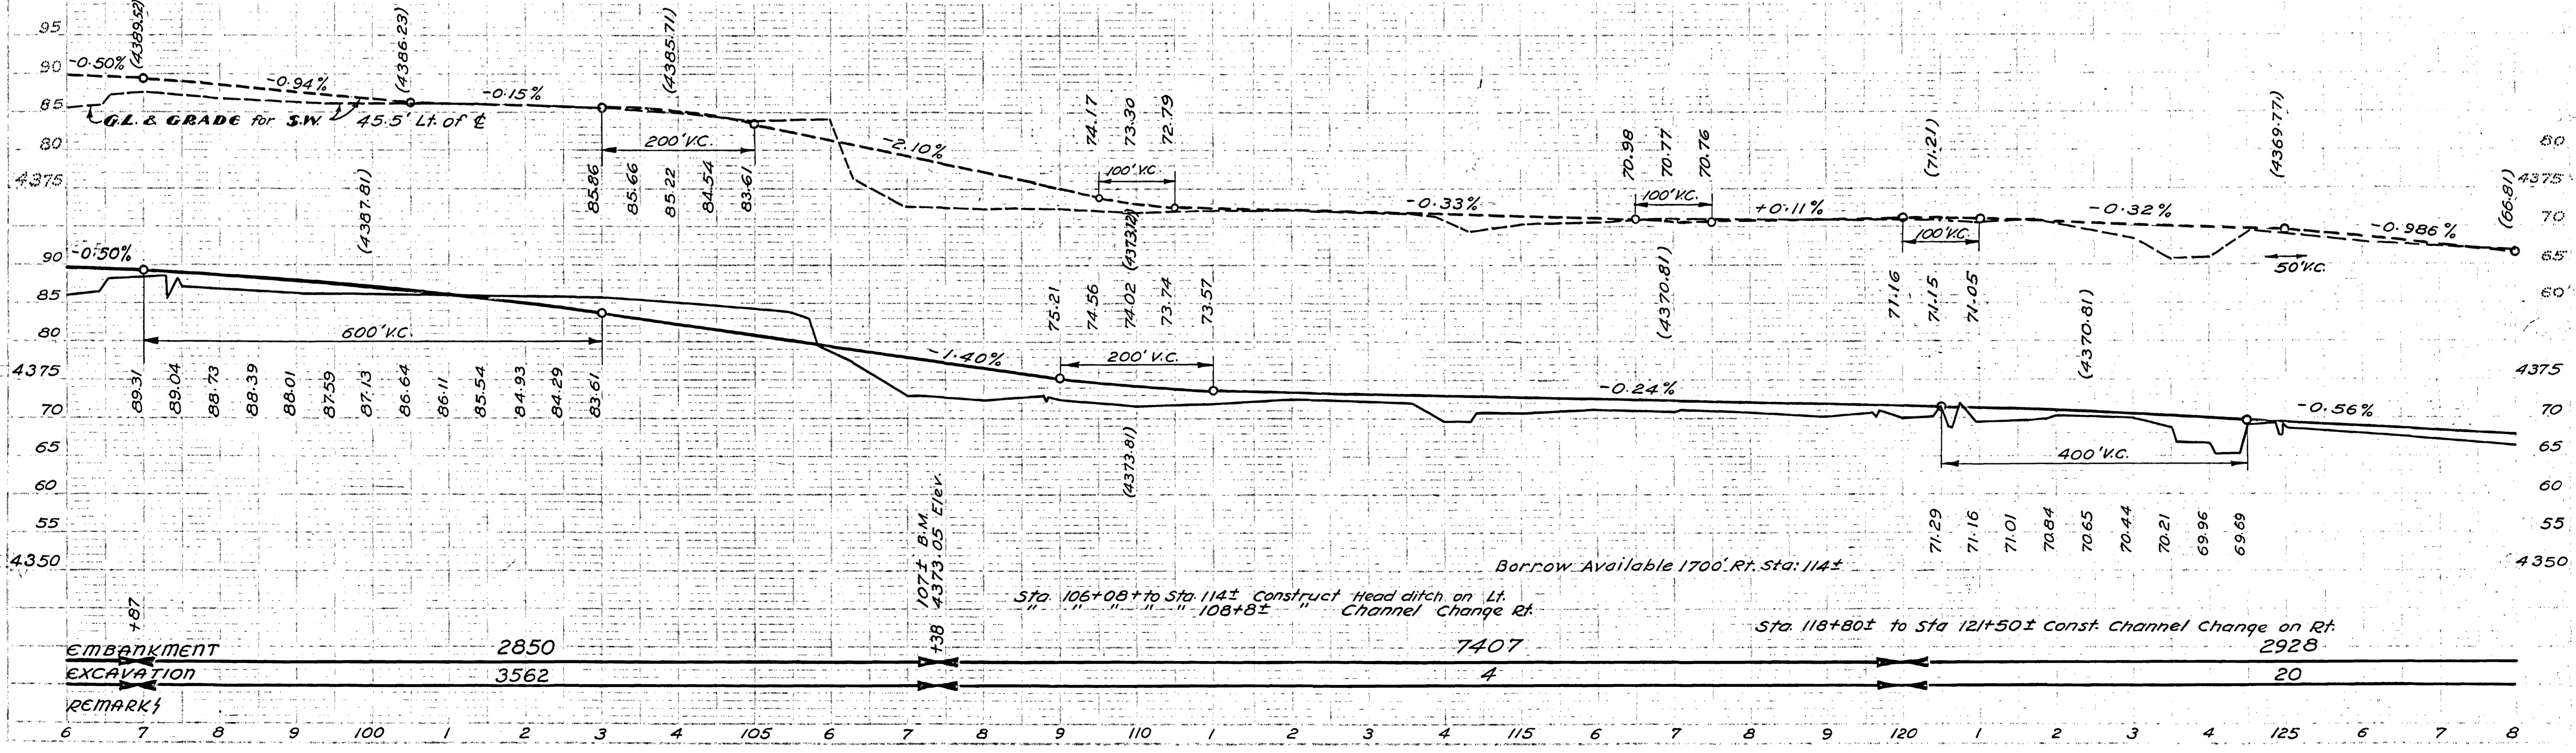

Sta. 106+08 to Sta. 114± Construct Head ditch on Lt.
 " " " " " 108+8± " Channel Change Rt.
 Sta. 118+80± to Sta. 121+50± Const. Channel Change on Rt.

EMBANKMENT	2850
EXCAVATION	3562
REMARKS	

UTAH STATE ROAD COMMISSION
 SALT LAKE CITY, UTAH
 W. LANDERSON
 DESIGN ENGINEER
 CHANNELIZATION AT INTER-
 SECTION OF SNA-FAR 114-A(4) &
 114-B(3) & AW(P) FAR 222-B(1) &
 DAW-R #12(1)
 SCALE: 1"=50'
 DESIGNED BY: W.L.A.
 CHECKED BY: H.S.W.
 DRAWN BY: F.L.R.
 APPROVED: _____
 CHIEF ENGINEER
 NO. _____
 NO. _____

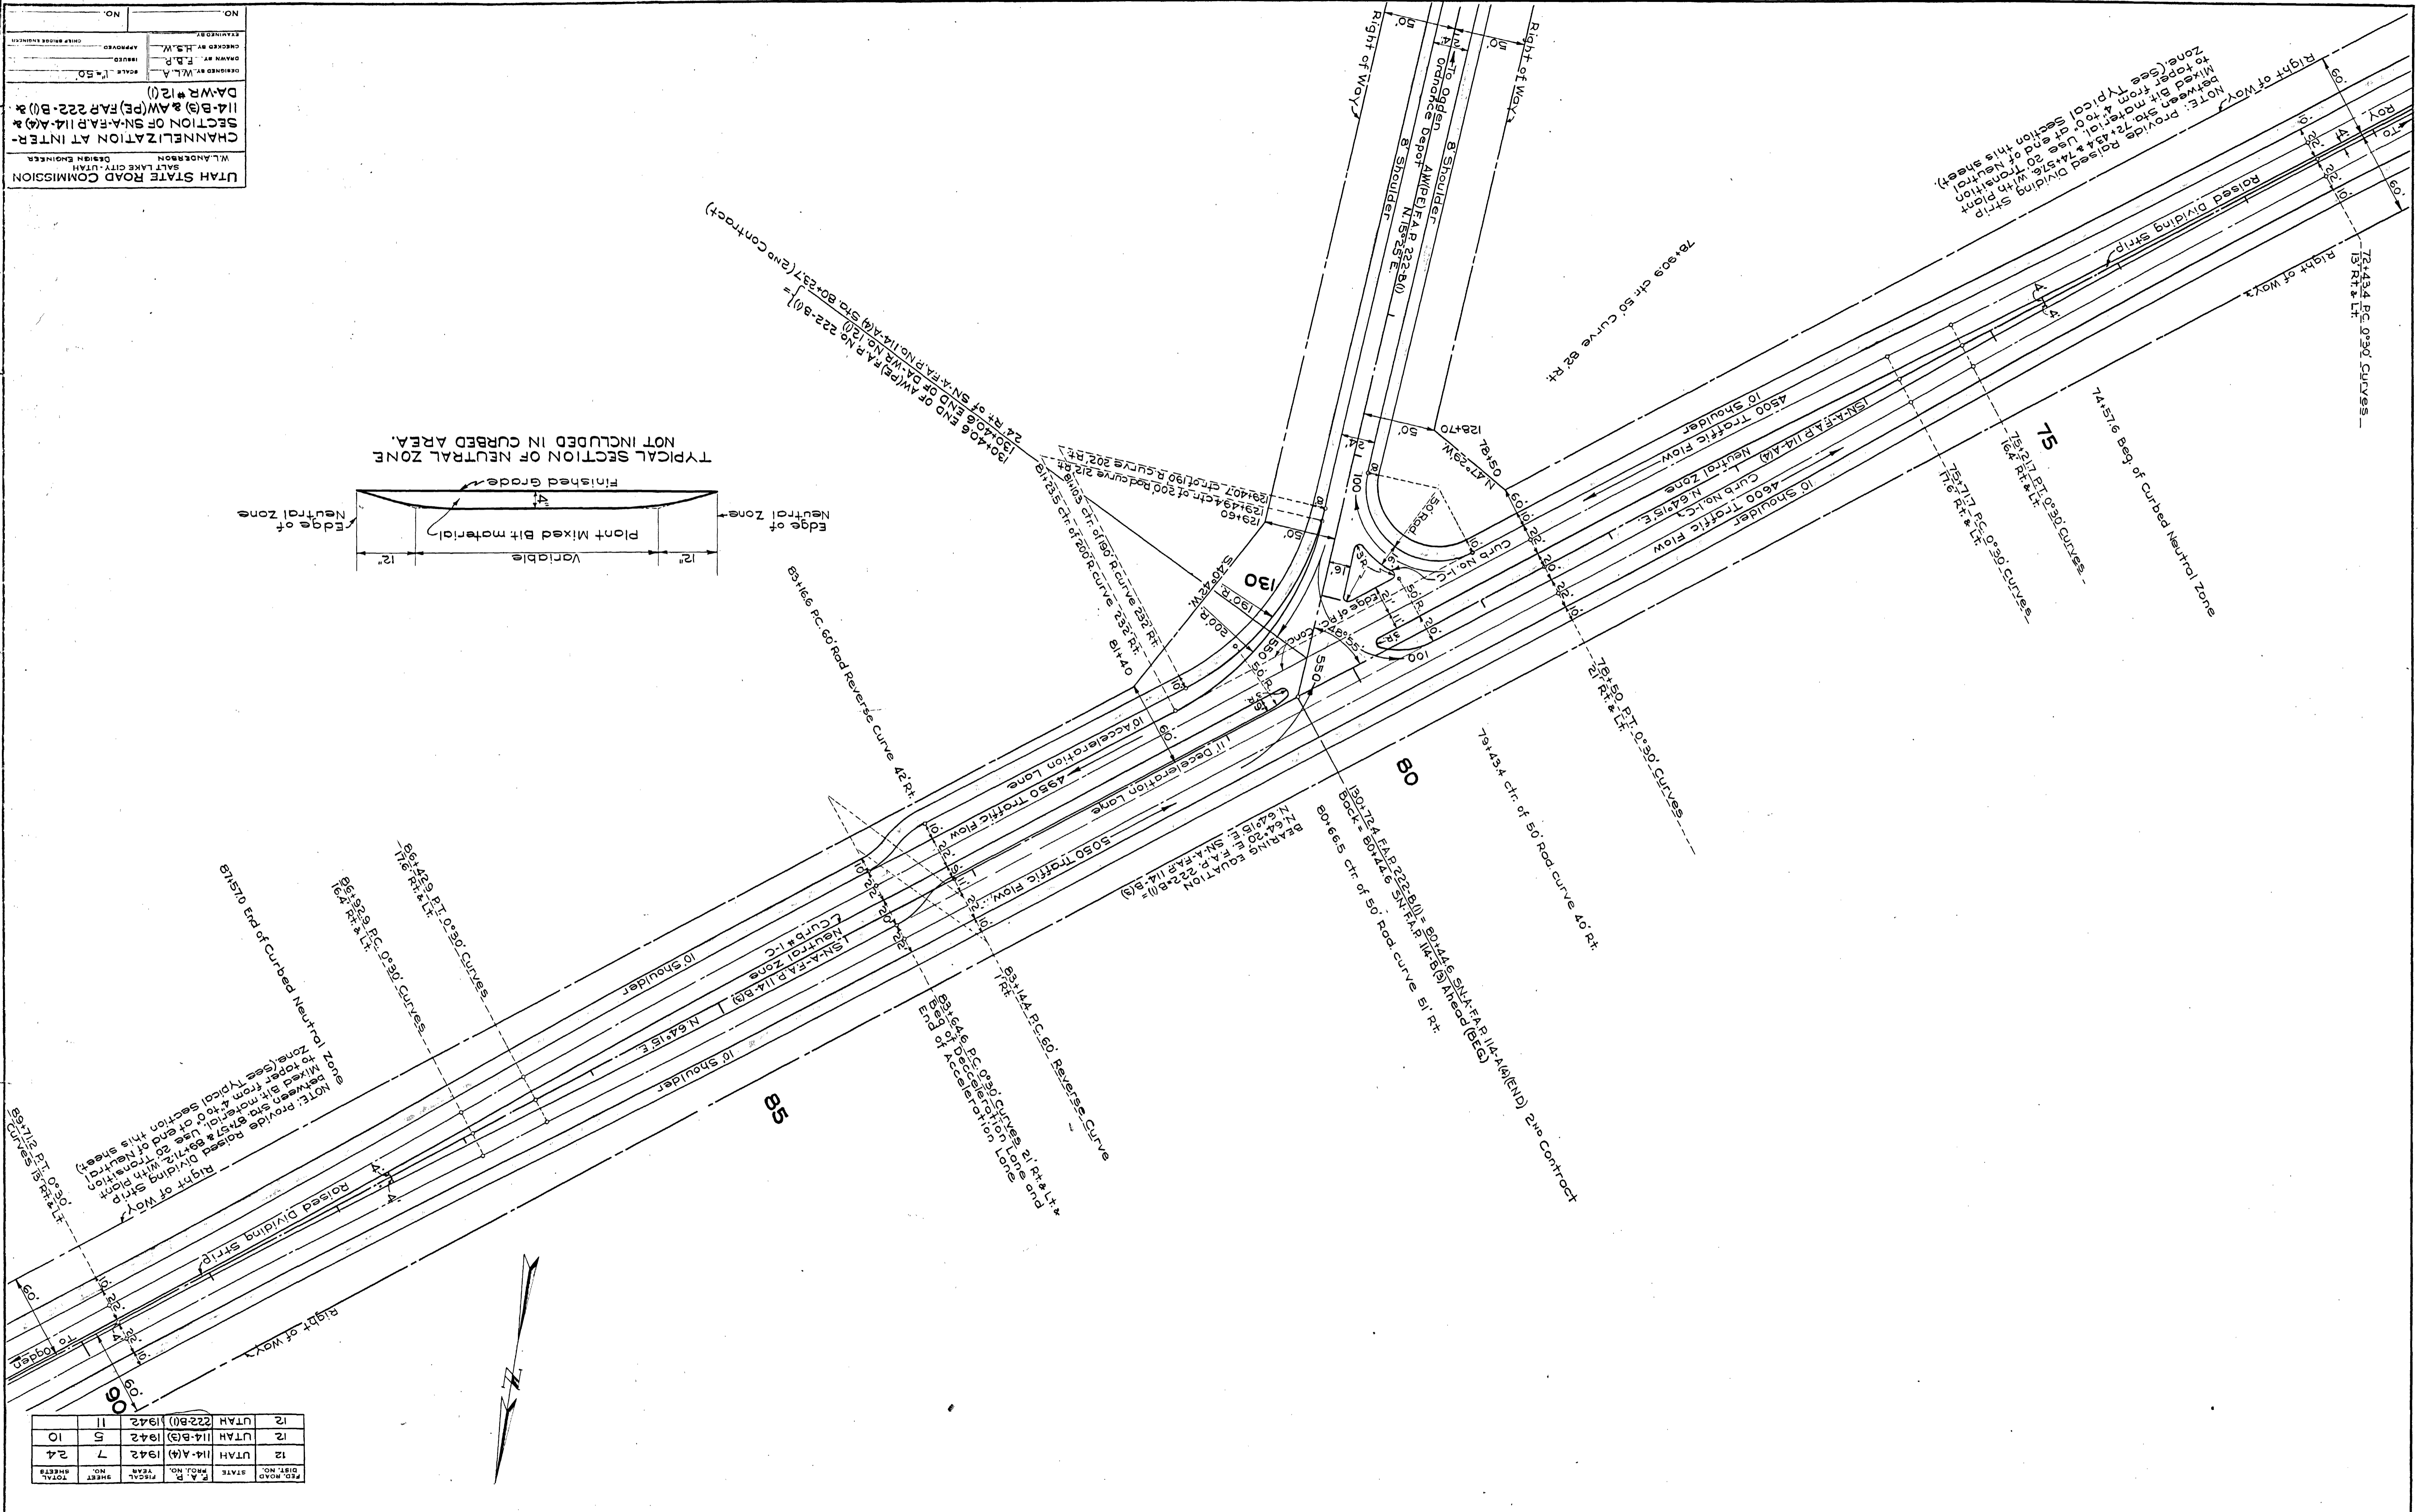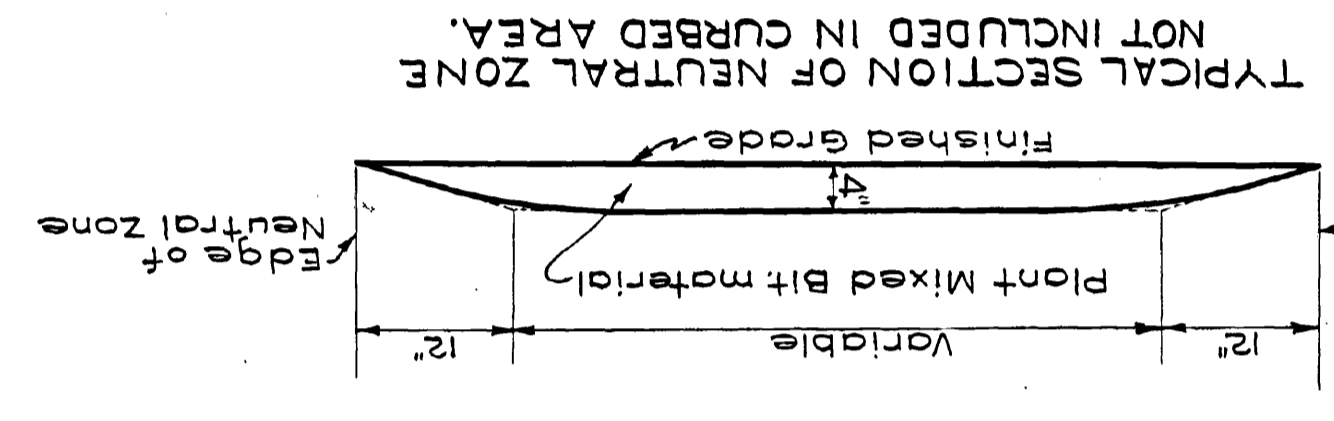

NOTE: Provide Raised Dividing Strip
 between stn. 72+43.4 & 74+57.6 with plant
 mixed bit material. Use 20' transition
 from 4' to 0' of end of Neutral
 Zone. (See Typical Section this sheet).

NOTE: Provide Raised Dividing Strip
 between stn. 87+12 & 89+71.2 with plant
 mixed bit material. Use 20' transition
 from 4' to 0' of end of Neutral
 Zone. (See Typical Section this sheet).

FED. ROAD DIST. NO.	STATE	FISCAL YEAR	SHEET NO.	TOTAL SHEETS
12	UTAH	1942	7	24
12	UTAH	1942	5	10
12	UTAH	1942	11	10

REVISIONS	
DATE	BY