


WEBER COUNTY SURVEYORS & ENGINEER 2568 WASHINGTON BLVD. OGDEN, UTAH		
CACHE COUNTY SURVEYORS & ENGINEER 179 NORTH MAIN STREET LOGAN, UTAH		
WEBER & CACHE COUNTIES BOUNDARY T. 7 & 8 N., R. 1 E. TO R. 4 E.		
JOB NO. MC-80-73 WEBER CO. 12/28/82	SURVEYED BY F.W.M., G.G., J.C., H.P., V.W., M.H. APPROVED BY <i>Fred W. Mclan</i>	FIELD BOOK MC-45, P. 34 MC-45A, P. 35 FILE NO. A-5-5
CACHE CO.	SURVEYED BY	FIELD BOOK
	APPROVED BY	FILE NO.
DATE	SCALE 1" = 400'	SHEETS 1 of 7

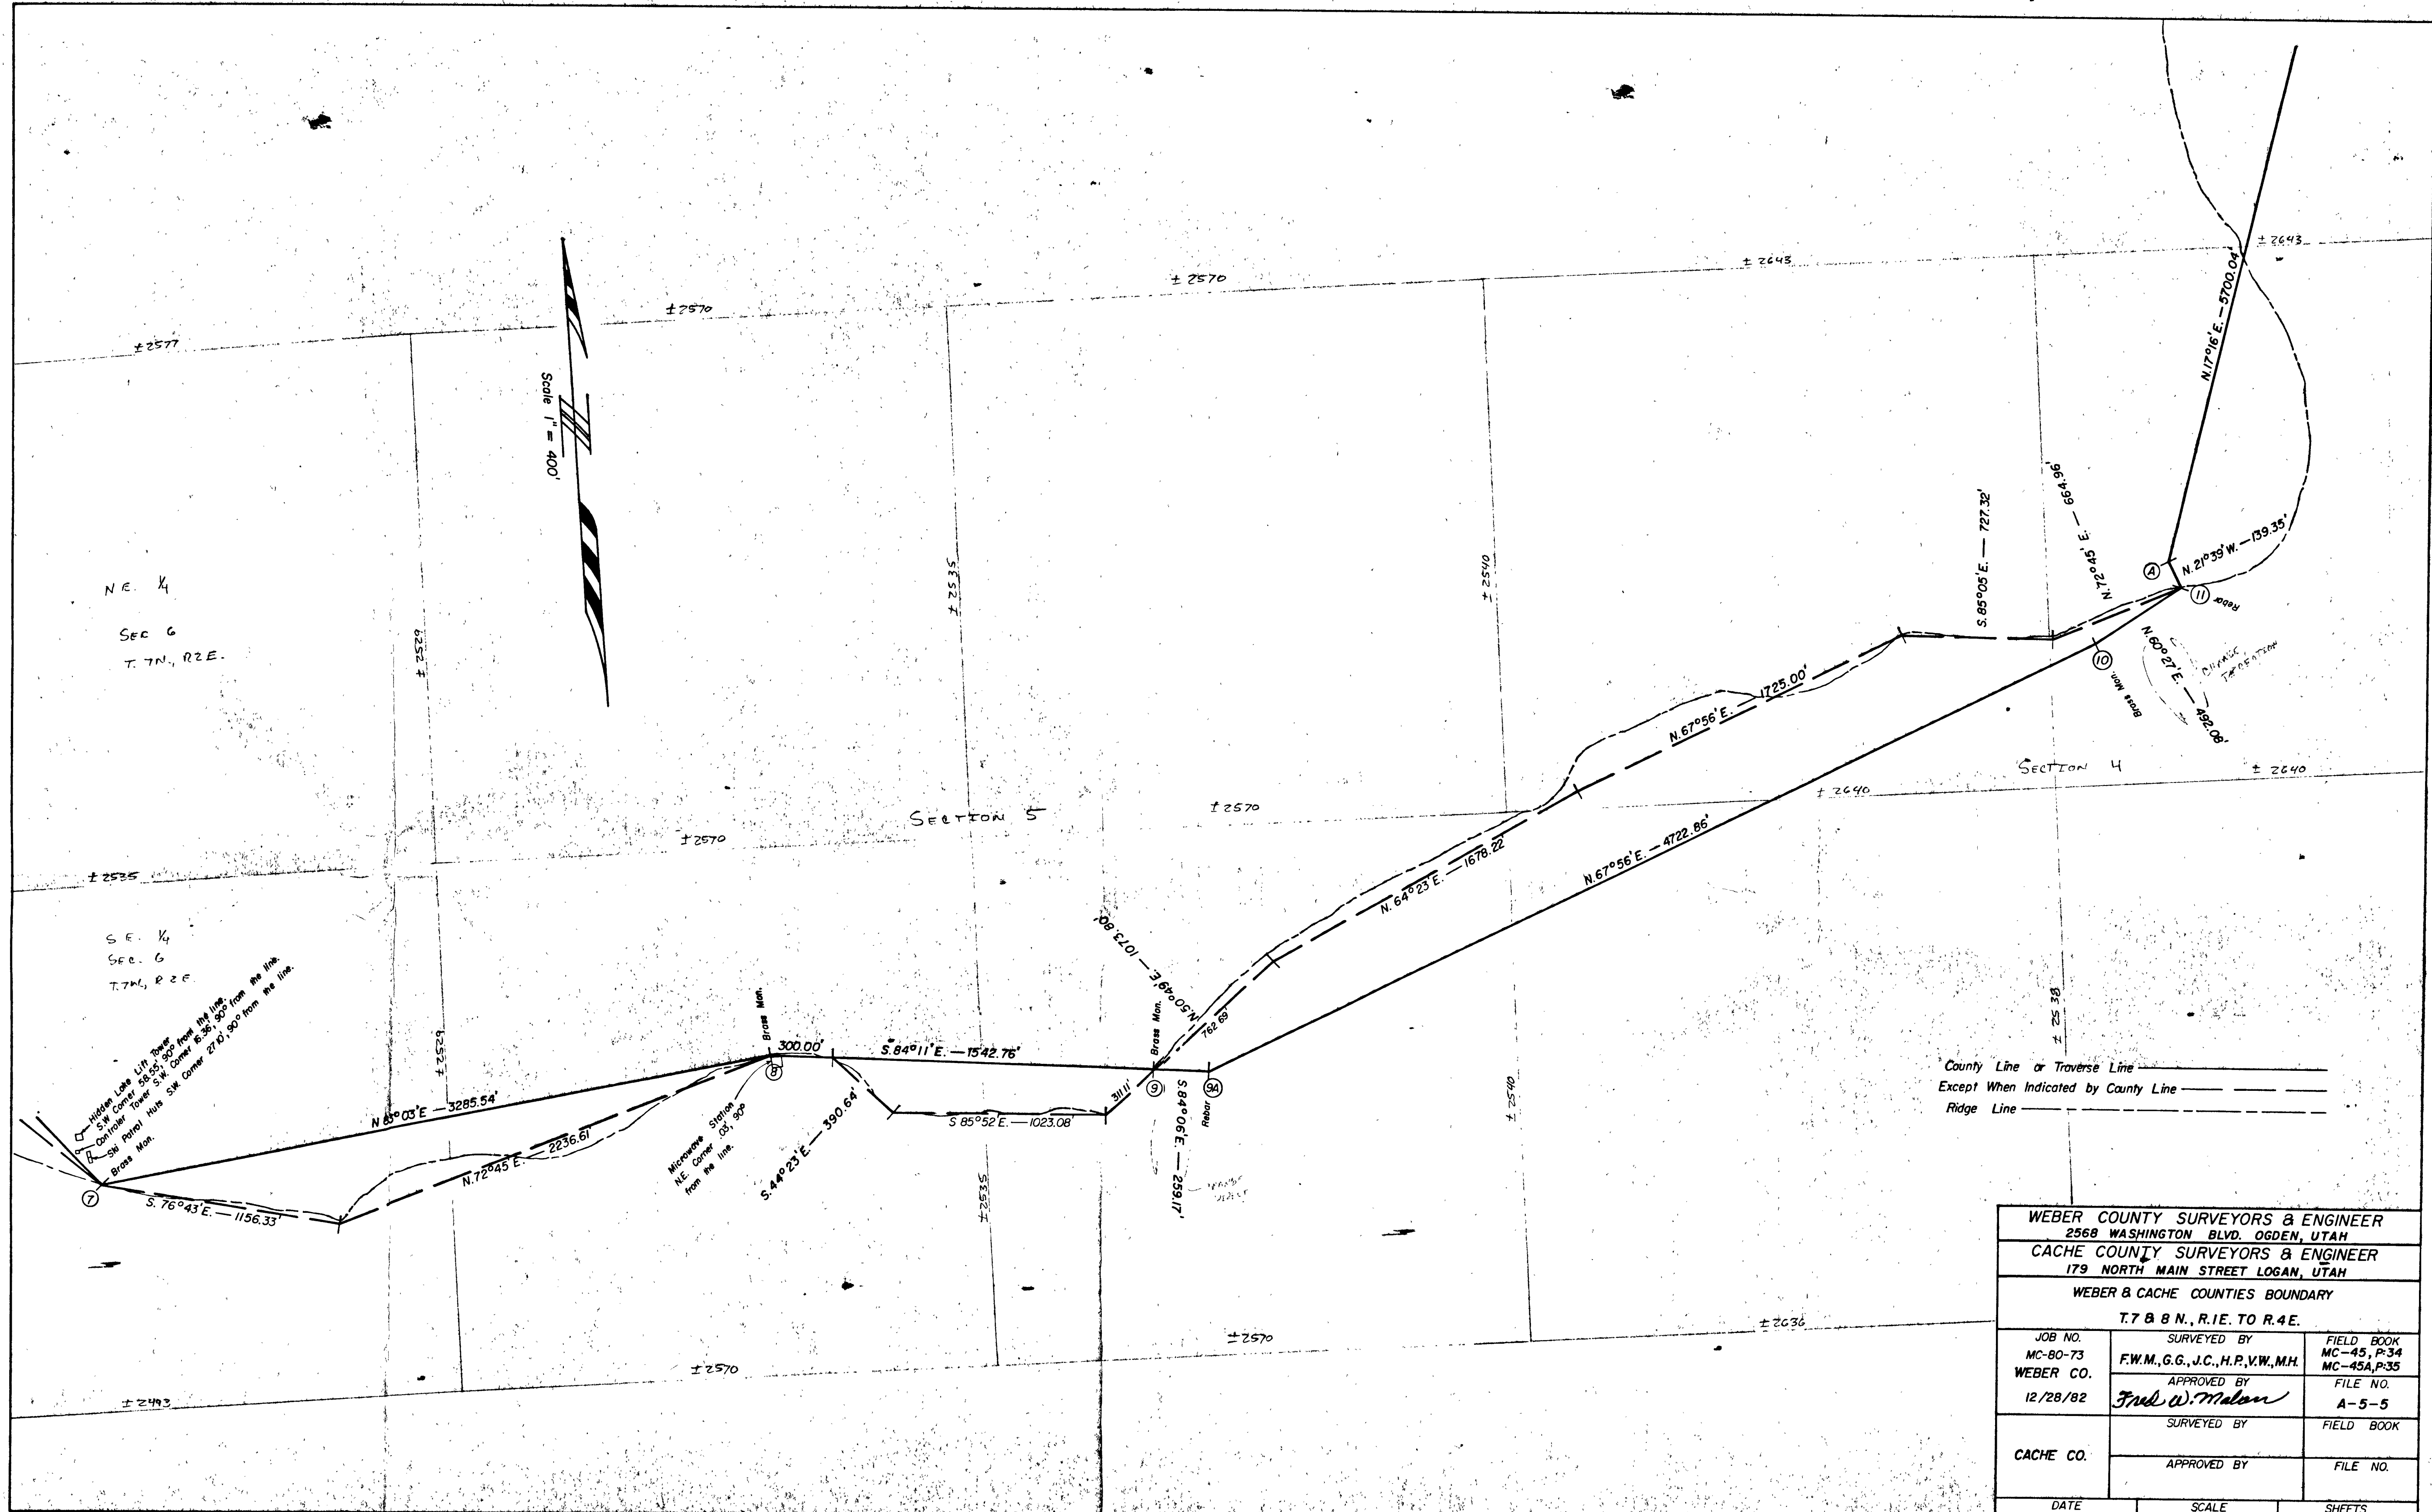

NE ¼  
SEC 6  
T. 7N., R. 2E.

SE ¼  
SEC 6  
T. 7N., R. 2E.




N. 21° 33' W - 139.35'  
N 17° 16' E - 5700.04'

County Line or Traverse Line ———  
Except When Indicated by County Line - - - -  
Ridge Line ·····


WEBER COUNTY SURVEYORS & ENGINEER 2568 WASHINGTON BLVD. OGDEN, UTAH		
CACHE COUNTY SURVEYORS & ENGINEER 179 NORTH MAIN STREET LOGAN, UTAH		
WEBER & CACHE COUNTIES BOUNDARY T. 7 & 8 N., R. 1E. TO R. 4E.		
JOB NO. MC-80-73 WEBER CO. 12/28/82	SURVEYED BY F.W.M., G.G., J.C., H.P., V.W., M.H. APPROVED BY <i>Fred W. Malan</i>	FIELD BOOK MC-45, P. 34 MC-45A, P. 35 FILE NO. A-5-5
CACHE CO.	SURVEYED BY	FIELD BOOK
	APPROVED BY	FILE NO.
DATE	SCALE 1" = 400'	SHEETS 2 of 7

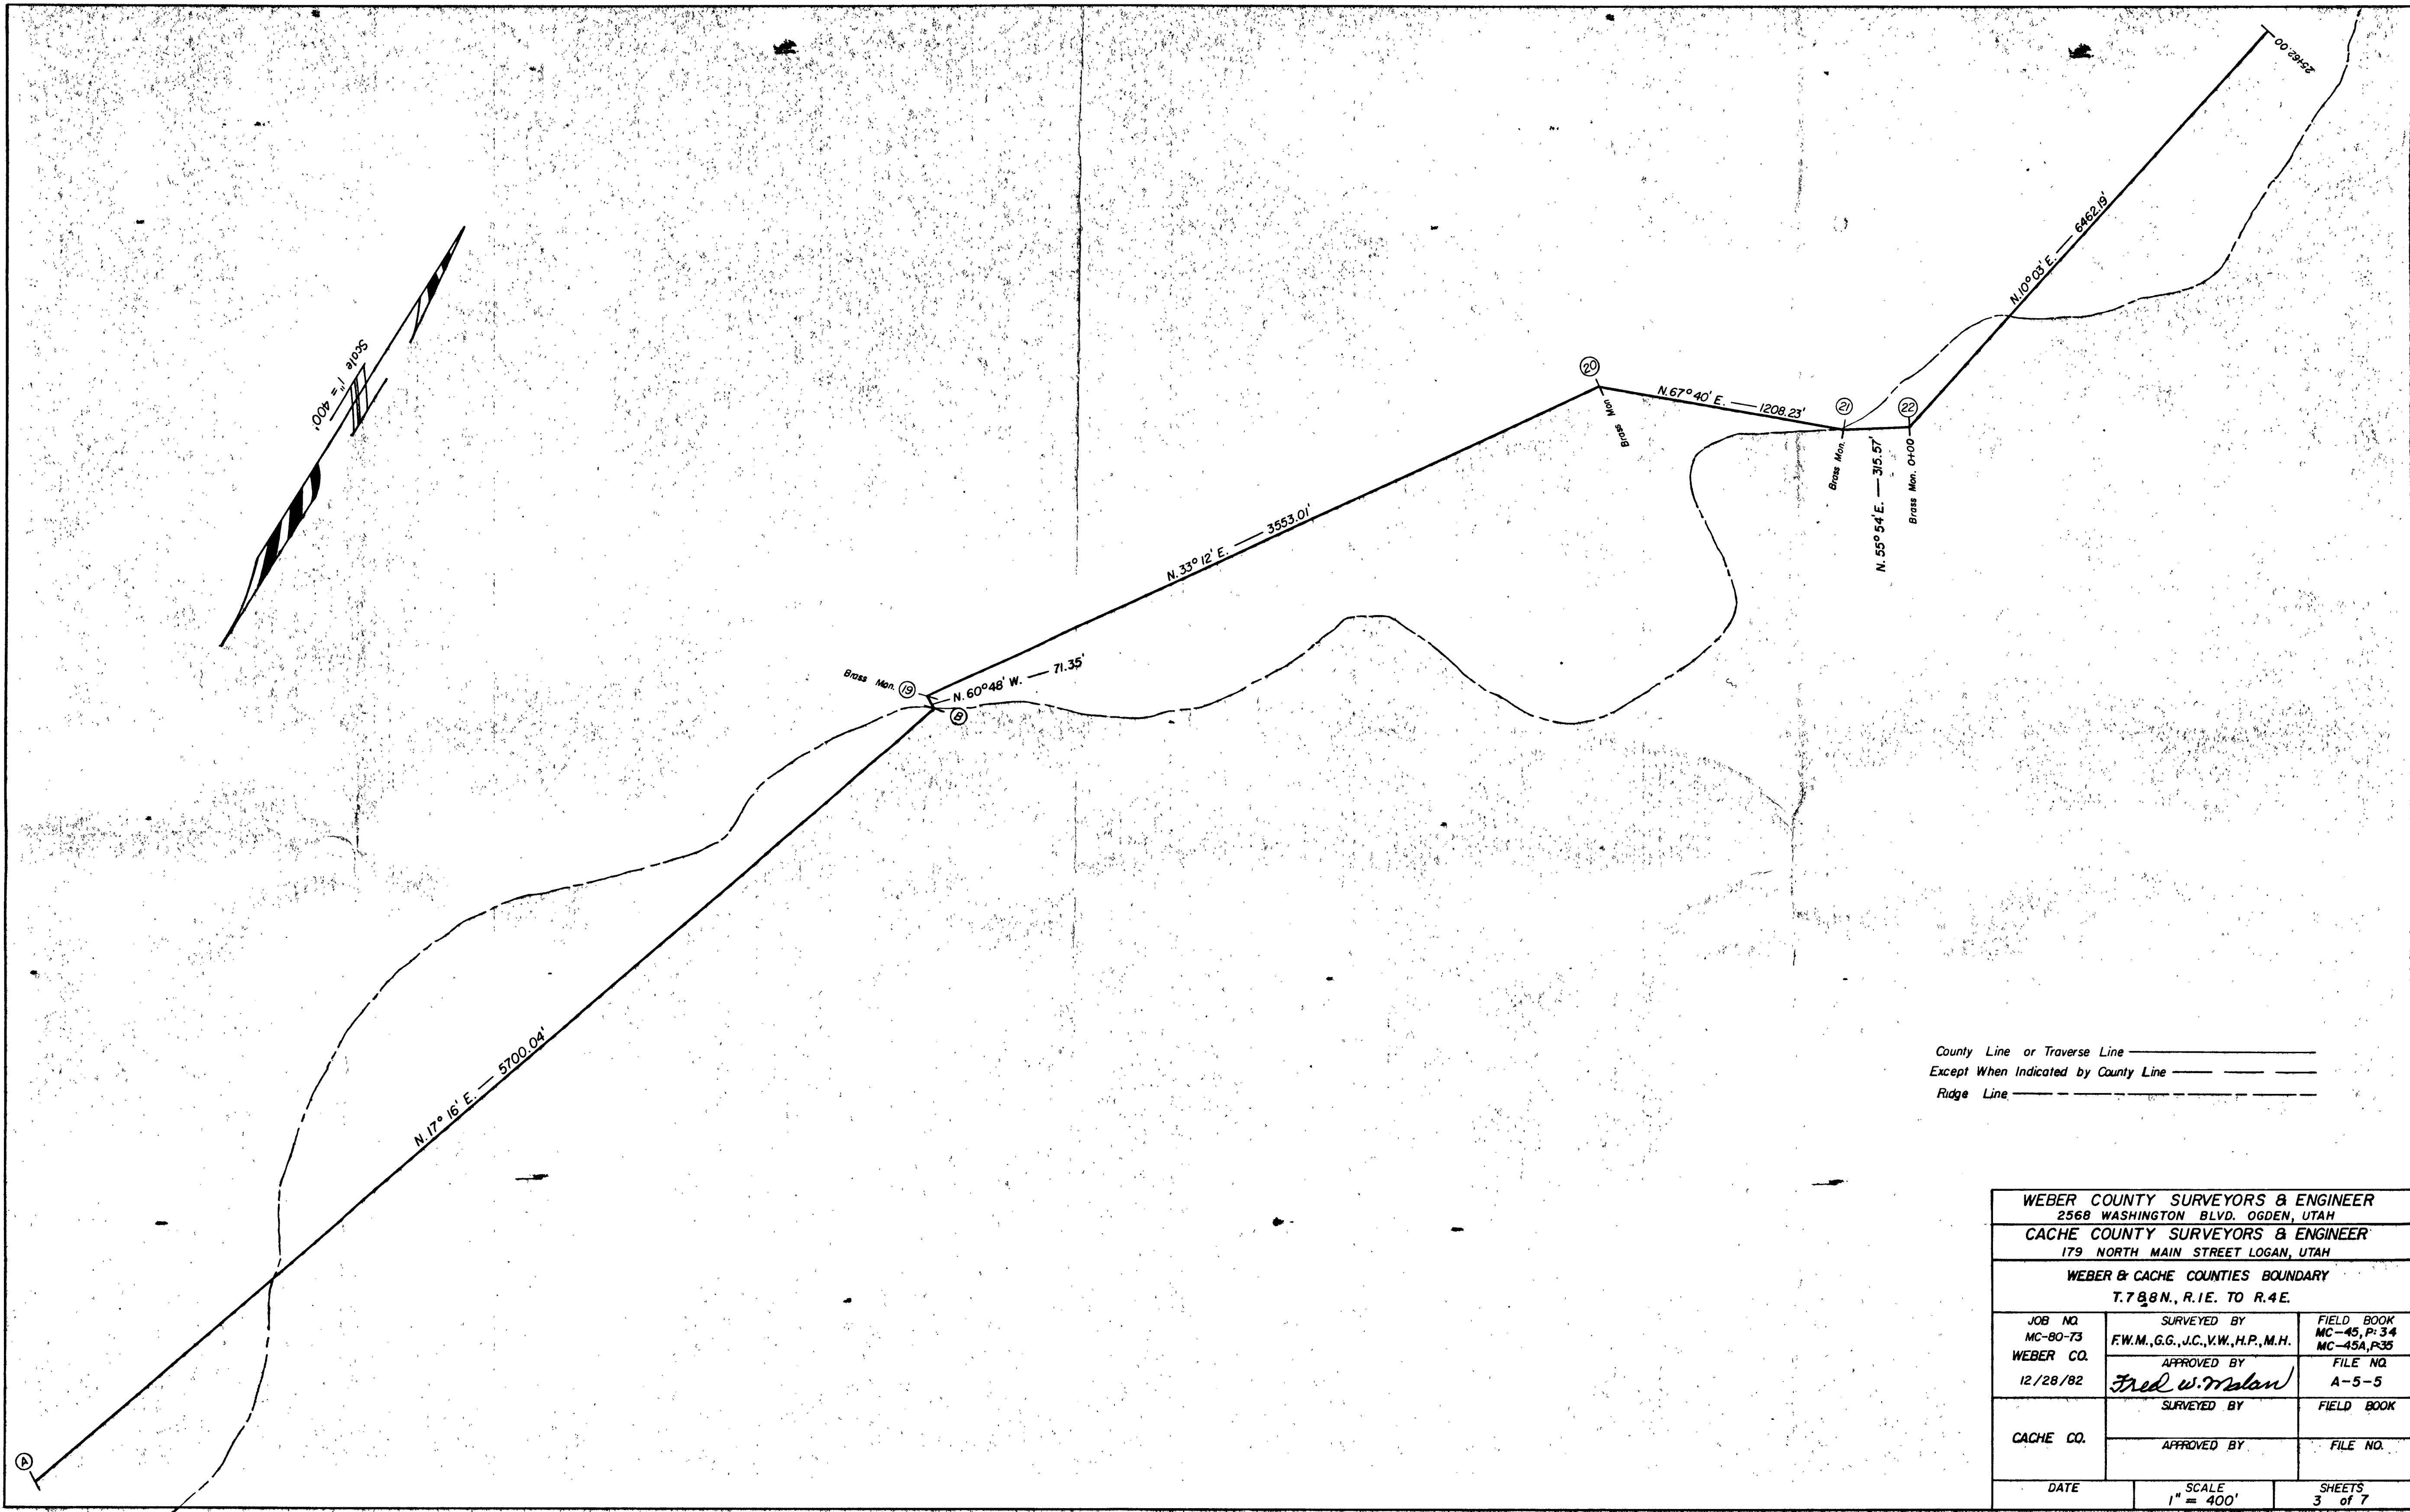


County Line or Traverse Line \_\_\_\_\_  
 Except When Indicated by County Line - - - - -  
 Ridge Line - - - - -

WEBER COUNTY SURVEYORS & ENGINEER 2568 WASHINGTON BLVD. OGDEN, UTAH		
CACHE COUNTY SURVEYORS & ENGINEER 179 NORTH MAIN STREET LOGAN, UTAH		
WEBER & CACHE COUNTIES BOUNDARY T.7&8N., R.1E. TO R.4E.		
JOB NO. MC-80-73 WEBER CO. 12/28/82	SURVEYED BY F.W.M., G.G., J.C., V.W., H.P., M.H. APPROVED BY <i>Fred W. Moran</i>	FIELD BOOK MC-45, P. 3-4 MC-45A, P. 35 FILE NO. A-5-5
CACHE CO.	SURVEYED BY	FIELD BOOK
	APPROVED BY	FILE NO.
DATE	SCALE 1" = 400'	SHEETS 3 of 7




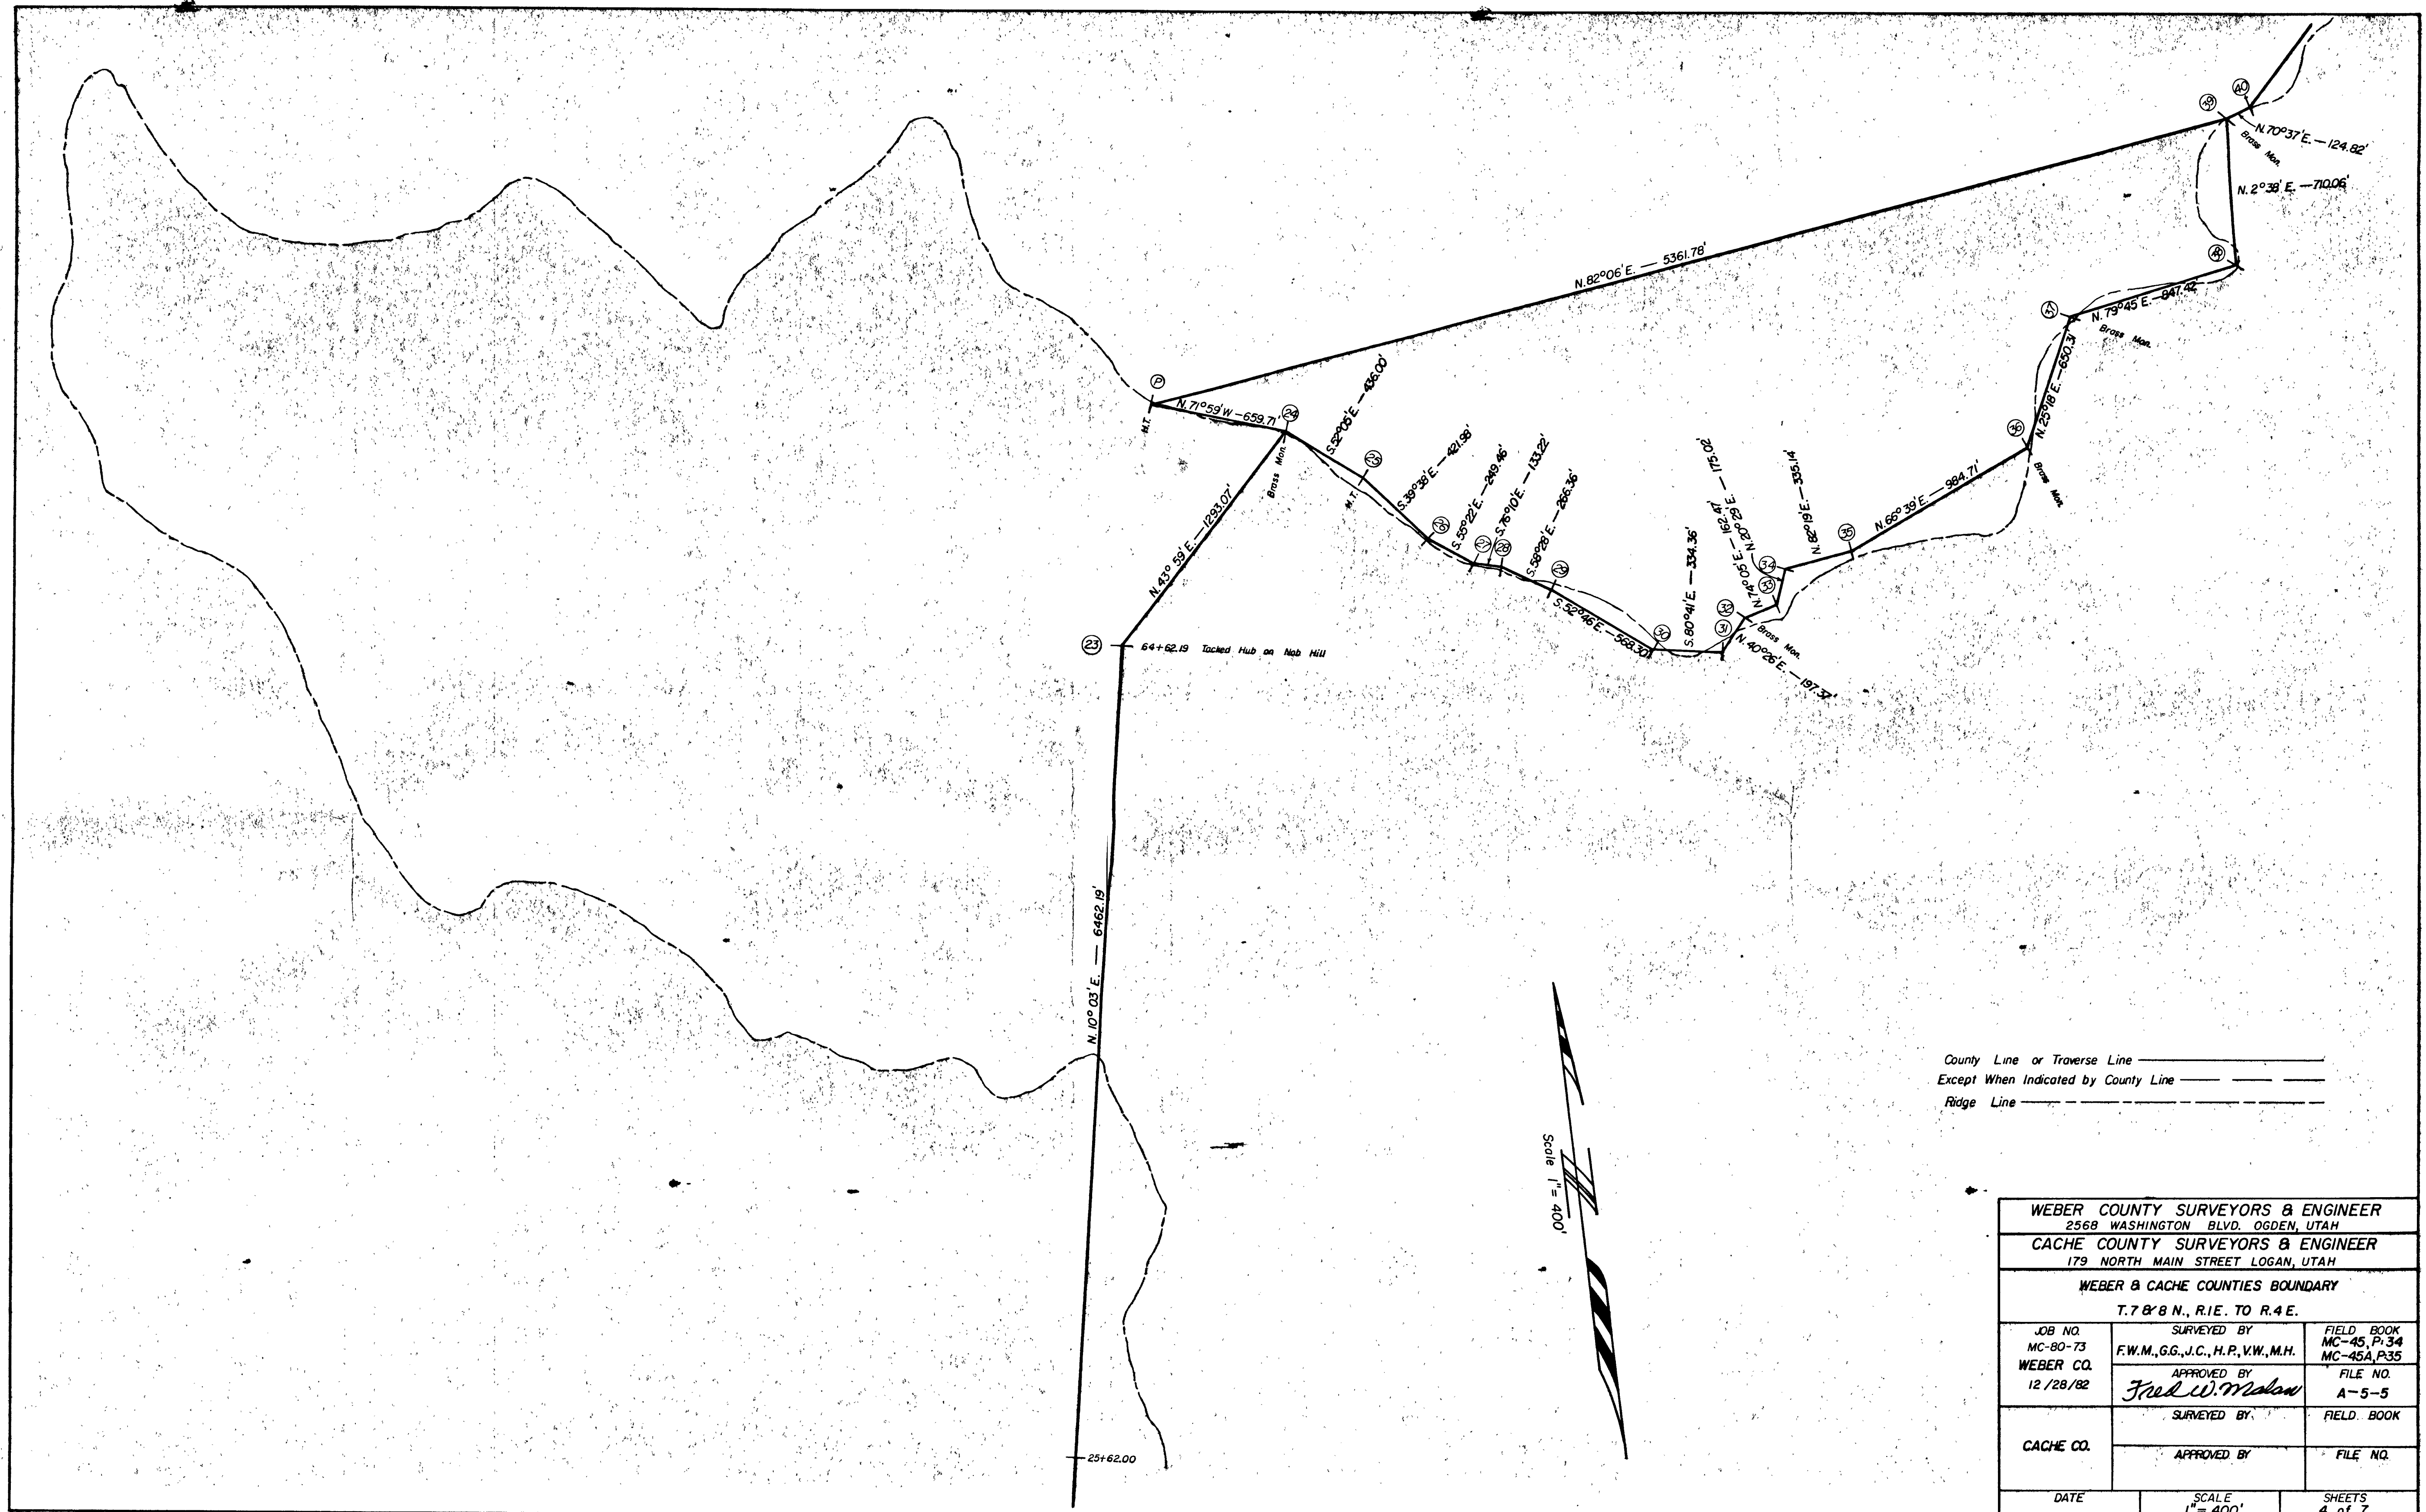

County Line or Traverse Line —————  
 Except When Indicated by County Line —————  
 Ridge Line - - - - -

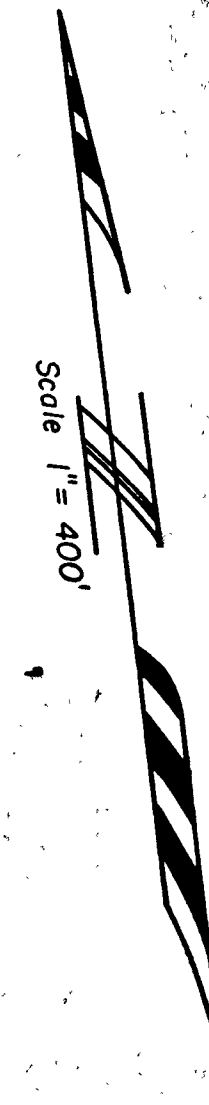


WEBER COUNTY SURVEYORS & ENGINEER 2568 WASHINGTON BLVD. OGDEN, UTAH		
CACHE COUNTY SURVEYORS & ENGINEER 179 NORTH MAIN STREET LOGAN, UTAH		
WEBER & CACHE COUNTIES BOUNDARY T. 7 & 8 N., R. 1 E. TO R. 4 E.		
JOB NO. MC-80-73 WEBER CO. 12/28/82	SURVEYED BY F.W.M., G.G., J.C., H.P., V.W., M.H. APPROVED BY <i>Fred W. Melan</i>	FIELD BOOK MC-45, P. 34 MC-45A, P. 35 FILE NO. A-5-5
CACHE CO.	SURVEYED BY	FIELD BOOK
	APPROVED BY	FILE NO.
DATE	SCALE 1" = 400'	SHEETS 4 of 7

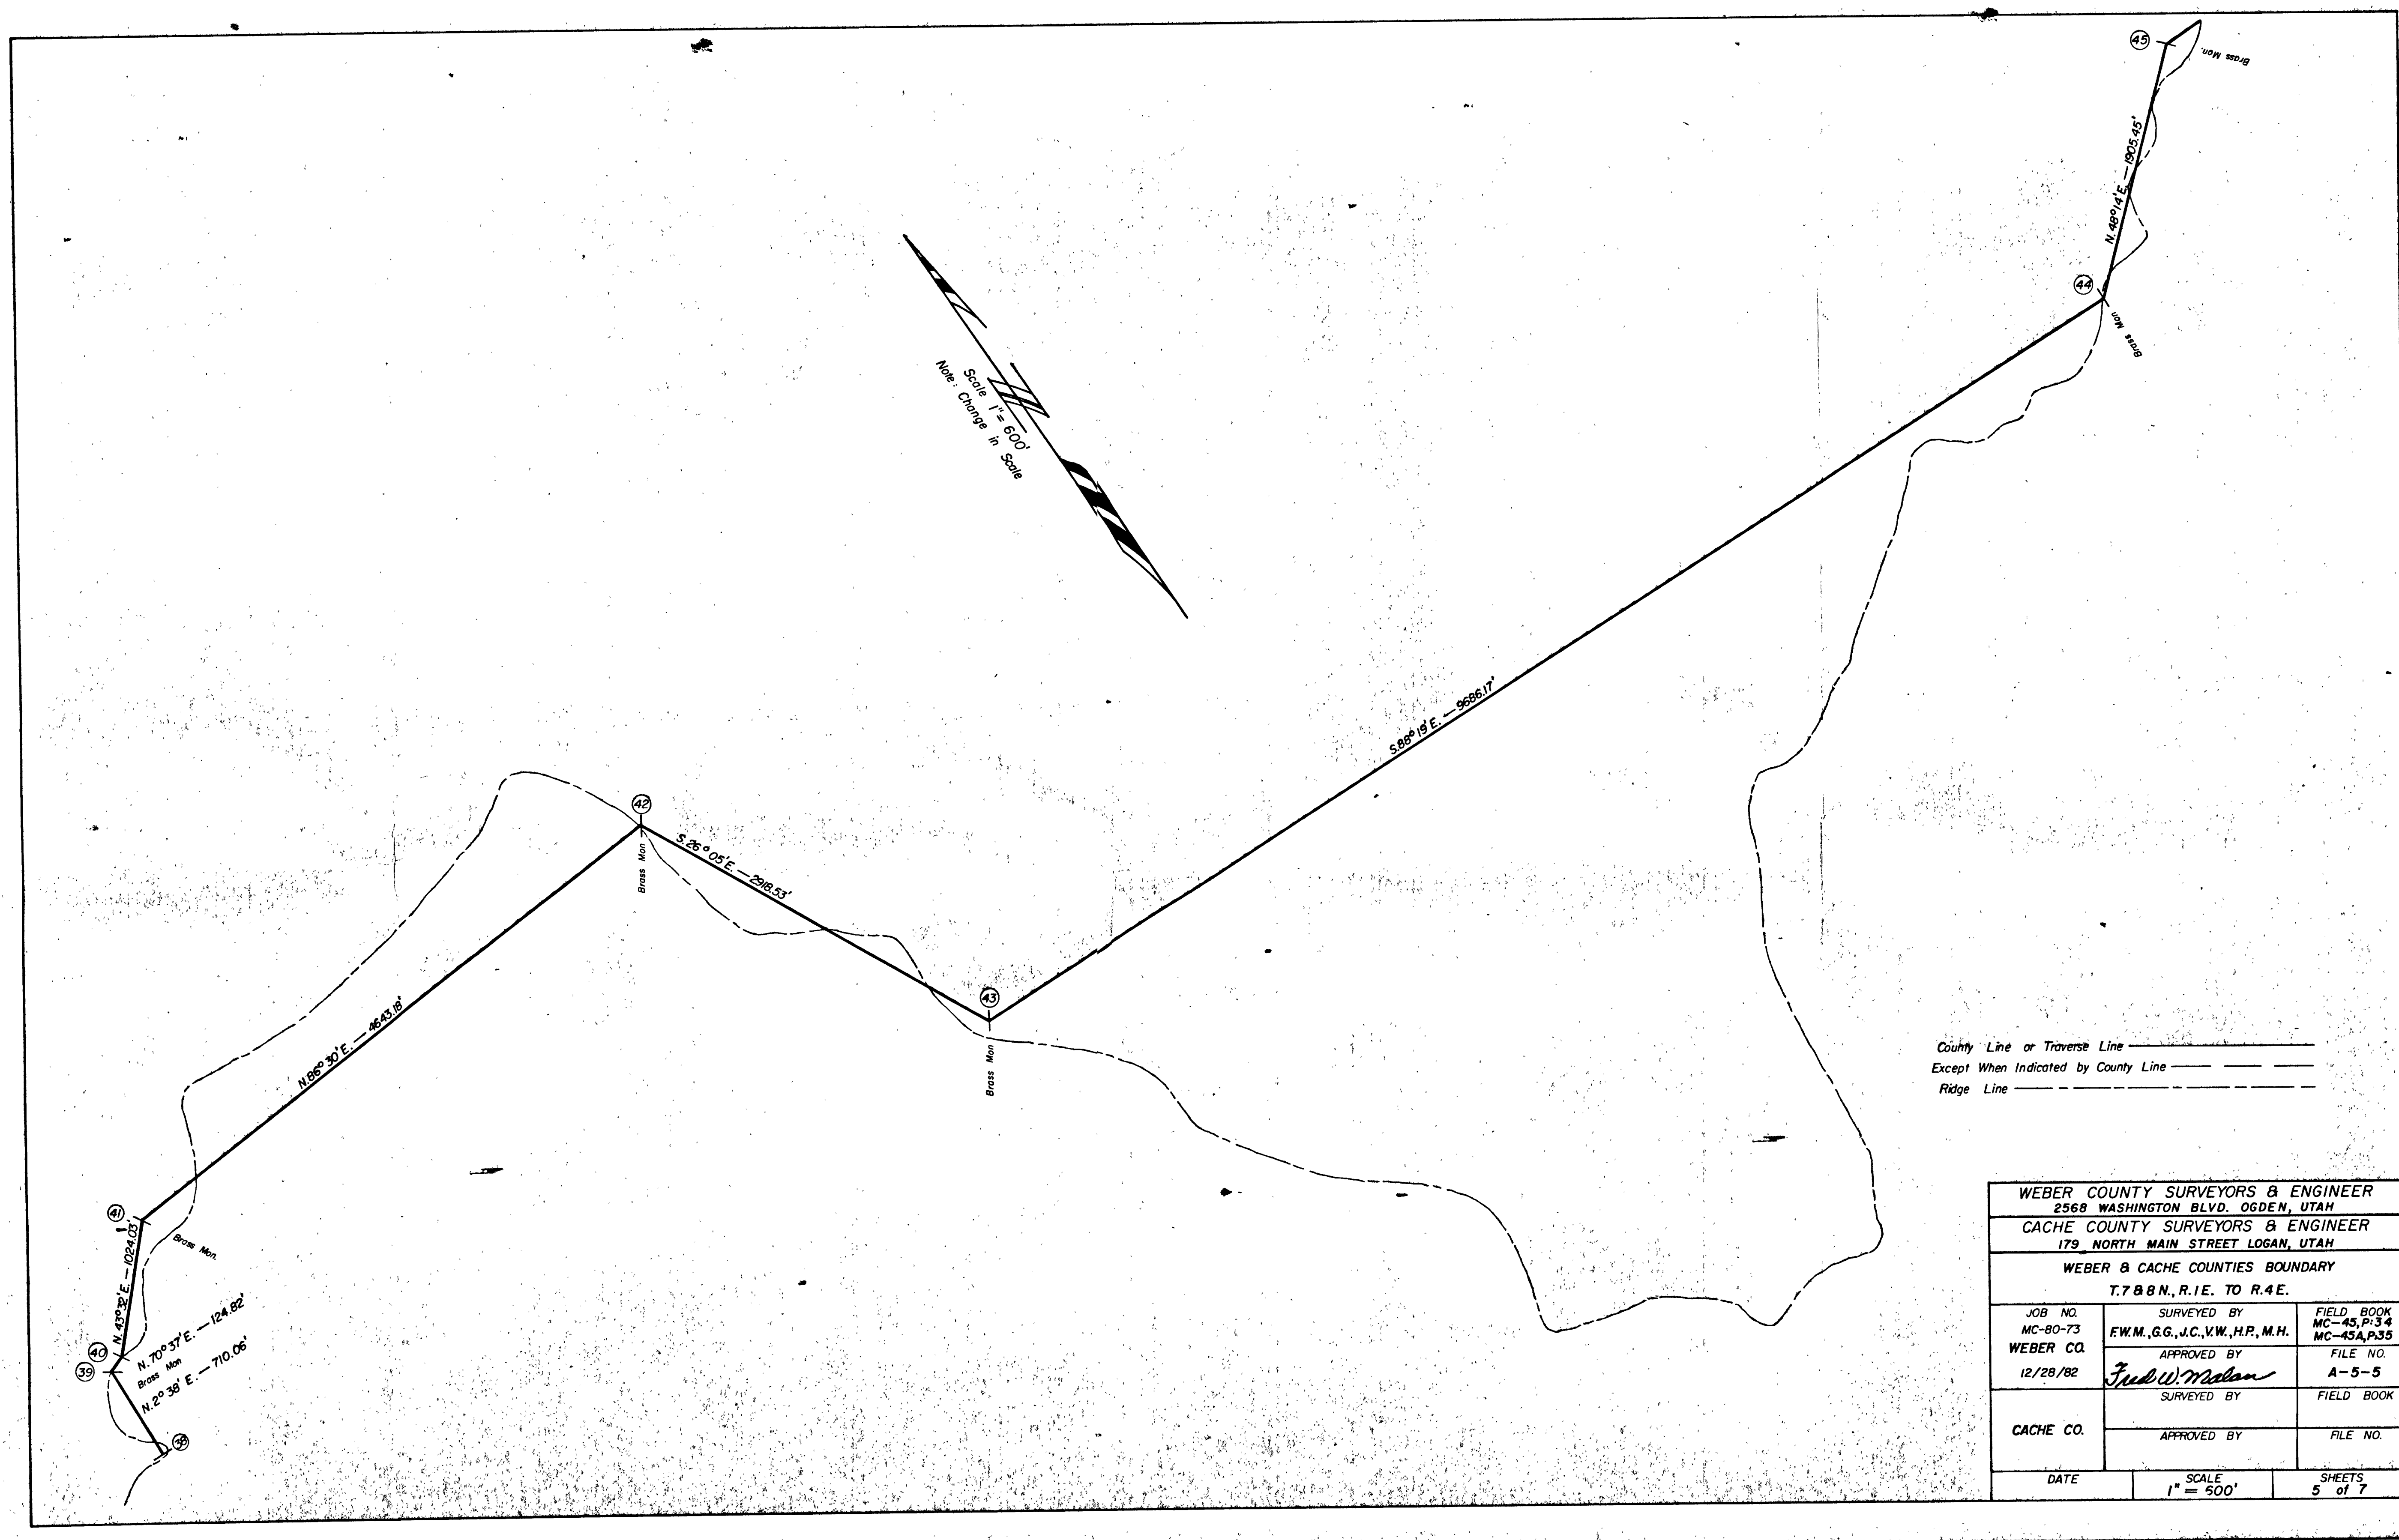

County Line or Traverse Line \_\_\_\_\_  
 Except When Indicated by County Line - - - - -  
 Ridge Line - - - - -


WEBER COUNTY SURVEYORS & ENGINEER 2568 WASHINGTON BLVD. OGDEN, UTAH		
CACHE COUNTY SURVEYORS & ENGINEER 179 NORTH MAIN STREET LOGAN, UTAH		
WEBER & CACHE COUNTIES BOUNDARY T.788N., R.1E. TO R.4E.		
JOB NO. MC-80-73 WEBER CO.	SURVEYED BY F.W.M., G.G., J.C., V.W., H.P., M.H. APPROVED BY <i>Fred W. Melan</i> 12/28/82	FIELD BOOK MC-45, P. 34 MC-45A, P. 35 FILE NO. A-5-5
CACHE CO.	APPROVED BY	FILE NO.
DATE	SCALE 1" = 500'	SHEETS 5 of 7

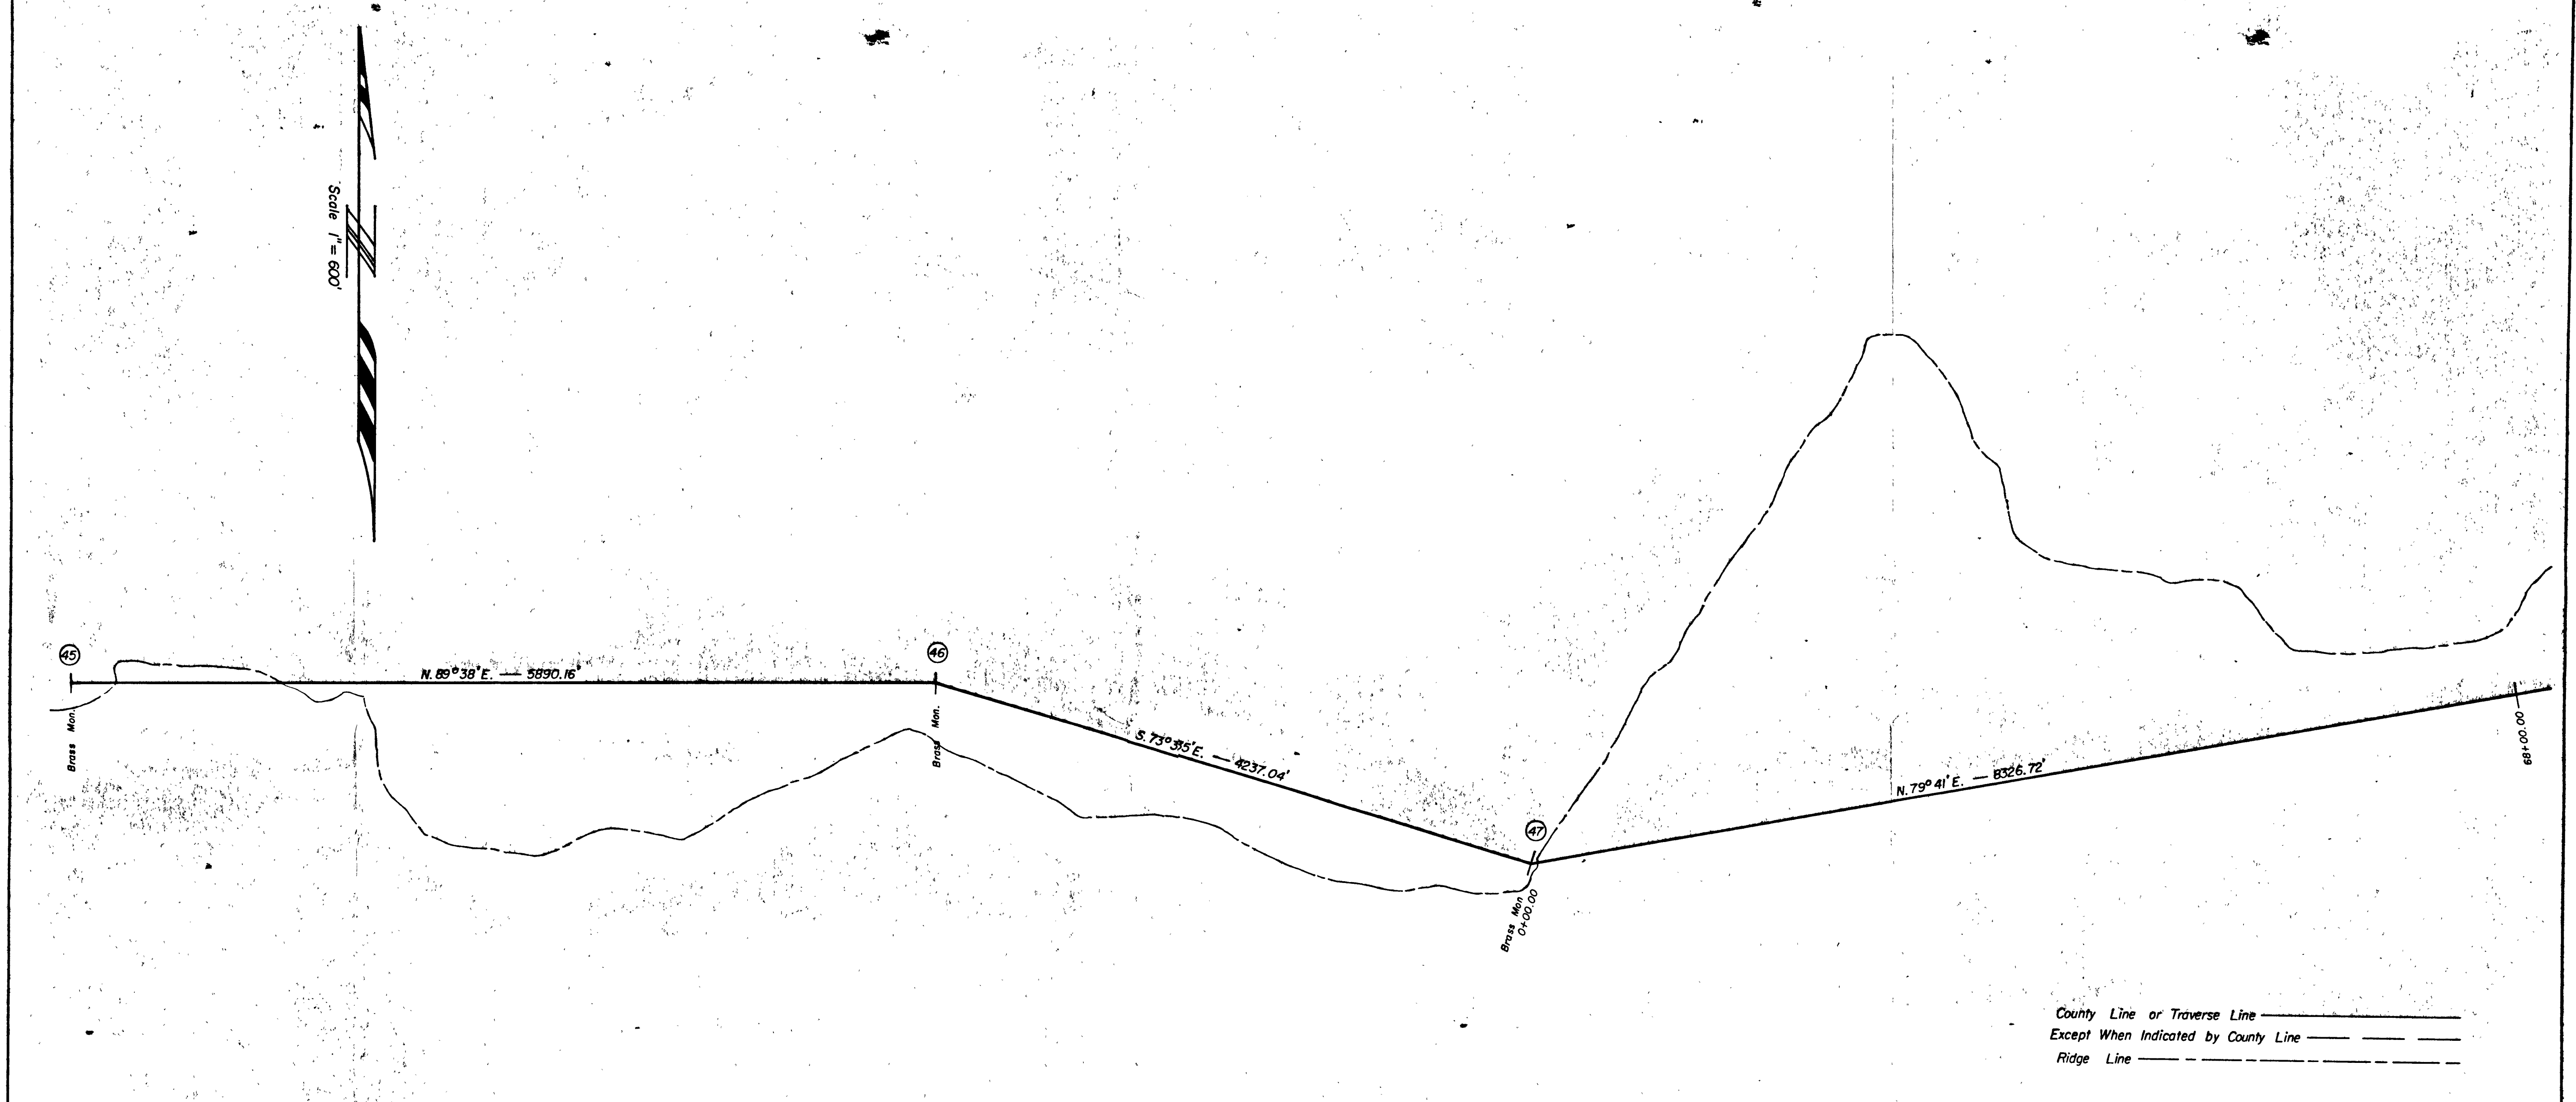

County Line or Traverse Line \_\_\_\_\_  
 Except When Indicated by County Line \_\_\_\_\_  
 Ridge Line \_\_\_\_\_

WEBER COUNTY SURVEYORS & ENGINEER 2568 WASHINGTON BLVD. OGDEN, UTAH		
CACHE COUNTY SURVEYORS & ENGINEER 179 NORTH MAIN STREET LOGAN, UTAH		
WEBER & CACHE COUNTIES BOUNDARY T.7 & 8 N., R.1 E. TO R.4 E.		
JOB NO. MC-80-73 WEBER CO. 12/28/82	SURVEYED BY F.W.M., G.G., J.C., V.W., H.P., M.H. APPROVED BY <i>Fred W. Nelson</i>	FIELD BOOK MC-45, P. 34 MC-45A, P. 35 FILE NO. A-5-5
CACHE CO.	SURVEYED BY	FIELD BOOK
	APPROVED BY	FILE NO.
DATE	SCALE 1" = 600'	SHEETS 6 of 7



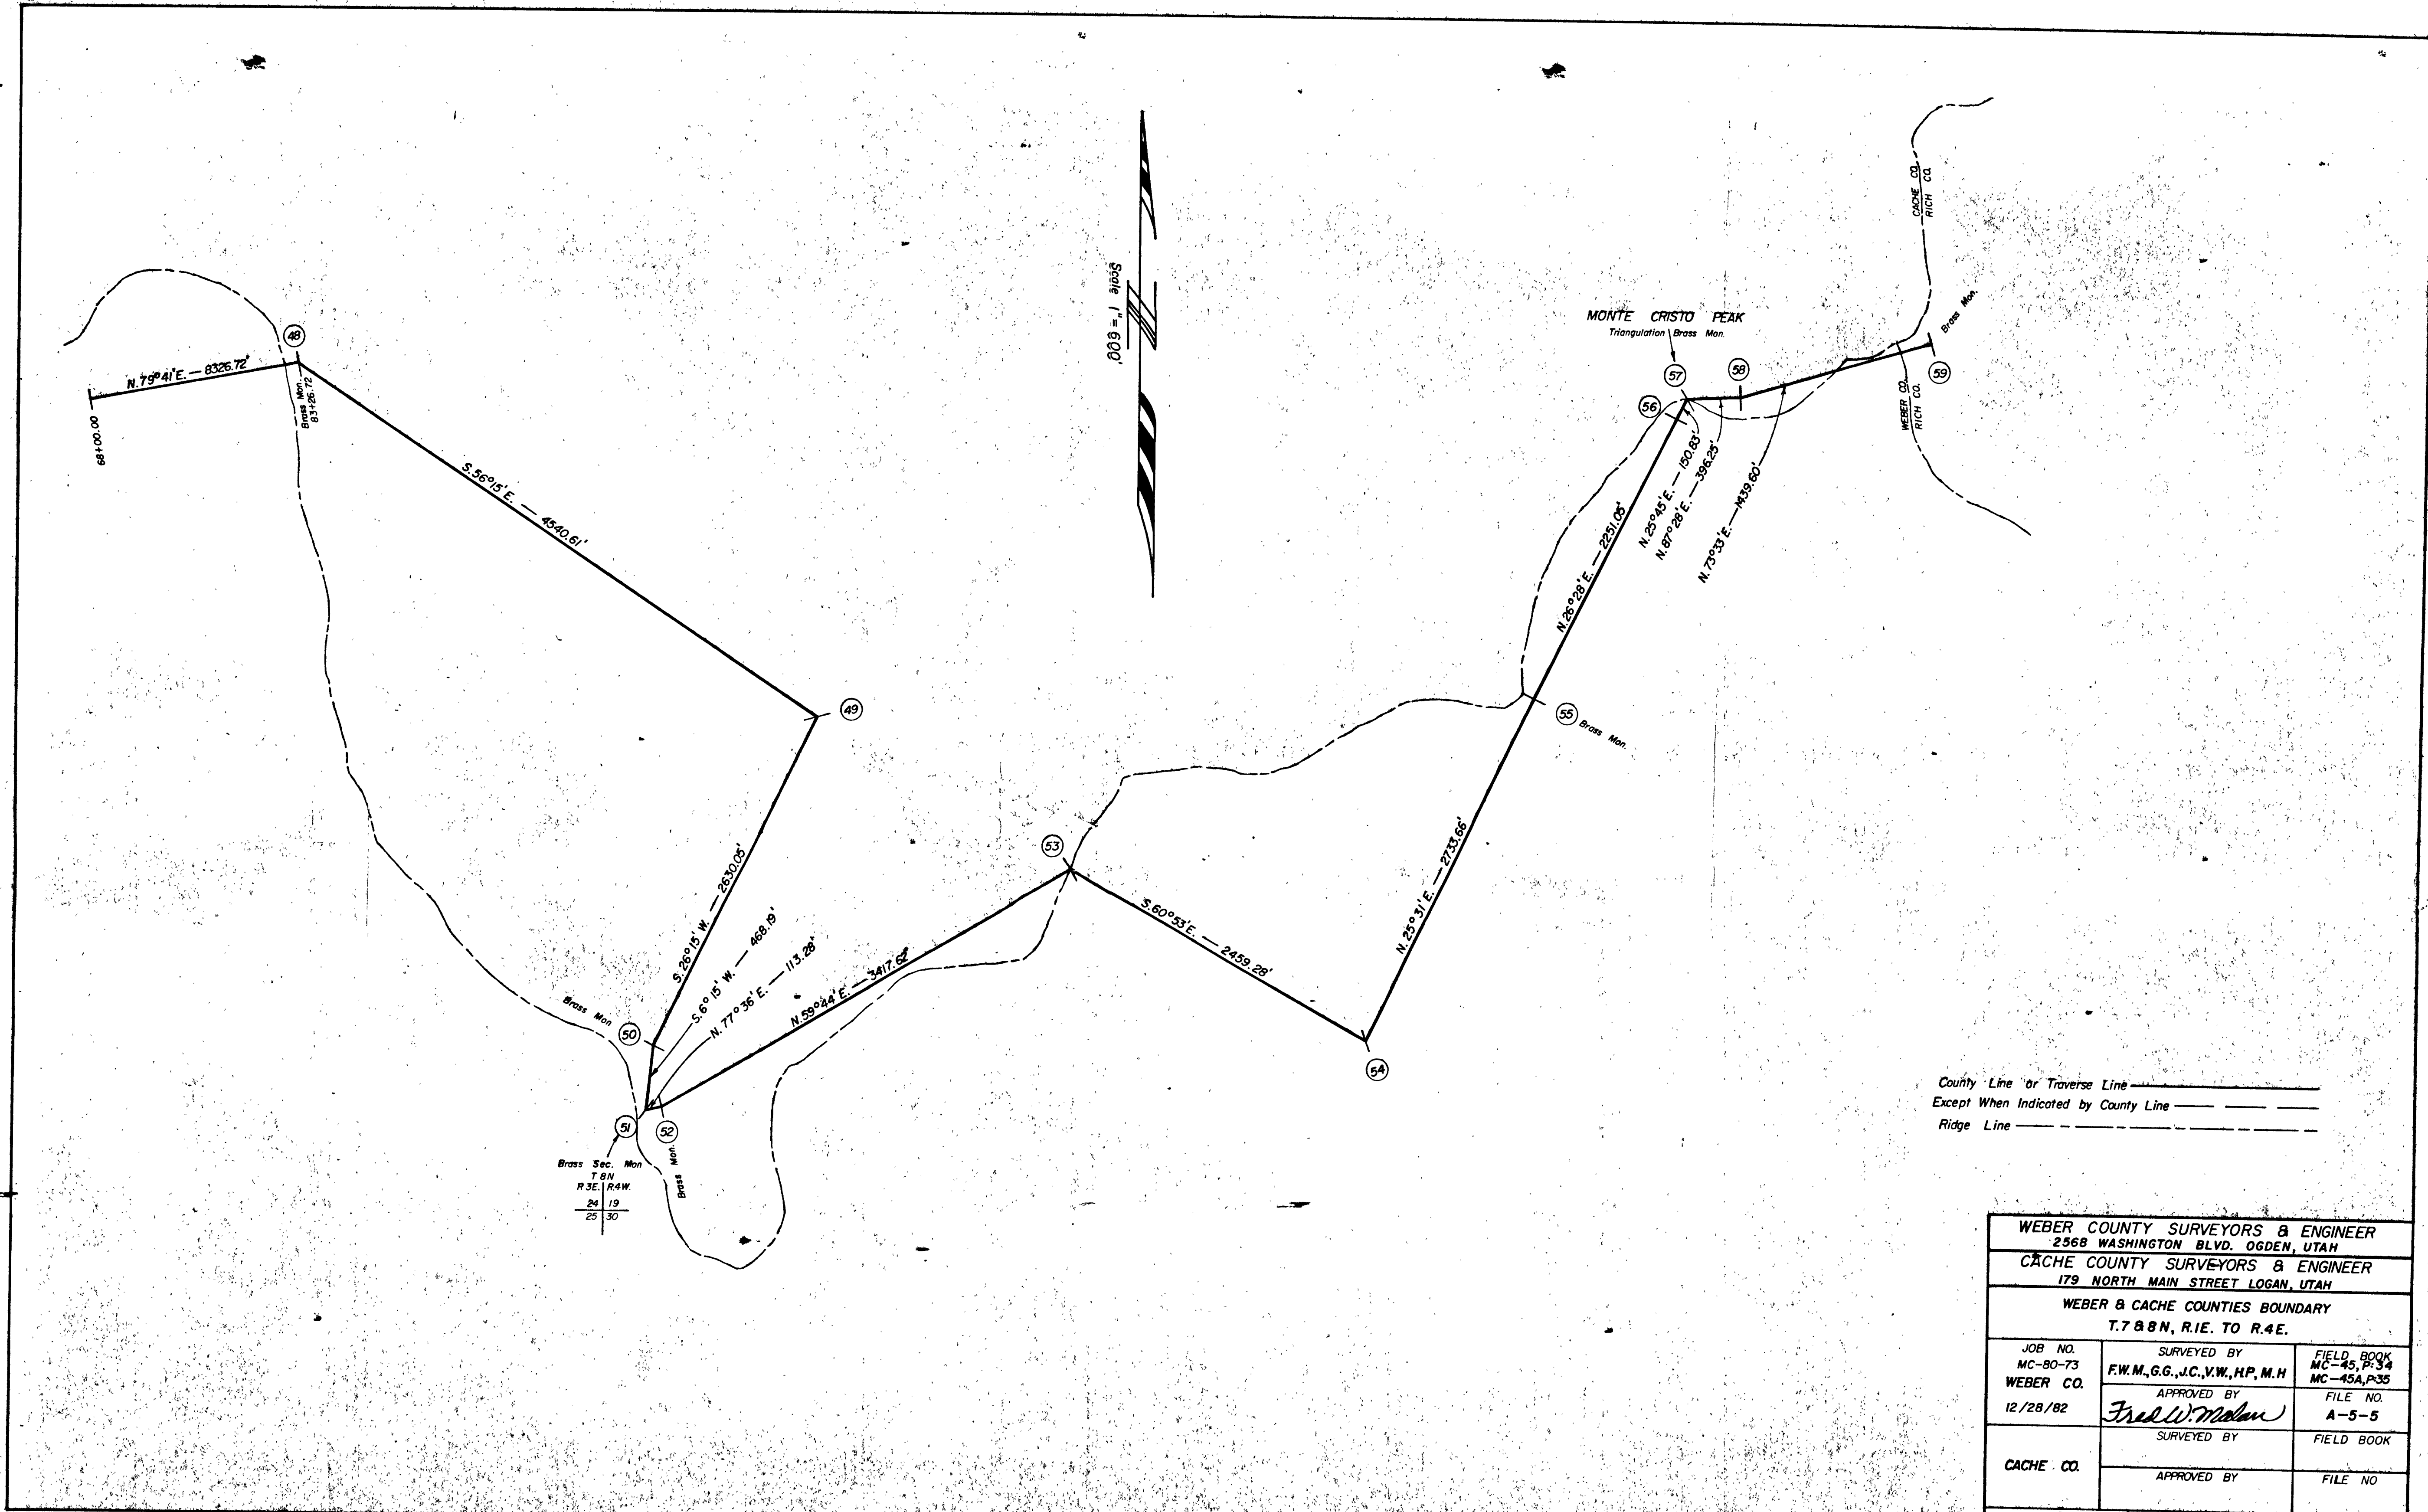

WEBER COUNTY SURVEYORS & ENGINEER 2568 WASHINGTON BLVD. OGDEN, UTAH		
CACHE COUNTY SURVEYORS & ENGINEER 179 NORTH MAIN STREET LOGAN, UTAH		
WEBER & CACHE COUNTIES BOUNDARY T. 7 & 8 N., R. 1 E. TO R. 4 E.		
JOB NO. MC-80-73 WEBER CO. 12/28/82	SURVEYED BY F.W.M., G.G., J.C., V.W., H.P., M.H. APPROVED BY <i>Fred W. Nelson</i>	FIELD BOOK MC-45, P. 34 MC-45A, P. 35 FILE NO. A-5-5
CACHE CO.	SURVEYED BY	FIELD BOOK
	APPROVED BY	FILE NO.
DATE	SCALE 1" = 600'	SHEETS 7 of 7