

143.5

39

T @ 16 F B.S. 16 E @ 0°00'00"

* RT To Brass cap 16/15


= 70°24'32"

Dist = 143.50

			43
		43	43
222	30	45.5	33
	74	43	33.5
	62	45	33.5
			028

Tie to Hub G

N →

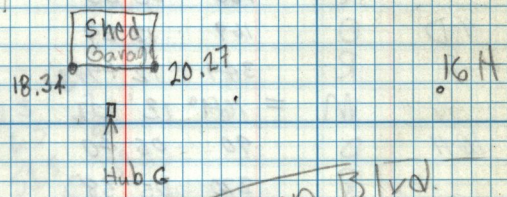

	43
42.5	43
43.75	33
33.5	
9.75	