
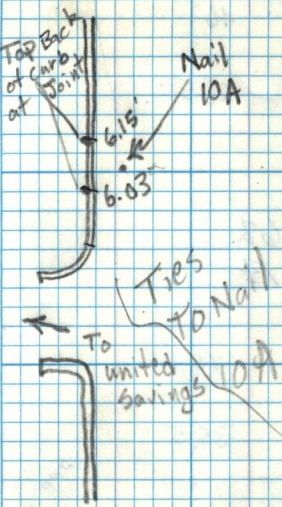


10 A

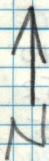

10 51 065  
 169 12 20.8"  


---

 1800327  
 725157  


---

 2525520  
 1070430  


---

 3595958

SAVINGS