


2
95.0
195
A 7-S

10b

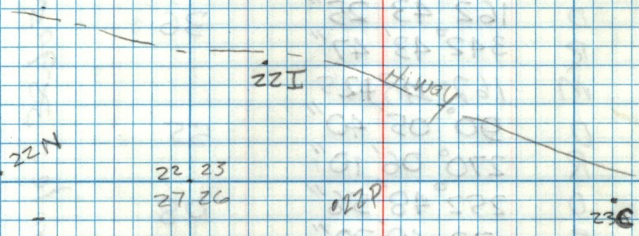

10b.

42.75	13
23.25	23
40.75	41
12.75	13
<u>12.75</u>	
9.5	