

↑  
N

1

w.c

21N

20C

20/21  
20/28


210

21P

27028

• 21Q

26  
28

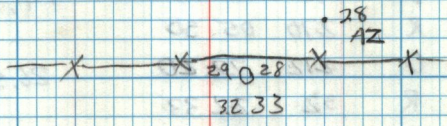

26  
•  
33

MAP B