


6-27-83

T. 5 N. R. 1 W.

(8)

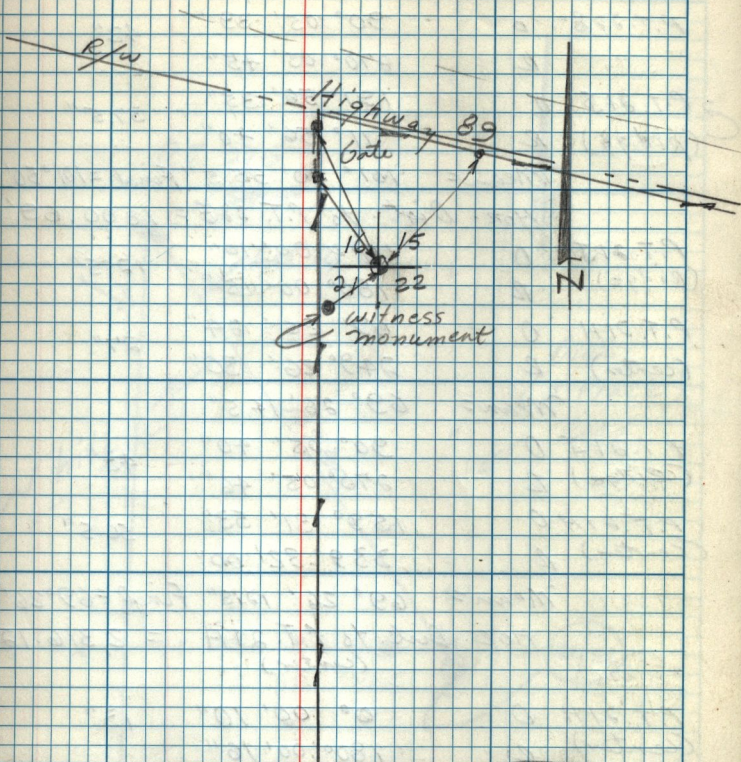

Cont. From pg 7 Ties for 16
72-86 21

T @ 16/15
21/22

C

D 0° 00' 10" S

R 179° 59' 46"

22A

D 139° 38' 35" S

R 319° 37' 56"

M

(From
Tran.
Notes)