

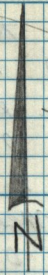


T. 5 N. 7-08-83 (21)
R. 1 W.


Highway 89

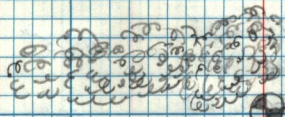

Hill

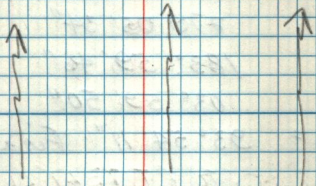

22	23
27	26

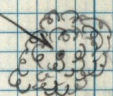

Dirt Road

V.P. R.R.

