


3-9-84

B.S. 6H (Horse)

①  $238^{\circ} 43' 53''$   
96.36'

②  $252^{\circ} 05' 38''$   
92.15'

③  $219^{\circ} 25' 51''$   
84.38'

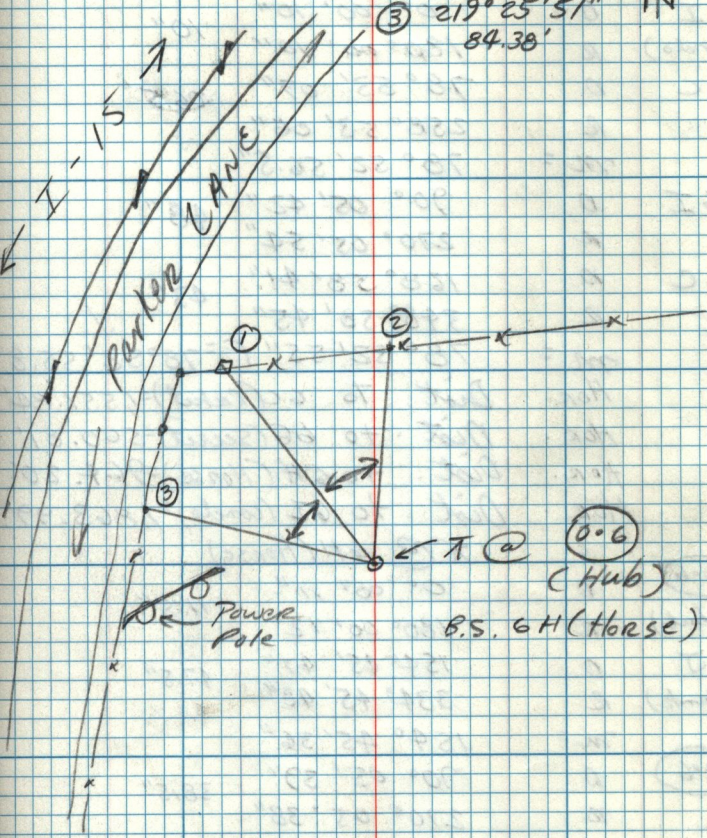

B.S. 6H (Horse)