

T.5N. R.1W.

3-14-84
Fly Tie



76

Sec. 6



31st
Expressway

TC 6S (spur)
B.S. 6T (coal)
∠ 194° 59' 49"
207.54'

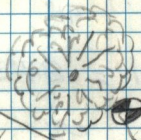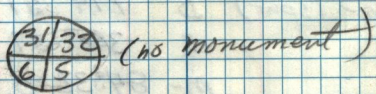

Railroad
spur

6S
(spur)

