

4H 4G

	0-00-00	
a.c.m.	314-39-56	
Mon.	179-59-55	218.80
Grandview	134-39-47	

EEW Fence 8-56-04 253.7


Plow Fence 19-47-17 132.3

W. end Fence 73-09-51 49.3

Prop. Fence Entr. 139-05-34 49.6

P.I. in Fence  $\Rightarrow$  Prop. Fence Entr. 216-54-11 46.3

Prop. Fence Entr. 246-04-26 98.0

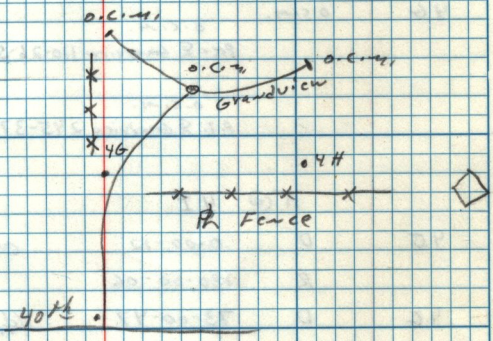

40.75	41
22.75	22
57	57
<hr/>	
0.50	