


D
19Y

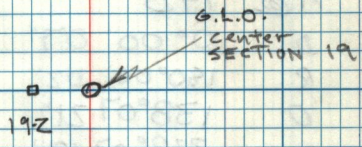

\nearrow @ 19Z B.S. 19Y @ 0°00'
 \nwarrow RT 175° 41' 58"
 DIST. 25.84' to G.L.O. center SECTION 19