D. LEE
T. WOOD
5-16-85
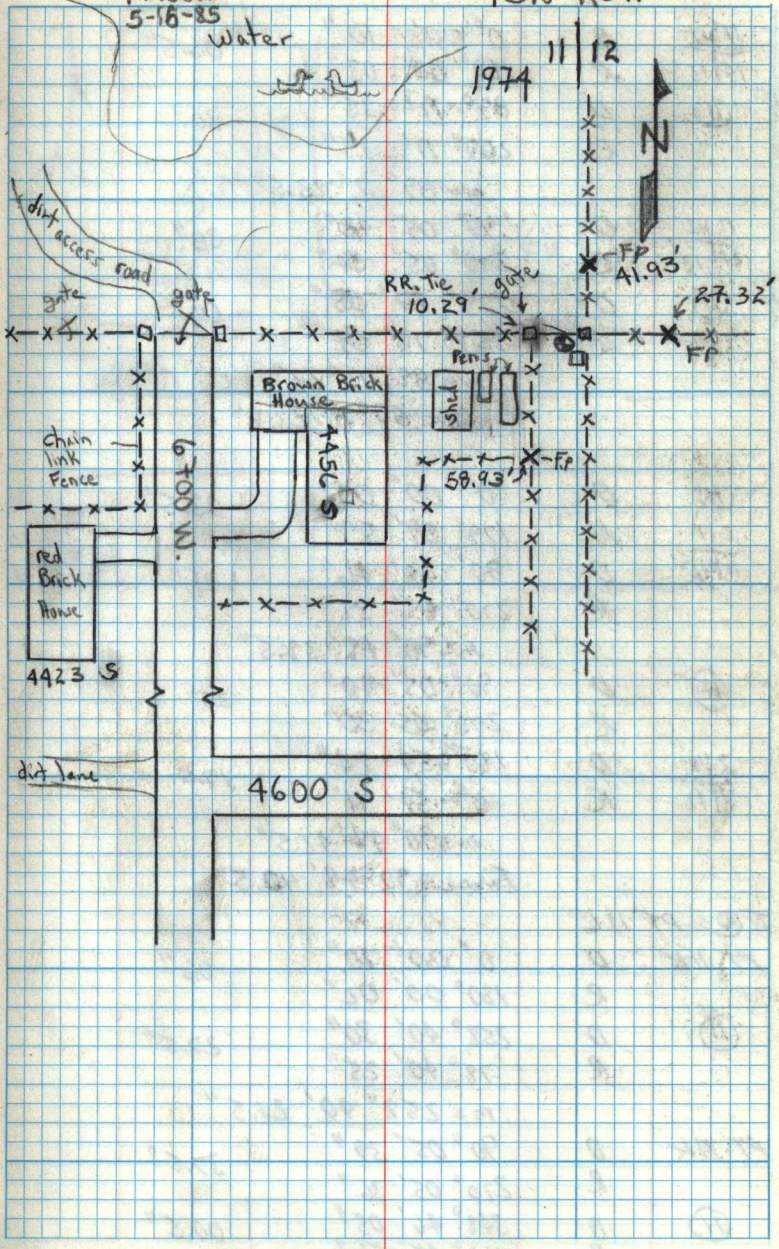
T5N R3W