

| | | | |
|-------|---|--------------|-------|
| 11/12 | D | 0° 00' 10" | 06.5" |
| 14/13 | R | 180° 00' 03" | |
| (11) | D | 89° 11' 35" | 30" |
| | R | 269° 11' 25" | |

$m = 89° 11' 23.5"$

| | | | |
|-------|---|--------------|-----|
| 11/12 | D | 90° 05' 42" | 38" |
| 14/13 | R | 270° 05' 34" | |
| (11) | D | 179° 17' 08" | 01" |
| | R | 359° 16' 54" | |

$m = 89° 11' 23"$

FINAL = 89° 11' 23.3"

| | | | |
|-------|---|--------------|-------|
| (11) | D | 0° 00' 08" | 03.5" |
| 2/1 | R | 179° 59' 59" | |
| 11/12 | D | 90° 48' 46" | 42" |
| | R | 270° 48' 38" | |


$m = 90° 48' 38.5"$

| | | | |
|------|---|--------------|-----|
| (11) | D | 90° 05' 40" | 35" |
| | R | 270° 05' 30" | |

| | | | |
|-------|---|--------------|------|
| 2/1 | D | 180° 54' 24" | 17.5 |
| 11/12 | R | 0° 54' 11" | |

$m = 90° 48' 42.5"$

FINAL = 90° 48' 40.5"

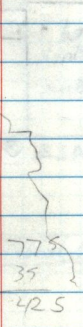

X @ PT 11L

| | | | |
|--------|---|--------------|-------|
| PT 11K | D | 0° 00' 10" | 06" |
| | R | 180° 00' 02" | |
| (11) | D | 258° 40' 30" | 27.5" |
| | R | 78° 40' 25" | |

$m = 258° 40' 21.5"$

| | | | |
|--------|---|--------------|-------|
| PT 11K | D | 90° 05' 39" | 37.5" |
| | R | 270° 05' 36" | |

| | | | |
|------|---|--------------|-------|
| (11) | D | 348° 46' 05" | 00.5" |
| | R | 168° 45' 56" | |

$m = 258° 40' 23"$