

5-23-84

STA. OVR Circle Rdg. Mean

Returned from pg. 16 Bk. 18

D 0° 00' 07" 05.5

R 180° 00' 04"

D 121° 00' 12" 06"

R 301° 00' 00"

M = 121° 00' 00.5"

D 90° 05' 36" 32.5"


R 270° 05' 29"

D 211° 05' 43" 36.5"

R 31° 05' 30"

M = 121° 00' 04".0

Final mean = 121° 00' 02.3"

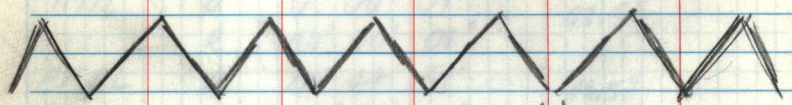

Township 5 North
RANGE 3 WEST

5-24-84 D. Butters B. Hillier

X @ S.W. 23

22/25 23A D 0° 00' 07" 08.5
(shit) R 180° 00' 10"

23B D 82° 29' 09" 09.5"
(Hows. Slough) R 262° 29' 10"

M = 82° 29' 01"

23A D 90° 05' 38" 38
R 270° 05' 38"

23B D 172° 34' 42" 39
R 352° 34' 36"

M = 82° 29' 01" Final M = 82° 29' 01"

Dist. to 23A (shit) = 2659.05'

Dist. to 23B (slough) = 2647.23