


Hilmer Outfall  
Fly TIES

Western  
outdoor man


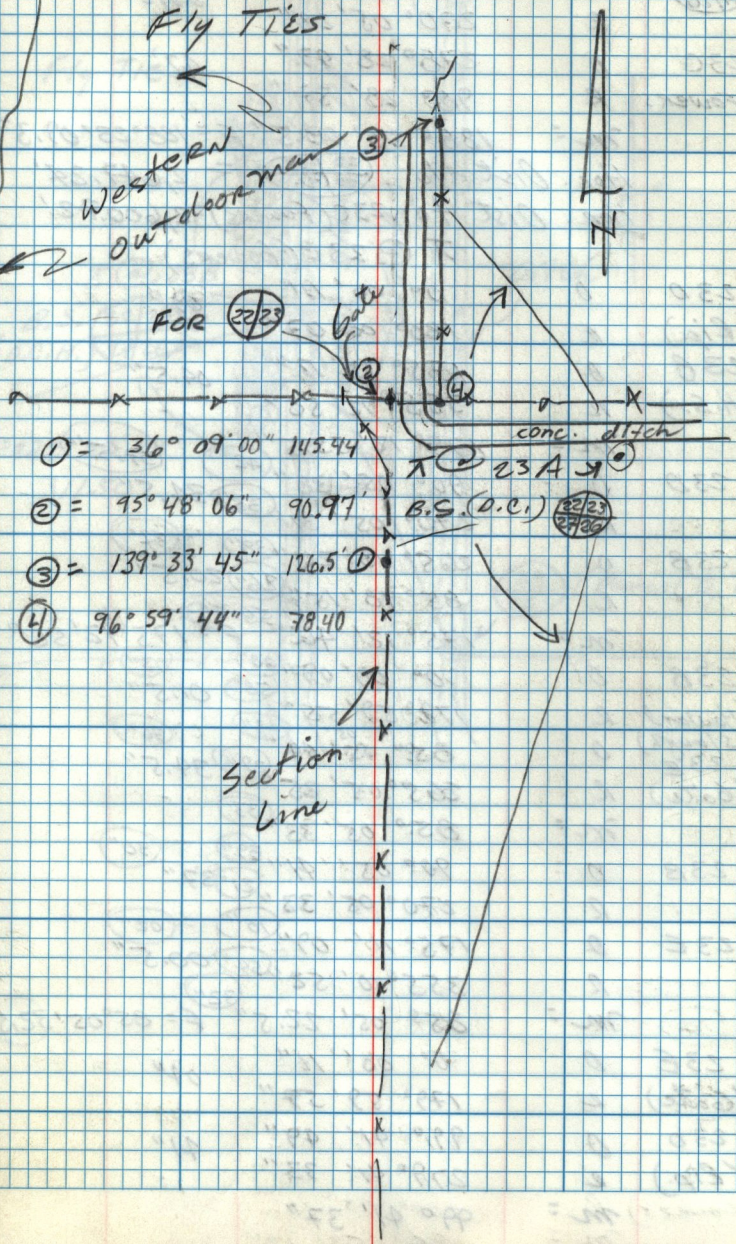

① =  $36^{\circ} 09' 00''$  145.44


③ =  $139^{\circ} 33' 45''$  126.5

④ =  $96^{\circ} 59' 44''$  78.40

Section  
Line


conc. ditch