


D. Lee
T Word
5-16-85

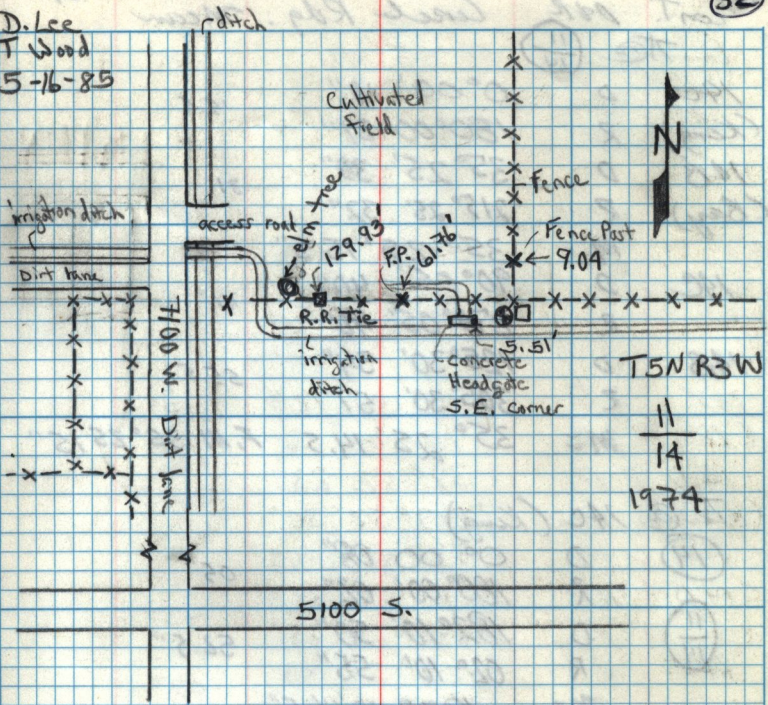

T5N R3W
 11
 14
 1974

5100 S
 11
 14