


21.4 To East Gate
31.75 west

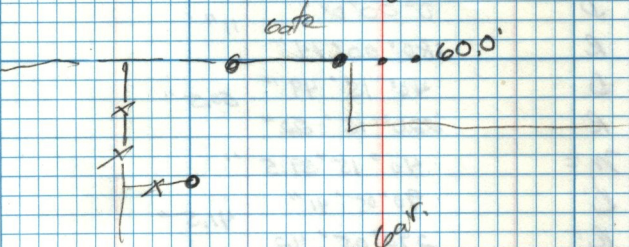

S.E. cor. Gar.
92.7

S. cor. of sheds

7
81.5
46.0

35.5
81.5