


Sec 11 T.S.N. R.3W.

Fly Tie

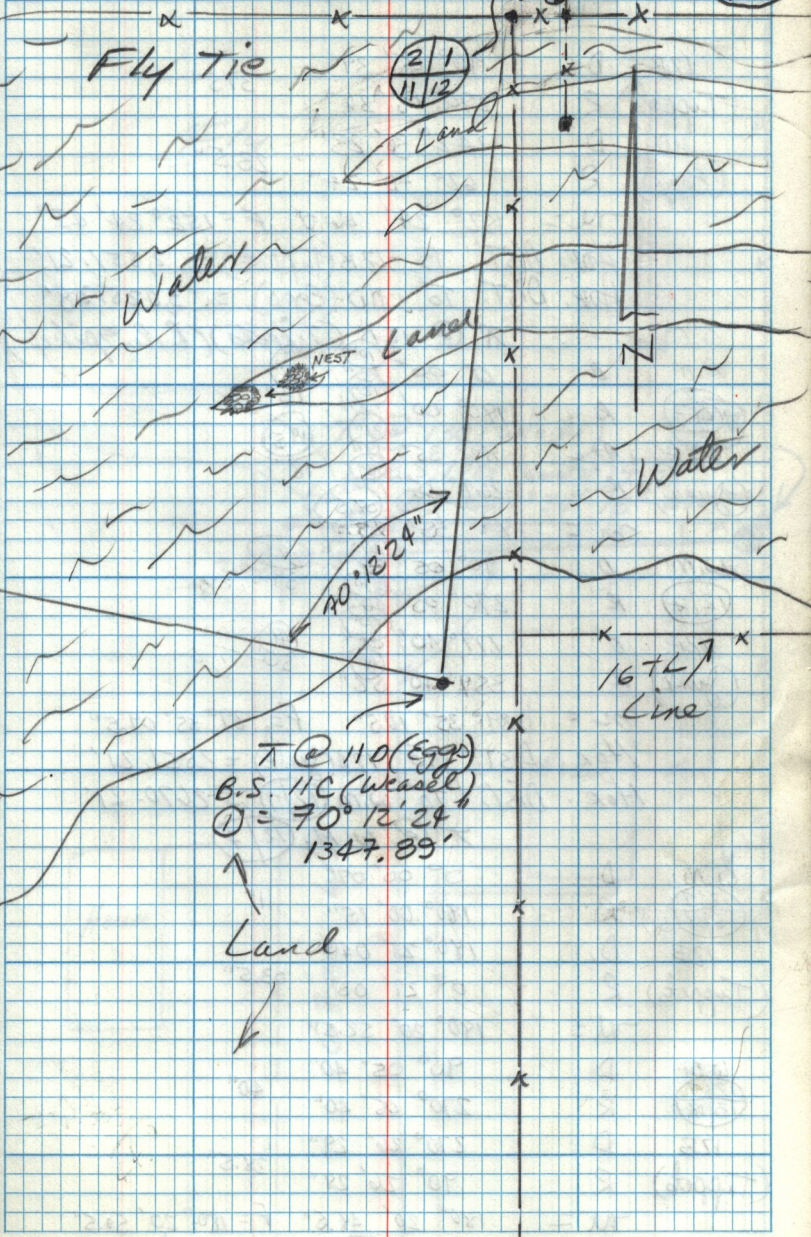

T @ 110 (Egg)
 B.S. 11C (Weasel)
 $\theta = 70^{\circ} 12' 24''$
 1347.89'

Land

167L Line

NEST

Land

Water

Land

Water

70° 12' 24"

1347.89'