


D. Lee  
T. WOOD  
5-30-85

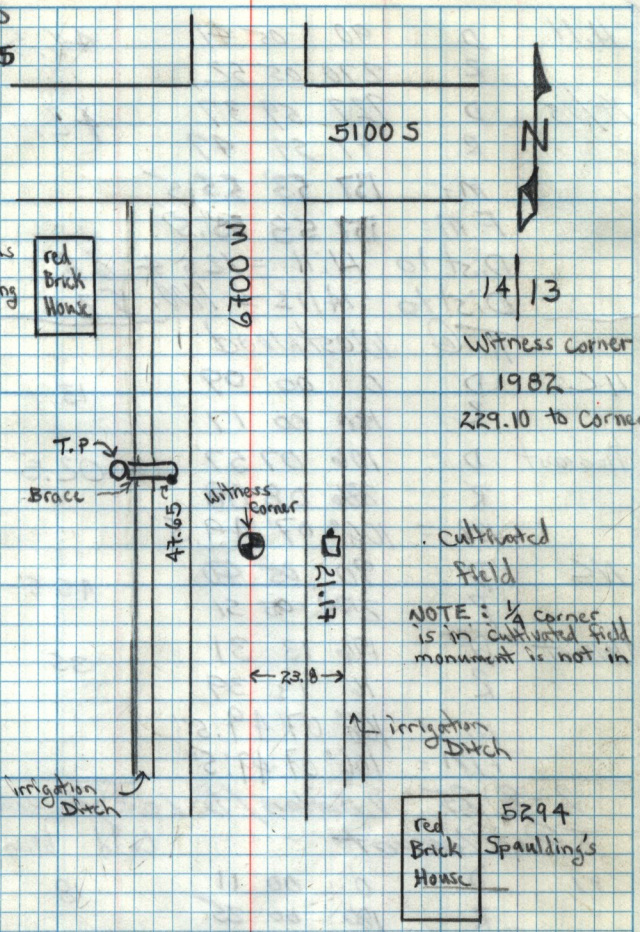

161° 20' 28" From To 14 13 B.S. 146  
 A.B.T. ↑ To H-1 (717)