


5/8

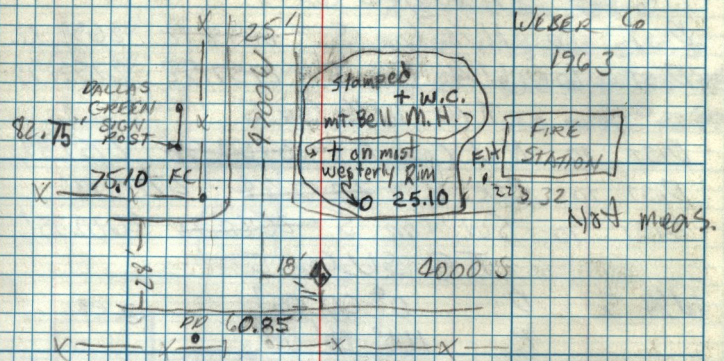

NOT MEAS.

COULD USE WITNESS MON.