



Center Sect 3

WEBER Co. 1968

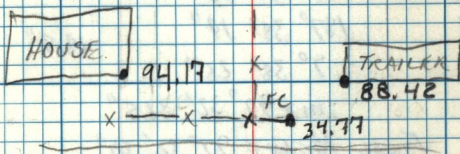

3600 SOUTH

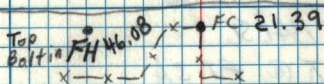

Note: Brass needs to be re-enforced with concrete