


34.35
3 | 2

WEBER CO. 1962

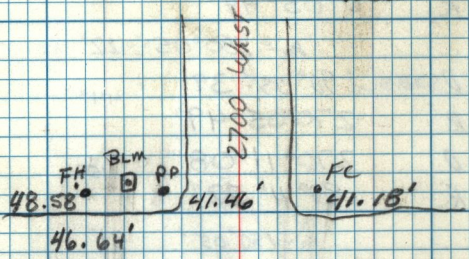

3300 SOUTH

