

T @ S.E. COR SEC 3


B.S. S 1/4 COR 0°00'00"

X RT ① W.C = 90°29'15"

1/3/84

② W.C = 270°27'50"

1960

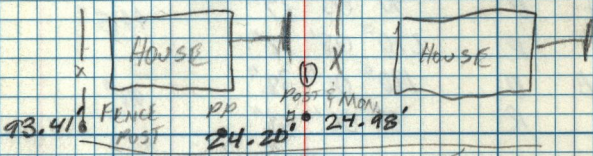

4000 SOUTH

