

④ • FENCE POST

③ • FC

① PK
NAIL

② PK
MON

4000 SOUTH

DPT CA


J. Wood
R. Balken

8-29-85

2
11
Roy City
Mon.

2275 West

NORTH

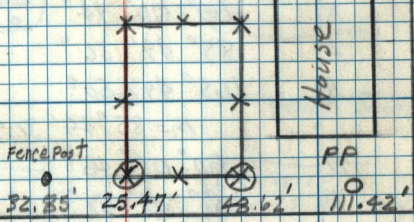

4000 South

P.K. + Washer

21.72'

P.K. + Washer

15.64'

Field