


177-257

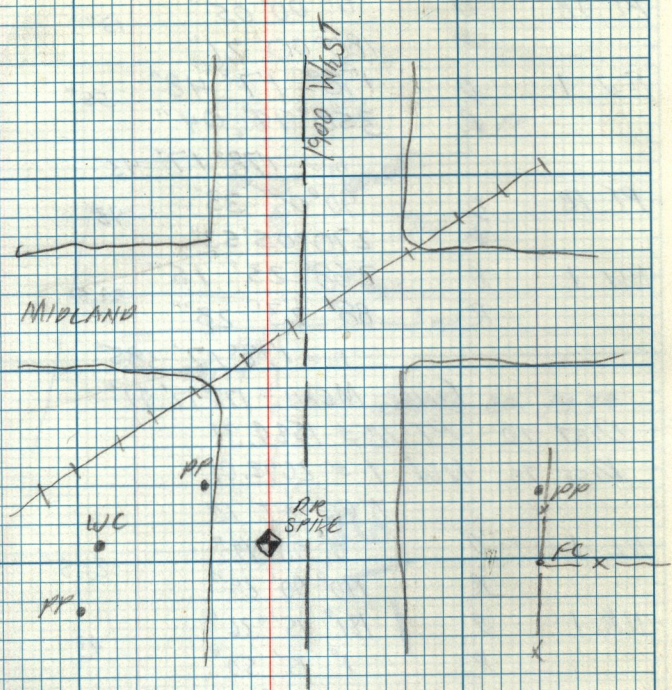

T&E NE COR SEC 2  
 BS N 1/4 SEC 2 0°00'00"  
 TO SEE IF R.R. SPIKE ON LINE

WITNESS MON. 358°21' 54"  
 next to R.R. SPIKE 0°00'00"

DIST TO R.R. SPIKE =  
 DIST TO MON. =