1225.76

Δ @ PT 12C
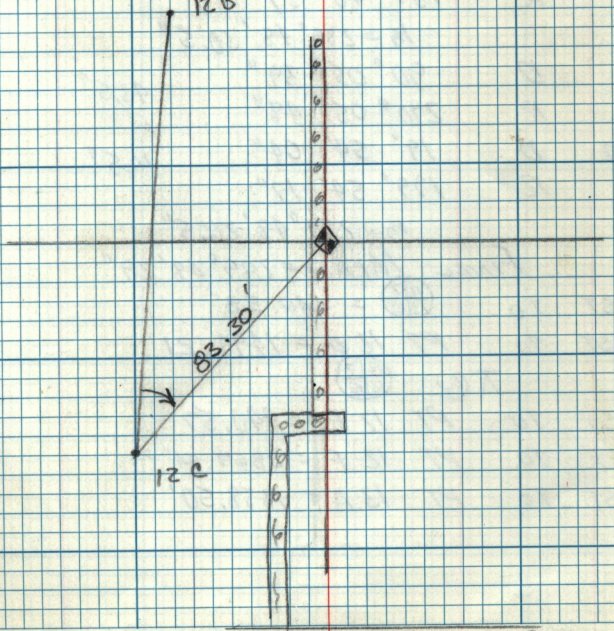
R.S. PT 12B & PT. TO E¼ = 40°22'53"