

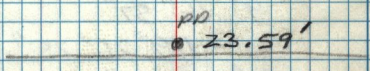


11  
1A

WEBER Co.  
1/6/84 1965

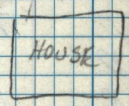


WEBER Co  
1965

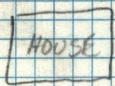

4800 SOUTH

2350 WEST

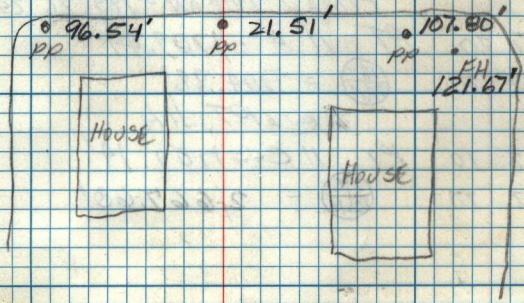

2275 WEST