


Roy City 1980  
1/6/84

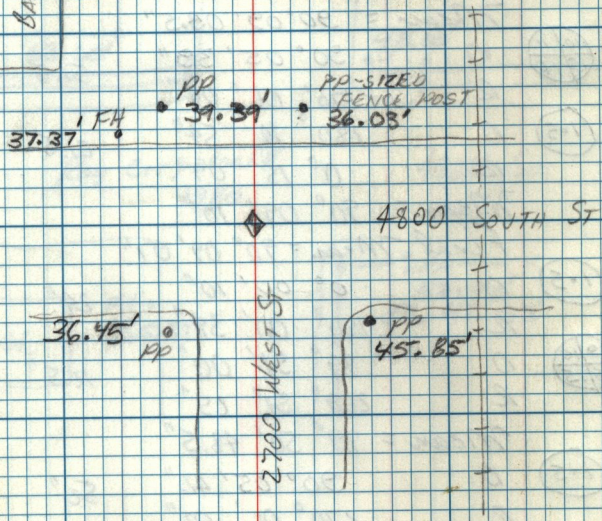

10 | 11  
15 | 14

done RT