



10
15

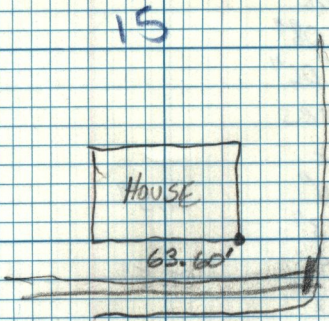

3100 West

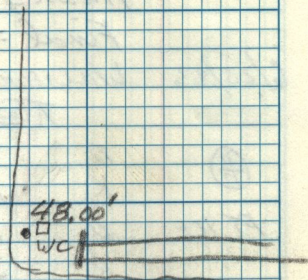

ROY CITY MOUNTAIN
1980

4800 So

