


9/16

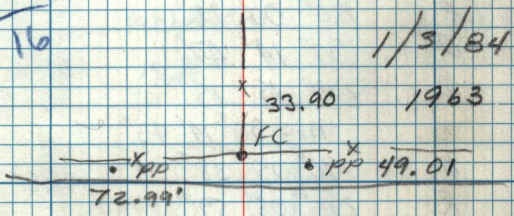

4800 So

