


4300 WEST

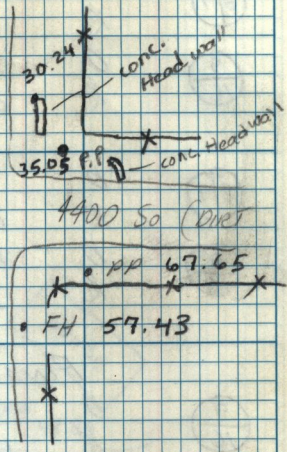

Weber Co
1963

1-04-84

8/9