


pond

Point 6E (1/4)

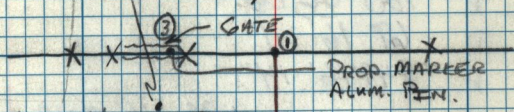

T @ 6E Sight 6D @ 0°00'00"

96°36'30" 19.75' to ③

161°15'25" 55.44' to ①

226°19'30" 75.70' to ②

