


T@ wit mon. to center sec 18 5-2m

- Wit. to $\frac{18}{19}$ D 0-00-11 14.5 ✓
R 180-00-18
- Wit. to $\frac{7}{18}$ D 179-54-40 44.5 ✓
R 359-54-49
M 179-54-30 ✓
- Wit to $\frac{18}{19}$ D 90-05-42 42.5 ✓
R 270-05-51 5500 S : 5900 W
- Wit to $\frac{7}{18}$ D 270-00-18 20.5 ✓
R 90-00-23
M 179-54-34 ✓
F 179-54-32 ✓

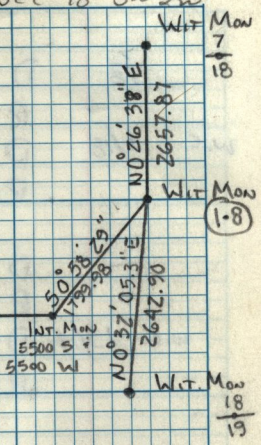

Dist to witness Mon $\frac{18}{19}$ 2642.90
Dist to witness Mon $\frac{7}{18}$ 2657.87

T@ wit mon to center 18

- Wit to $\frac{18}{19}$ D 0-00-10 11.5 ✓
R 180-00-18
- Intr mon at 5500 S 5500 W
D 0-26-30 3A ✓
R 180-26-38
M = 0-26-22.5

Dist to intr mon at 5500 S 5500 W = 1800.02

S 1° 12' 44\" W 2632.83

