

T @ 18C (Near S.W. CORNER 18)


SIGHTING 13/18 @ 0° 00' 00"

X RT TO MON $\frac{13}{24} \frac{18}{19}$ $80^{\circ} 56' 13'' - 156.31'$

TO W.C. WEST SIDE OF 5900 W.

$305^{\circ} 04' 07'' - 39.21'$

5500 SOUTH

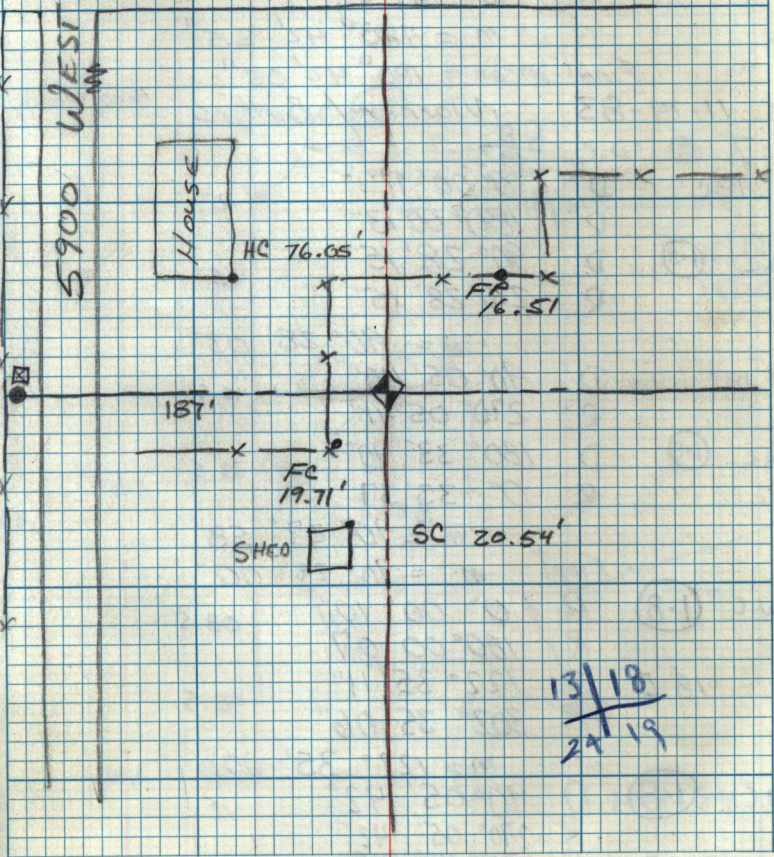

$\frac{13}{24} \frac{18}{19}$