


17 B is about 45' East of  $\frac{17}{20}$

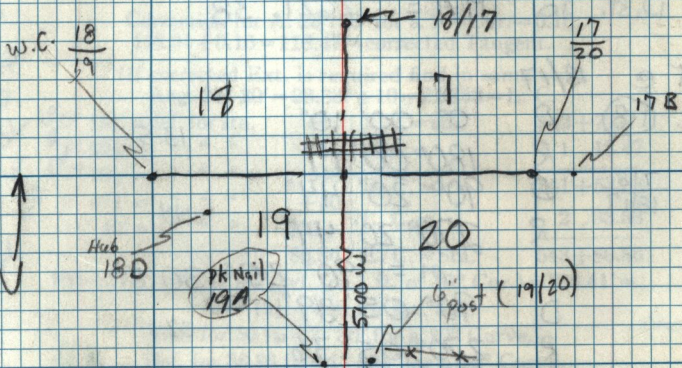

19 A is About 25' West of 19/20