


1-09-84

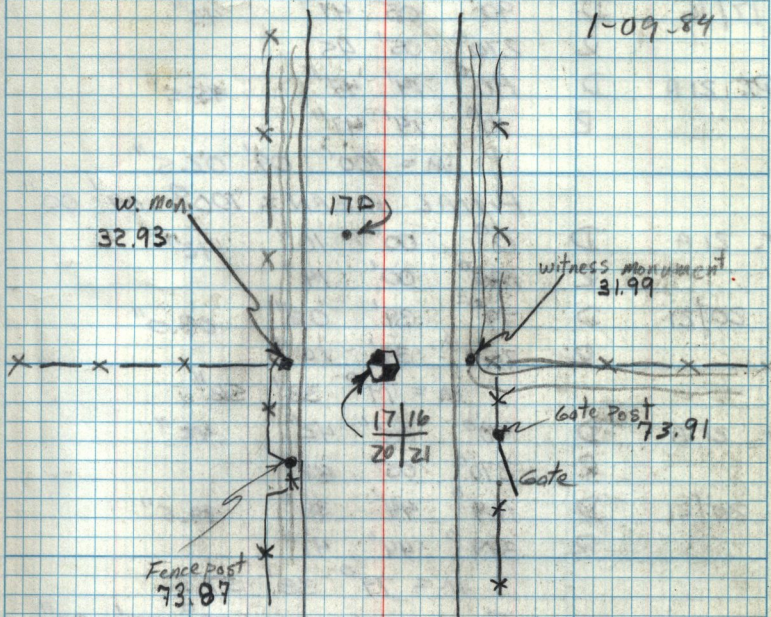

λ @ 17D SIGHTING 17/16 MON

$$\angle RT. TO MON \frac{17/16}{20/21} = 174^{\circ} 59' 14''$$

$$DIST TO MON. = 39.17'$$

Weber Co. 1980