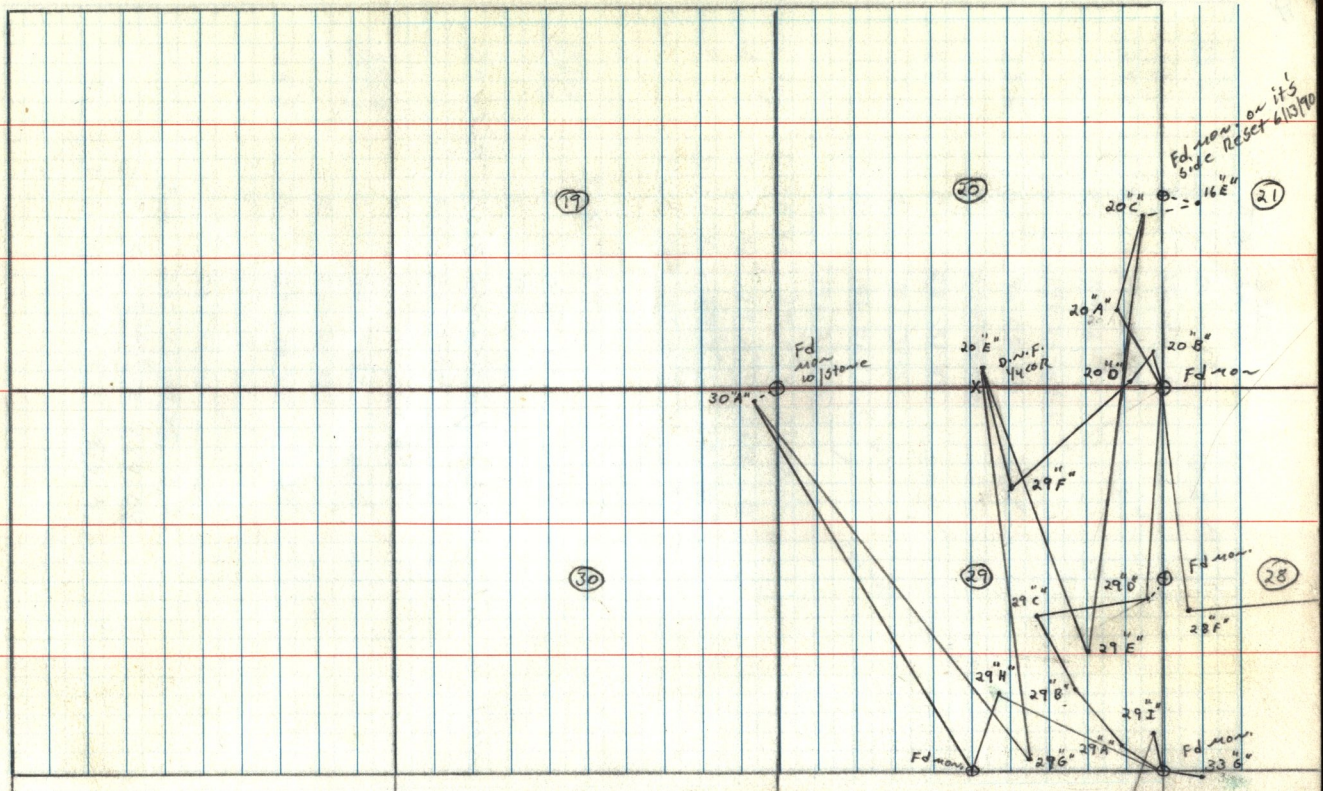
19
20
21
30
29
28
Fd mon on it's side Reset 4/13/90
20"C"
16"E"
20"A"
20"B"
20"E"
D.W.F. 14 COR
20"D"
Fd mon
Fd mon to stone
30"A"
29"F"
Fd mon.
29"D"
29"C"
28"F"
29"E"
29"H"
29"B"
29"I"
Fd mon.
29"G"
29"A"
Fd mon.
33"B"