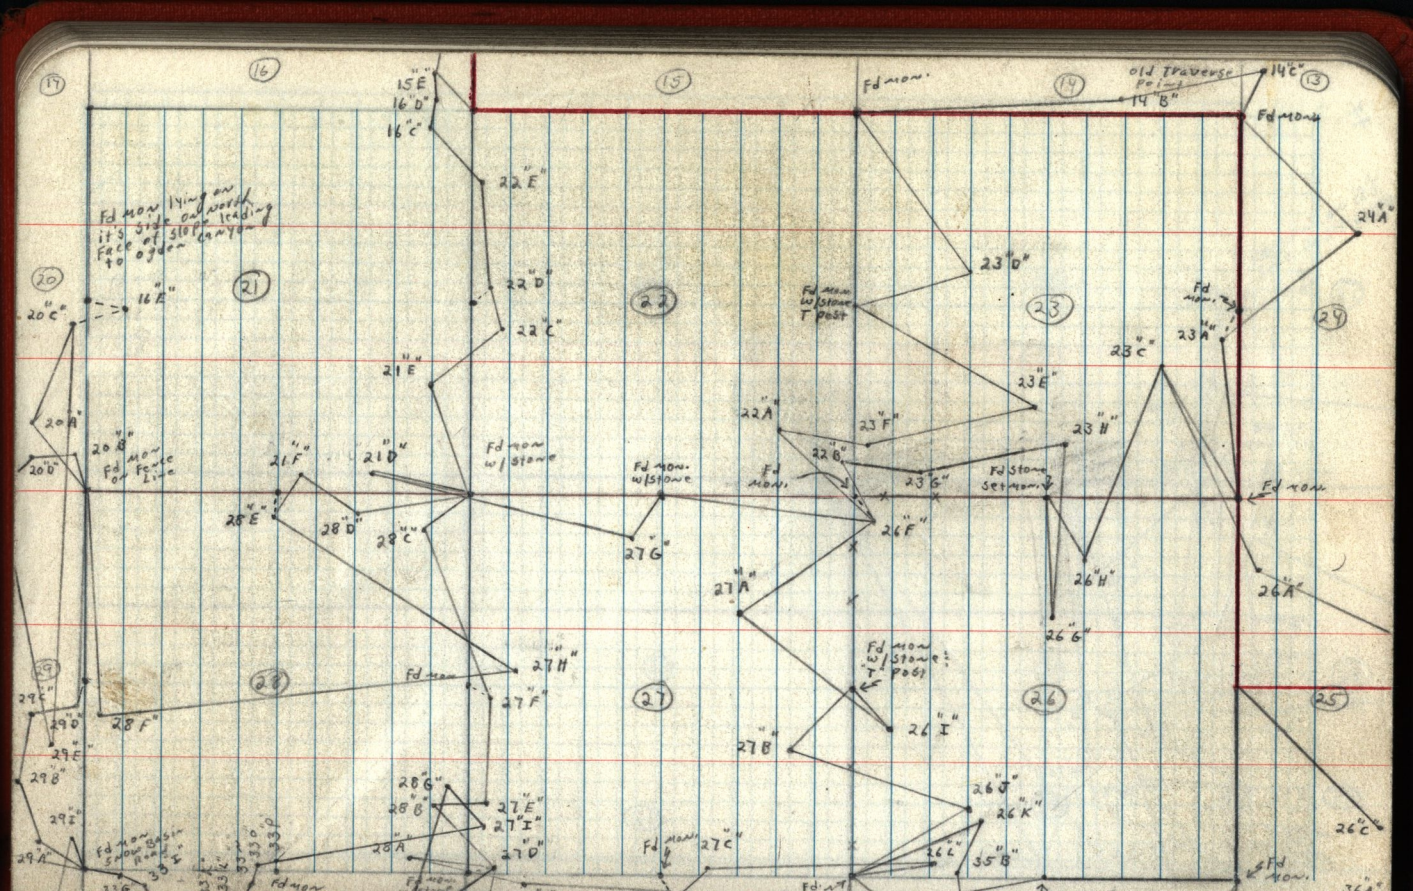
19
16
15
14
13
20
21
22
23
29
28
27
26
25
15"E
16"D
16"C
Fd mon
old Traverse Point
14"C
14"B
Fd mon
Fd mon lying on it's side on west leading face of slot canyon to ogden
22"E
24"A
23"D
22"D
22"C
Fd mon w/stone T post
Fd mon
16"E
20"C
21"E
23"C
23"A
23"E
22"A
23"F
23"H
20"A
20"B
Fd mon Face Line
20"D
21"F
21"D
Fd mon w/stone
Fd mon w/stone
Fd mon
22"B
23"G
Fd stone set mon
Fd mon
28"E
28"D
28"C
27"G
24"F
26"H
26"A
27"A
26"G
27"H
Fd mon
Fd mon w/stone T post
29"C
29"D
28"F
27"F
26"I
27"B
29"E
29"B
28"G
28"B
27"E
27"I
26"J
26"K
26"C
Fd mon Stone Basin Road
30"I
33"O
33"O
20"A
27"D
Fd mon
27"C
26"L
35"B
Fd mon