


West Ogden Monument Survey

170

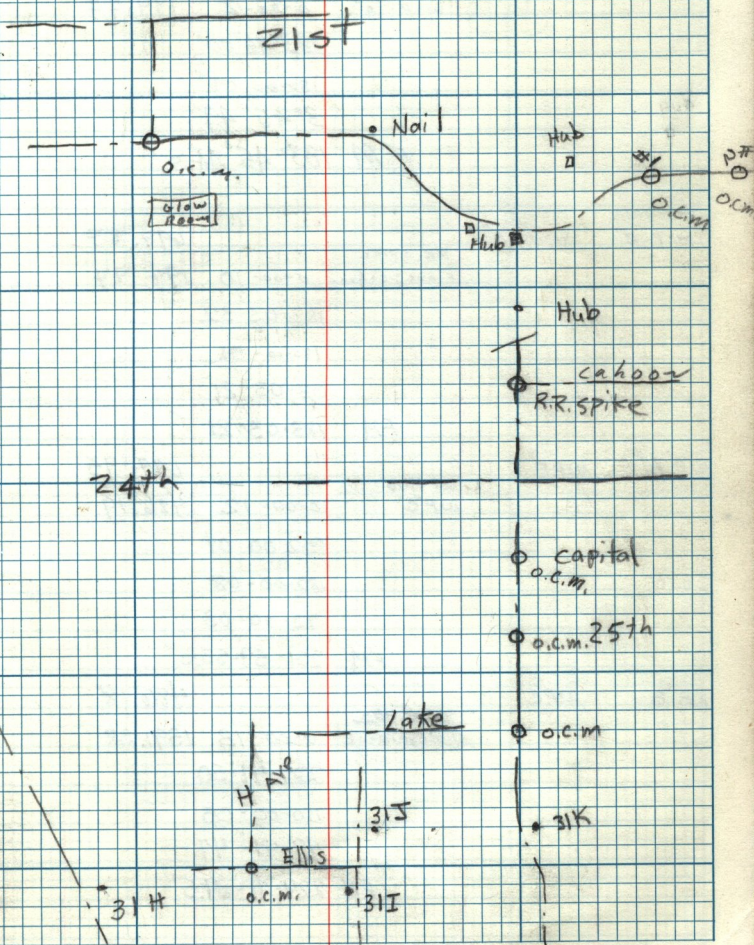

I-15

F Ave