


T@ 4A B.S. N 1/4 3 @ 0000.00


RT 198° 28' 08" Dist 62.13 to ①

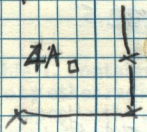

RT 115° 49' 46" Dist 30.65 to ②

RT 334° 49' 00" Dist 28.98 to ③

Same Hub used IN Traverse

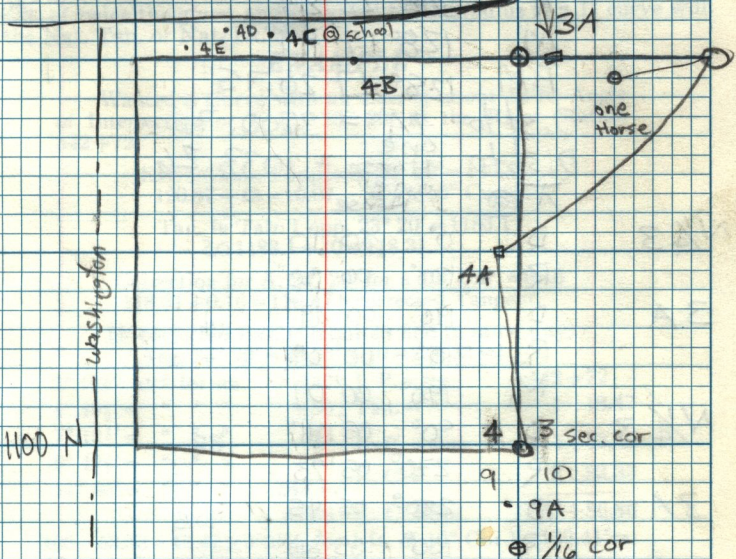

Dist to 4/3 = 2719.37

Dist to 3A = 2509.88

Dist to N 1/4 3 = 3600.78