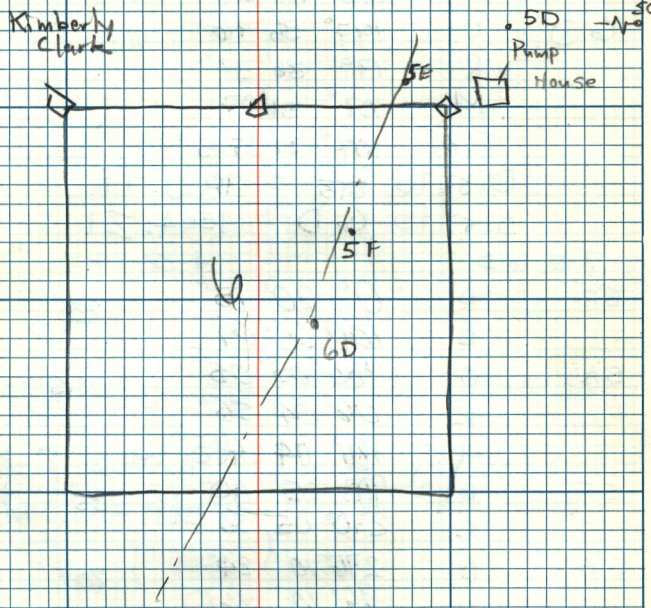

DIST TO 5D = 447.96
DIST TO 5F = 1810.94
DIST TO 5D = 1922.09