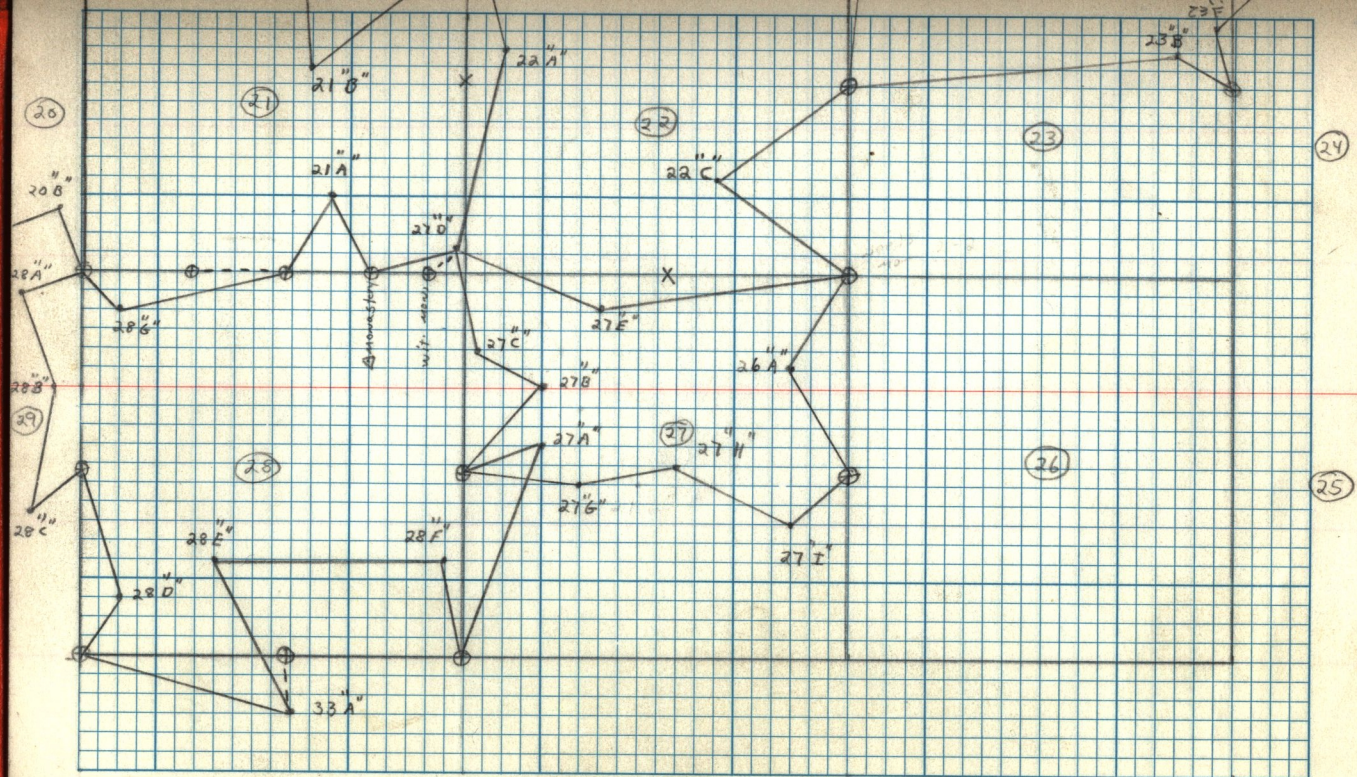
20
21
22
23
24
25
26
27
28
29
21"B"
22"A"
21"A"
22"C"
23"B"
23"E"
20"B"
28"A"
28"G"
Wit. mess.
27"C"
27"E"
27"B"
26"A"
28"B"
27"A"
27"H"
27"G"
28"C"
28"E"
28"F"
28"D"
27"I"
33"A"