


30/29
31/32 (5)

1/25/84

BH + V.W.

1963 man
manual 1965
to present location

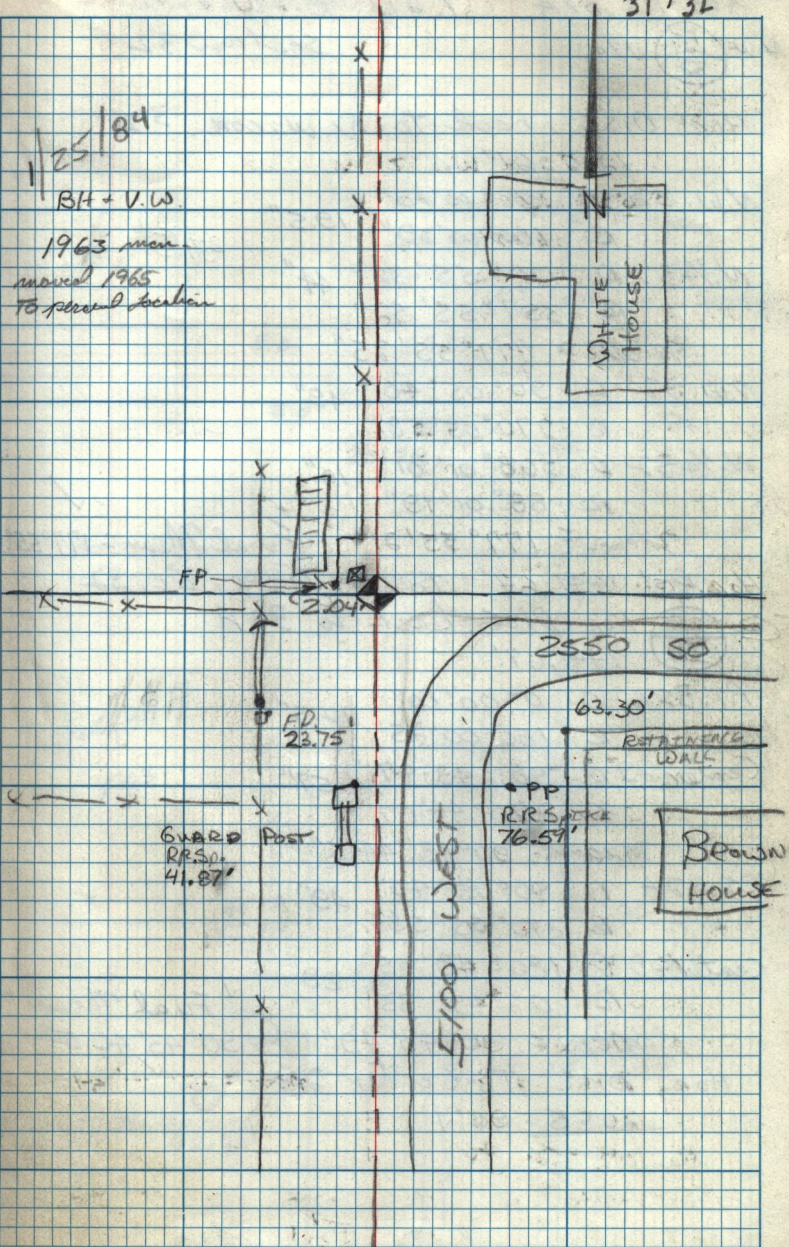

done