



✓ Hillier  
 & Holmes Butlers

5-12-83

6

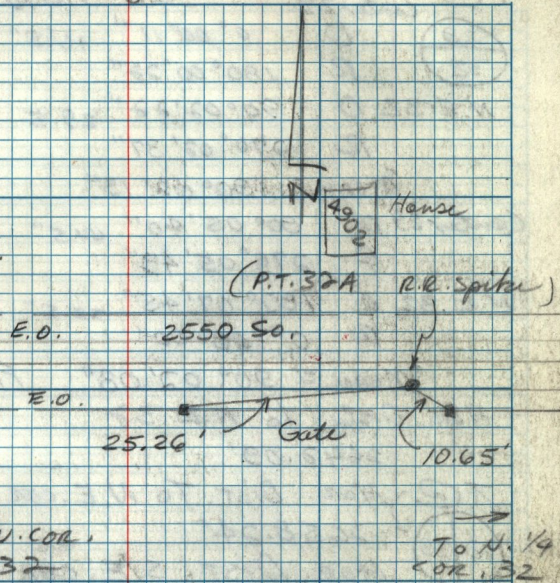

1/26/83  
 1963

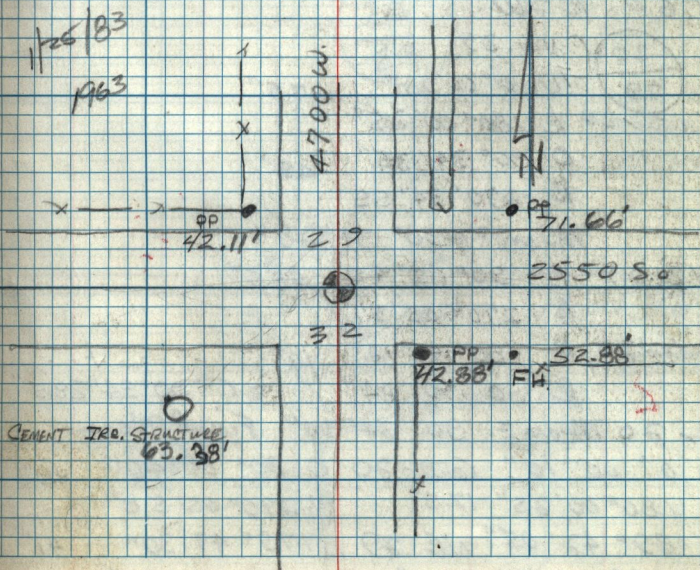

Jan