

Hillier & Butters
Holmes &


$\frac{20}{29}$

1963

5-12-83

NHFBH

T.6N.
R.2W.

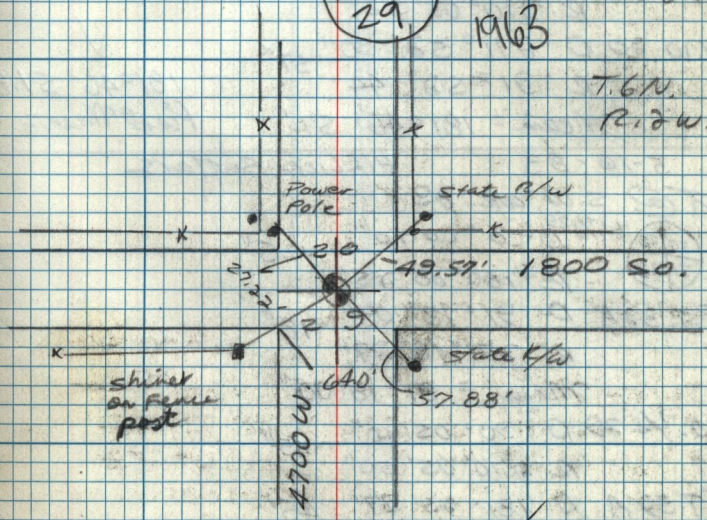

→ Final Meas = $89^{\circ}41'53''$

done