

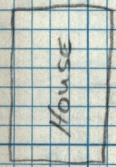



1/16/84
1963 MON.

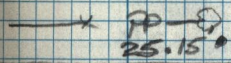



STREET

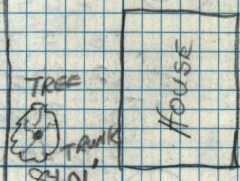

2550 SOUTH STREET

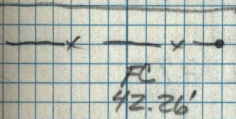

4300 WEST

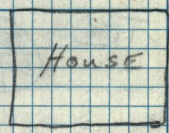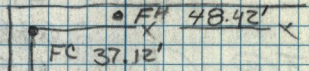

29/28
32/33

done